
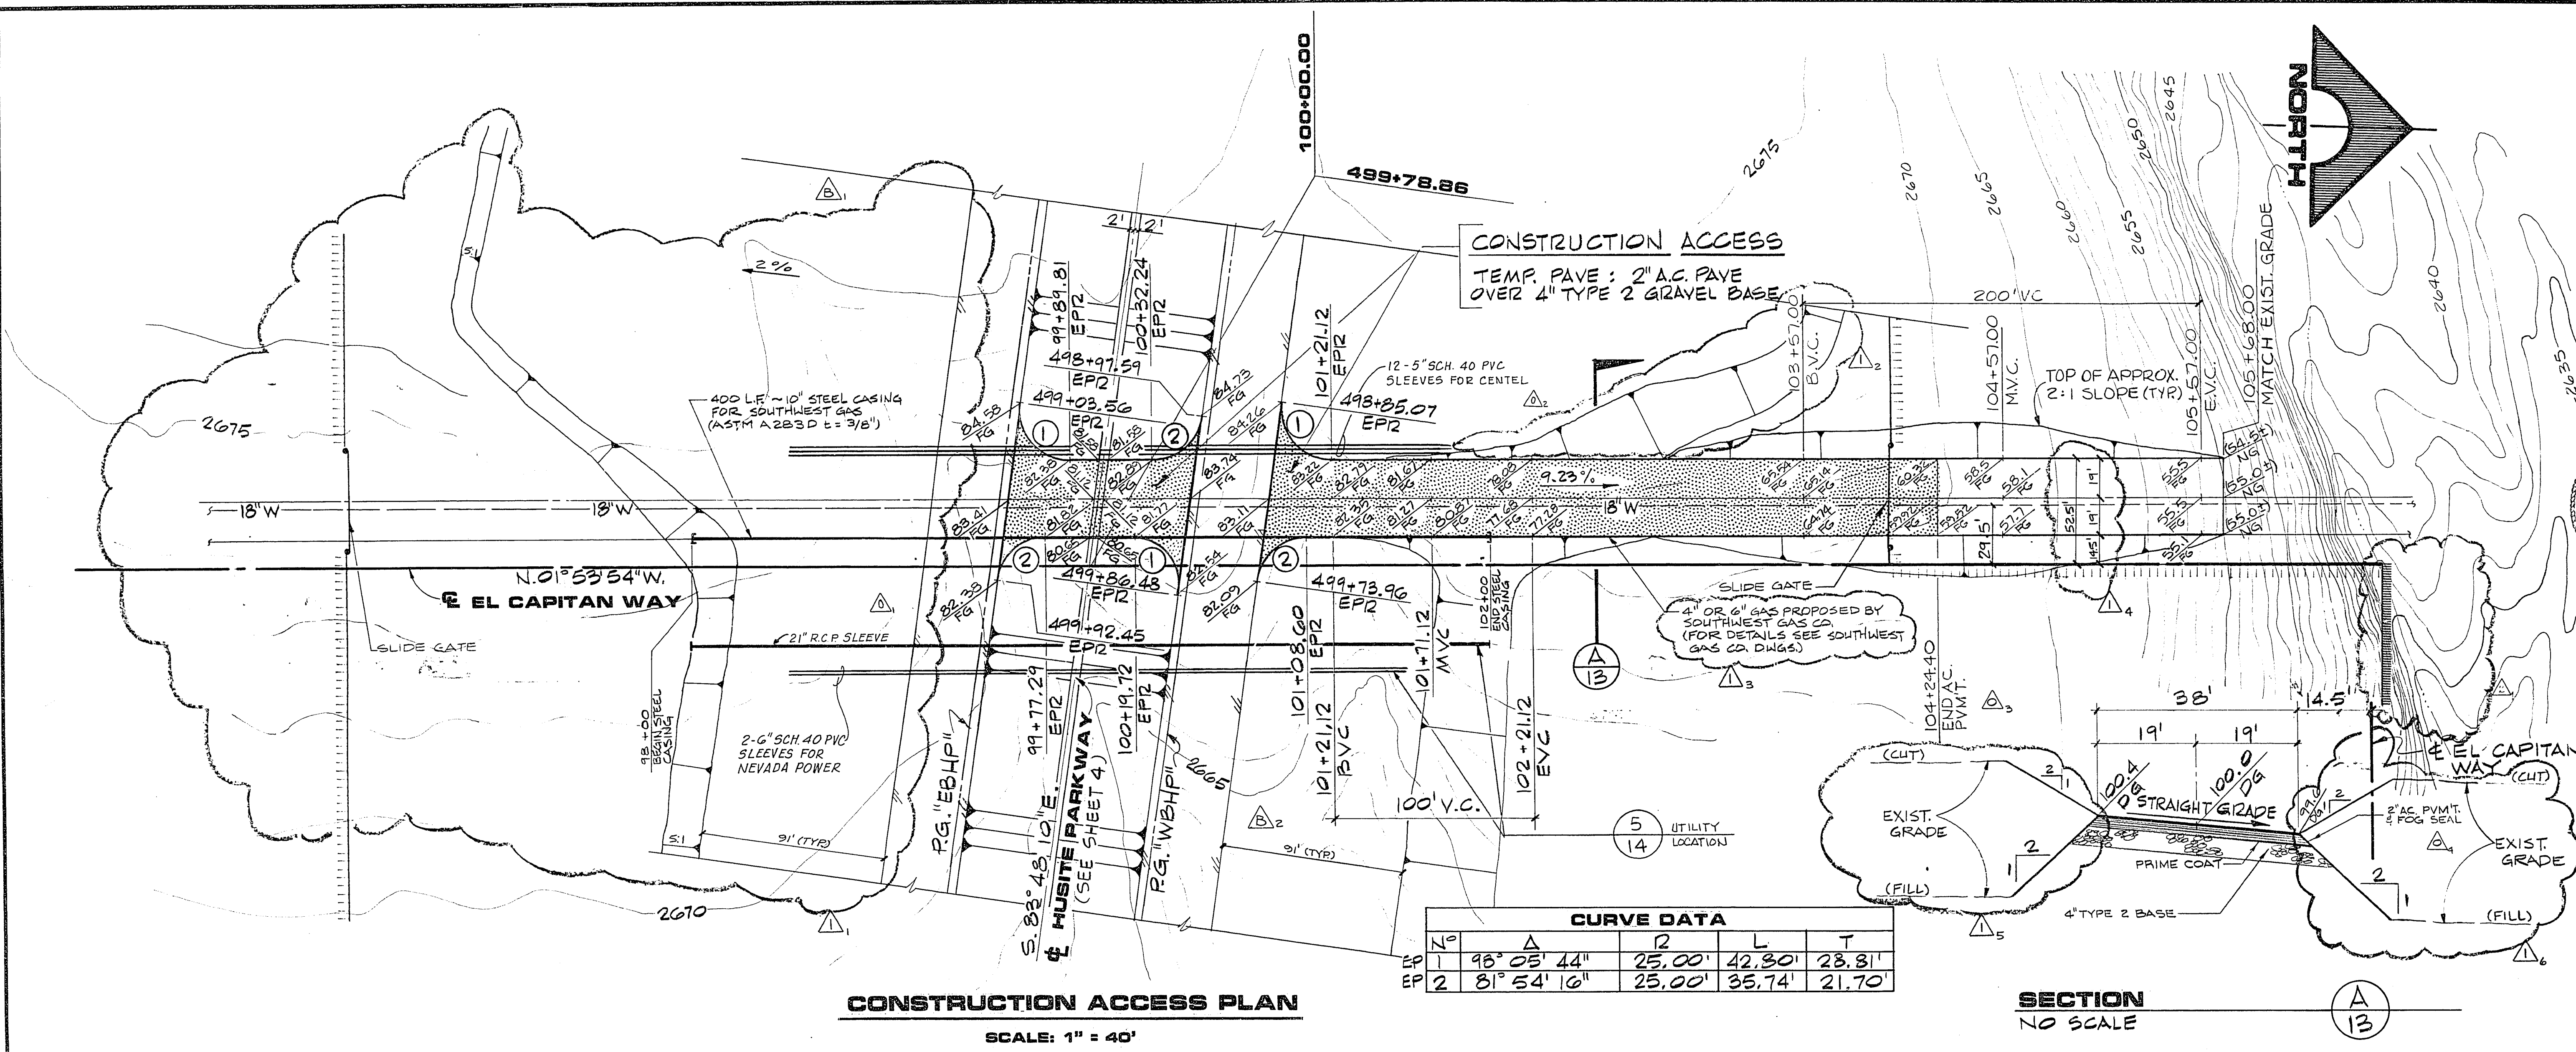


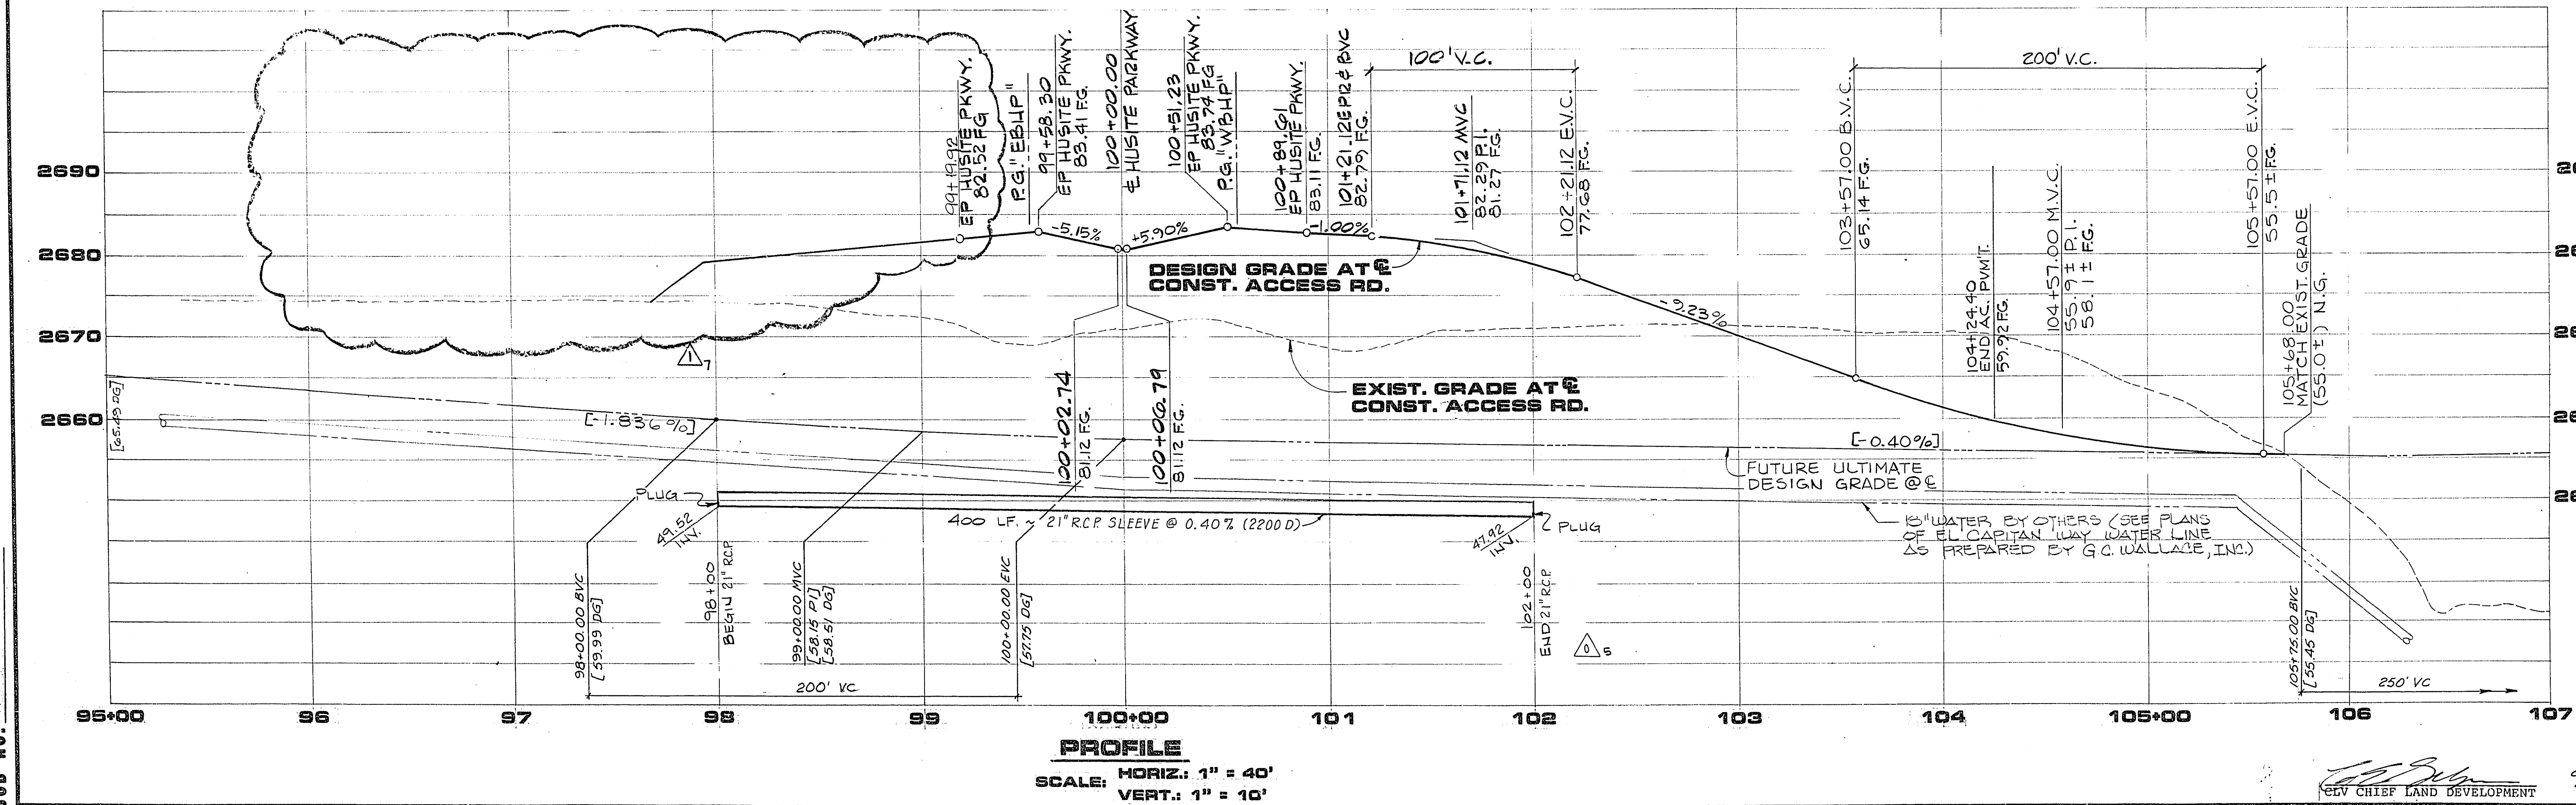

CURVE DATA				
N°	Δ	R	L	T
1	98° 05' 44"	25.00'	42.30'	23.81'
2	81° 54' 10"	25.00'	35.74'	21.70'

SECTION
NO SCALE
A 13

REVISIONS

REV	DATE	DESCRIPTION
1	11/01/97	ISSUED FOR BIDD
2	11/09/97	ISSUE APPENDIX 18 TO GMP
3	11/09/97	ISSUE FOR CONSTRUCTION
4	11/09/97	ISSUE PER G.C.H. LETTER
5	11/09/97	ISSUE PER G.C.H. LETTER

RECOMMENDED

APPROVED

6638

11/23/97

R.E. NO.

DATE

HOWARD HUGHES PROPERTIES

HUSITE PARKWAY

EL CAPITAN WAY CONSTRUCTION ACCESS

PLAN & PROFILE

SHEET

13

OF 20 SHEETS

107-VIS71-2

G.C. WALLACE, INC.
Engineering/Architecture
155 SOUTH RAINBOW BLVD. LAS VEGAS, NEVADA 89102