



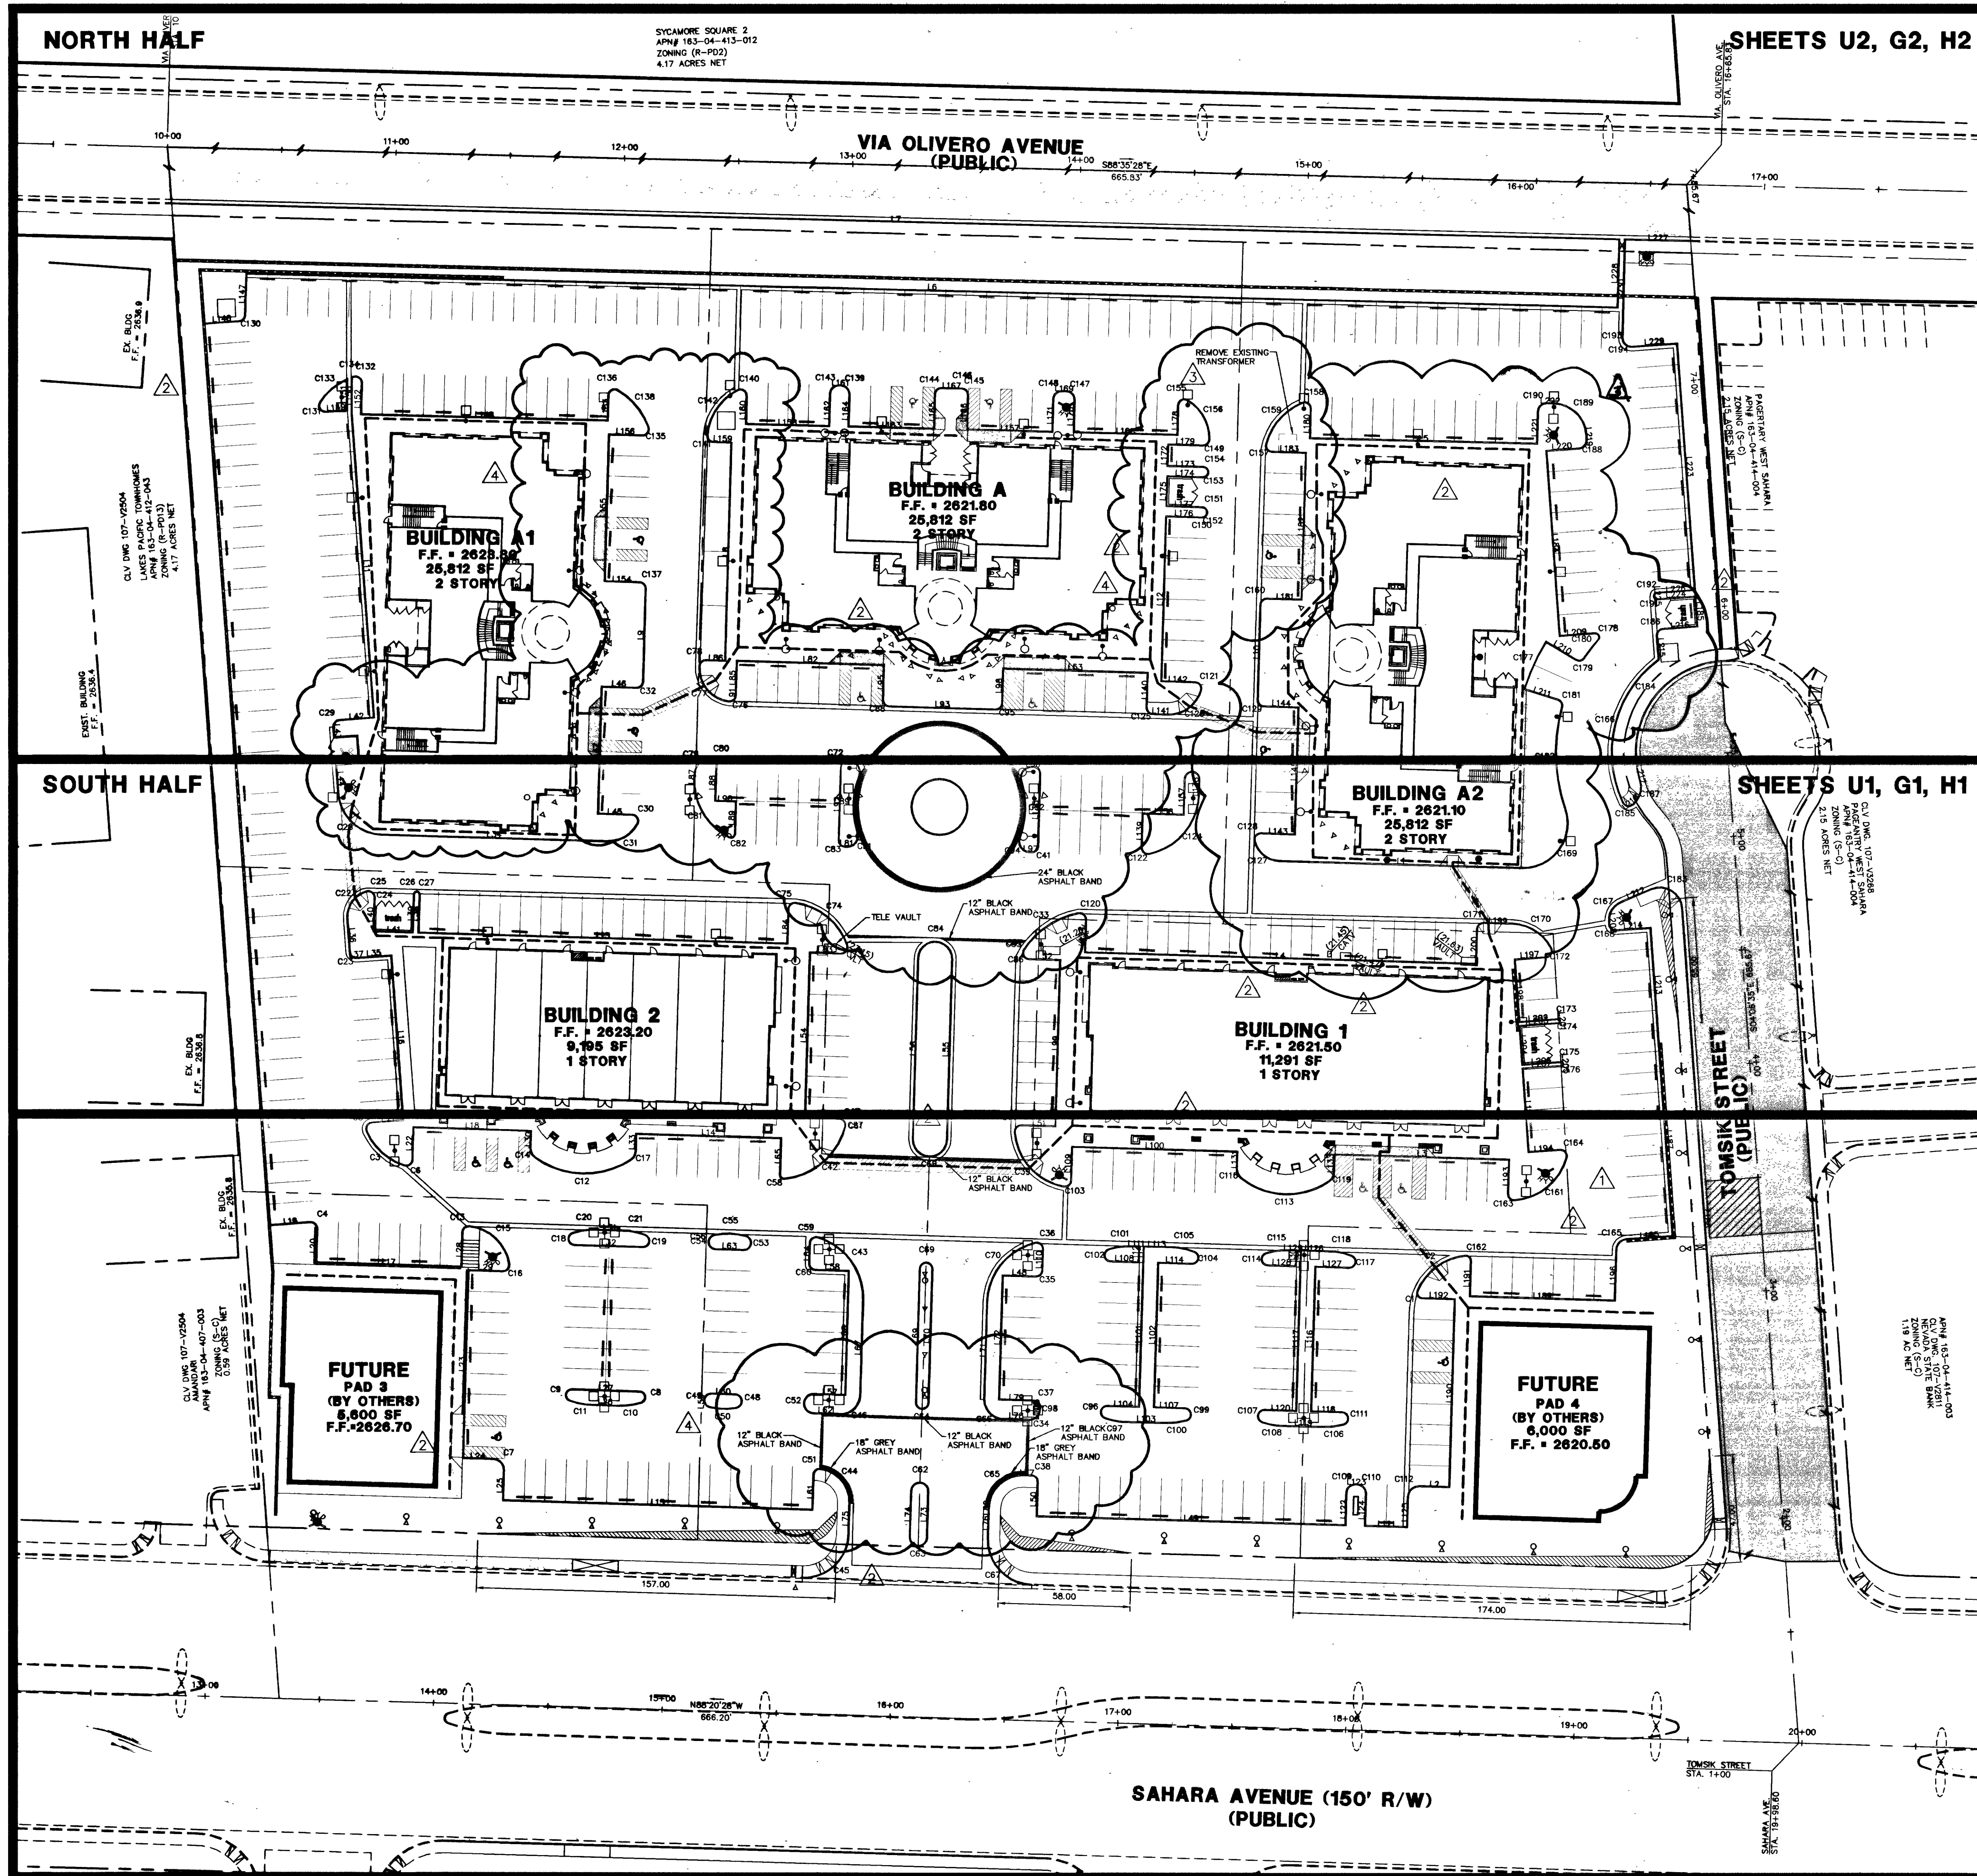

KEY MAP

SHEETS U2, G2, H2

SHEETS U1, G1, H1

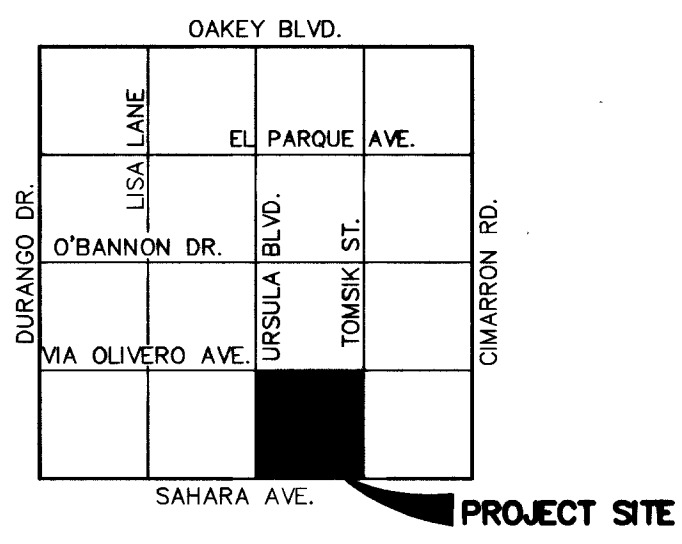

VICINITY MAP

LEGEND

- PROPERTY LINE
- STREET CENTER LINE
- EXISTING BUILDING
- EXISTING CURB
- PROPOSED CURB
- EXISTING EDGE OF A.C. PAVEMENT
- BUMPER BLOCK

GRAPHIC SCALE



(IN FEET)
1 inch = 40 ft.

LEGAL DESCRIPTION

BEING A PORTION OF THE SOUTHWEST QUARTER (SW 1/4) OF THE SOUTHEAST QUARTER (SE 1/4) OF THE SOUTHWEST QUARTER (SW 1/4) OF SECTION 4, TOWNSHIP 21 SOUTH, RANGE 60 EAST, M.D.M., CITY OF LAS VEGAS, COUNTY OF CLARK

BENCHMARK

CITY OF LAS VEGAS BENCHMARK NO. 11Y10 4SSW6
RIVET & PLATE IN THE TOP OF CURB 8250 W. SAHARA AVE. IN THE NORTH CURB LINE, (NE CORNER OF SAHARA & TOMSIK)

OLD BENCHMARK ELEVATION
ELEVATION = 795.8136 METERS
(2610.93 U.S. SURVEY FEET) NAVD88 DATUM

NEW BENCHMARK ELEVATION
ELEVATION = 795.8314 METERS
(2610.99 U.S. SURVEY FEET) NAVD88 DATUM

METERS X $\frac{3937}{1200}$ = U.S. SURVEY FEET
1. THE ELEVATIONS SHOWN HEREON ARE BASED ON FEET.

BASIS OF BEARINGS

SOUTH 88°20'28" EAST BEING THE SOUTH LINE OF THE SOUTHEAST QUARTER (SE 1/4) OF THE SOUTHWEST QUARTER (SW 1/4) OF SECTION 4, TOWNSHIP 21 SOUTH, RANGE 60 EAST, M.D.M., CLARK COUNTY, NEVADA, AS SHOWN IN BOOK 82 OF PLATS, PAGE 32, IN THE OFFICE OF THE CLARK COUNTY, NEVADA RECORDER.

Call before you Dig.
1-800-227-2600
UNDERGROUND SERVICE ALERT (USA)

Call before you OVERHEAD
1-702-593-6111
NEVADA POWER OVERHEAD AND SAFETY SERVICE SEPARATION

DISCLAIMER NOTE

EXISTING UTILITY LOCATIONS SHOWN HEREIN ARE APPROXIMATE ONLY. IT SHALL BE THE CONTRACTOR'S RESPONSIBILITY TO DETERMINE THE EXACT VERTICAL AND HORIZONTAL LOCATION OF ALL EXISTING UNDERGROUND UTILITIES PRIOR TO COMMENCING CONSTRUCTION. NO REPRESENTATION IS MADE THAT ALL EXISTING UTILITIES ARE SHOWN HEREON. THE ENGINEER ASSUMES NO RESPONSIBILITY FOR UTILITIES NOT SHOWN OR UTILITIES NOT SHOWN IN THEIR PROPER LOCATION. ALL DISCREPANCIES MUST BE IMMEDIATELY REPORTED TO THE ENGINEER. CALL BEFORE YOU DIG: 1-800-227-2600.

GREAT AMERICAN CAPITAL 8687 WEST SAHARA AVE. #201 LAS VEGAS, NEVADA 89117 (702)253-5751 FAX (702)360-5594		WRIGHT CIVIL ENGINEERS, INC. 7310 SMOKE RANCH ROAD, SUITE P LAS VEGAS, NEVADA 89128 TEL (702) 233-6400 FAX (702) 233-1164	
KEY MAP		GREAT AMERICAN PLAZA	
DRAWN BY: CJB	DESIGNED BY: JEP	CHECKED BY: SFC	PROJECT NO: CN2210301
SHEET 09-26-02	SHEET 09-26-02	SCALE: NONE	TITLE
PROFESSIONAL ENGINEER STEPHEN W. WRIGHT CIVIL No. 13689 08-22-09			
SHEET 3 OF 15 SHEETS DRAWING NO. 307Y4745			

56859

2ND RELOT