


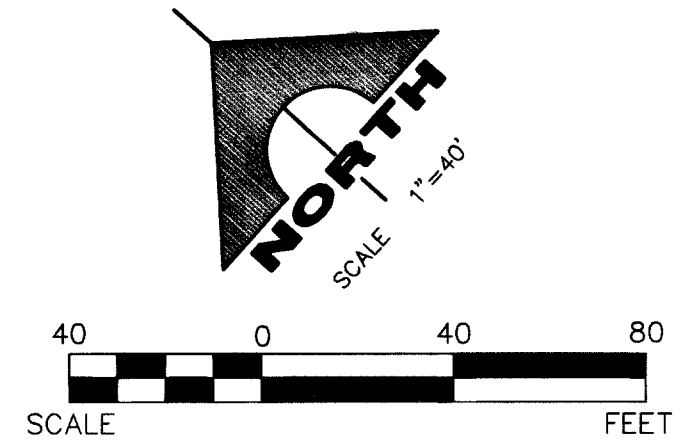


BENCHMARK			
CLV	DESC.	NAVD 88	NAVD 88
BM NO.		DATUM	DATUM
D36B 3	U.S.C. & G.S. BRASS DISC SET IN ROCK ON THE EAST SIDE OF CHARLESTON BOULEVARD AND SOUTH OF THE RED ROCK DETENTION BASIN.	3246.71 (FEET)	989.599 (METERS)

BASIS OF BEARINGS
NORTH 89°45'05" EAST BEING THE SOUTH LINE OF THE SOUTHWEST QUARTER (SW 1/4) OF SECTION 35, TOWNSHIP 20 SOUTH, RANGE 59 EAST, M.D.M., AS SHOWN BY MAP ON FILE IN FILE 91, PAGE 28 OF PARCEL MAPS IN THE CLARK COUNTY RECORDER'S OFFICE, CLARK COUNTY, NEVADA

Call before you Dig.
1-800-227-2600
UNDERGROUND SERVICE (USA)

CALL BEFORE YOU DO OVERHEAD
1-702-593-6111

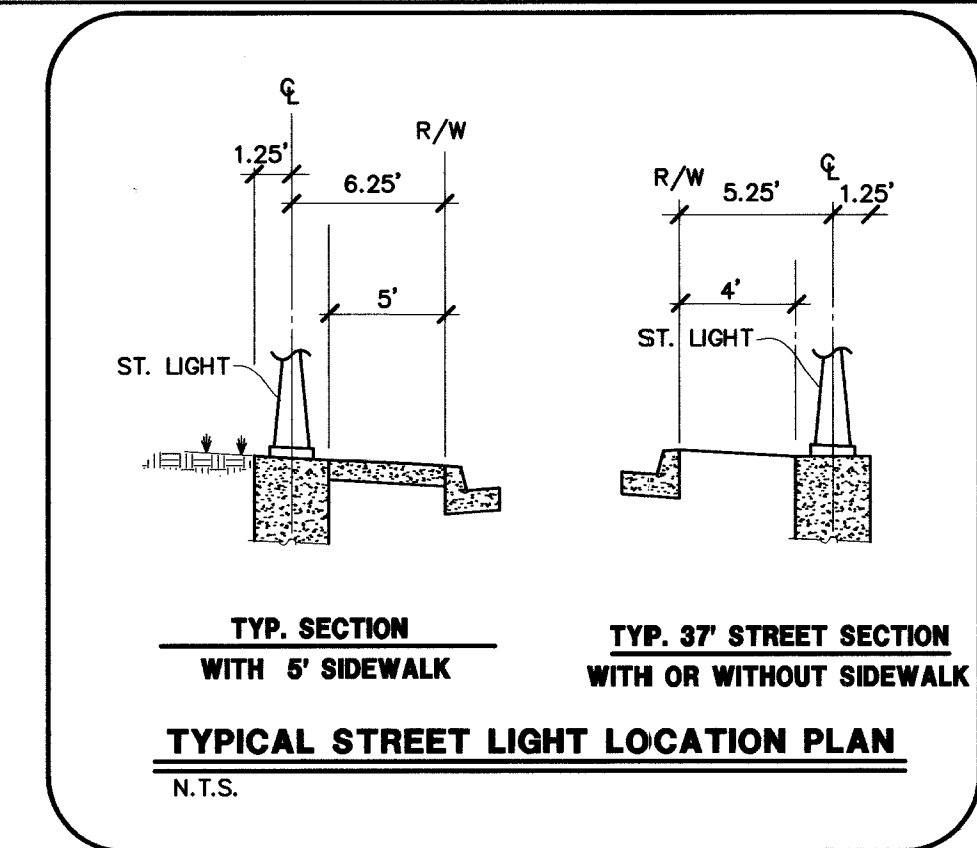


NOTE:
FOR TRAFFIC AND STREET LIGHT NOTES, SEE SHEET C-02.

TRAFFIC AND STREET LIGHTING LEGEND


1	BLOCK NUMBER	EXISTING STREET LIGHT
CONCRETE DRIVEWAY		FUTURE STREET LIGHT
BARRICADE		SUMMERLIN TYPE 3B 100W HPS LUMINAIRE
END OF ROAD MARKER		SUMMERLIN TYPE 3A 150W HPS LUMINAIRE
STREET NAMES		125 AMP 240V PAD MOUNT SERVICE WITH 2-2 POLE 60 AMP CIRCUIT BREAKERS 1-1 POLE 15 AMP CIRCUIT BREAKERS 2-2 POLE 60 AMP CONTACTORS 1 BY PASS SWITCH PER CONTACTOR
STOP SIGN		1 1/4" PVC CONDUIT (ST. LT.)
		NO. 3 1/2 CONCRETE PULL BOX W/ METAL COVER

SIGHT VISIBILITY RESTRICTION ZONE:
NOTHING OVER 24" IN HEIGHT ALLOWED IN SVRZ EXCEPT TRAFFIC CONTROL DEVICES

NOTE: REFER TO SUMMERLIN IMPROVEMENT STANDARDS E-1 AND E-2 FOR STREETLIGHT REQUIREMENTS AND DETAILS

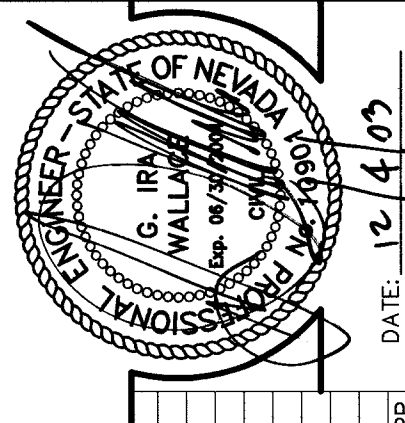

NOTE:
ALL PRIVATE ST. ARE P.U.E.'S, PUBLIC SEWER EASEMENTS AND PUBLIC DRAINAGE EASEMENTS TO BE PRIVATELY MAINTAINED.

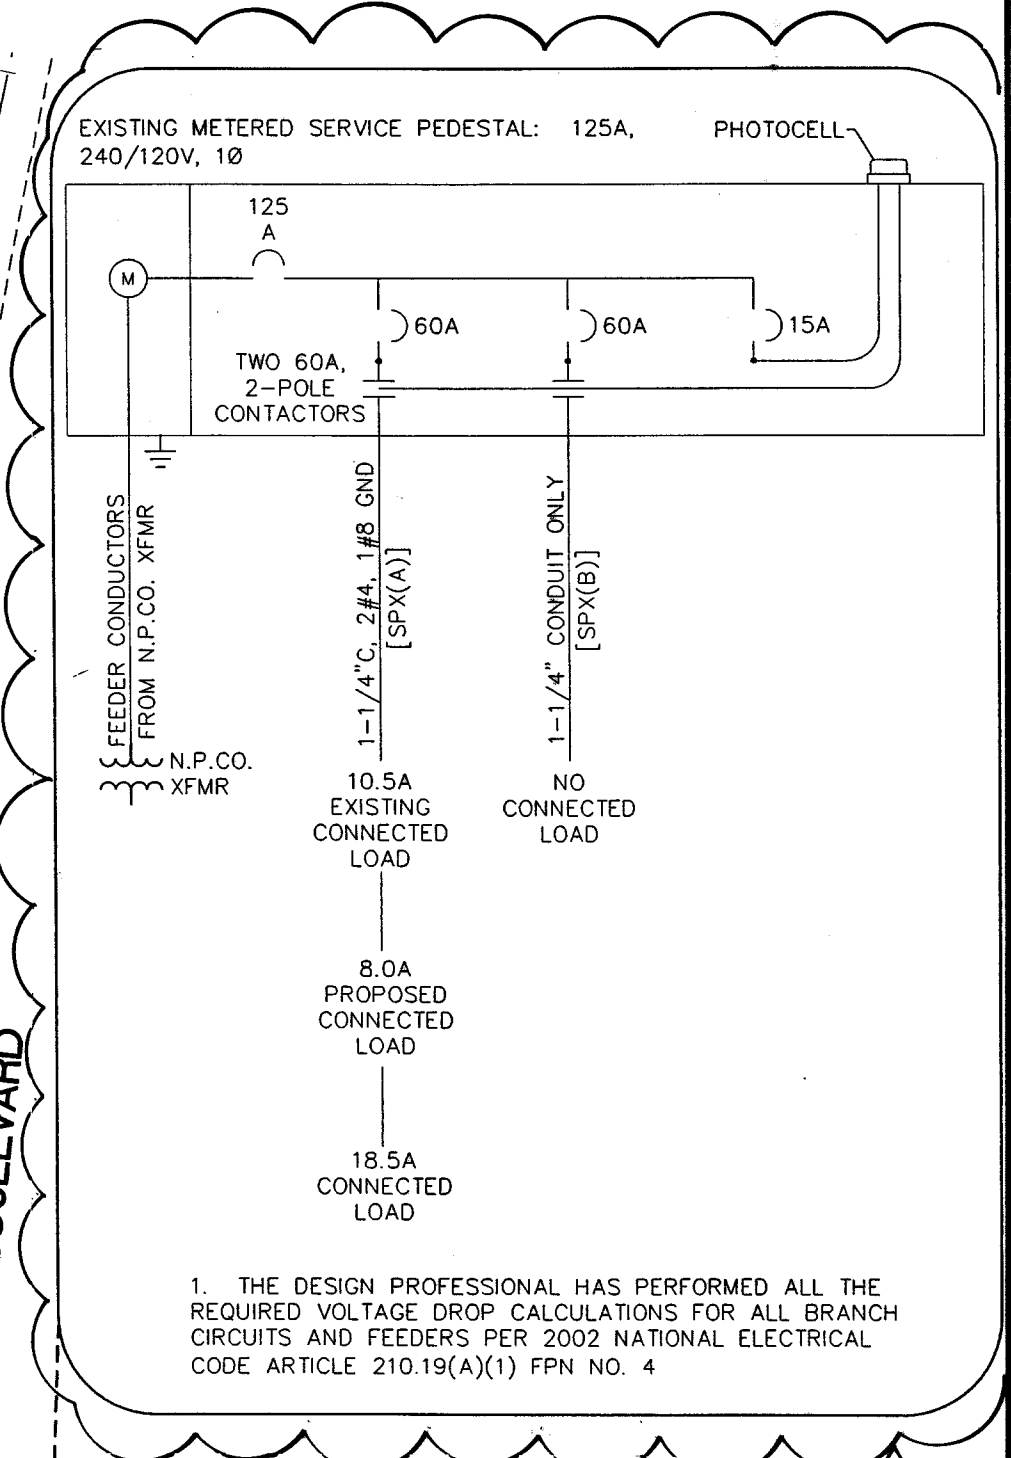

G. C. WALLACE, INC.
Engineers/Planners/Surveyors
1555 SOUTH HANBOW BLVD./AS VEGAS, NEVADA 89146
PHONE: (702) 864-2600 FAX: (702) 864-2299
E: V71-008@wallaceinc.com

WILLIAM LYON HOMES
GRANADA AT SUMMERLIN VILLAGE 23A PARCEL D UNIT NO. 2
TRAFFIC AND STREETLIGHT PLAN

655906m 72955

107Y4765-2