


BACK OF CURB CURVE TABLE

CURVE	LENGTH	RADIUS	TANGENT	DELTA
C1	6.12'	25.00'	3.08'	14°02'10"
C2	6.12'	25.00'	3.08'	14°02'10"
C3	4.13'	25.00'	2.07'	9°27'44"
C4	59.35'	200.75'	29.89'	16°56'17"
C5	63.33'	199.28'	31.93'	18°12'40"
C6	34.13'	149.25'	17.14'	13°06'12"
C7	12.19'	4.25'	30.93'	164°21'02"
C8	3.93'	1.25'	INFINITE	180°00'00"
C9	60.20'	250.75'	30.25'	13°45'23"
C10	60.20'	250.75'	30.25'	12°29'00"
C11	59.35'	200.75'	29.89'	16°56'16"
C12	63.33'	199.28'	31.93'	18°12'39"
C13	31.76'	100.00'	16.01'	18°11'42"
C14	31.76'	100.00'	16.01'	18°11'42"
C15	39.33'	25.00'	25.06'	90°08'17"
C16	39.21'	25.00'	24.94'	89°51'43"

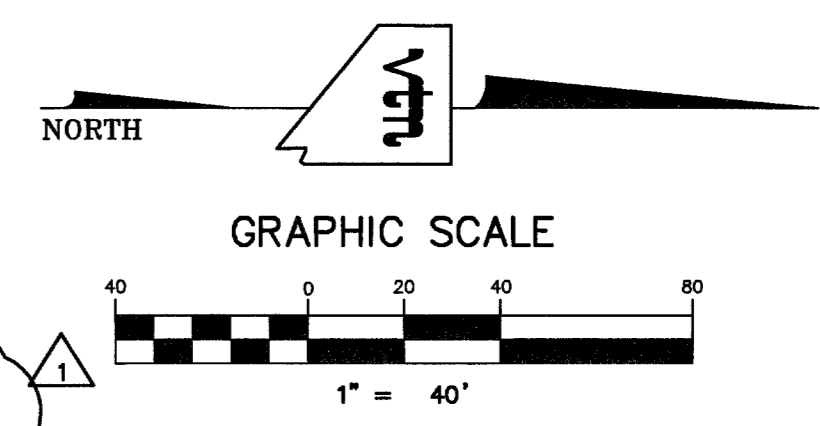

CONTRACTOR NOTE:
CONTRACTOR SHALL VERIFY UTILITIES AND VERTICAL LOCATION OF EXISTING UTILITIES AND NOTIFY THE DESIGN ENGINEER IMMEDIATELY OF ANY DISCREPANCIES PRIOR TO CONSTRUCTION.

CONSTRUCTION NOTES:
 (A) CONSTRUCT "L" TYPE CURB & GUTTER PER STD. DWG. NO. 216
 (B) CONSTRUCT "A" TYPE ISLAND CURB PER STD. DWG. NO. 219
 (C) ADJUST MAN HOLES TO FINISH GRADE

Call before you Dig
 1-702-455-7511
 CLARK COUNTY TRAFFIC OPERATIONS
 1-702-229-6611
 LAS VEGAS AREA COMPUTERIZED TRAFFIC SYSTEM

SIDEWALK RAMPS

NO.	"A"	"B"	CASE
1	8.0'	8.0'	II
2	15.0'	4.5'	II

Call before you Dig
 1-800-227-2600

Call before you Overhead
 1-702-227-2929

BASIS OF BEARINGS:
 THE BASIS OF BEARINGS FOR THIS PROJECT IS NORTH 00°08'16" EAST BEING THE EAST LINE OF THE NORTHWEST QUARTER (NE 1/4) OF THE SECTION 24, TOWNSHIP 19 SOUTH, RANGE 59 EAST, M.D.M., CLARK COUNTY, NEVADA, AS SHOWN ON A RECORD OF SURVEY ON FILE IN THE CLARK COUNTY, NEVADA, RECORDER'S OFFICE IN FILE 123 AT PAGE 32.

PROJECT BENCHMARK:
 PROJECT DATUM: NORTH AMERICAN VERTICAL DATUM OF 1988 (NAVD88)

CLARK COUNTY VERTICAL CONTROL: 1000-6N6
 NAVD88 ELEVATION: 787.794 METERS (2584.62 FEET)

CITY OF LAS VEGAS BENCHMARK:
 DATUM: NORTH AMERICAN VERTICAL DATUM OF 1988 (NAVD88)

CITY OF LAS VEGAS BENCHMARK: BLV99-13S5E
 NAVD88 ELEVATION: 859.606 METERS (2823.03 FEET)

NOTE: ADD 0.34' TO ABOVE CITY OF LAS VEGAS BENCHMARK BLV99-13S5E TO MATCH ORIGINAL PROJECT BENCHMARK, CLARK COUNTY BENCHMARK 1000-6N6 (2584.62 FEET) AS SHOWN ON RECORD OF SURVEY FILE 124 PAGE 94.

"I CERTIFY THAT THIS PLAN IS IN CONFORMANCE WITH THE APPROVED DRAINAGE STUDY ON FILE AT CITY OF LAS VEGAS FOR THIS PROJECT."

DANIEL J. HOOD NO. 12811 DATE 11-13-91

CLIFFS EDGE LLC
 3455 CLIFF SHADOWS PARKWAY, SUITE 280
 LAS VEGAS, NEVADA, 89129
 (702) 777-7121

STREET PLAN & PROFILE
HUALAPAI WAY
 STA. 53+50.00 TO 62+00.00

CLIFFS EDGE / PROVIDENCE
HUALAPAI WAY
DEER SPRINGS TO GRAND TETON

CITY OF LAS VEGAS, NEVADA
 2727 SOUTH RAINBOW BOULEVARD LAS VEGAS, NEVADA 89146-5148
 PH. (702) 873-7550 FAX (702) 962-2597

REVISIONS:

NO.	DATE	BY	REVISION
1	11/8/95	ROM	REV BOVS RADIUS PER INFO CENTER
2			
3			
4			
5			
6			
7			

SCALE: 1" = 40' HORIZ. VERT.

PROFESSIONAL ENGINEER - STATE OF NEVADA
 DANIEL J. HOOD
 NO. 12811

SHEET **ST3**
 6 OF 29 SHEETS
 DRAWING NO. 107426-HW

HTE# 05-19169