



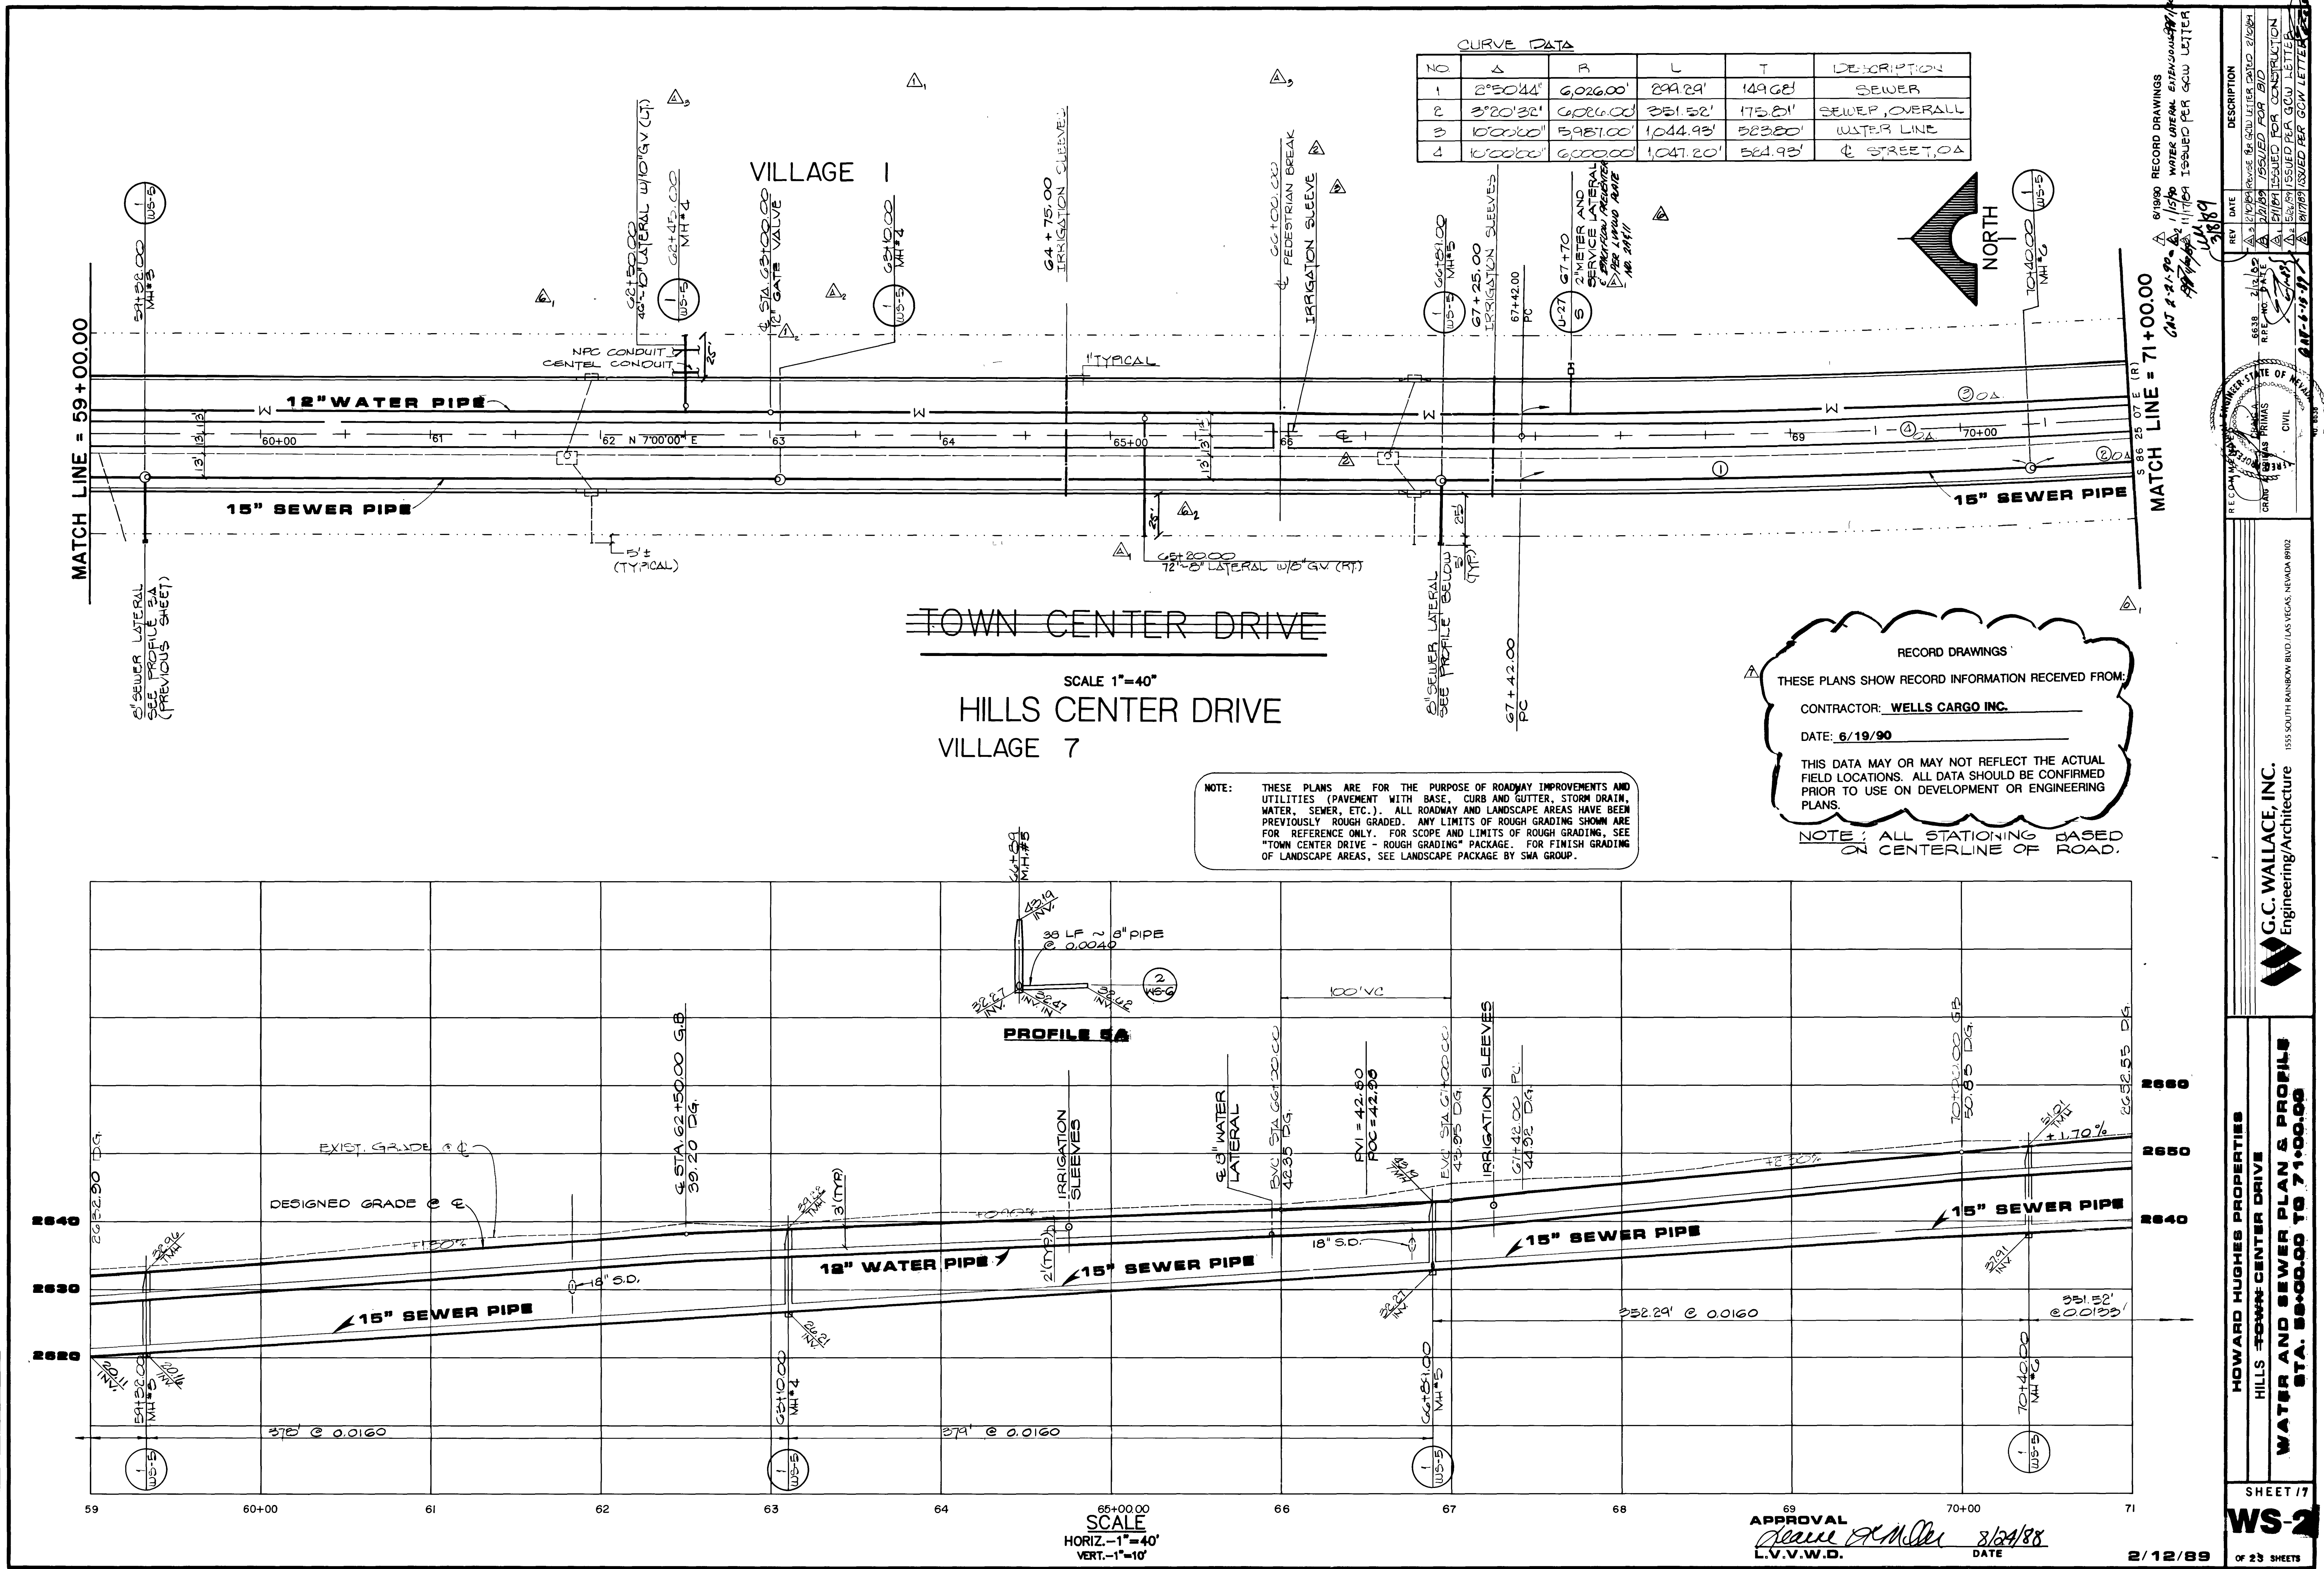


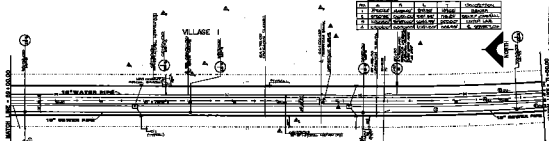

TOWN CENTER DRIVE

HILLS CENTER DRIVE
VILLAGE 7



