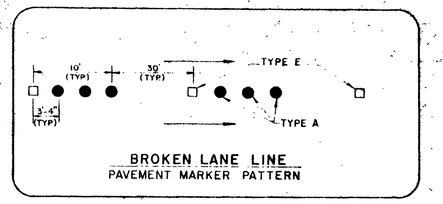

BROKEN LANE LINE
PAVEMENT MARKER PATTERN

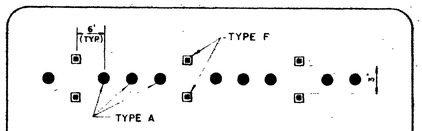

STORAGE LANE LINE
PAVEMENT MARKER PATTERN

SIGN SUMMARY

INST. NO.	STATION	LOC.	MESSAGE	SIGN NO.	PANEL SIZE	NO.	POST TYPE AND SIZE	LENGTH	SIGN AREA SQ. FT.
1	52+35.00	RT.	KEEP RIGHT (SYMBOL)	R4-7	24" X 30"	1	2.5" SQ. METAL	10.5'	5.00
2	52+65.00	LT.	RIGHT LANE MUST TURN RIGHT	R3-7R	30" X 30"	1	2.5" SQ. METAL	10.5'	6.25
3	54+50.00	LT.	RIGHT LANE MUST TURN RIGHT	R3-7R	30" X 30"	1	2.5" SQ. METAL	10.5'	6.25
4	56+00.00	RT.	SPEED LIMIT 35	R2-1	24" X 30"	1	2.5" SQ. METAL	10.5'	5.00
5	65+90.00	LT.	PEDESTRIAN CROSSING	W11A-2	30" X 30"	1	2.5" SQ. METAL	10.5'	6.25
6	66+10.00	RT.	PEDESTRIAN CROSSING	W11A-2	30" X 30"	1	2.5" SQ. METAL	10.5'	6.25
7	76+25.00	LT.	SPEED LIMIT 35	R2-1	24" X 30"	1	2.5" SQ. METAL	10.5'	5.00
8	77+95.00	RT.	RIGHT LANE MUST TURN RIGHT	R3-7R	30" X 30"	1	2.5" SQ. METAL	10.5'	6.25
9	79+60.00	RT.	RIGHT LANE MUST TURN RIGHT	R3-7R	30" X 30"	1	2.5" SQ. METAL	10.5'	6.25
10	79+74.00	LT.	KEEP RIGHT (SYMBOL)	R4-7	24" X 30"	1	2.5" SQ. METAL	10.5'	5.00
11	81+05.00	RT.	KEEP RIGHT (SYMBOL)	R4-7	24" X 30"	1	2.5" SQ. METAL	10.5'	5.00
12	81+20.00	LT.	RIGHT LANE MUST TURN RIGHT	R3-7R	30" X 30"	1	2.5" SQ. METAL	10.5'	6.25
13	83+00.00	LT.	RIGHT LANE MUST TURN RIGHT	R3-7R	30" X 30"	1	2.5" SQ. METAL	10.5'	6.25
14	84+50.00	RT.	SPEED LIMIT 35	R2-1	24" X 30"	1	2.5" SQ. METAL	10.5'	5.00
15	52+36.00	LT.	STOP	R1-1	30" X 30"	1	2.5" SQ. METAL	10.5'	6.25
16	DELETED								
17	DELETED								
18	91+00.00	RT.	YIELD AHEAD (SYMBOL)	W3-2a	36" X 36"	1	2.5" SQ. METAL	10.5'	9.00
19	91+00.00	RT.	YIELD AHEAD (SYMBOL)	W3-2a	36" X 36"	1	2.5" SQ. METAL	10.5'	9.00
20	63+00.00	RT.	PEDESTRIAN CROSS. AHEAD	W11-2	30" X 30"	1	2.5" SQ. METAL	10.5'	6.25
21	69+00.00	LT.	PEDESTRIAN CROSS. AHEAD	W11-2	30" X 30"	1	2.5" SQ. METAL	10.5'	6.25
							TOTAL		116.75

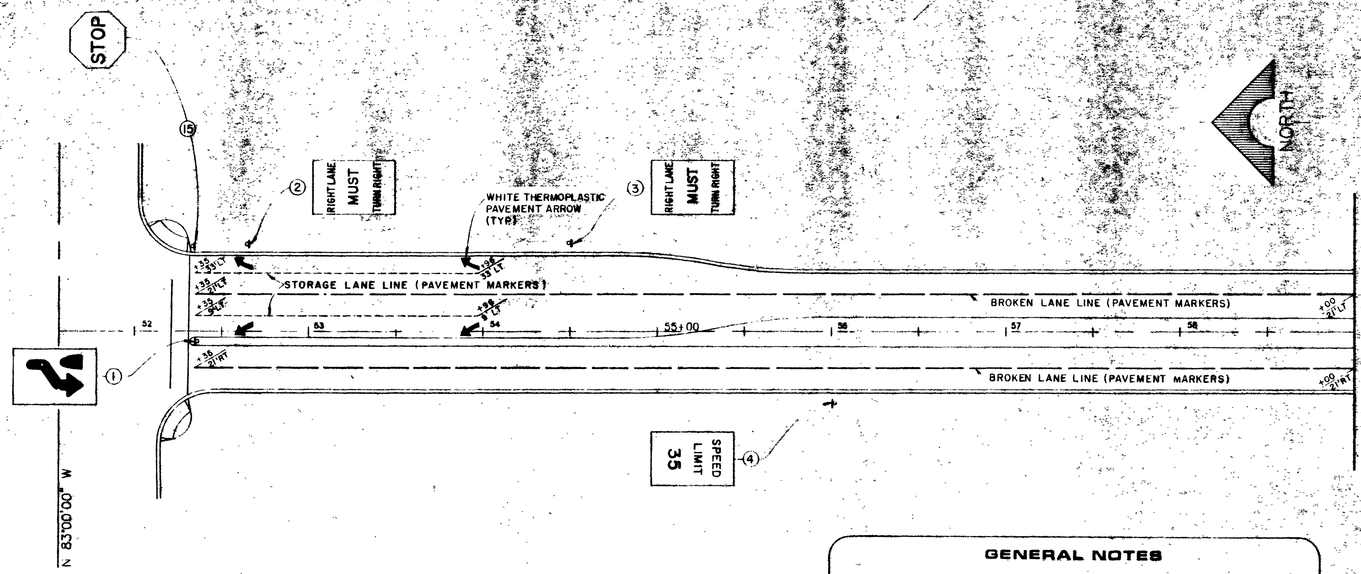

QUANTITIES

PERMANENT SIGNS	134.75 S.F.
TYPE "A" NON-REFLECTIVE PAVEMENT MARKERS	710 EA.
TYPE "E" REFLECTIVE PAVEMENT MARKERS	200 EA
TYPE "F" REFLECTIVE PAVEMENT MARKERS	80 EA.
WHITE PAVEMENT ARROW	12 EA

GENERAL NOTES

1. ALL SIGNS SHALL CONFORM TO THE REQUIREMENTS SET FORTH IN THE MANUAL OF UNIFORM TRAFFIC CONTROL DEVICES, 1978, AND STANDARD HIGHWAY SIGNS WITH NEVADA SUPPLEMENTS, AND SHALL BE MOUNTED ON SUMMERLIN'S STANDARD SIGN POSTS. (SIS DWG. RS-3).
2. SIGN NUMBERS SHOWN ON SIGN SUMMARY ARE TAKEN FROM THE MANUAL ON UNIFORM TRAFFIC CONTROL DEVICES (1978) AND STANDARD HIGHWAY SIGNS-NEVADA SUPPLEMENT.
3. FOR MOUNTING DETAILS NOT SHOWN SEE THE STATE OF NEVADA STANDARD PLANS FOR ROAD AND BRIDGE CONSTRUCTION (1988 REVISED).
4. ALL CONSTRUCTION AND MATERIALS FOR THIS PROJECT SHALL BE IN ACCORDANCE WITH THE MOST RECENT EDITION OF THE STANDARD SPECIFICATIONS FOR ROAD AND BRIDGE CONSTRUCTION, NEVADA DEPARTMENT OF TRANSPORTATION.
5. LOCATIONS OF EXISTING UTILITIES ARE NOT SHOWN. THE CONTRACTOR'S RESPONSIBILITY REGARDING UTILITIES SHALL BE AS REQUIRED IN SECTION 107.17 OF THE STANDARD SPECIFICATIONS.
6. THE CONTRACTOR WILL NOT BE REQUIRED TO MAINTAIN PUBLIC TRAFFIC FOR THIS PROJECT.
7. ALL SIGN LETTERING SHALL BE SERIES E MODIFIED UNLESS OTHERWISE NOTED.

DATE

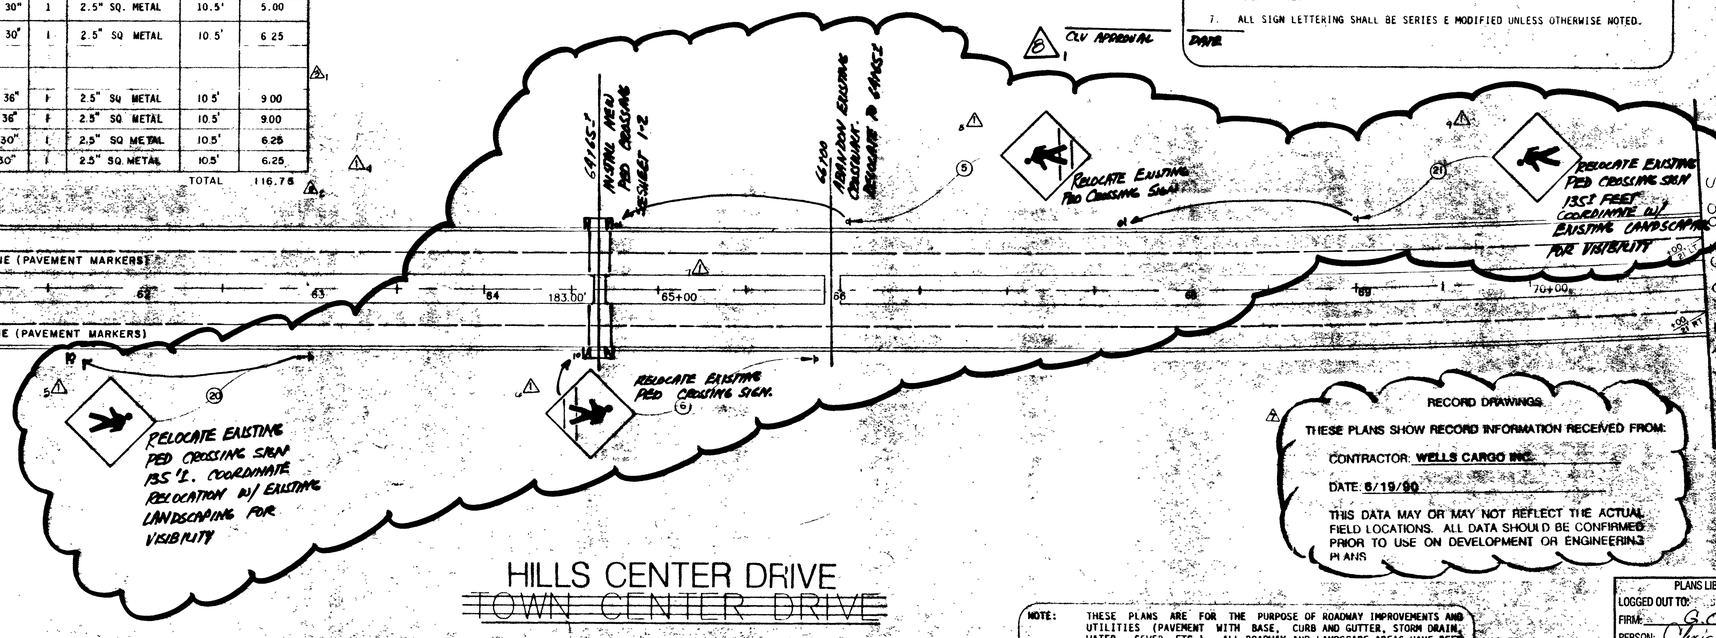

HILLS CENTER DRIVE
~~TOWN CENTER DRIVE~~
SCALE 1"=40'

RECORD DRAWINGS

THESE PLANS SHOW RECORD INFORMATION RECEIVED FROM:

CONTRACTOR: WELLS CARGO INC.

DATE: 6/19/90

THIS DATA MAY OR MAY NOT REFLECT THE ACTUAL FIELD LOCATIONS. ALL DATA SHOULD BE CONFIRMED PRIOR TO USE ON DEVELOPMENT OR ENGINEERING PLANS

NOTE: THESE PLANS ARE FOR THE PURPOSE OF ROADWAY IMPROVEMENTS AND UTILITIES (PAVEMENT WITH BASE, CURB AND GUTTER, STORM DRAIN, WATER, SEWER, ETC.). ALL ROADWAY AND LANDSCAPE AREAS HAVE BEEN PREVIOUSLY ROUGH GRADED. ANY LIMITS OF ROUGH GRADING SHOWN ARE FOR REFERENCE ONLY. FOR SCOPE AND LIMITS OF ROUGH GRADING, SEE "TOWN CENTER DRIVE - ROUGH GRADING" PACKAGE. FOR FINISH GRADING OF LANDSCAPE AREAS, SEE LANDSCAPE PACKAGE BY SWA GROUP.

PLANS LIBRARY
LOGGED OUT TO:
FIRM: G.C.W.
PERSON: Chris Anderson
DATE: 9-14-95

Revised 107-V1639-12/12/89

2-15-95 REVISED PER CHANGE #19

REV	DATE	DESCRIPTION
1	12/1/89	ISSUED FOR BID
2	5/1/90	ISSUED FOR CONSTRUCTION
3	9/17/90	REVISED PER ADD'L LETTER
4	2/17/92	REVISED PER CHANGE #19
5		AS WORK RECORD DRAWINGS

REGISTERED PROFESSIONAL ENGINEER — CIVIL — STATE OF NEVADA

RENEWAL DATE 6-30-96

G.C. WALLACE, INC.
Engineering/Architecture
1555 SOUTH RAINBOW BLVD./LAS VEGAS, NEVADA 89102

HOWARD HUGHES PROPERTIES
HILLS CENTER DRIVE
SIGNS AND STRIPING PLAN

SHEET 22
T-1
OF 25 SHEETS

JOB NO. 620.222

6/84 DIETERICH POST 66328

1981

11-5705

 
SIGN SUMMARY
GENERAL NOTES
HILLS CENTER DRIVE
TOWN CENTER DRIVE