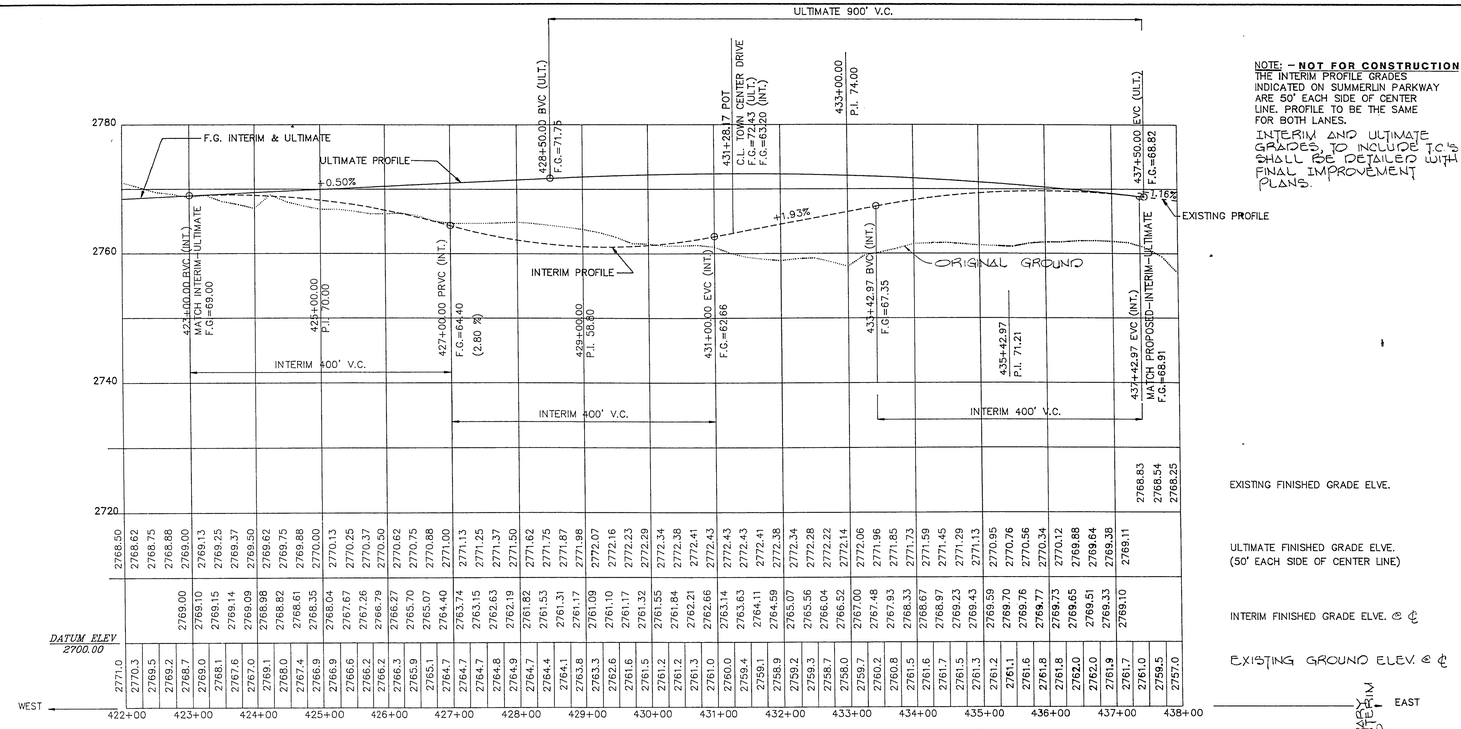

NOTE: – **NOT FOR CONSTRUCTION**
THE INTERIM PROFILE GRADES INDICATED ON SUMMERLIN PARKWAY ARE 50' EACH SIDE OF CENTER LINE. PROFILE TO BE THE SAME FOR BOTH LANES.
INTERIM AND ULTIMATE GRADES, TO INCLUDE TC & SHALL BE DETAILED WITH FINAL IMPROVEMENT PLANS.

SUMMERLIN PARKWAY

SCALE: HORIZ.–1"=100'
VERT.–1"=10'

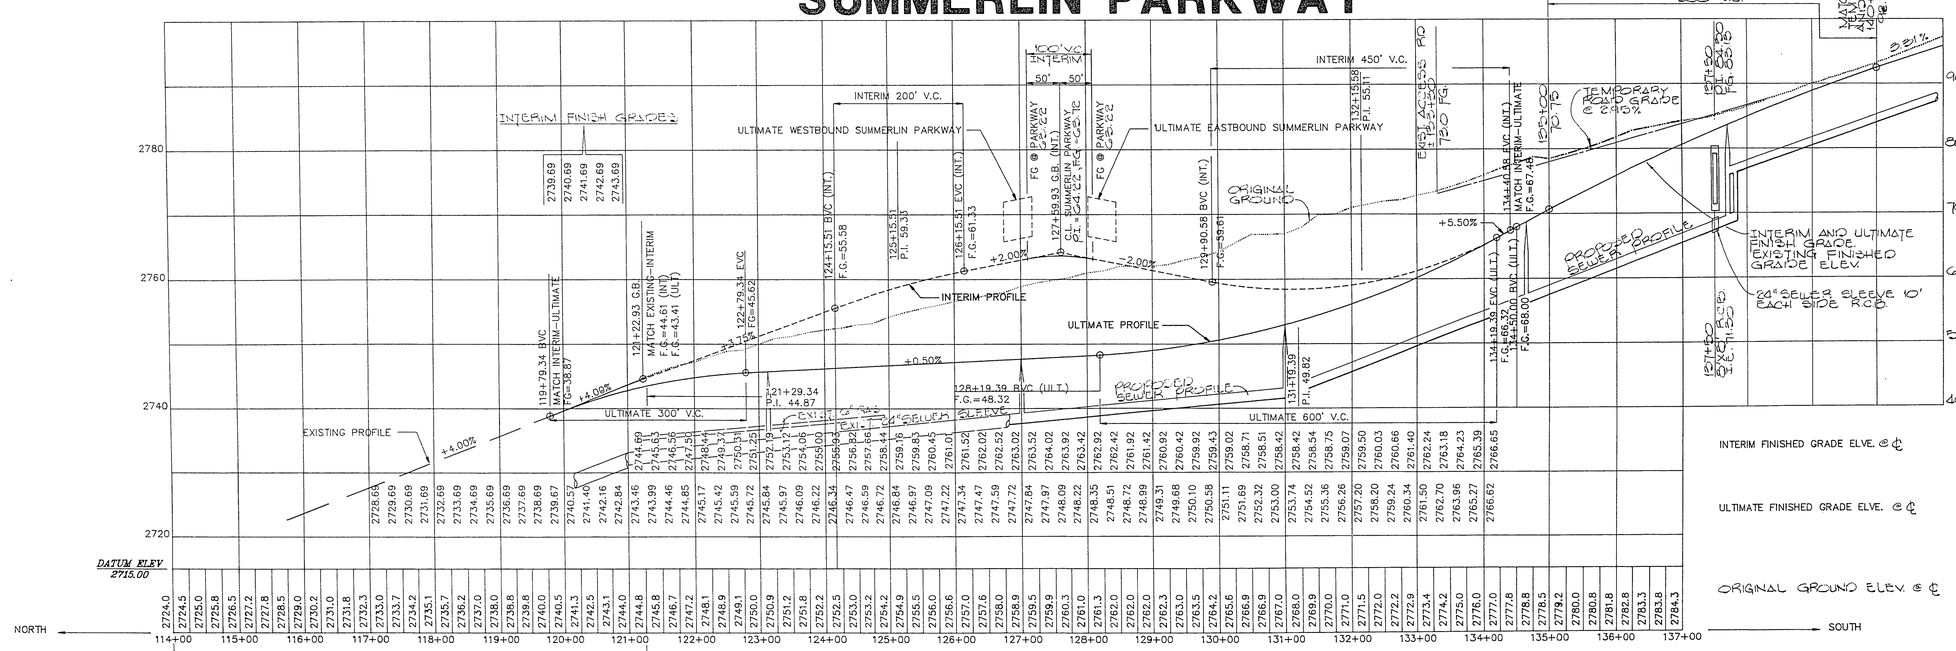

TOWN CENTER DRIVE

SCALE: HORIZ.–1"=100'
VERT.–1"=10'

ELEVATIONS PRIOR TO SUMMERLIN PARKWAY AND TOWN CENTER DRIVE (EXIST.) IMPROVEMENTS

6/30/89

JOB NO. 620.232R

REV.	DATE	DESCRIPTION

RECOMMENDED: CORP. ENGINEERING DIV. — 3834 R.P.E. NO. — DATE

APPROVED: MANAGER, MAINTENANCE & CONSTRUCTION — CIVIL — REGISTERED PROFESSIONAL ENGINEER No. 3834 — STATE OF NEVADA

G.C. WALLACE, INC.
Engineering/Architecture
1555 SOUTH RAINBOW BLVD./LAS VEGAS, NEVADA 89102

HOWARD HUGHES PROPERTIES
TOWN CENTER DRIVE-SUMMERLIN PARKWAY INTERCHANGE
PRELIMINARY PROFILES

SHEET 9 OF 9 SHEETS

107-V1709