


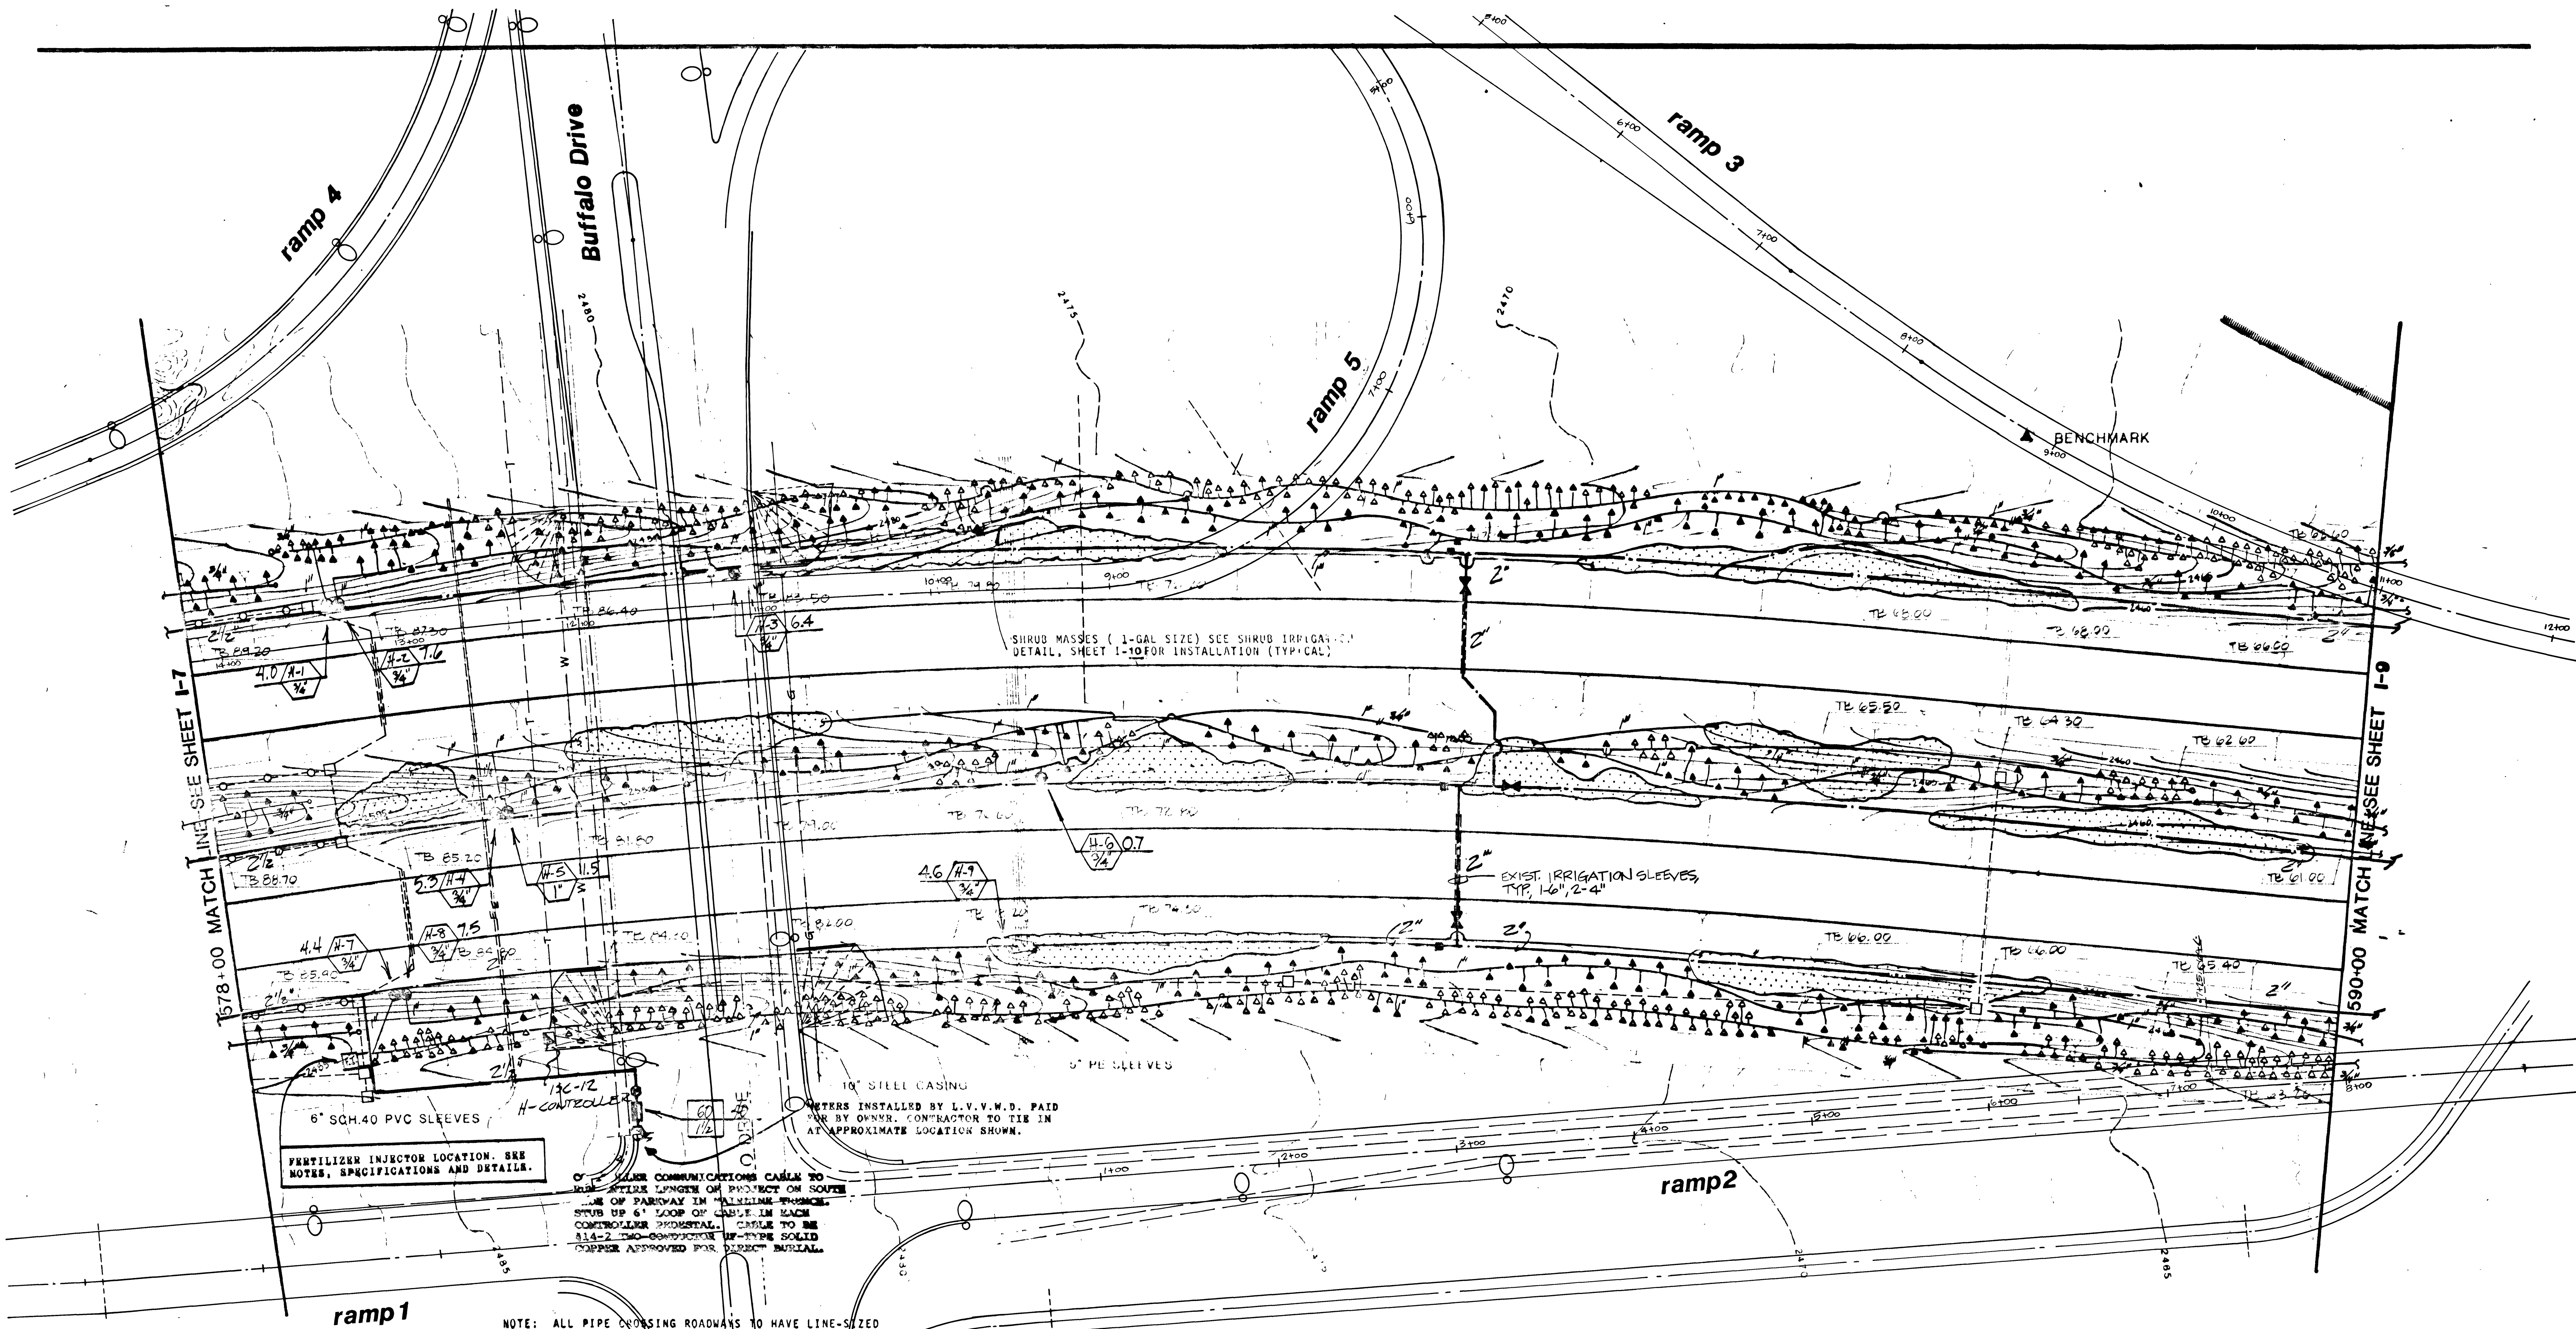

NOTE: ALL PIPE CROSSING ROADWAYS TO HAVE LINE-SIZED GATE VALVE IN ROUND CONCRETE BOX. SCHEDULE 40 PIPE TO BE 1\"/>

PLANT LAYOUT (STAKED OR FLAGGED) MUST BE APPROVED BY LANDSCAPE ARCHITECT PRIOR TO INSTALLATION OF DRIP SYSTEM LATERALS AND EMITTERS. EMITTERS ARE TO BE INSTALLED PER DETAIL AND ON UPHILL SIDE OF ROOTBALL.

FERTILIZER INJECTOR LOCATION. SEE NOTES, SPECIFICATIONS AND DETAILS.

SHRUB MASSES (1-GAL SIZE) SEE SHRUB IRRIGATION DETAIL, SHEET 1-10 FOR INSTALLATION (TYPICAL)

EXIST. IRRIGATION SLEEVES TYP. 1-6\"/>


10\"/>

Irrigation Designs
Water Management & Irrigation Design
50 El Camino Drive, Costa Mesa, CA 94026
(415) 924-4465

Royston Hanamoto
Alley & Abey

Landscape Architects:
Land Planning
Urban Design
Park Planning
Environmental Planning
225 Miller Avenue
Mill Valley
California 94041
415 383-7980

Sheet Title
IRRIGATION PLAN
Project
HUSITE PARKWAY (OFFSITE)
LANDSCAPE CONSTRUCTION DRAWINGS

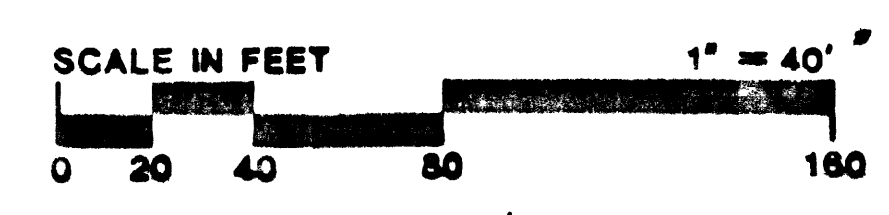


ADDENDUM #1 3/16/92 FOR REFERENCE ONLY

Date OCT. 14, 1988
Job Number 88019
Sheet Number 31
1-3

Donald K. Wilson
State of Nevada Landscape Architect #151

Project Team
A. HANAOTO
R. GUNVILLE
B. STANSTEIN
D. NELSON
H. KRAFT

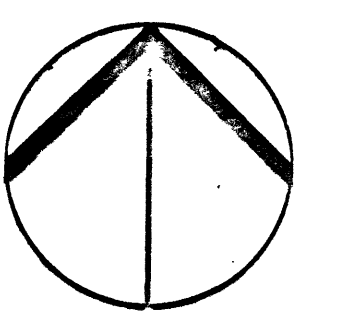

Of 33 Sheets

107-V1592-
107-V1753

