26.5.8

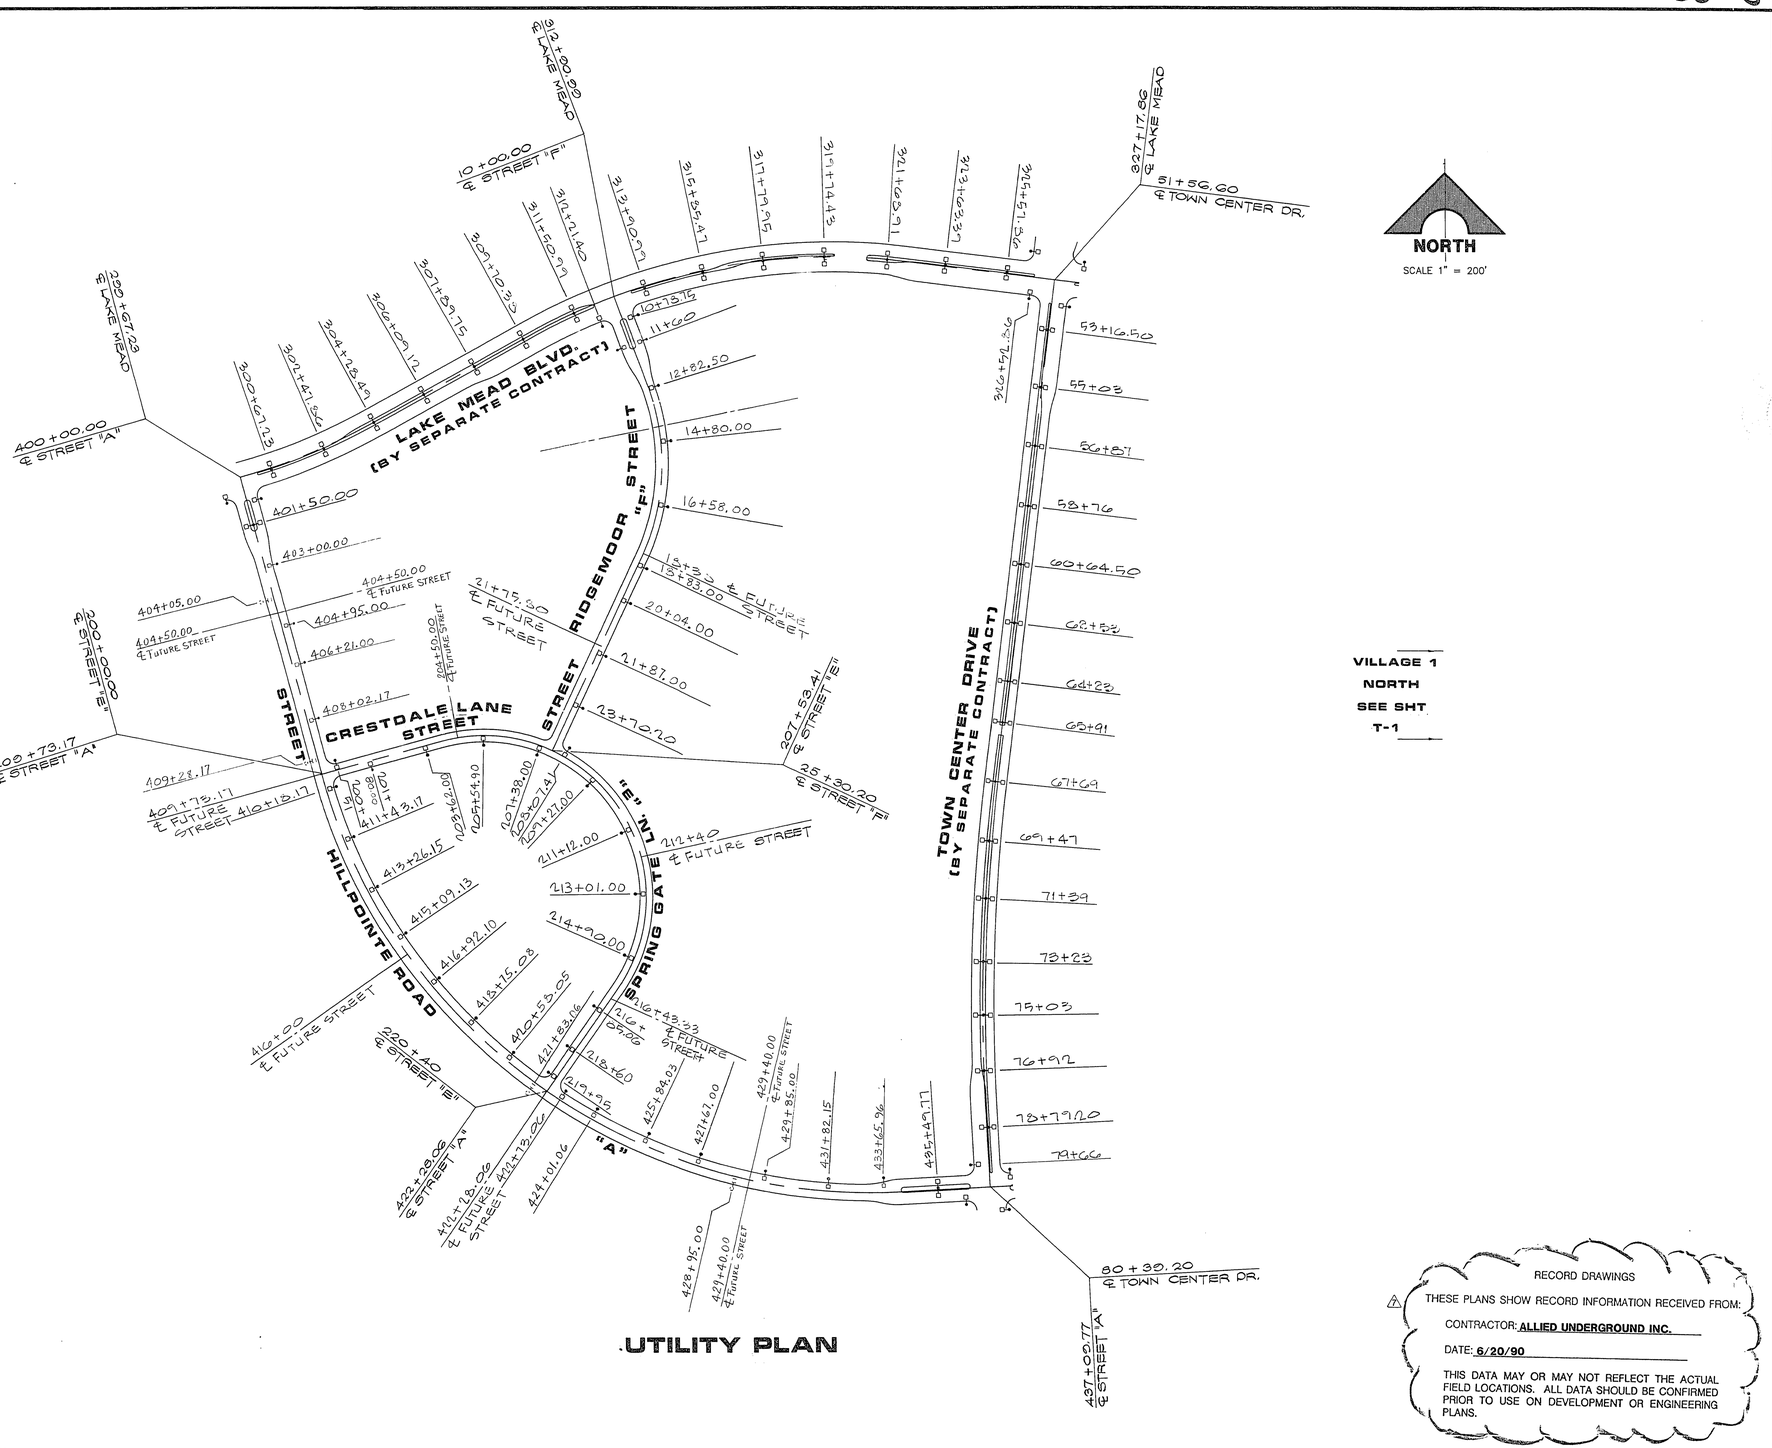

UTILITY PLAN

RECORD DRAWINGS

THESE PLANS SHOW RECORD INFORMATION RECEIVED FROM:

CONTRACTOR: ALLIED UNDERGROUND INC.

DATE: 6/20/90

THIS DATA MAY OR MAY NOT REFLECT THE ACTUAL FIELD LOCATIONS. ALL DATA SHOULD BE CONFIRMED PRIOR TO USE ON DEVELOPMENT OR ENGINEERING PLANS.

REV	DATE	DESCRIPTION
1	11/20/89	REVISION #1
2	12/20/90	RECORD DRAWINGS

RECOMMENDED BY: Christopher W. Anderson
CHRISTOPHER W. ANDERSON R.E. NO. 5071 DATE 9-4-89

G.C. WALLACE, INC.
Engineering/Architecture
1555 SOUTH RAINBOW BLVD. / LAS VEGAS, NEVADA 89102

HOWARD HUGHES PROPERTIES
VILLAGE 1 NORTH
MASTER STREET LIGHT PLAN
VILLAGE 7 NORTH AREA

SHEET
T-2
5 OF 16 SHEETS

JOB NO. 620.314

8/84 DIETERICH-POST 6532B

207-V250