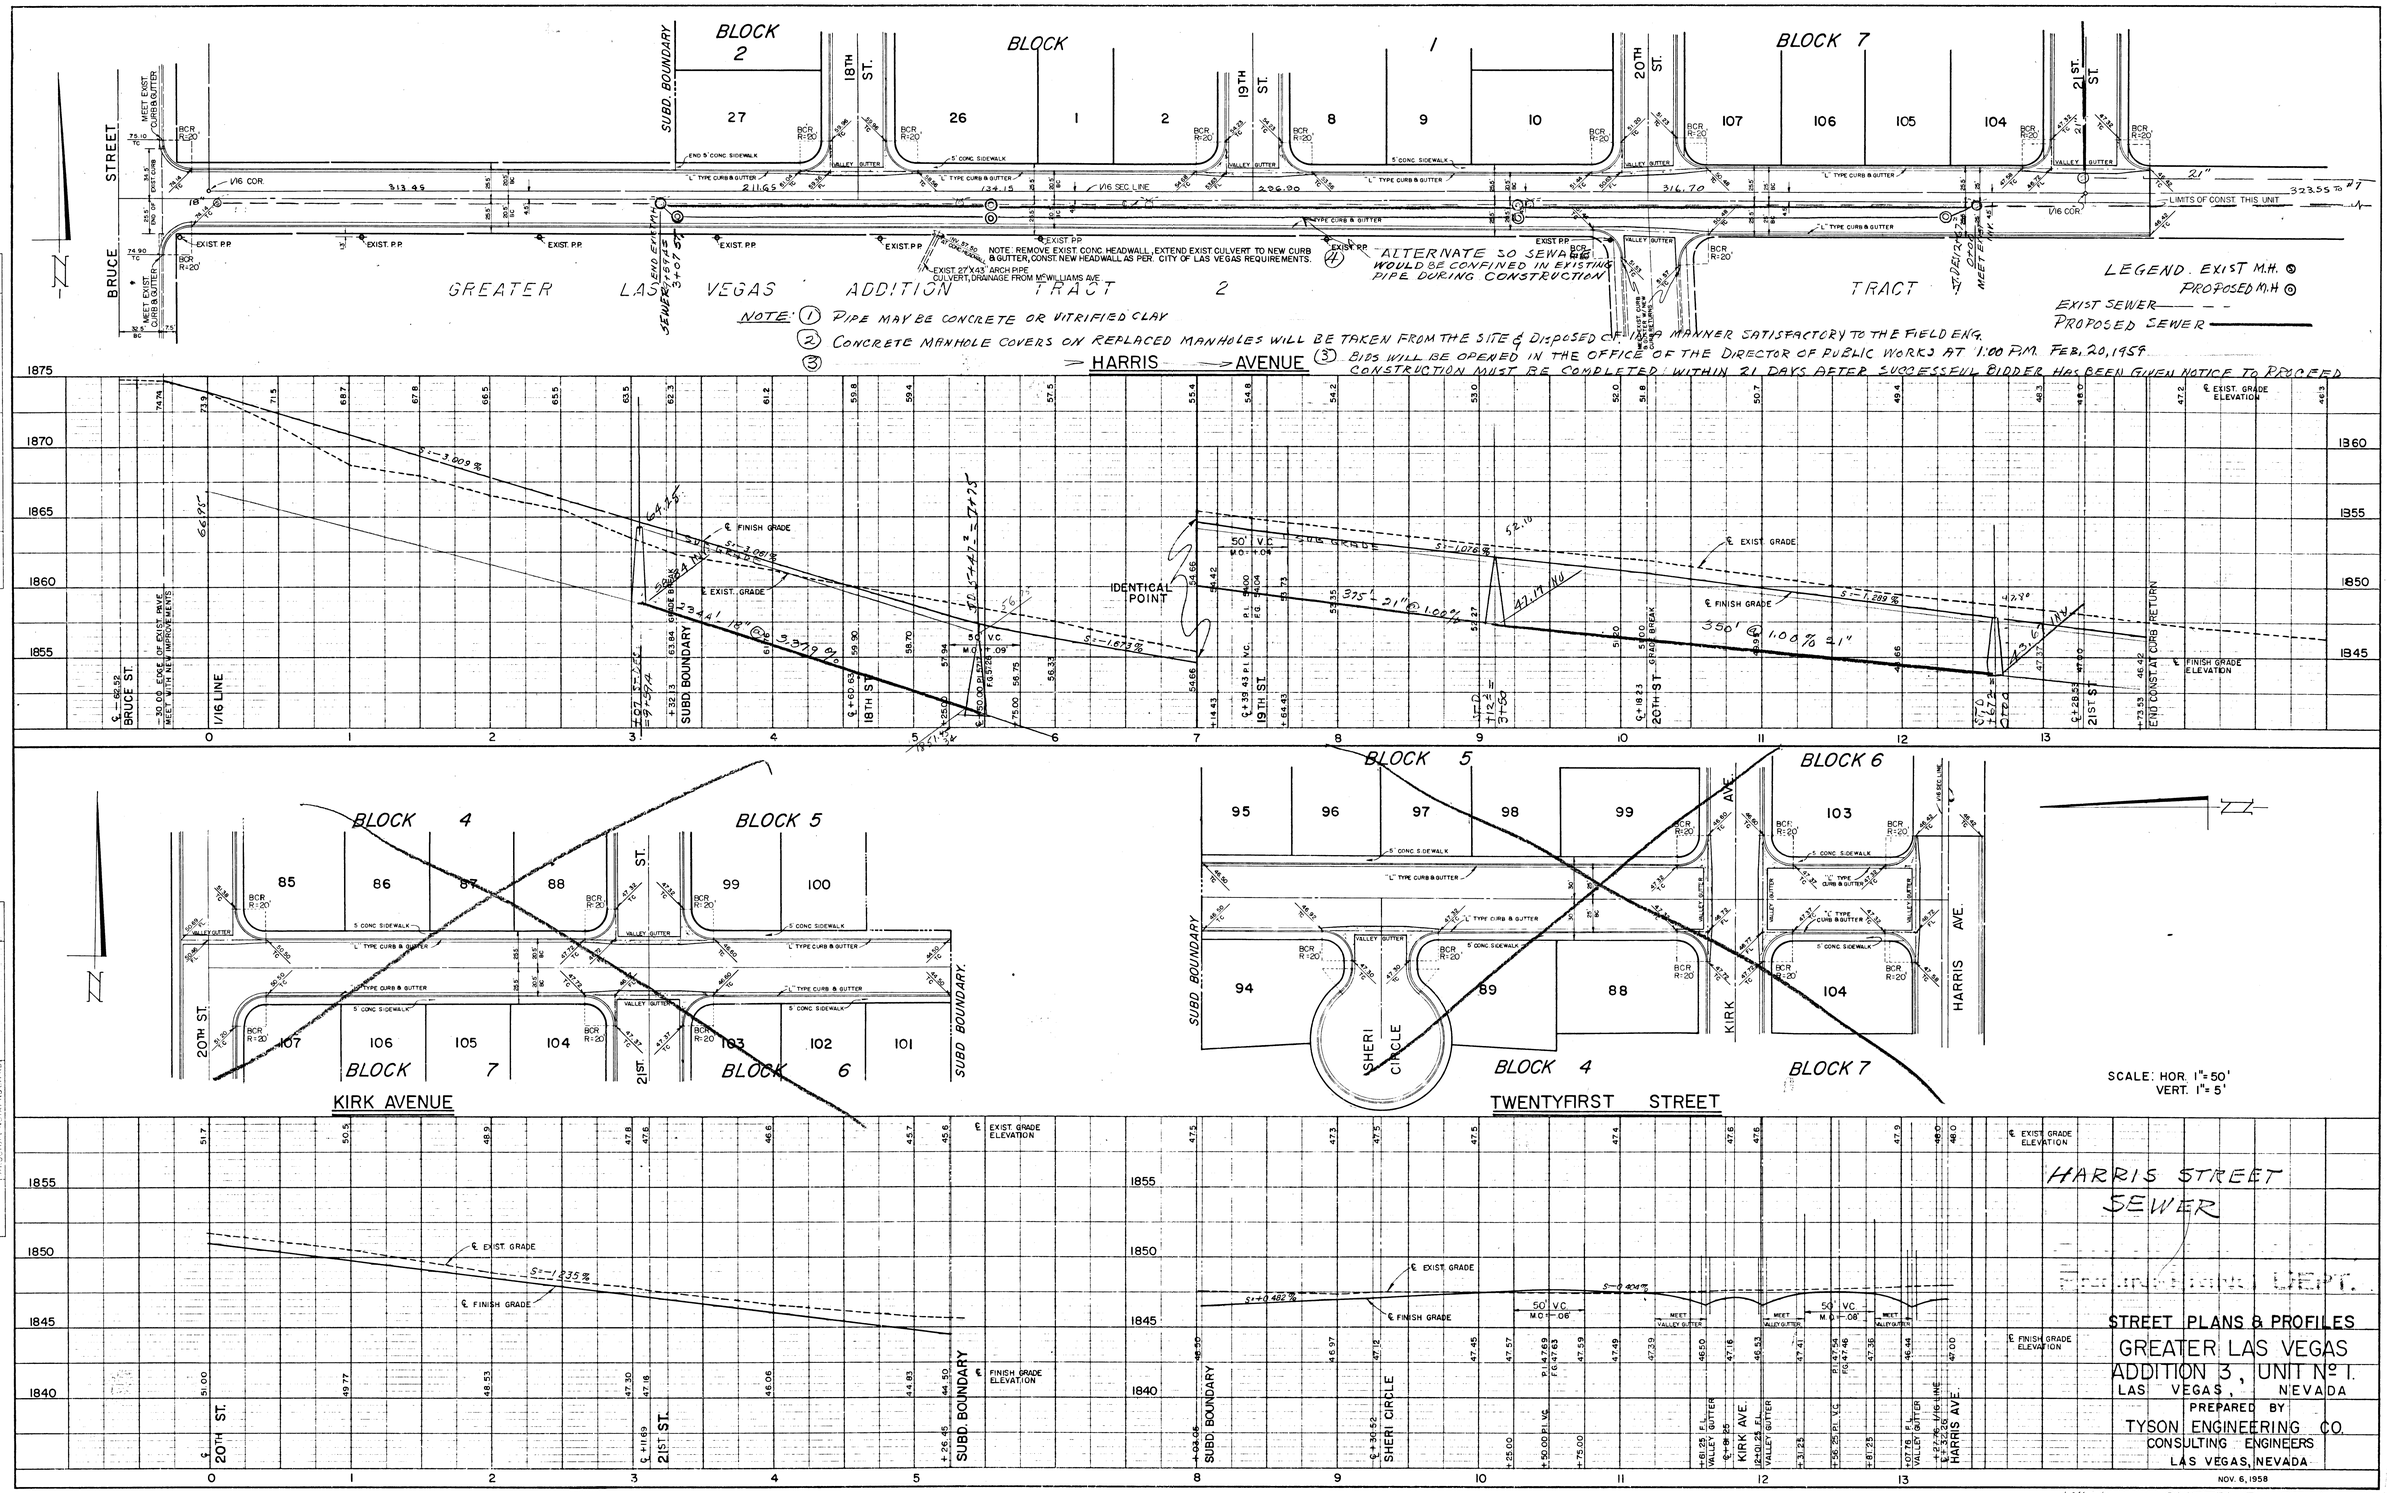
BLOCK 2
BLOCK 1
BLOCK 7
SUBD. BOUNDARY
18TH ST.
19TH ST.
20TH ST.
21ST ST.
BRUCE STREET
GREATER LAS VEGAS ADDITION TRACT 2
TRACT
LIMITS OF CONST. THIS UNIT
ALTERNATE SO SEWER FLOW WOULD BE CONFINED IN EXISTING PIPE DURING CONSTRUCTION
NOTE: REMOVE EXIST. CONC. HEADWALL, EXTEND EXIST CULVERT TO NEW CURB & GUTTER, CONST NEW HEADWALL AS PER CITY OF LAS VEGAS REQUIREMENTS.
EXIST 27"X43" ARCH PIPE CULVERT, DRAINAGE FROM McWILLIAMS AVE
LEGEND: EXIST M.H.
PROPOSED M.H.
EXIST SEWER
PROPOSED SEWER
NOTE: (1) PIPE MAY BE CONCRETE OR VITRIFIED CLAY
(2) CONCRETE MANHOLE COVERS ON REPLACED MANHOLES WILL BE TAKEN FROM THE SITE & DISPOSED OF IN A MANNER SATISFACTORY TO THE FIELD ENG.
(3) BIDS WILL BE OPENED IN THE OFFICE OF THE DIRECTOR OF PUBLIC WORKS AT 1:00 P.M. FEB. 20, 1959
CONSTRUCTION MUST BE COMPLETED WITHIN 21 DAYS AFTER SUCCESSFUL BIDDER HAS BEEN GIVEN NOTICE TO PROCEED
HARRIS AVENUE
IDENTICAL POINT
BLOCK 4
BLOCK 5
BLOCK 6
BLOCK 7
KIRK AVENUE
TWENTYFIRST STREET
SHERI CIRCLE
HARRIS AVE.
SCALE: HOR. 1"=50'
VERT. 1"=5'
HARRIS STREET SEWER
STREET PLANS & PROFILES
GREATER LAS VEGAS ADDITION 3, UNIT No. 1
LAS VEGAS, NEVADA
PREPARED BY
TYSON ENGINEERING CO.
CONSULTING ENGINEERS
LAS VEGAS, NEVADA
NOV. 6, 1958
SHEET 3 OF 4
307-V240
14-1-47