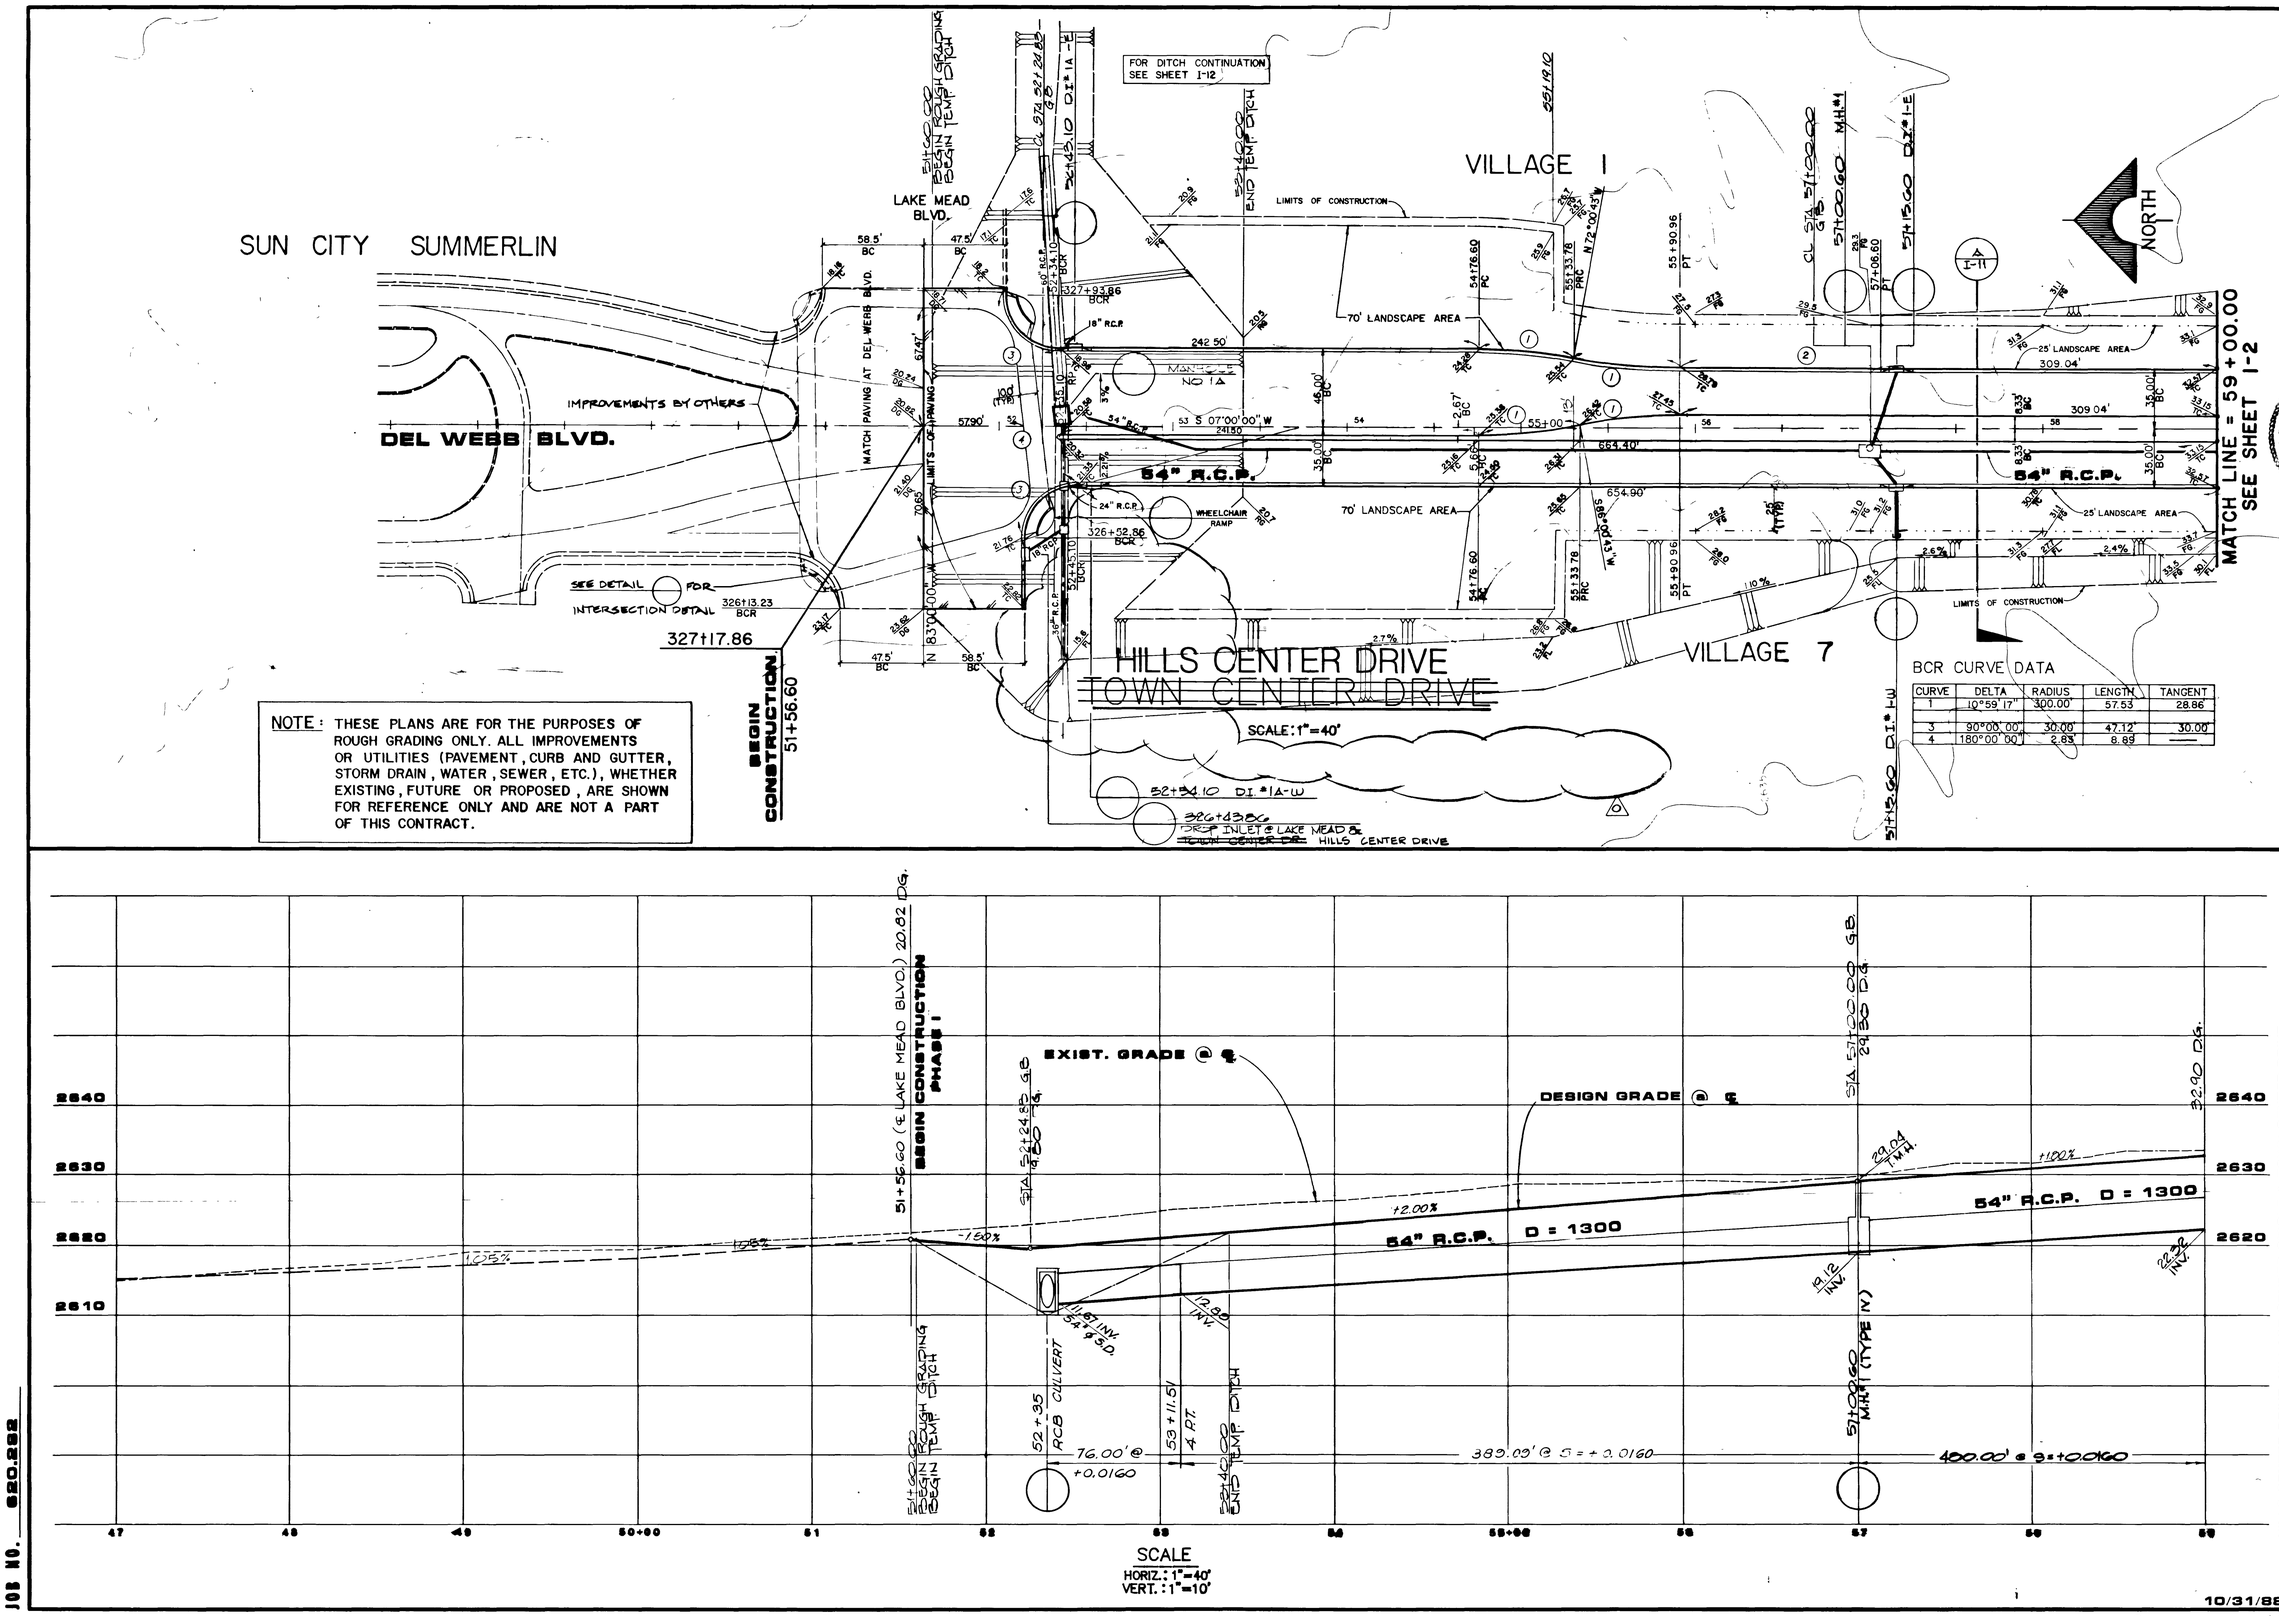

NOTE: THESE PLANS ARE FOR THE PURPOSES OF ROUGH GRADING ONLY. ALL IMPROVEMENTS OR UTILITIES (PAVEMENT, CURB AND GUTTER, STORM DRAIN, WATER, SEWER, ETC.), WHETHER EXISTING, FUTURE OR PROPOSED, ARE SHOWN FOR REFERENCE ONLY AND ARE NOT A PART OF THIS CONTRACT.

REV	DATE	DESCRIPTION
1	11/21/88	ISSUED FOR BID
2	12/23/88	ISSUED FOR CONSTRUCTION

R.E. COMPANY: 6638 R.E. NO. DATE 11/21/88
CHARLES A. PRUNK, JR. REGISTERED PROFESSIONAL ENGINEER STATE OF NEVADA 6638 CIVIL

G.C. WALLACE, INC.
Engineering/Architecture
1555 SOUTH RAINBOW BLVD / LAS VEGAS, NEVADA 89102

HILLS CENTER DRIVE, VILLAGE CENTER CIRCLE & TOWN CENTER DRIVE

HOWARD HUGHES PROPERTIES
ROUGH GRADING
PLAN & PROFILE
STA. 51+56.60 TO STA. 59+00.00

SHEET 1-1 OF 15 SHEETS

10/31/88

JOB NO. 620.282

9-2-52 107-V2094

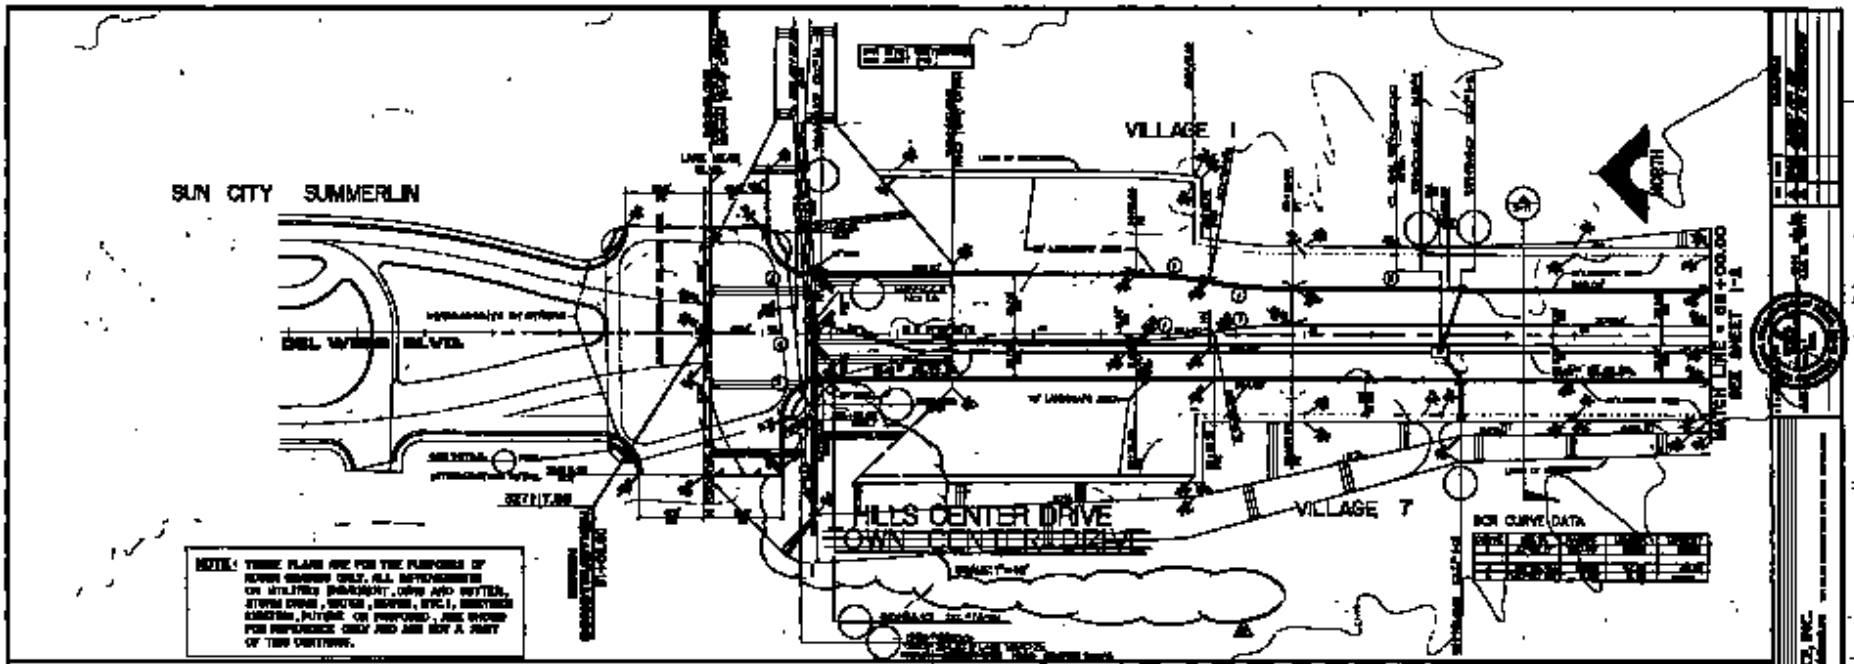

 

G.C. WALLACE, INC.
Engineering Consultants

HILLS CENTER DRIVE, VILLAGE CENTER CIRCLE & TOWN CENTER DRIVE
HOWARD HUGHES PROPERTIES
PLAN & PROFILE

SHEET
1-1

9-2-69