



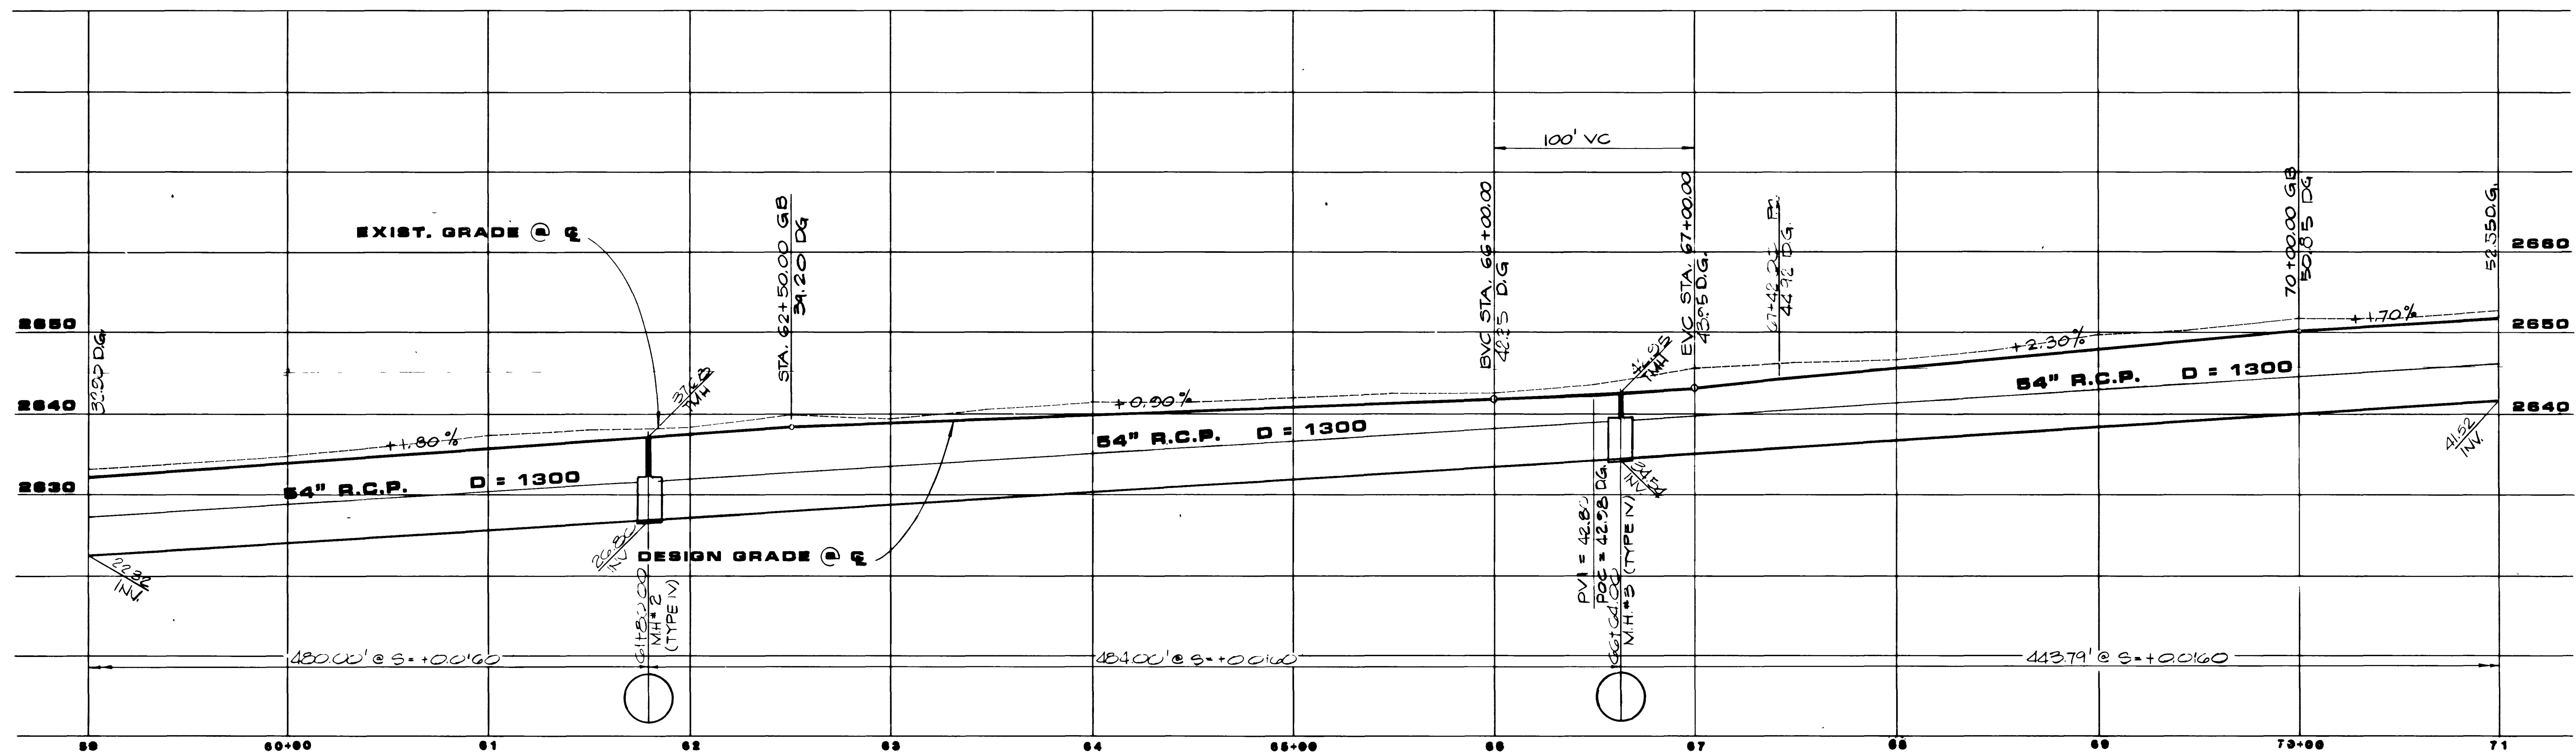

SCALE
HORIZ. 1"=40'
VERT. 1"=10'

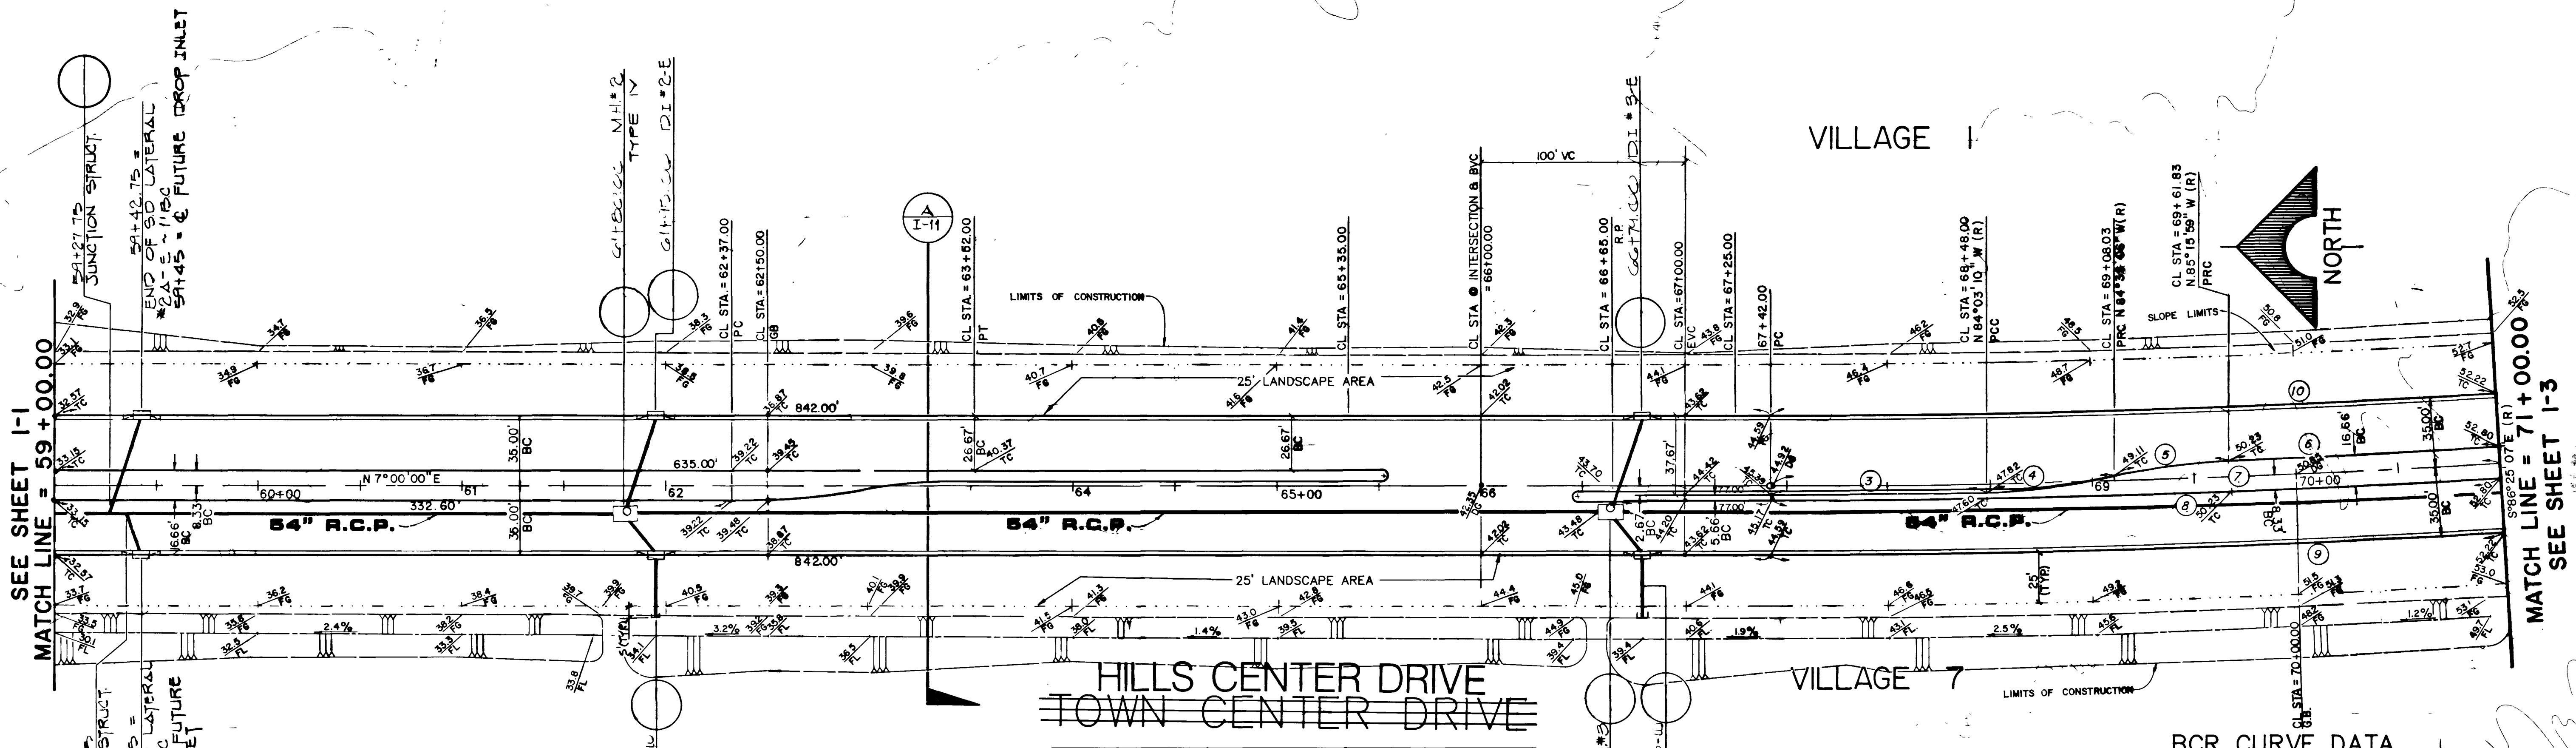

NOTE: THESE PLANS ARE FOR THE PURPOSES OF
ROUGH GRADING ONLY. ALL IMPROVEMENTS
OR UTILITIES (PAVEMENT, CURB AND GUTTER,
STORM DRAIN, WATER, SEWER, ETC.), WHETHER
EXISTING, FUTURE OR PROPOSED, ARE SHOWN
FOR REFERENCE ONLY AND ARE NOT A PART
OF THIS CONTRACT.

SCALE: 1"=40'

CURVE NO.	DELTA	RADIUS	LENGTH	TANGENT
1	11°02'57"	300.00'	57.85'	29.02'
2	180°00'00"	2.83'	8.89'	
3	01°00'44"	6002.67'	106.04'	53.02'
4	11°32'13"	300.00'	60.41'	30.31'
5	10°19'16"	300.00'	54.04'	27.09'
6	01°18'54"	5991.67'	137.51'	68.70'
7	03°25'07"	6008.33'	358.60'	179.08'
8	03°25'07"	6035.00'	360.09'	180.10'
9	03°25'07"	5965.00'	355.91'	178.00'

