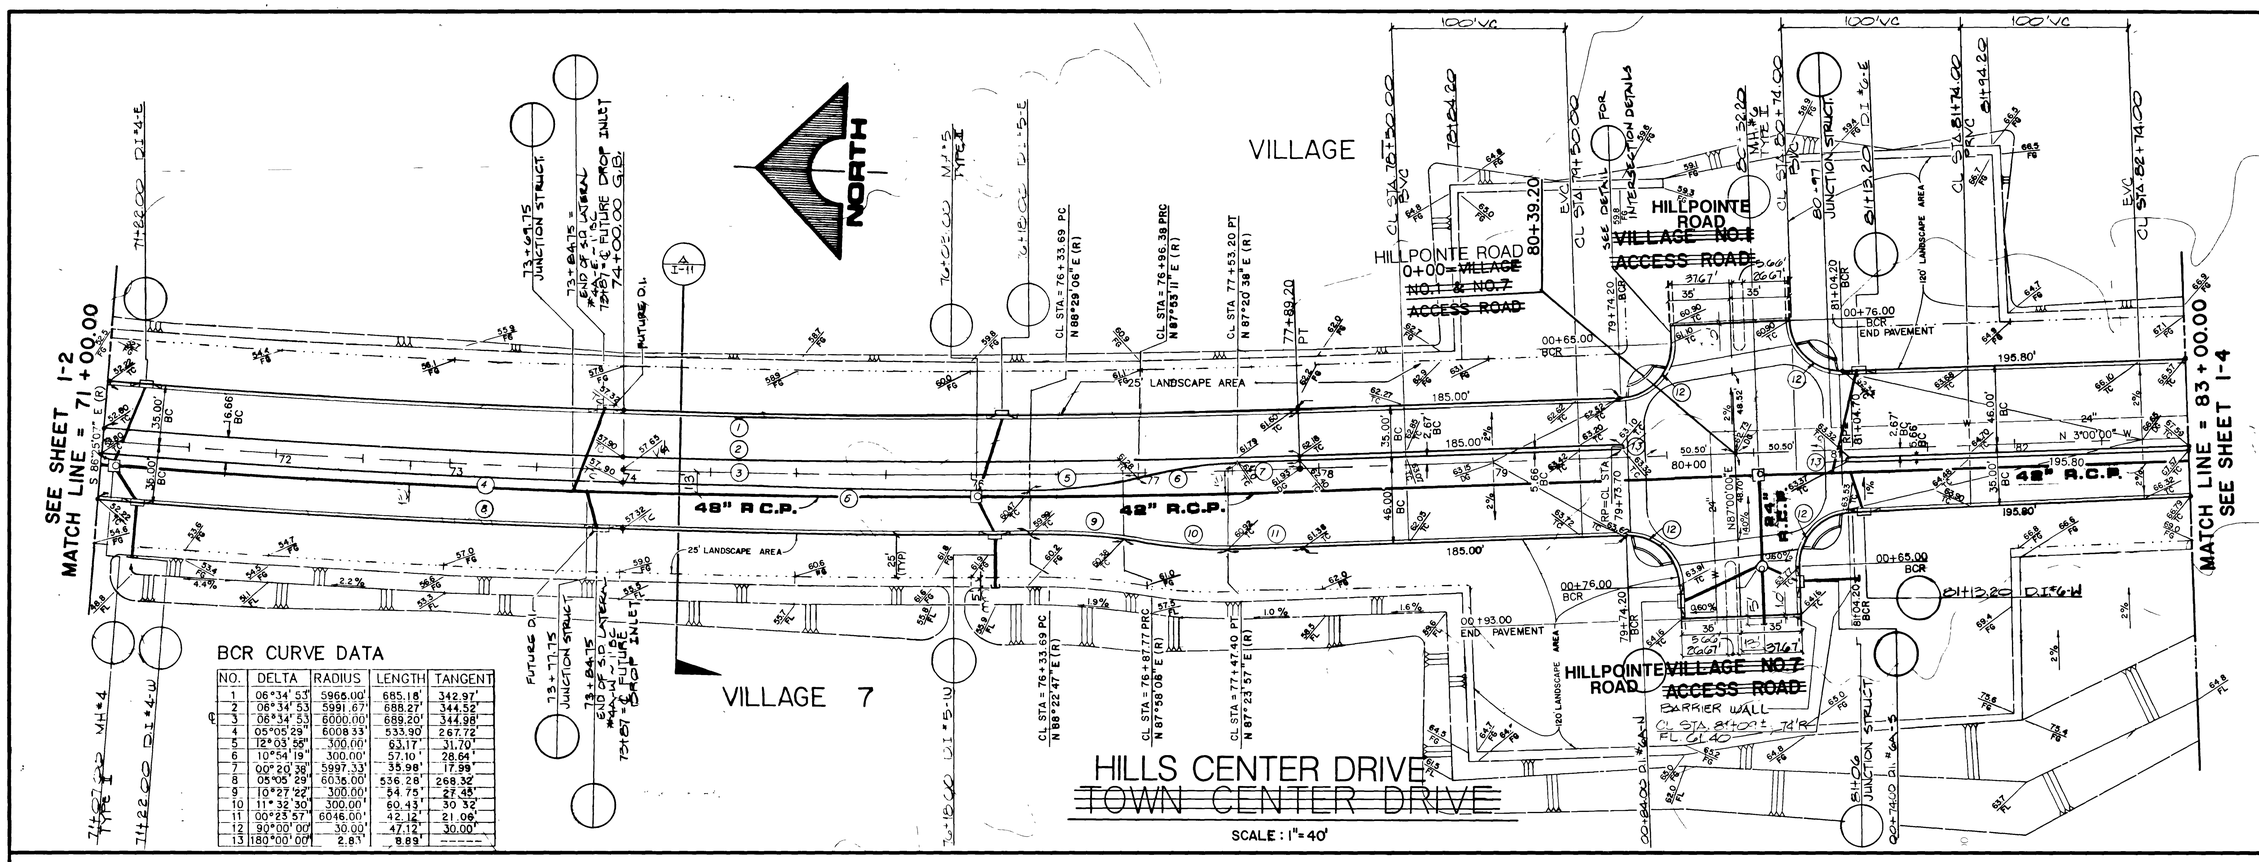

BCR CURVE DATA

NO.	DELTA	RADIUS	LENGTH	TANGENT
1	06°34'53"	5965.00'	685.18'	342.97'
2	06°34'53"	5991.67'	688.27'	344.52'
3	06°34'53"	6000.00'	689.20'	344.98'
4	05°05'29"	6008.33'	533.90'	267.72'
5	12°03'55"	300.00'	63.17'	31.70'
6	10°54'19"	300.00'	57.10'	28.64'
7	00°20'38"	5997.33'	35.98'	17.99'
8	05°05'29"	6036.00'	536.28'	268.32'
9	10°27'22"	300.00'	54.75'	27.43'
10	11°32'30"	300.00'	60.43'	30.32'
11	00°23'57"	6046.00'	42.12'	21.06'
12	90°00'00"	30.00'	47.12'	30.00'
13	180°00'00"	2.83'	8.89'	------

NOTE: THESE PLANS ARE FOR THE PURPOSES OF ROUGH GRADING ONLY. ALL IMPROVEMENTS OR UTILITIES (PAVEMENT, CURB AND GUTTER, STORM DRAIN, WATER, SEWER, ETC.), WHETHER EXISTING, FUTURE OR PROPOSED, ARE SHOWN FOR REFERENCE ONLY AND ARE NOT A PART OF THIS CONTRACT.

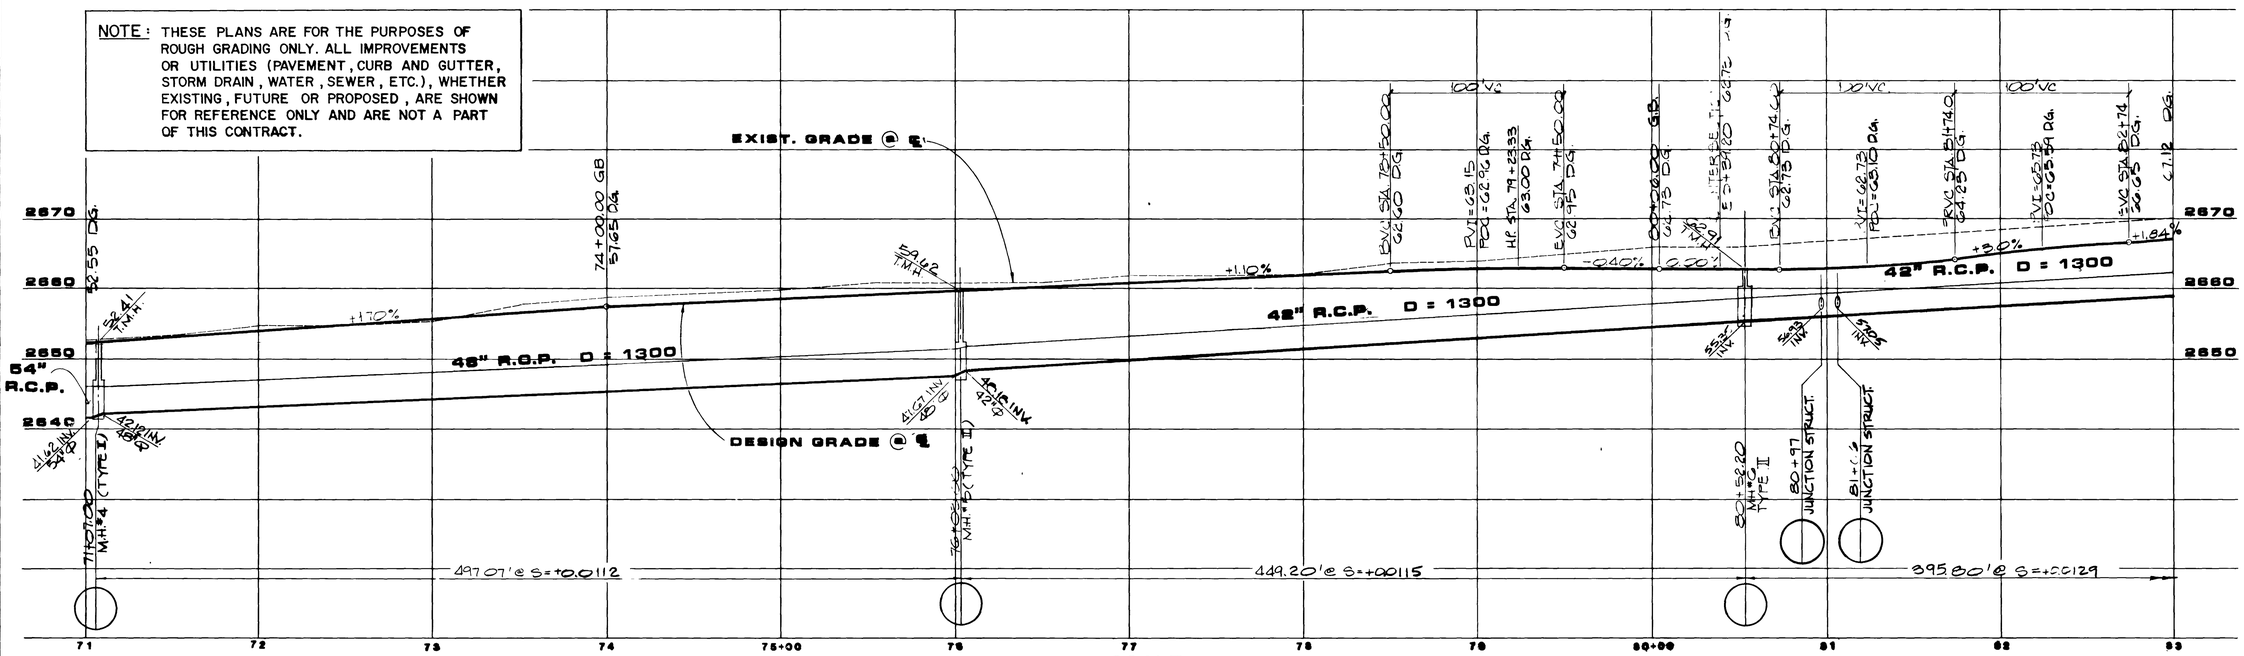

SCALE
HORIZ.: 1"=40'
VERT.: 1"=10'

REV	DATE	DESCRIPTION
1	11/29/88	ISSUED FOR BID
2	12/23/88	ISSUED FOR CONSTRUCTION

REGISTERED PROFESSIONAL ENGINEER 6639 R.E. NO. DATE 11/29/88 GRADY L. WALLACE

G.C. WALLACE, INC.
Engineering/Architecture
1555 SOUTH RAINBOW BLVD / LAS VEGAS, NEVADA 89102

HILLS CENTER DRIVE, VILLAGE CENTER CIRCLE & TOWN CENTER DRIVE

HOWARD HUGHES PROPERTIES
ROUGH GRADING
PLAN & PROFILE
STA.71+00.00 TO STA.83+00.00

SHEET 1-3 OF 15 SHEETS

10/31/88

JOB NO. 620.282

9-2-54 107-V2094

VILLAGE

VILLAGE 7

HILLS CENTER DRIVE

~~TOWN CENTER DRIVE~~

SCALE: 1"=40'

BCR CURVE DATA

NO.	DELTA	RADIUS	LENGTH	TANGENT


SCALE
HORIZ.: 1"=40'
VERT.: 1"=10'

W.C.C. WALLACE, INC.

1-3

4-2-94