
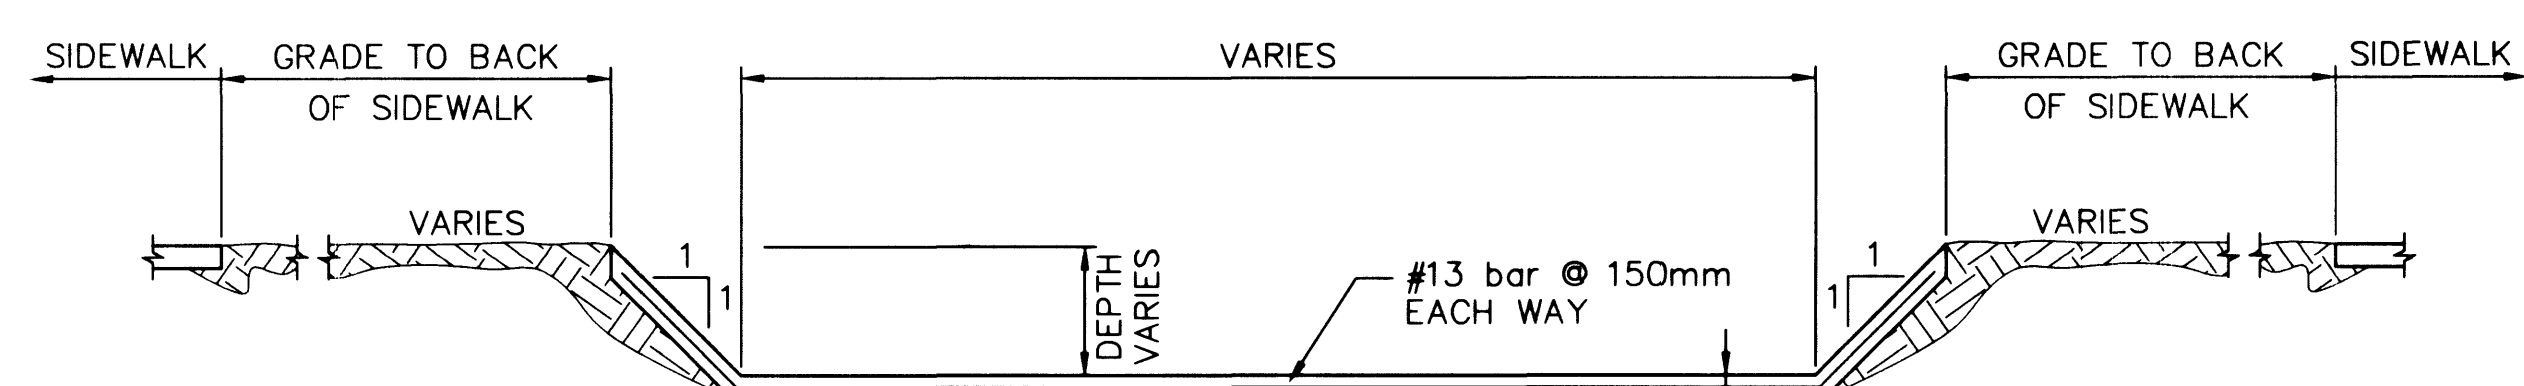


K:\31604\ADDEND\SHITS\R-08.DWG GHANEM 01/31/02 TT:

43258

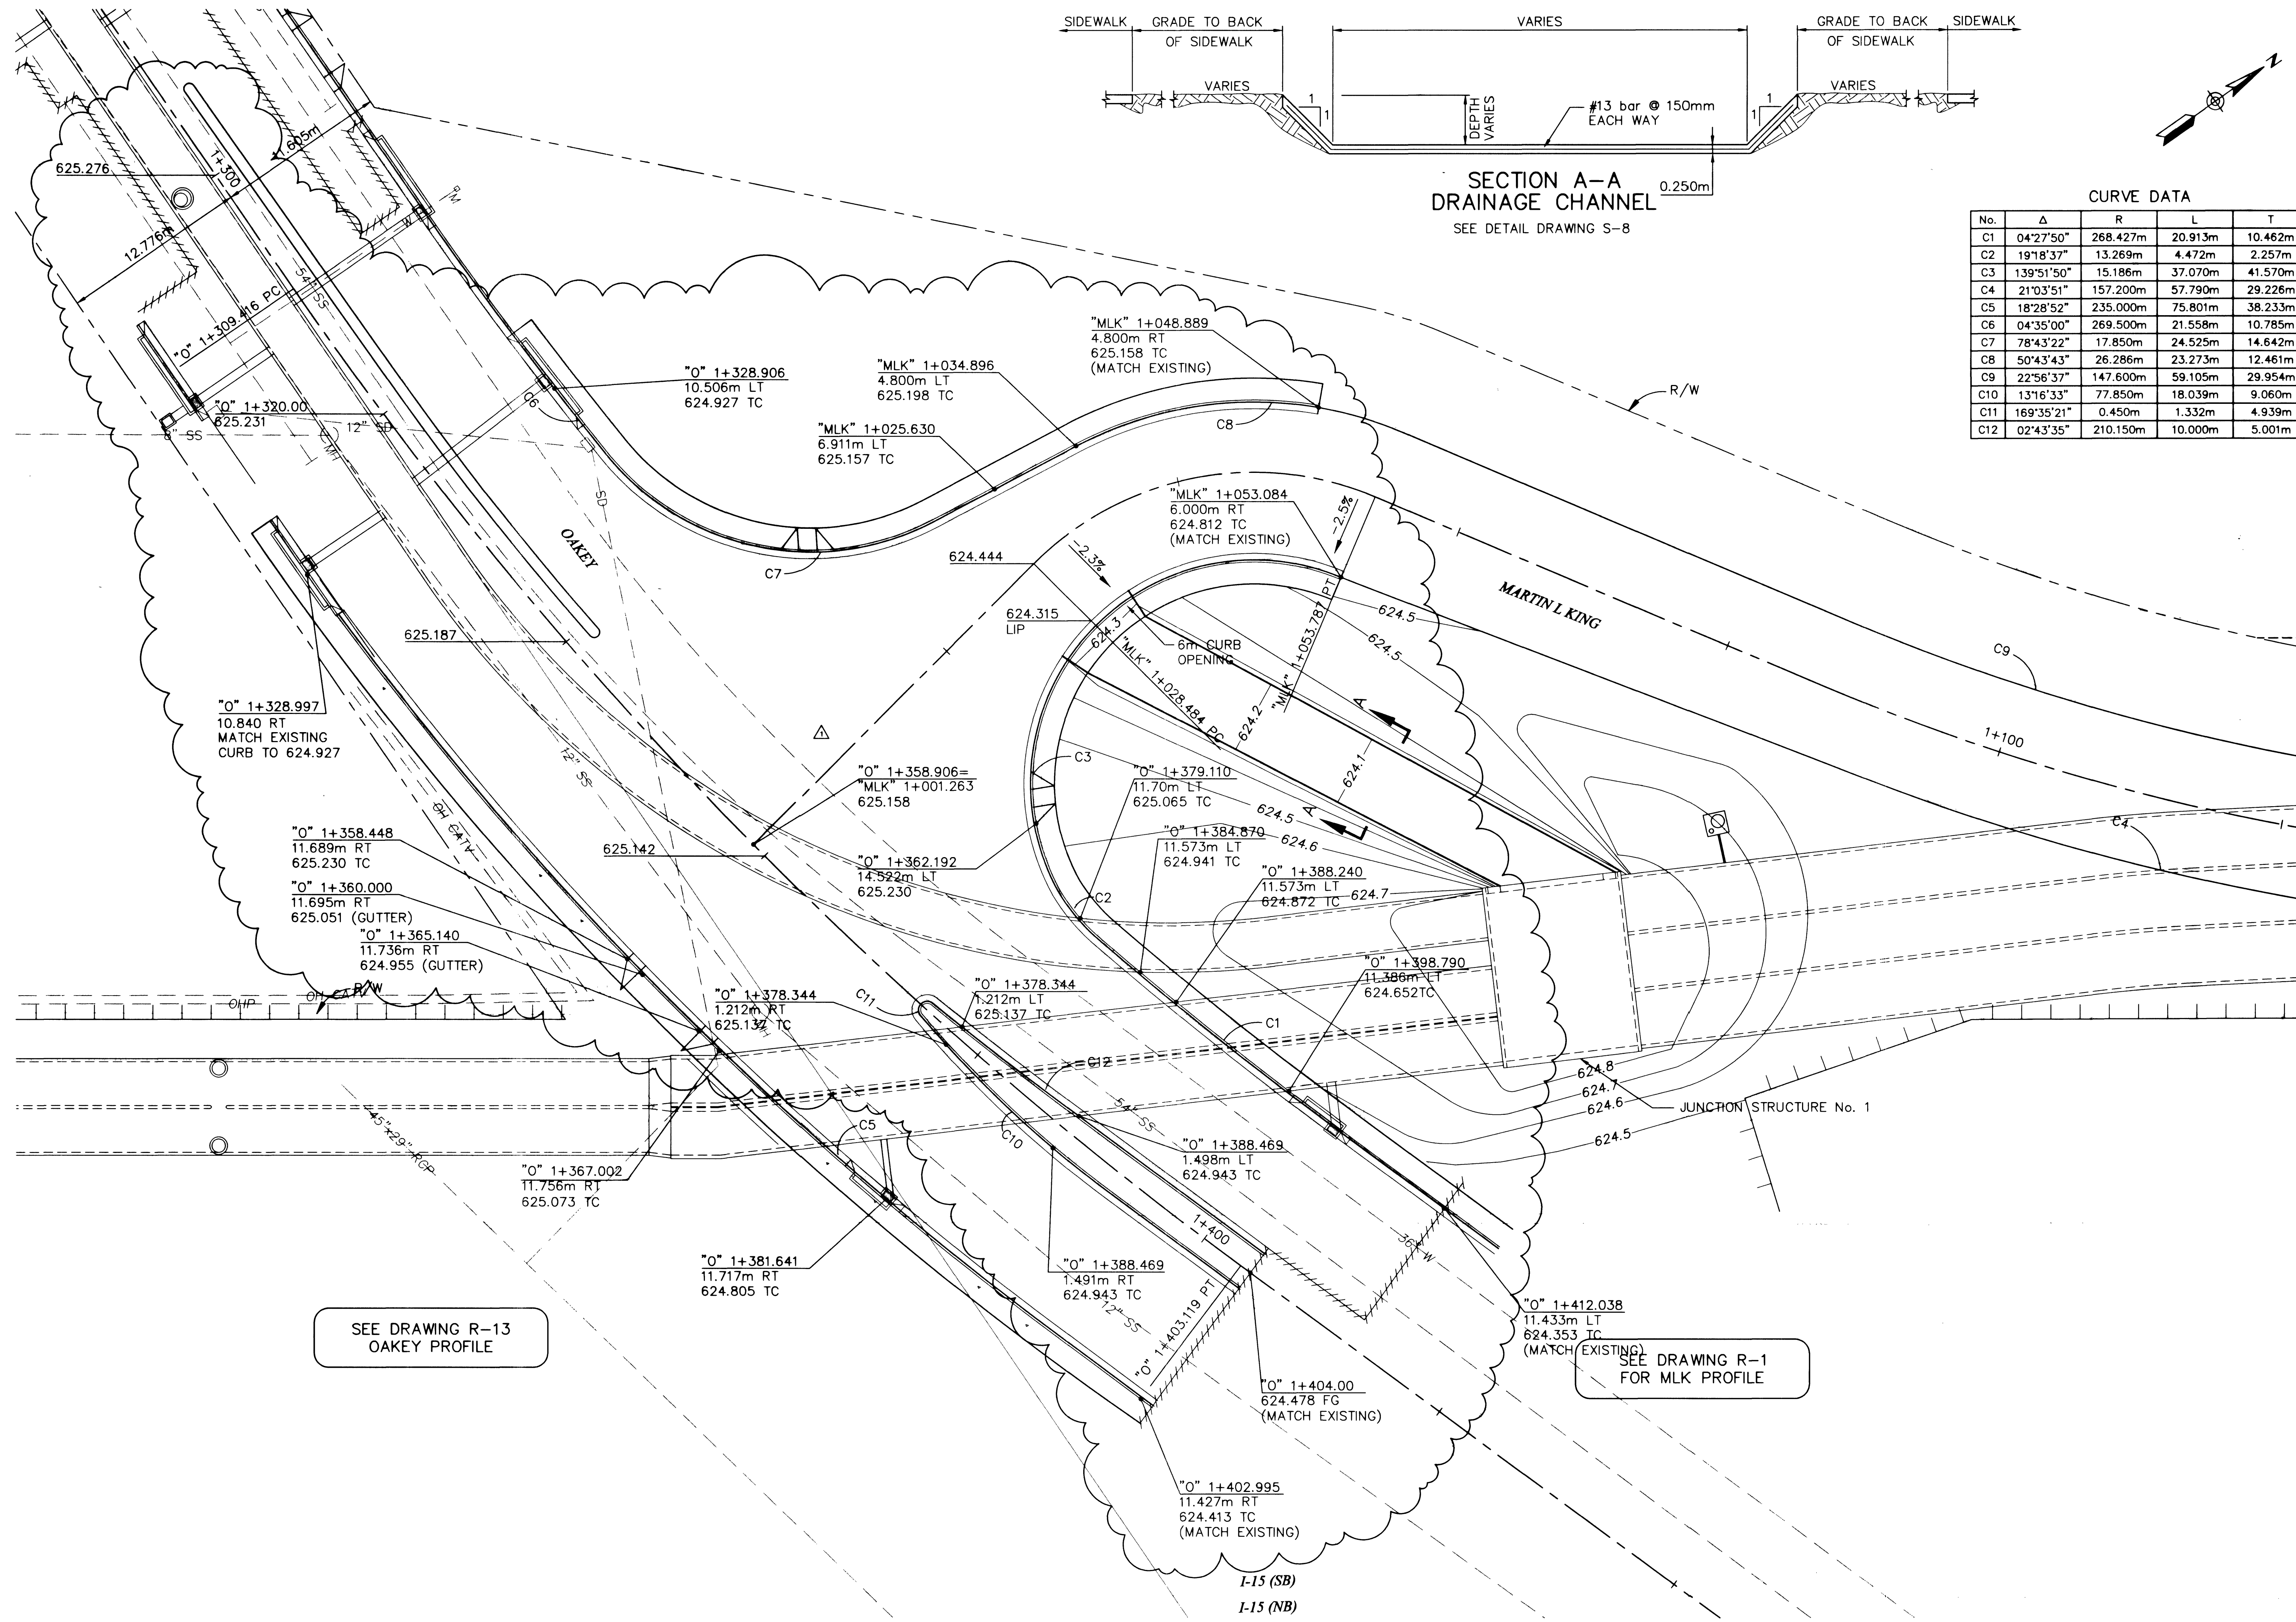

SECTION A-A
DRAINAGE CHANNEL
SEE DETAIL DRAWING S-8


CURVE DATA

No.	Δ	R	L	T
C1	04°27'50"	268.427m	20.913m	10.462m
C2	19°18'37"	13.269m	4.472m	2.257m
C3	139°51'50"	15.186m	37.070m	41.570m
C4	21°03'51"	157.200m	57.790m	29.226m
C5	18°28'52"	235.000m	75.801m	38.233m
C6	04°35'00"	269.500m	21.558m	10.785m
C7	78°43'22"	17.850m	24.525m	14.642m
C8	50°43'43"	26.286m	23.273m	12.461m
C9	22°56'37"	147.600m	59.105m	29.954m
C10	13°16'33"	77.850m	18.039m	9.060m
C11	169°35'21"	0.450m	1.332m	4.939m
C12	02°43'35"	210.150m	10.000m	5.001m

SEE DRAWING R-13
OAKLEY PROFILE

SEE DRAWING R-1
FOR MLK PROFILE

DEPARTMENT OF PUBLIC WORKS
I-15 FREEWAY CHANNEL
INTERSECTION DETAIL
OAKLEY AND MARTIN L. KING

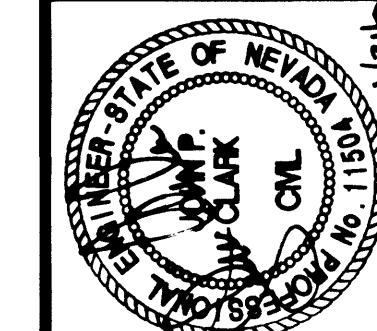


DRAWING No. 104
R-8 241

METRIC

327-V254

PROJECT # 31604
DESIGN BY DWR
DATE APRIL 03, 2001
SCALE (H) 1:200
SCALE (V) N/A
F.L.D. BK. # N/A

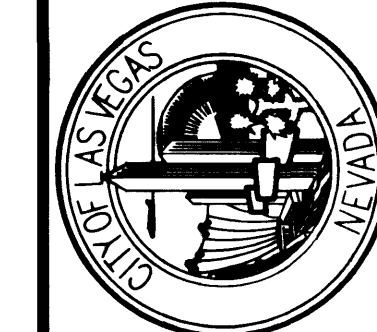

DATE	REVISIONS
12/25/01	REVISED STREET GRADES
07/27/02	REVISED STREET GRADES

PARSONS
BRINCKERHOFF
Las Vegas, Nevada