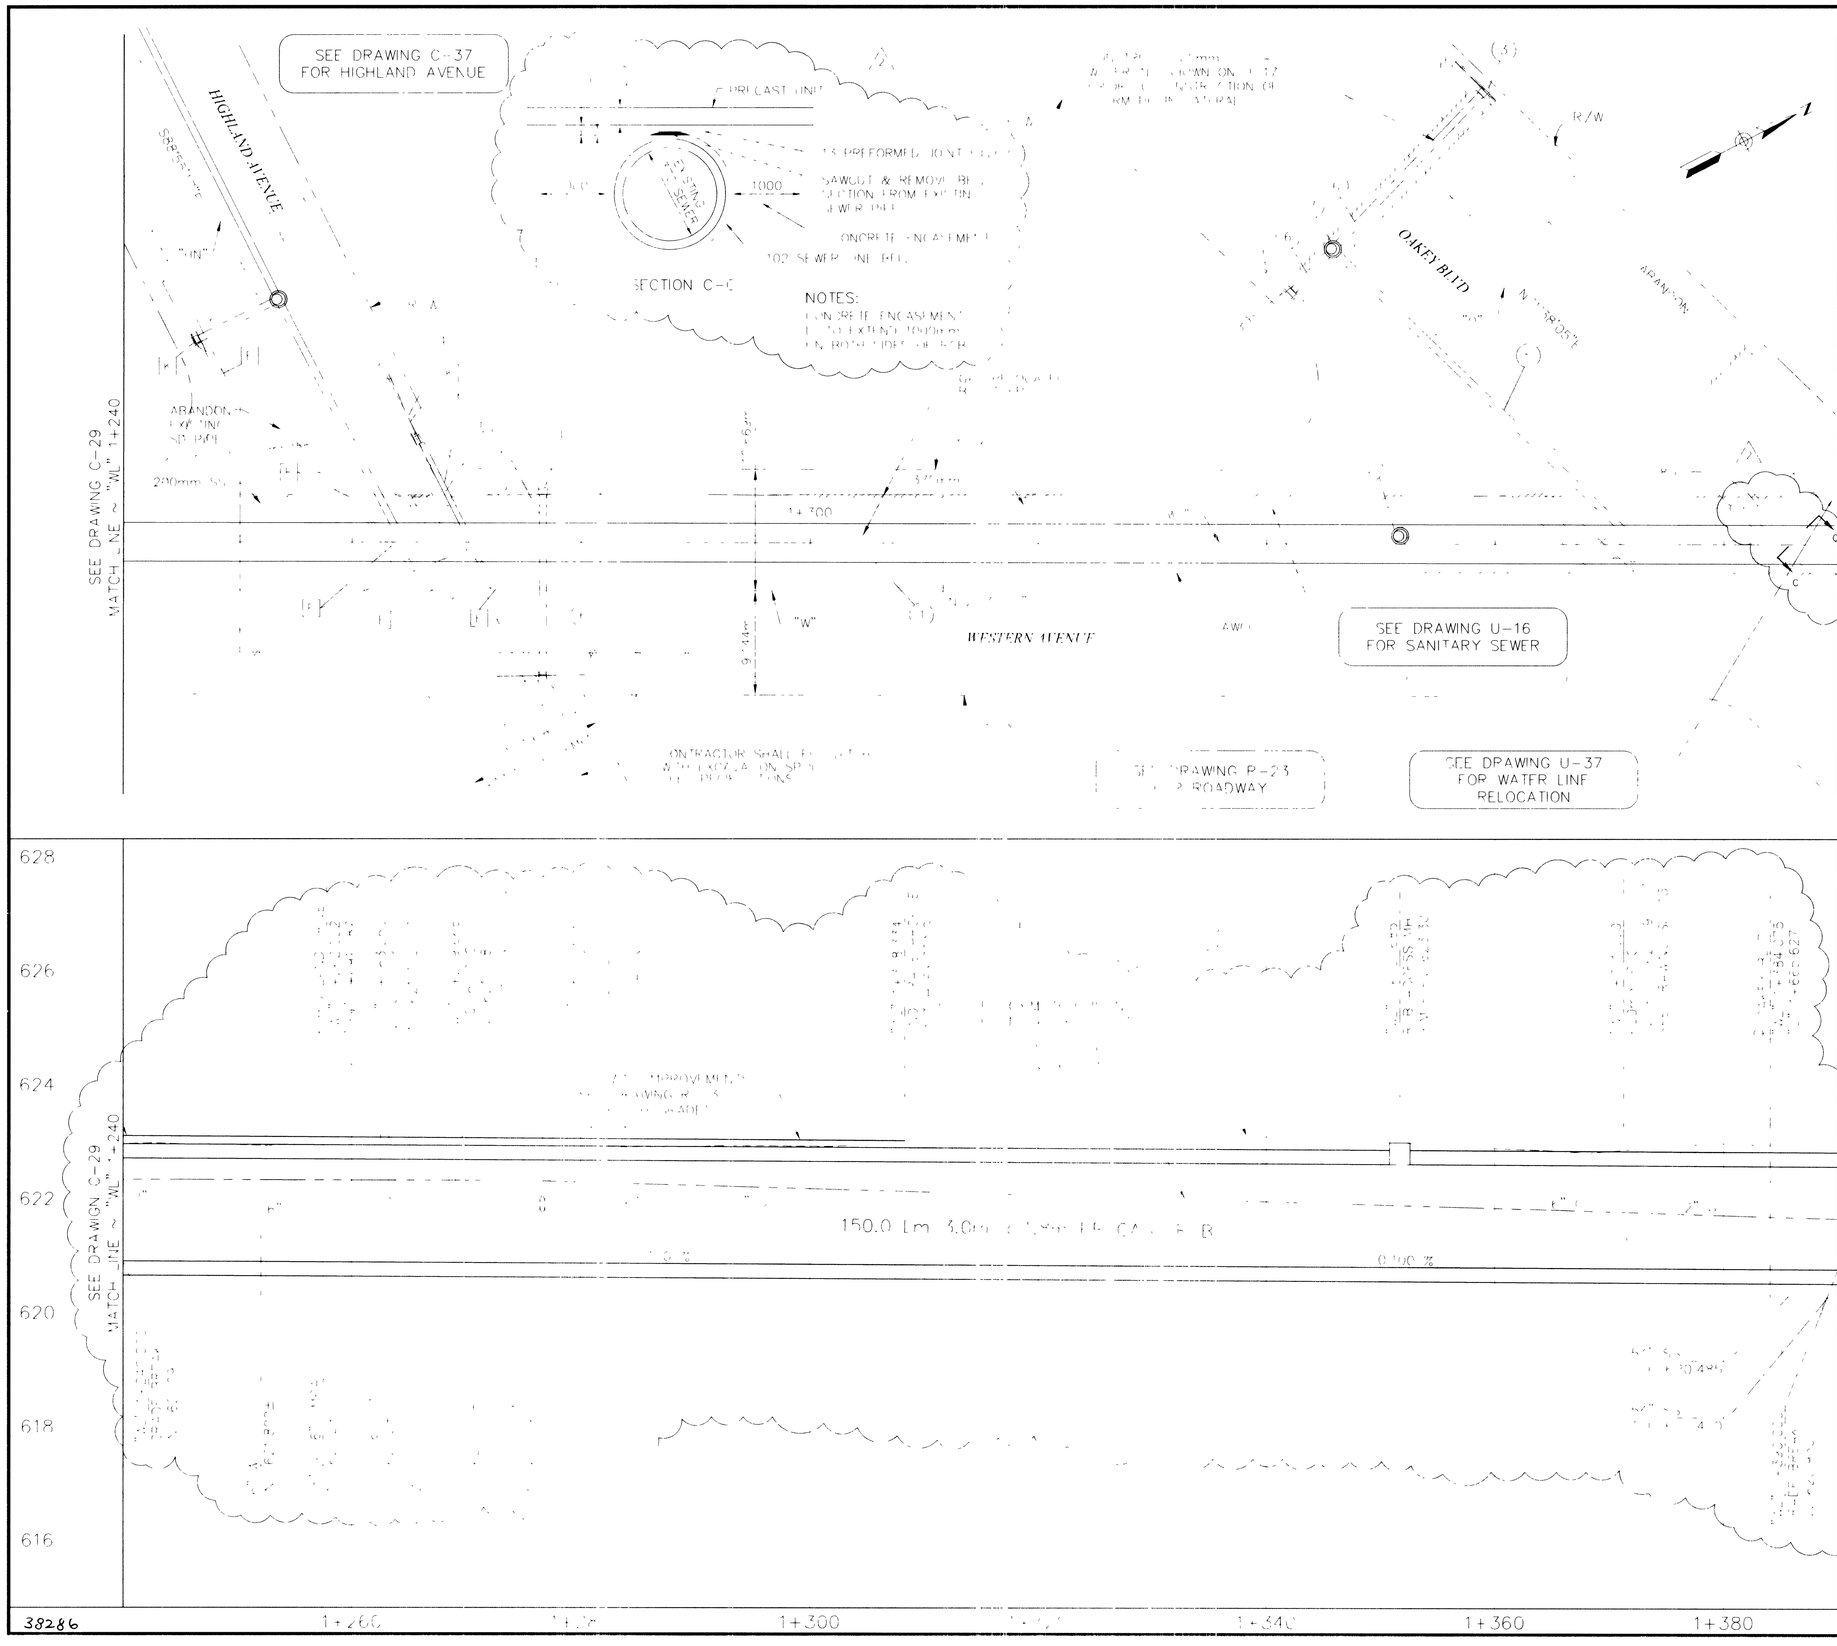

REMOVAL ITEMS

[H] PLUG STORM DRAIN PIPE

[K] REMOVE DI

[P] REMOVE STORM DRAIN PIPE

CONSTRUCTION ITEMS

(1) "WL" 1+240.000 TO "WL" 1+390.000	CONSTRUCT 3.0m x 1.8m PRECAST RCB
(2) "WL" 1+351.685, 1.120m LT	CONSTRUCT RCB ACCESS MH SEE DRAWING S-20 (1)
(3) "WL" 1+341.988, 21.905m LT "WL" 1+359.009, 34.782m LT	CONSTRUCT 3.0m DI TYPE "D" MOD SEE DRAWING S-7
(4) "WL" 1+265.849, 9.072m LT "WL" 1+276.666, 12.159m RT "WL" 1+276.666, 4.662m LT	CONSTRUCT 6.0m DI TYPE "D" MOD SEE DRAWING S-7
(5) "WL" 1+345.988, 25.854m LT TO "WL" 1+371.000, 1.500m LT	CONSTRUCT 600mm PVC
(6) "WL" 1+265.849, 9.072m LT TO "WL" 1+269.666, 1.500m LT "WL" 1+276.666, 4.662m LT TO "WL" 1+276.666, 1.500m LT "WL" 1+276.666, 12.159m RT TO "WL" 1+276.666, 1.500m RT "WL" 1+341.988, 21.905m LT TO "WL" 1+345.759, 25.854m LT "WL" 1+359.009, 39.782m LT TO "WL" 1+345.759, 25.854m LT	CONSTRUCT 450 mm PVC
(7) "WL" 1+345.759, 25.854m LT	CONSTRUCT TYPE I MH WITH 750mm FRAME AND COVER
(8) "WL" 1+383.304, 3.787m LT "WL" 1+391.041, 3.787m RT	CONCRETE ENCASEMENT SEE SECTION C-C

APPROVED FOR CONSTRUCTION

10/23/01
WATER DISTRICT DATE
First approval 3/31/00

DATE	REVISIONS
3/30	ADDENDUM 2
5/03	REVISE DURING CONSTRUCTION

SCALE (H) 1:250 | SCALE (V) 1:50 | PROJECT # 31604
FLD BK # N/A | DATE DECEMBER 17, 1999 | DESIGN BY BPP

PARSONS BRINCKERHOFF

Call before you Dig. 1-800-227-2600 (UNDERGROUND SERVICE (USA))

Call before you Overhead 563-6111 (OVERHEAD SERVICE (USA))

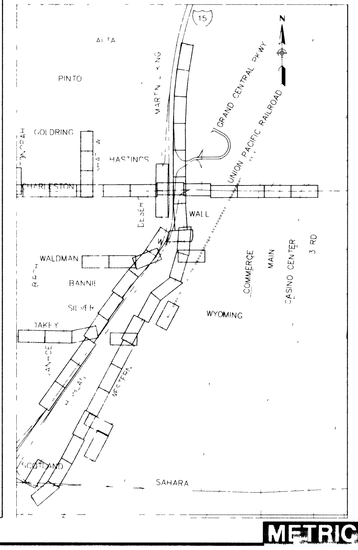

DEPARTMENT OF PUBLIC WORKS

I-15 FREEWAY CHANNEL
CONSTRUCTION PLAN AND PROFILE
"WL" 1+240 TO "WL" 1+390

DRAWING No C-30 | 53 | 241

38286

METRIC

REPLOT 327-V254