LEGEND

- PORTABLE PRECAST CONCRETE BARRIER RAIL
- TEMPORARY IMPACT ATTENUATOR (70 KMH)
- TEMPORARY CONSTRUCTION SIGN
- TRAFFIC DRUM AT 9.0m SPACING

TEMPORARY PAVEMENT DELINEATION LEGEND

(1) 200mm SOLID WHITE LINE

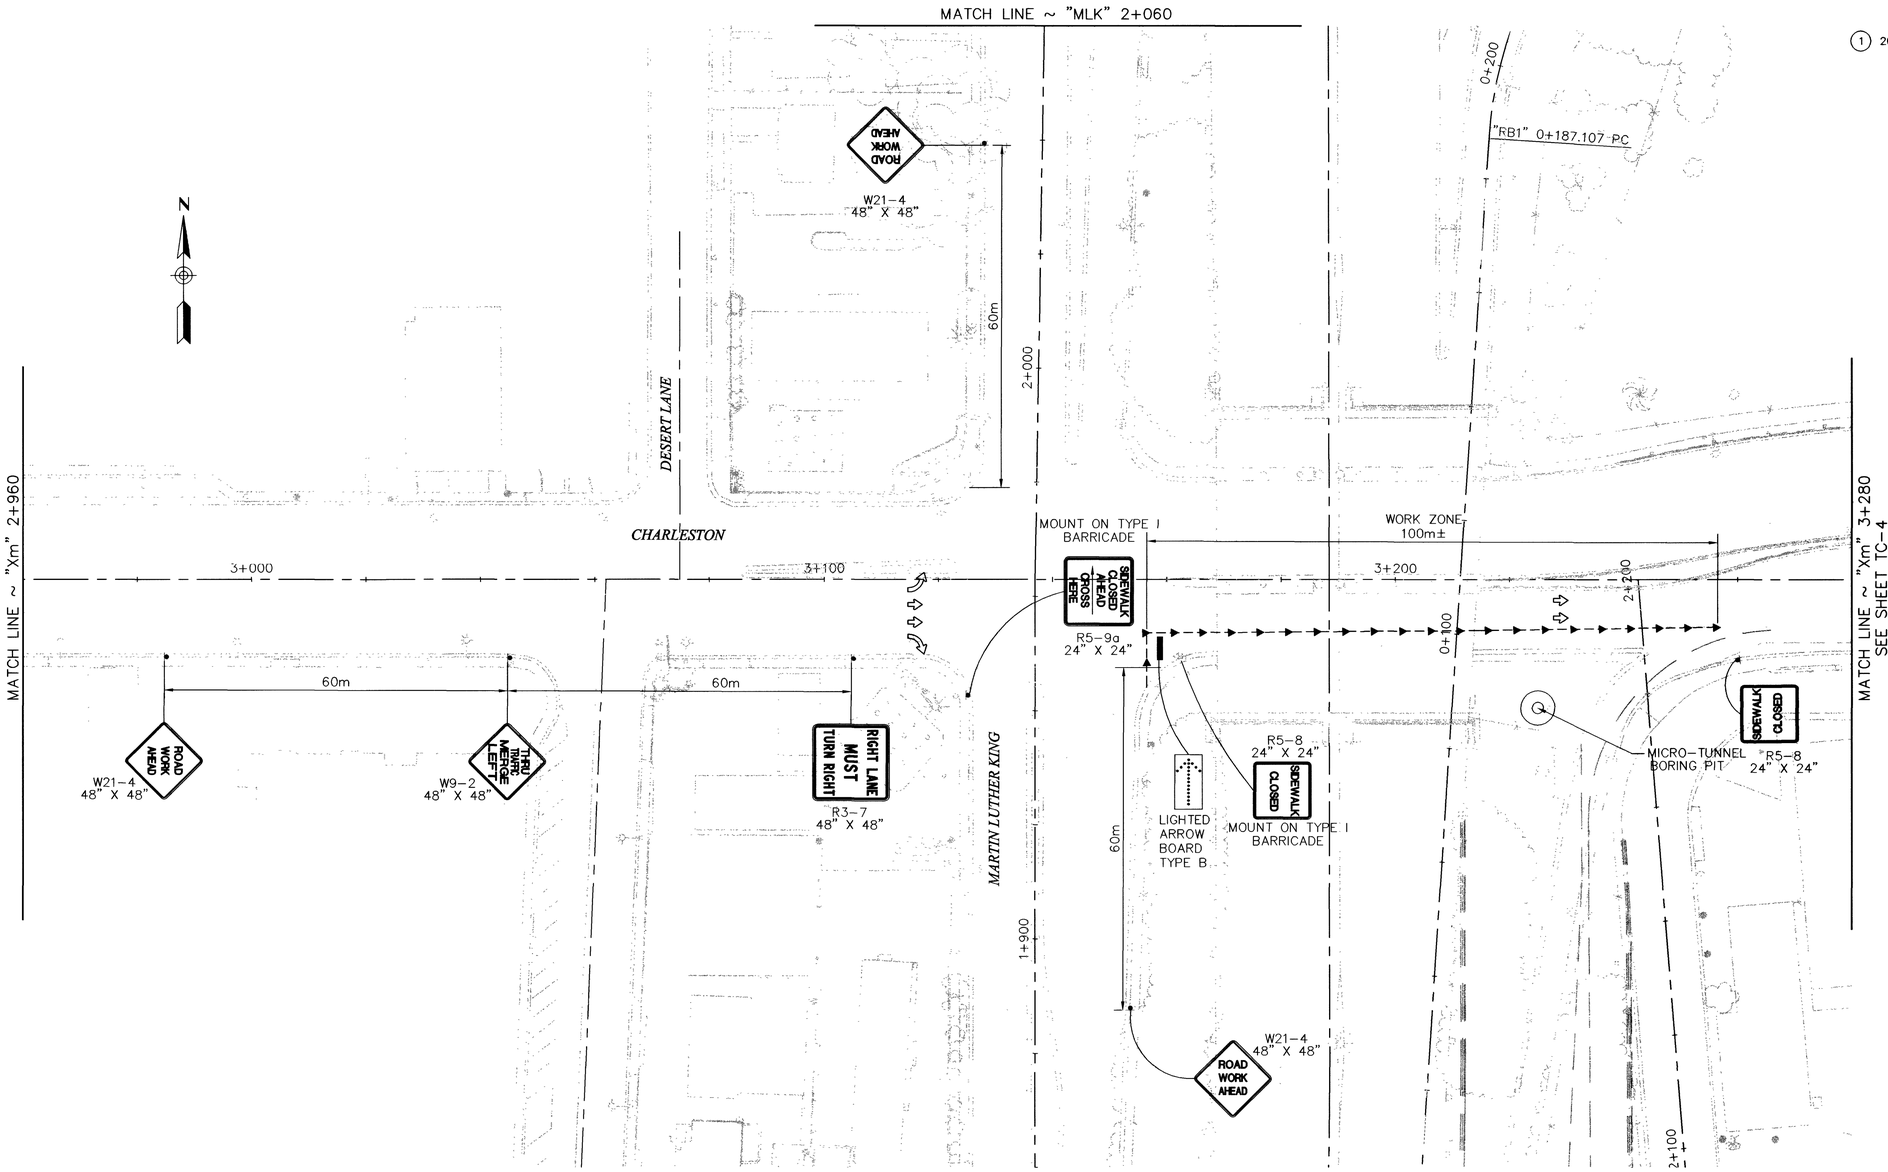

Call before you Dig.	Call before you Overhead
1-800-277-2600	563-6111
UNDERGROUND SERVICE (USA)	OVERHEAD SERVICE (USA)

RECORD DRAWING METRIC

DATE	REVISIONS
4/30/03	RECORD DRAWING

PROJECT # 31604 | DESIGN BY DWR
SCALE (V) N/A | DATE DEC 17, 1999
SCALE (H) N/A | FLD. BK. # N/A

PARSONS BRINCKERHOFF Las Vegas, Nevada

CITY OF LAS VEGAS NEVADA

DEPARTMENT OF PUBLIC WORKS

I-15 FREEWAY CHANNEL
CHARLESTON BLVD SANITARY SEWER WORK
TRAFFIC CONTROL

STATE OF NEVADA PROFESSIONAL ENGINEER JOHN P. CLARK CIVIL No. 11507

DRAWING No. TC-3 | 210/241

K:\31604\Record-dwgs\TC-03.dwg, 05/16/2003 02:37:37 PM, craftr

52667

327-V254