LEGEND

- PORTABLE PRECAST CONCRETE BARRIER RAIL
- TEMPORARY IMPACT ATTENUATOR (70 KMH)
- TEMPORARY CONSTRUCTION SIGN
- TRAFFIC DRUM AT 9.0m SPACING

TEMPORARY PAVEMENT DELINEATION LEGEND

(1) 200mm SOLID WHITE LINE

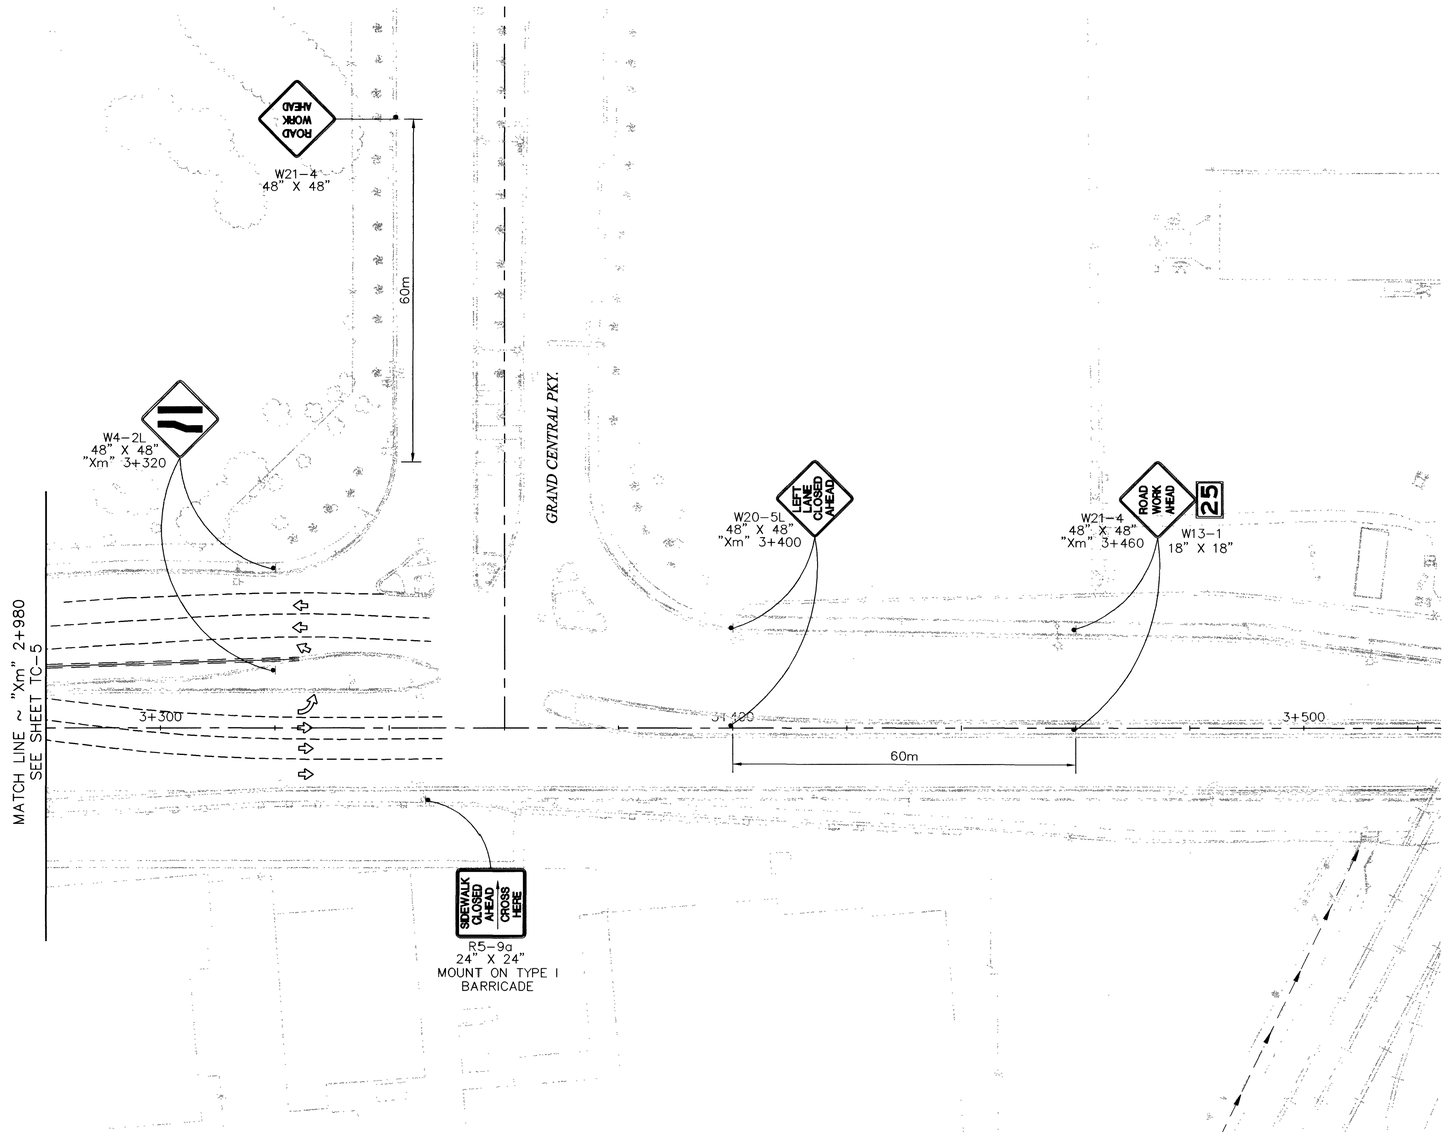

Call before you Dig. 1-800-277-2600 UNDERGROUND SERVICE (USA)

Call before you Overhead 563-6111 OVERHEAD SERVICE (USA)

RECORD DRAWING METRIC

REVISIONS	DATE
RECORD DRAWING	4/30/03

SCALE (H) N/A | SCALE (V) N/A | PROJECT # 31604
FLD. BK. # N/A | DATE DEC 17, 1999 | DESIGN BY DWR

PARSONS BRINCKERHOFF
Las Vegas, Nevada

CITY OF LAS VEGAS NEVADA

DEPARTMENT OF PUBLIC WORKS

I-15 FREEWAY CHANNEL
CHARLESTON BLVD RCB WORK
TRAFFIC CONTROL

STATE OF NEVADA
JOHN P. CLARK
CIVIL
No. 11191
PROFESSIONAL ENGINEER

DRAWING No. TC-6 | 213/241

K:\31604\Record-dwgs\TC-06.dwg, 05/16/2003 02:39:09 PM, craftr

52670

327-V254