PERMANENT PAVEMENT DELINEATION LEGEND

1. TYPE I CENTERLINE PER CCPW USD DWG 244
2. TRANSITION SECTION PER CCPW USD DWG 245
3. DROP LANE LINE PER CCPW USD DWG 246A
4. TYPE 4 LANE LINE PER CCPW USD DWG 244A
5. 150mm SOLID WHITE PAINT OR TAPE PARKING LINE
6. 150mm SOLID YELLOW PAINT OR TAPE PARKING LINE
7. STORAGE LANE LINE PER CCPW USD DWG 246A
8. INSTALL MEDIAN NOSE MARKINGS PER CCPW USD 248
A. INSTALL "ARROWS", "ONLY", & "STOP" USING TYPE 2 MARKING FILM

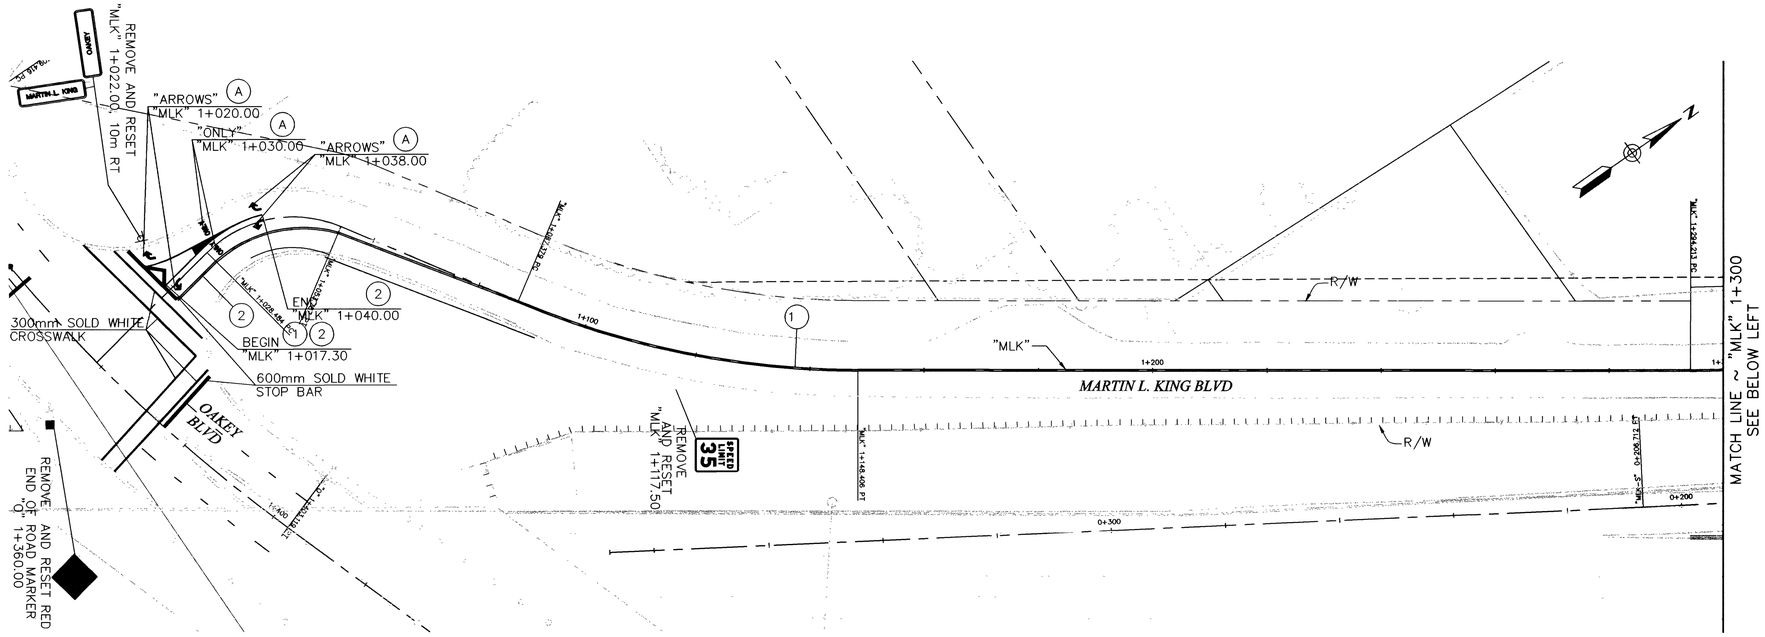

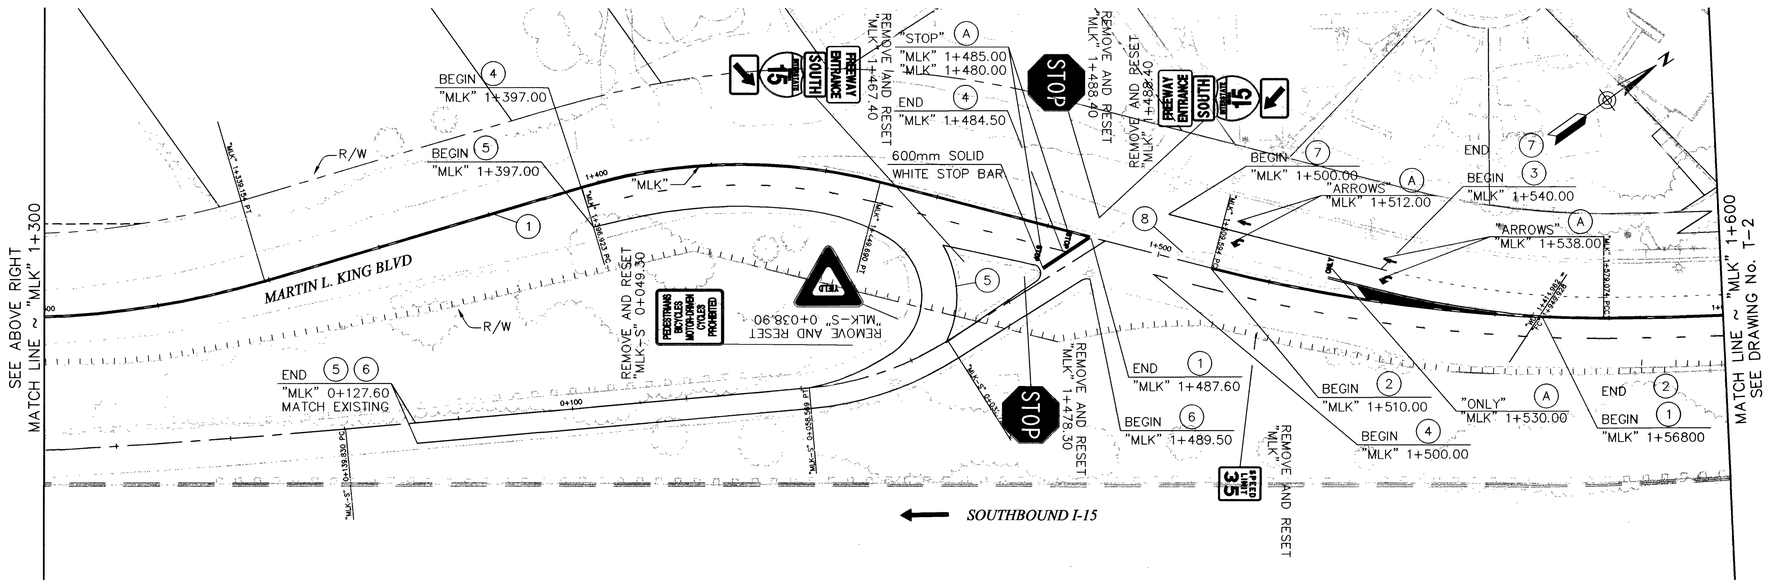

Call before you Dig. 1-800-277-2600 UNDERGROUND SERVICE (USA)

Call before you Overhead 563-6111 OVERHEAD SERVICE (USA)

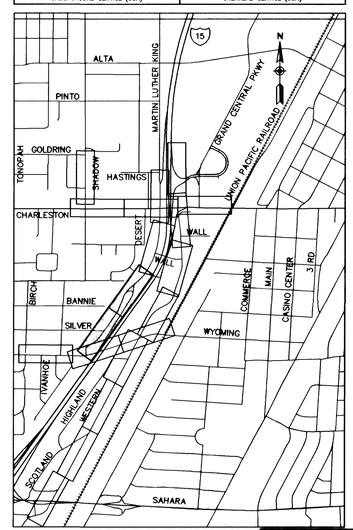

RECORD DRAWING METRIC

REVISIONS	DATE
RECORD DRAWING	4/30/03

PROJECT # 31604 | DESIGN BY KFN | SCALE (V) N/A | DATE DEC 17, 1999 | SCALE (H) 1:500 | FLD. BK. # N/A

PARSONS BRINCKERHOFF — Las Vegas, Nevada

CITY OF LAS VEGAS NEVADA

DEPARTMENT OF PUBLIC WORKS

I-15 FREEWAY CHANNEL
SIGNING AND STRIPING PLAN
"MLK" 1+001 TO "MLK" 1+600

REGISTERED PROFESSIONAL ENGINEER STATE OF NEVADA JOHN P. CLARK CIVIL No. 11501

DRAWING No. T-1 | 225/241

327-V254

52682