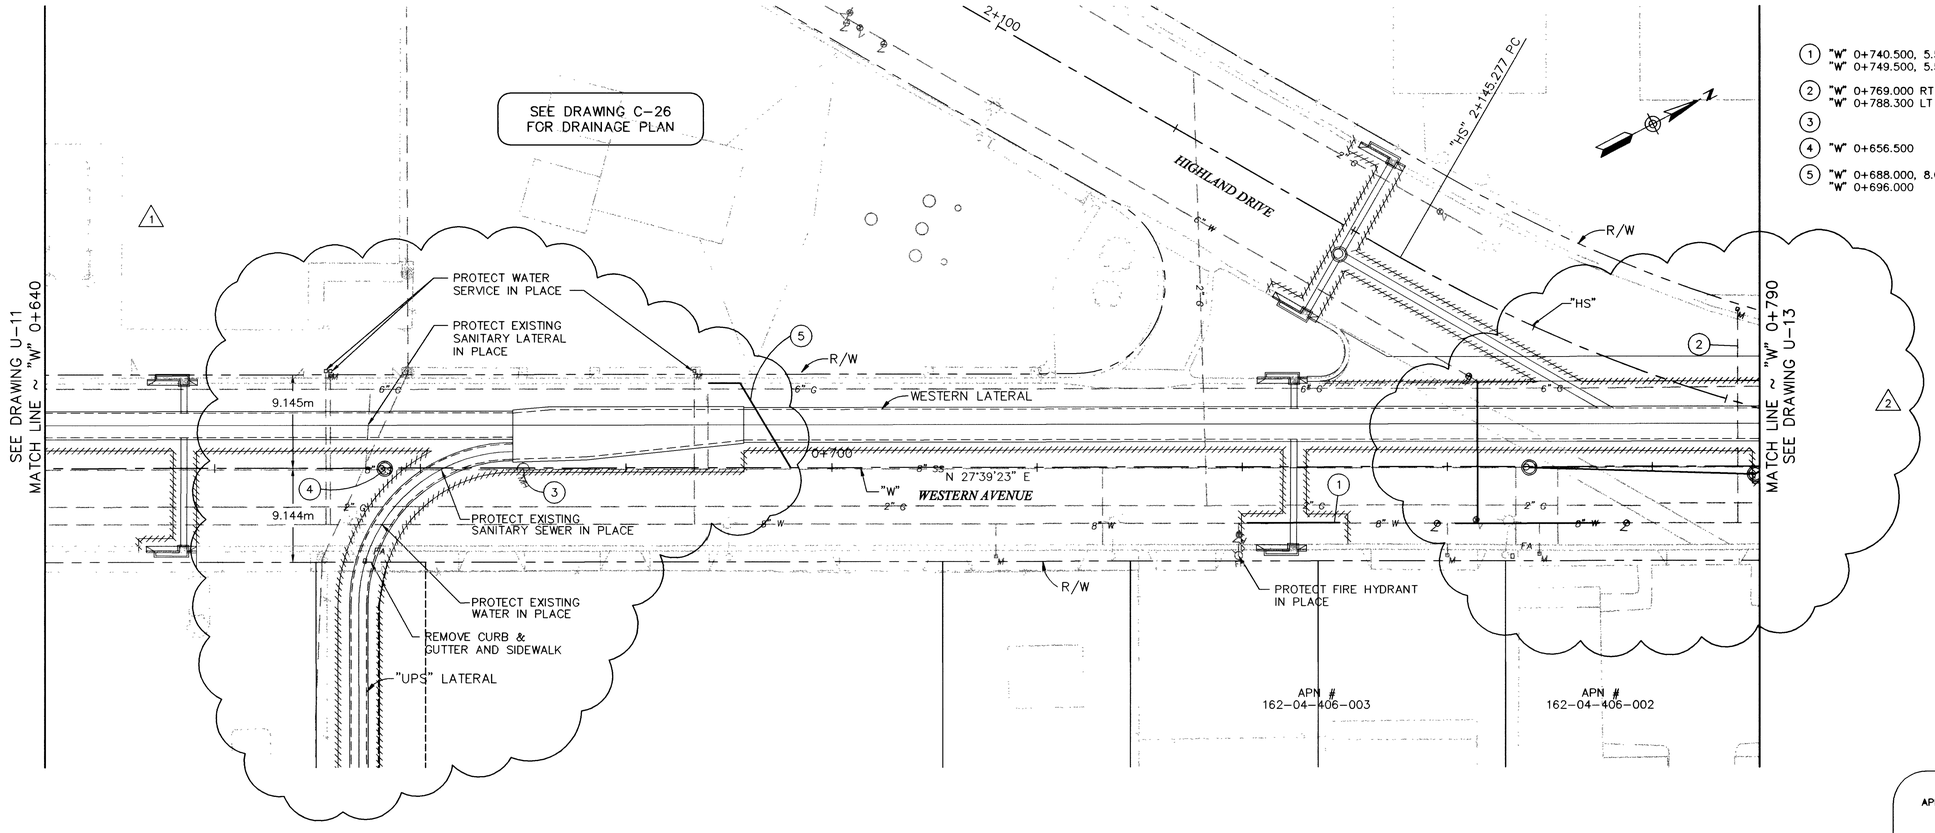

CONSTRUCTION ITEMS

1	"W" 0+740.500, 5.500m RT TO "W" 0+749.500, 5.500m RT	RELOCATE 200mm WATER LINE SEE DETAIL DRAWING U-40
2	"W" 0+769.000 RT "W" 0+788.300 LT	RECONNECT EX WATER SERVICE
3		REMOVE EXISTING MH
4	"W" 0+656.500	CONSTRUCT TYPE 1 SS MH
5	"W" 0+688.000, 8.000m LT TO "W" 0+696.000	RELOCATE EX. SS SERVICE

APPROVED FOR CONSTRUCTION

LAS VEGAS VALLEY WATER DISTRICT DATE

Call before you **Dig.** 1-800-227-2600 UNDERGROUND SERVICE (USA)

Call before you **Crane** 227-2929 OVERHEAD SERVICE (USA)

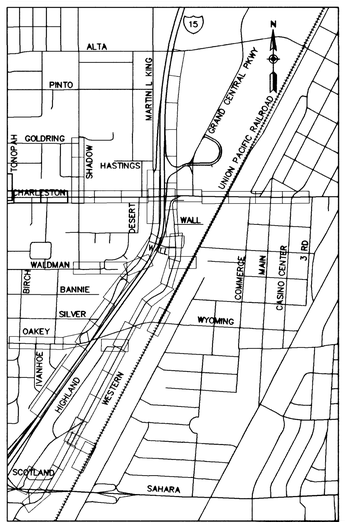

RECORD DRAWING METRIC

REVISIONS	DATE
1 REVISED UPS ALIGNMENT	4/20/01
2 DELETE PROPOSED SANITARY SEWER LINE	4/20/01
RECORD DRAWING	4/30/03

SCALE (H) 1:250 SCALE (V) 1:50 PROJECT # 31604

FLD. BK. # N/A DATE DEC 17, 1999 DESIGN BY RGK

PARSONS BRINCKERHOFF Las Vegas, Nevada

CITY OF LAS VEGAS NEVADA

DEPARTMENT OF PUBLIC WORKS

I-15 FREEWAY CHANNEL

UTILITY RELOCATION (WESTERN AVE)

"W" 0+640 TO "W" 0+790

CIVIL ENGINEER - STATE OF NEVADA JOHN P. CLARK CIVIL No. 11512 IN PROGRESS / CIVIL

DRAWING No. U-12 171/241

K:\31604\Record-dwgs\u-12.dwg, 05/16/2003 04:35:15 PM, craftr

52685

327-V254