ALL DIMENSIONS ARE IN MILLIMETERS UNLESS OTHERWISE NOTED, ALL STATIONS ARE IN METERS.

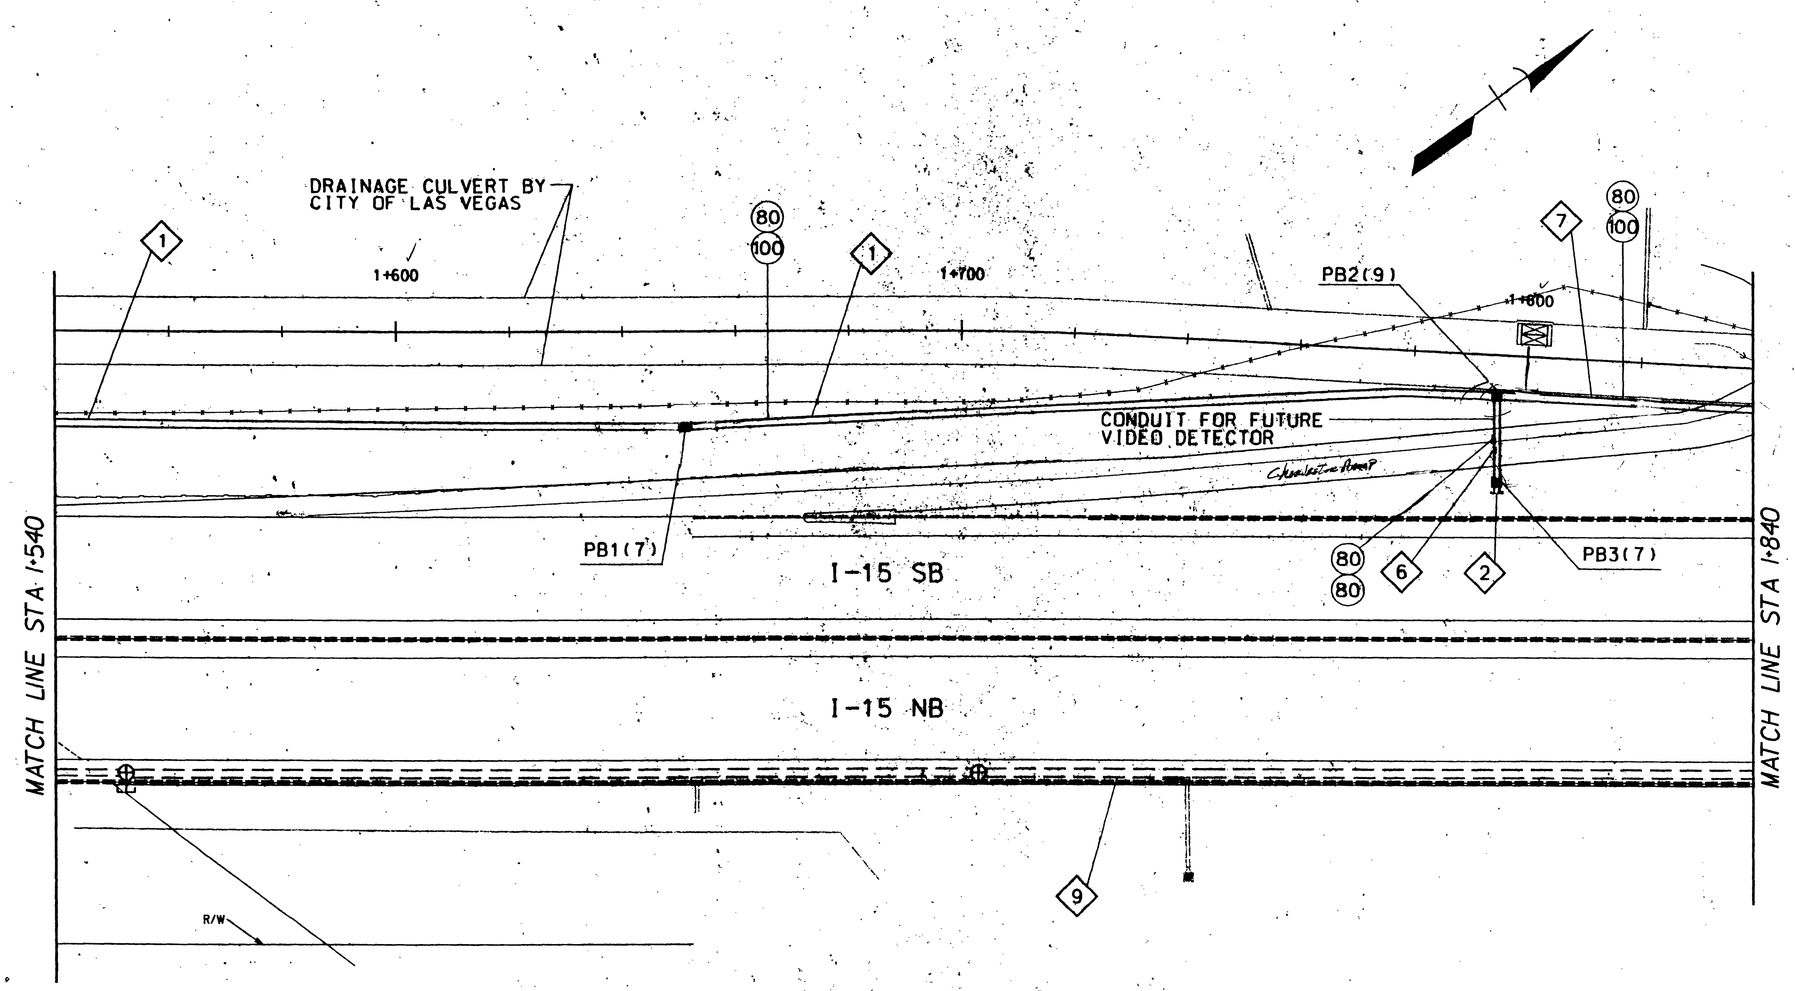

1. INSTALL 80 mm PVC CONDUIT AND 100 mm PVC MULTIDUCT IN TRENCH PER DETAILS AND SPECIFICATIONS.
2. INSTALL 2-80 mm PVC STUB-OUTS. ONE STUB-OUT FOR EACH POWER AND COMMUNICATION.
6. INSTALL CONDUIT IN TRENCH PRIOR TO NEW PAVING.
7. INSTALL 80 mm PVC CONDUIT AND 100 mm PVC MULTIDUCT ADJACENT TO DRAINAGE STRUCTURE IN TRENCH PER DETAILS AND SPECIFICATIONS.
9. ITS INFRASTRUCTURE TO BE INSTALLED AS PART OF NDOT'S I-15/SAHARA WIDENING PROJECT.

AS BUILT BY WESTERN DIVERSIFIED ELECTRIC
10-2-02

52273

322-v254

DEPARTMENT OF PUBLIC WORKS

I-15 FREEWAY CHANNEL
ITS INFRASTRUCTURE
"FC" 1+540 TO "FC" 1+840

Kimley-Horn and Associates, Inc.
Engineering, Planning, and Environmental Consultants
© 1999

HALF SCALE 1:1000 | FULL SCALE 1:500 | W.A. # | DESIGN BY | FLD. BK. # | DATE | REVISIONS | DATE

DRAWING NO. IT-12