ALL DIMENSIONS ARE IN MILLIMETERS UNLESS OTHERWISE NOTED, ALL STATIONS ARE IN METERS.

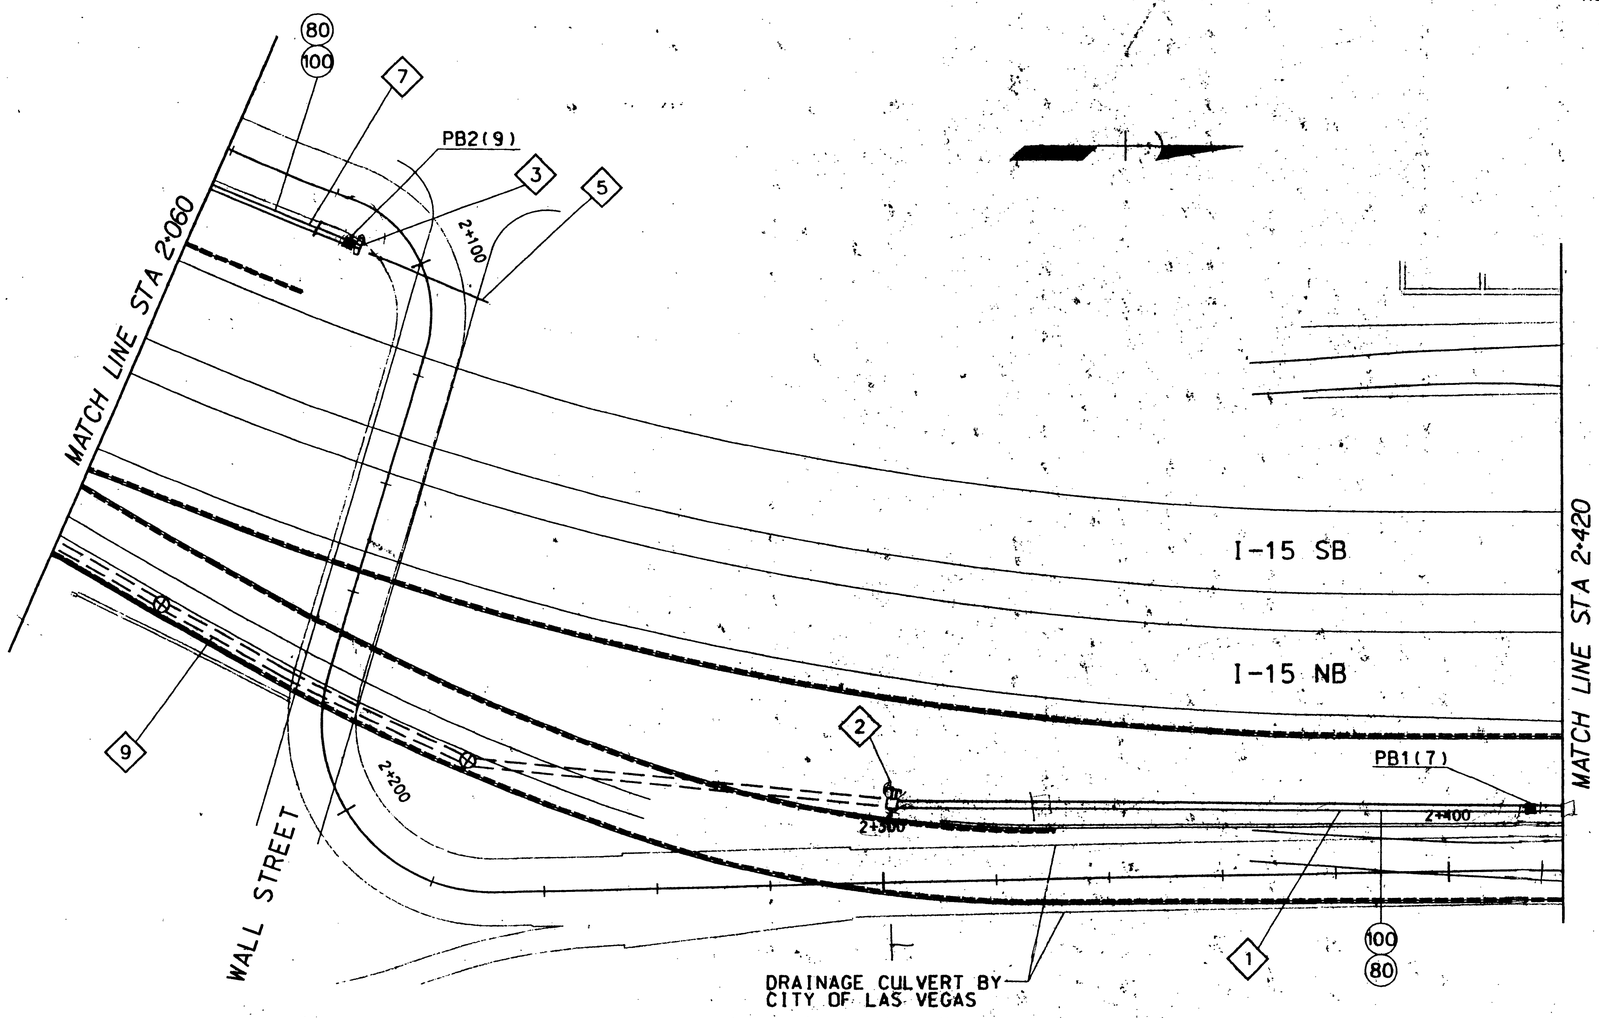

1. INSTALL 80 mm PVC CONDUIT AND 100 mm PVC MULTIDUCT IN TRENCH PER DETAILS AND SPECIFICATIONS.

2. INSTALL 2-80 mm PVC STUBOUTS. ONE STUB-OUT FOR EACH POWER AND COMMUNICATION.

3. INSTALL 1-80 mm CONDUIT AND 1-100 mm MULTIDUCT CONDUIT STUB-OUT.

5. INSTALL 250 mm PIPE SLEEVE IN TRENCH SPANNING ROADWAY PRIOR TO NEW PAVING. SEE CONDUIT SLEEVE DETAIL.

7. INSTALL 80 mm PVC CONDUIT AND 100 mm PVC MULTIDUCT ADJACENT TO DRAINAGE STRUCTURE IN TRENCH PER DETAILS AND SPECIFICATIONS.

9. ITS INFRASTRUCTURE TO BE INSTALLED AS PART OF NDOT'S I-15/SAHARA WIDENING PROJECT.

AS BUILT BY
WESTERN DIVERSIFIED
ELECTRIC
B Thomas 10-2-02

52275

327-Y254

DATE	REVISIONS

W.A.# | DESIGN BY
FULL SCALE 1:500 | DATE
HALF SCALE 1:1000 | F.I.D. BK.#

Kimley-Horn and Associates, Inc.
Engineering, Planning, and Environmental Consultants
© 1993

DEPARTMENT OF PUBLIC WORKS

I-15 FREEWAY CHANNEL
ITS INFRASTRUCTURE
"FC" 2+060 TO "FC" 2+420

DRAWING NO. IT-14