LEGEND

- SIGNAL HEAD
- SIGNAL HEAD WITH BACKPLATE
- MAST ARM OVERHEAD SIGNAL WITH BACKPLATE
- SIGNAL STANDARD
- No. 3 1/2 TRAFFIC SIGNAL PULL BOX
- LOOP DETECTOR
- CONDUIT

GRAND CENTRAL PKWY

CHARLESTON BLVD

N

3 LOOPS 78.6m

ONLY ONLY

78.6m TO STOP BAR

3+300

EXIST BOX

AS BUILT BY INTERN DIVERSIFIED ELECTRIC

52283

Call before you Dig. 1-800-277-2600 UNDERGROUND SERVICE (USA)

Call before you Overhead 563-6111 OVERHEAD SERVICE (USA)

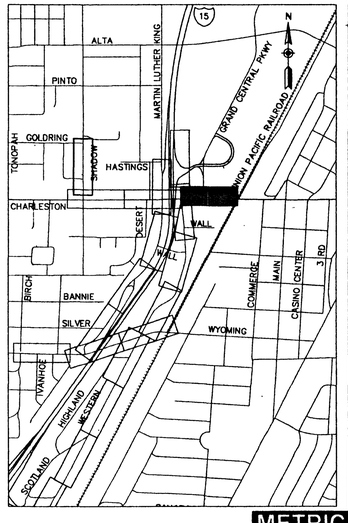


METRIC

| | | | |
|---|---|---|---|
| SCALE (H) 1:200 | SCALE (V) N/A | PROJECT # 31604 | REVISIONS |
| FLD. BK. # N/A | DATE DECEMBER 17, 1999 | DESIGN BY KFN | DATE |

PARSONS BRINCKERHOFF Las Vegas, Nevada

CITY OF LAS VEGAS NEVADA

DEPARTMENT OF PUBLIC WORKS

I-15 FREEWAY CHANNEL
SIGNALIZATION PLAN
CHARLESTON & GRAND CENTRAL PKWY

REGISTERED PROFESSIONAL ENGINEER STATE OF NEVADA

DRAWING No. T-15

239/241

L:\31604\SHTS\T-15.DWG KOECHLEY 12\22\99 18:26