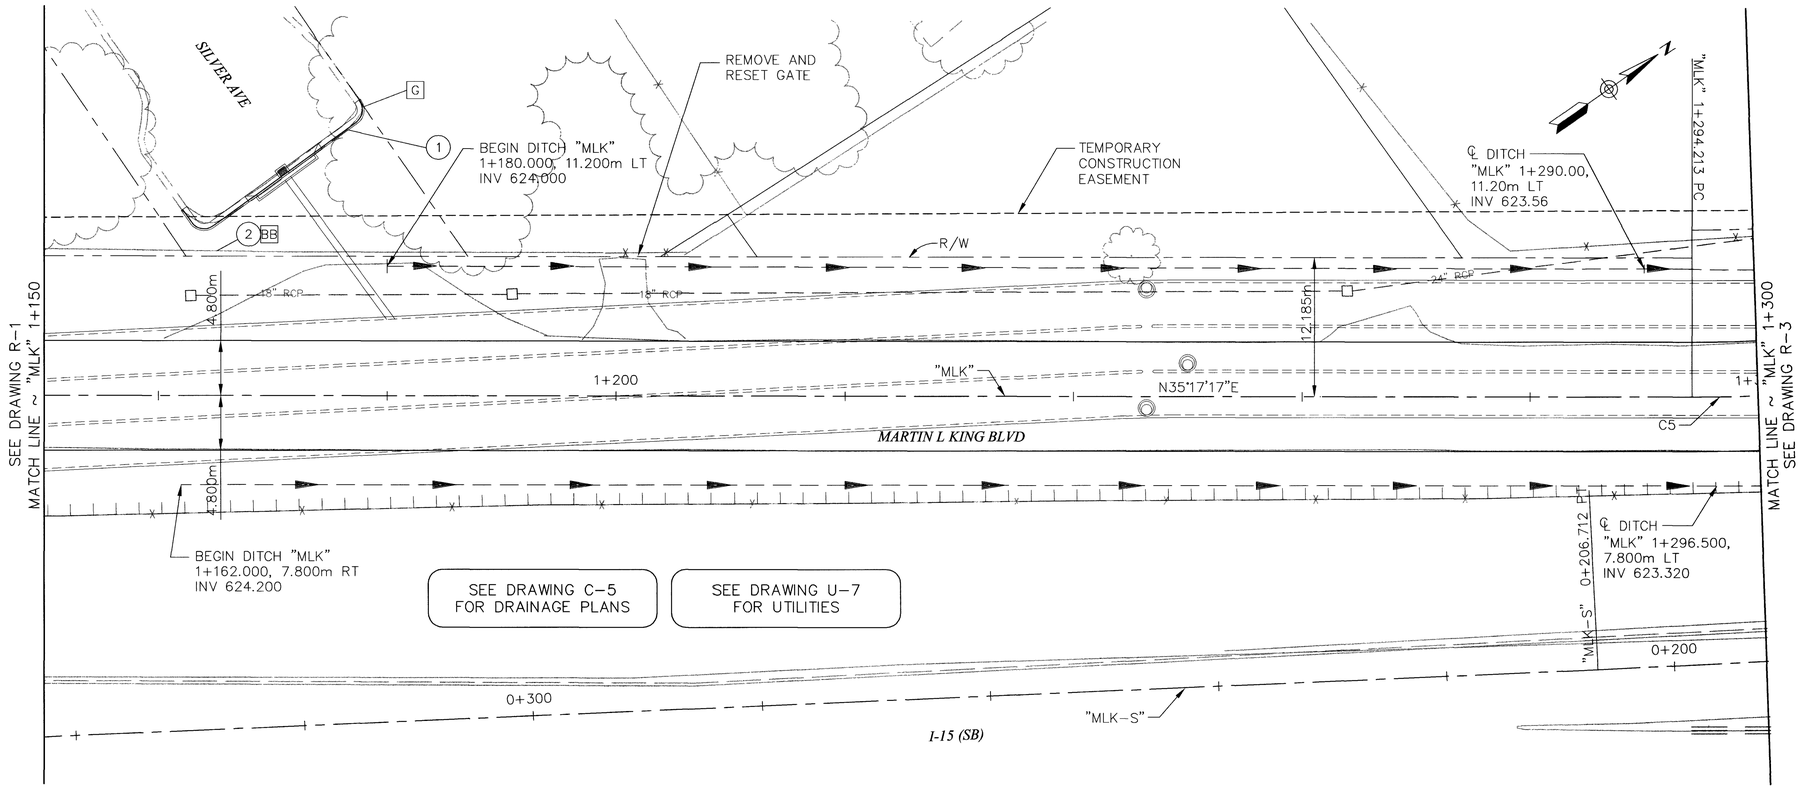

REMOVAL ITEMS

- F REMOVE AC PAVEMENT
- G REMOVE CURB AND GUTTER
- BB REMOVE BLOCK WALL

CONSTRUCTION ITEMS

1. "MLK" 1+162.120, 16.260m LT TO "MLK" 1+177.510, 25.870m LT — CONSTRUCT TYPE "L" CURB AND GUTTER
2. "MLK" 1+150.000, 12.837m LT TO "MLK" 1+206.149, 12.568m LT — CONSTRUCT BLOCK WALL

"MLK" CURVE DATA

No.	Δ	R	L	T
C5	16°30'00"	156.058m	44.941m	22.627m

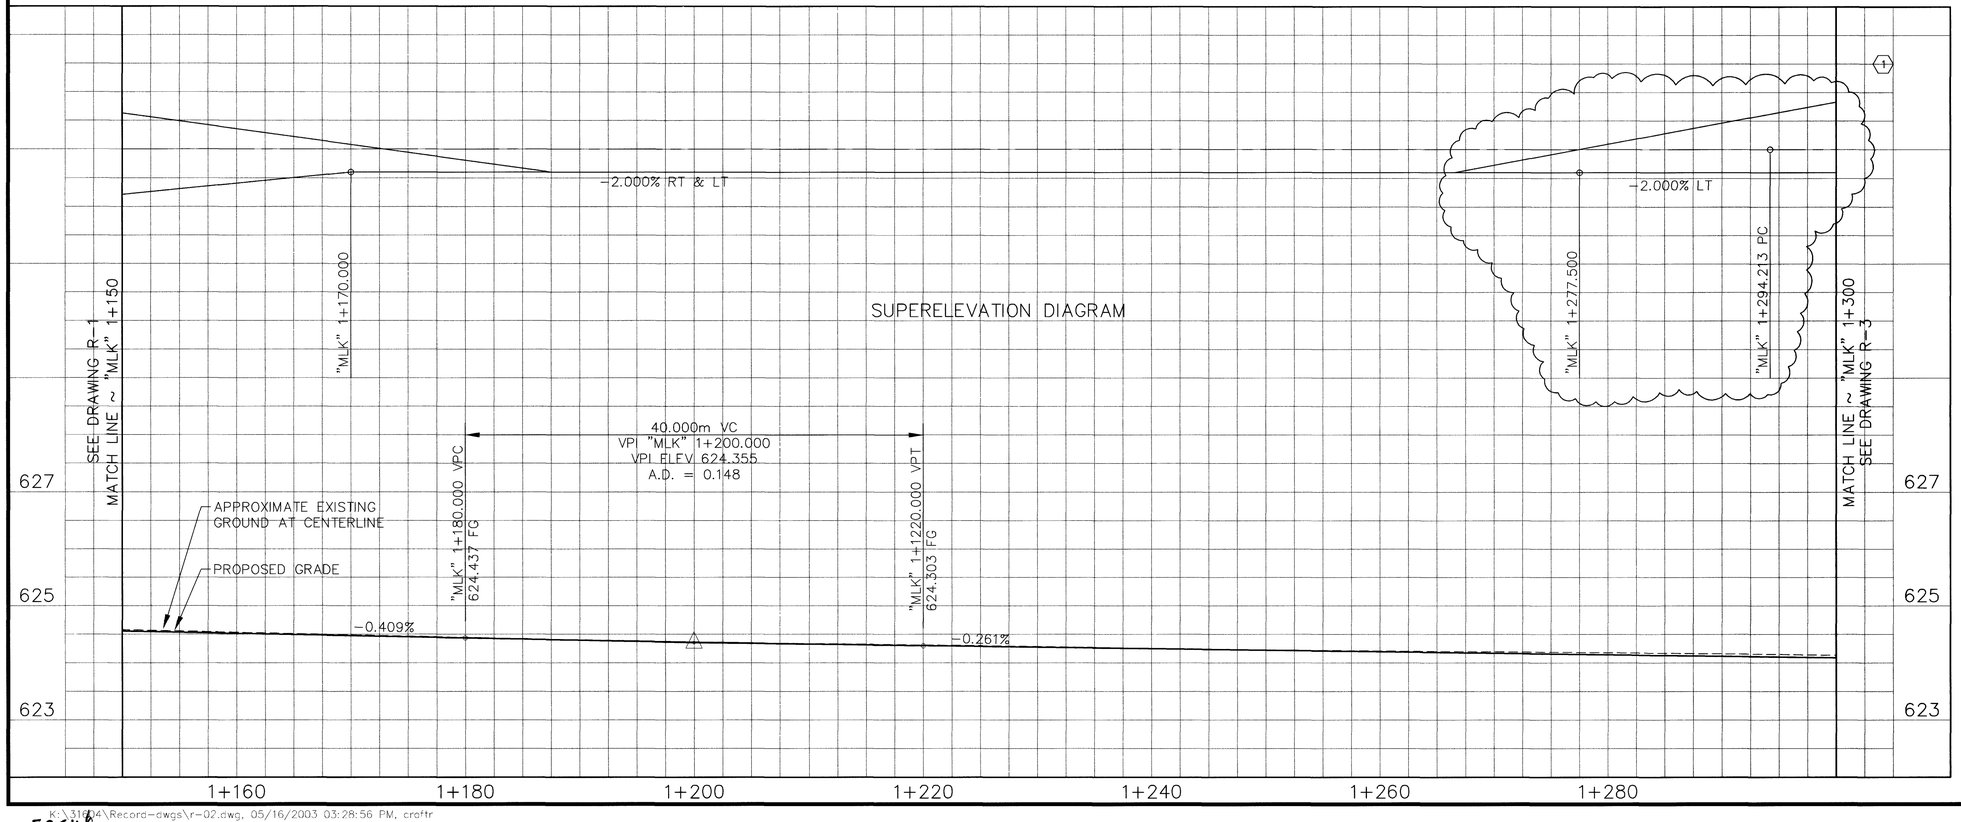

Call before you Dig. 1-800-227-2600 UNDERGROUND SERVICE (USA)

Call before you Overhead 563-6111 OVERHEAD SERVICE (USA)

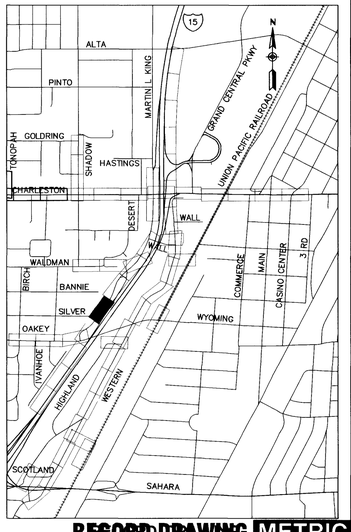

RECORD DRAWING METRIC

REVISIONS	DATE
1 REVISED FOR CLV FIRE STATION	6/29/00
RECORD DRAWING	4/30/03

SCALE (H) 1:250 | SCALE (V) 1:50 | PROJECT # 31604
FLD. BK. # N/A | DATE DEC 17, 1999 | DESIGN BY KFN

PARSONS BRINCKERHOFF
Las Vegas, Nevada

CITY OF LAS VEGAS NEVADA

DEPARTMENT OF PUBLIC WORKS

I-15 FREEWAY CHANNEL UTILITY RELOCATION "MLK" 1+150 TO "MLK" 1+300

ENGINEER: STATE OF NEVADA JOHN P. CLARK CIVIL No. 11594 PROFESSIONAL

DRAWING No. R-2 | 98/241

K:\31604\Record-dwgs\r-02.dwg, 05/16/2003 03:28:56 PM, croftr

52540

327-V254