

- CONSTRUCTION ITEMS**
- ① "WL" 0+640.000 TO 0+670.667 CONSTRUCT 2.4m x 1.2m PRECAST RCB
 - ③ "WL" 0+670.667 TO 0+693.083 CONSTRUCT JUNCTION STRUCTURE NO. 4 SEE DRAWING S-15
 - ④ "WL" 0+746.515, 12.222m RT TO 0+746.715, 4.427m LT
"WL" 0+747.787, 10.688m LT TO 0+756.399, 25.657m LT
CONSTRUCT 3.0m DI TYPE "D" MOD. SEE DRAWING S-7
 - ⑤ "WL" 0+746.515, 12.222m RT TO 0+746.703, 1.200m RT
"WL" 0+746.715, 4.427m LT TO 0+746.703, 1.200m LT
CONSTRUCT 600mm PVC
 - ⑦ "WL" 0+751.160, 16.518m LT TO CONSTRUCT TYPE I MH
 - ⑧ "WL" 0+751.160, 16.518m LT TO 0+777.381, 1.200m LT CONSTRUCT 750mm PVC
 - ⑨ "WL" 0+747.787, 10.688m LT TO 0+751.160, 16.518m LT
"WL" 0+756.399, 25.657m LT TO 0+751.160, 16.518m LT
CONSTRUCT 450mm PVC

DATE	REVISIONS
3/20/00	
4/20/01	
4/20/03	



SCALE (V)	SCALE (H)	F.L.D. BK. #	N/A	DATE	DESIGN BY	PROJECT #
1:50	1:250			DEC 17, 1999	BPP	31604



DEPARTMENT OF PUBLIC WORKS
I-15 FREEWAY CHANNEL
CONSTRUCTION PLAN AND PROFILE
"WL" 0+640 TO "WL" 0+790

APPROVED FOR CONSTRUCTION
 LAS VEGAS VALLEY WATER DISTRICT DATE

Call before you Dig. 1-800-227-2600 UNDERGROUND SERVICE (USA)
 Call before you Crane 227-2929 OVERHEAD SERVICE (USA)

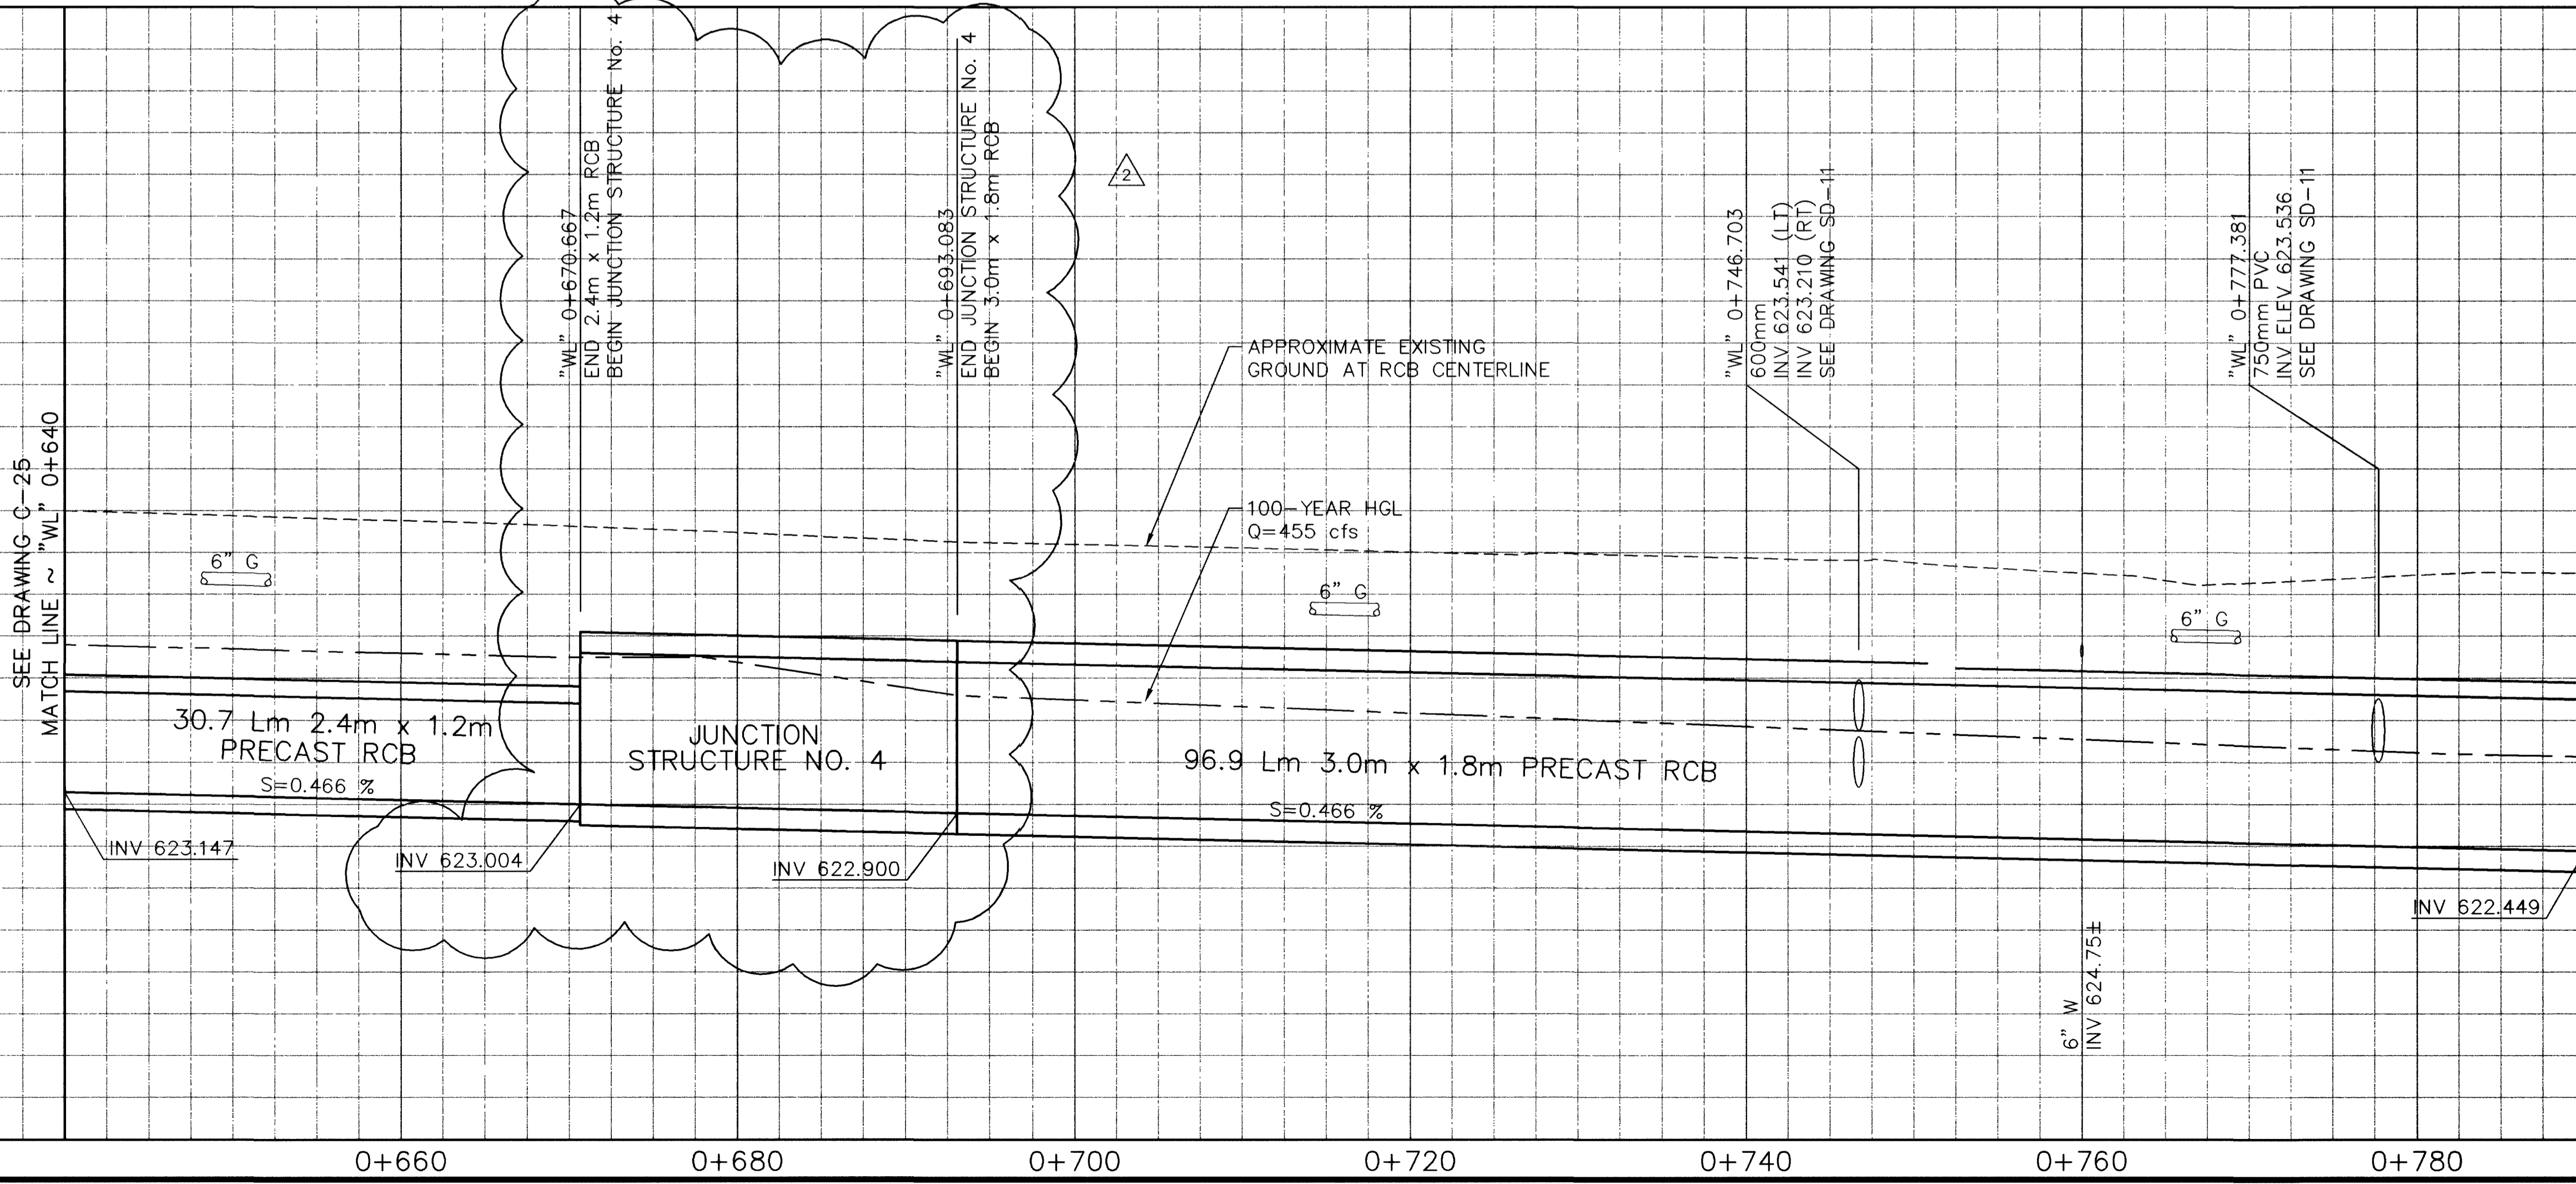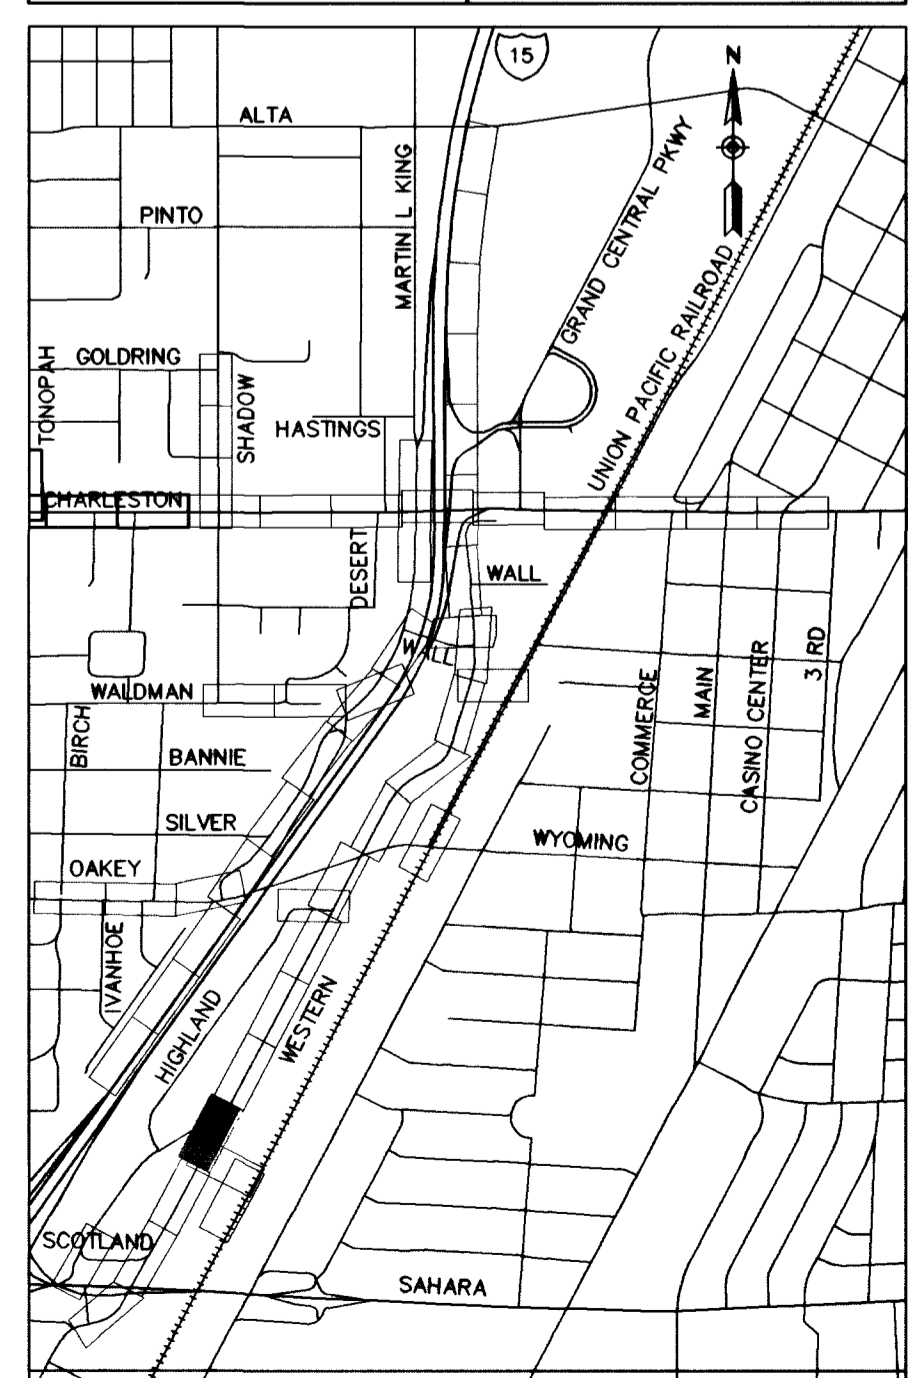

MATCH LINE ~ "WL" 0+790
 SEE DRAWING C-27