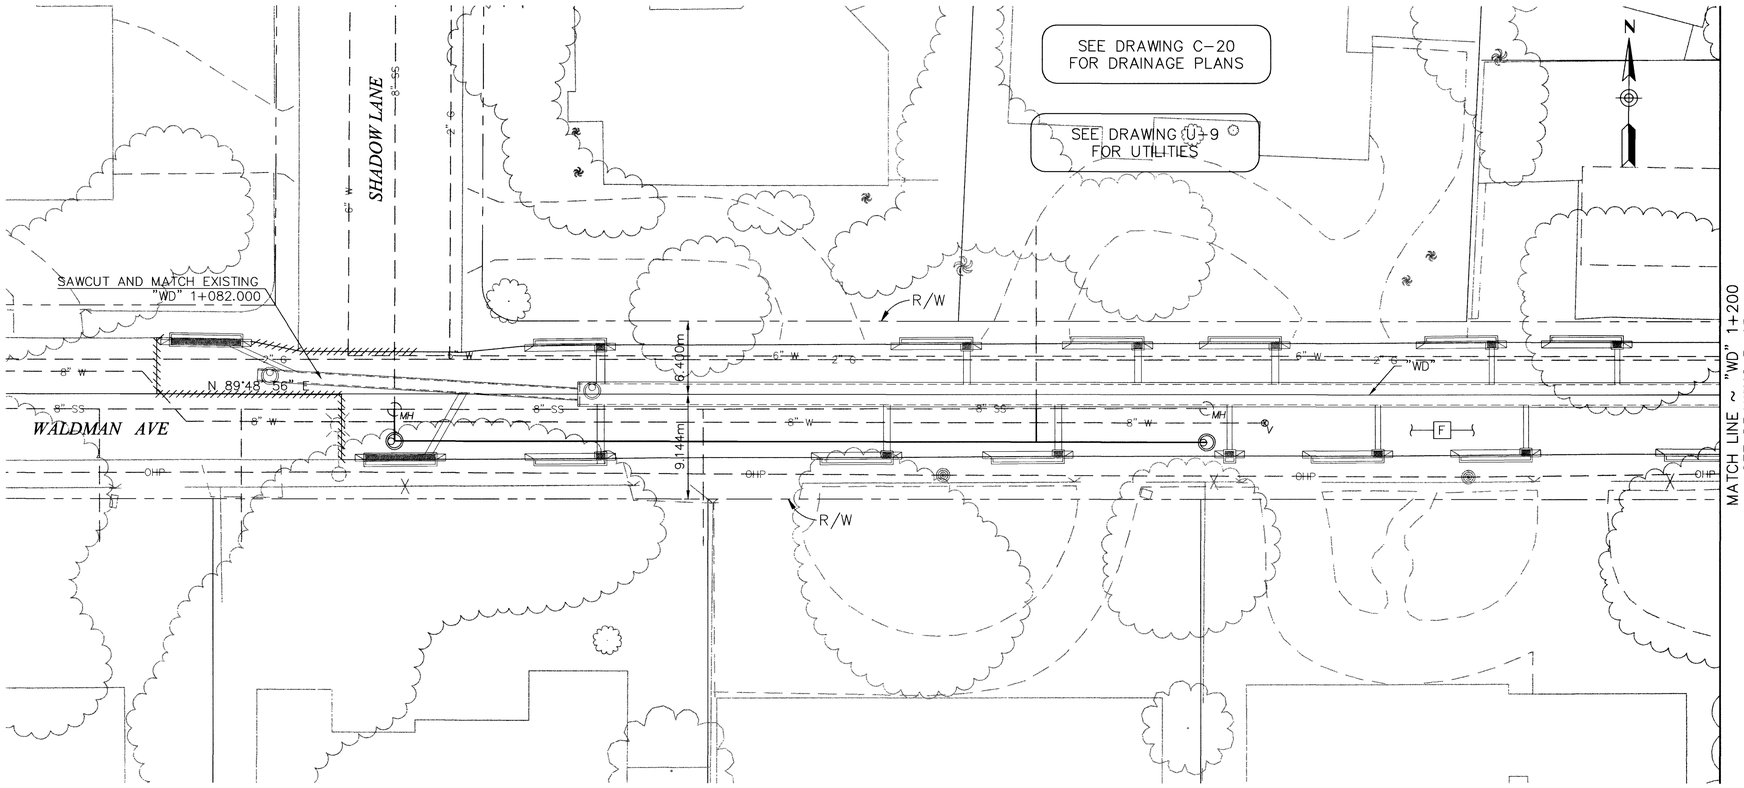

REMOVAL ITEMS

F REMOVE AC PAVEMENT

Call before you Dig. 1-800-277-2600 UNDERGROUND SERVICE (USA)

Call before you Overhead 563-6111 OVERHEAD SERVICE (USA)

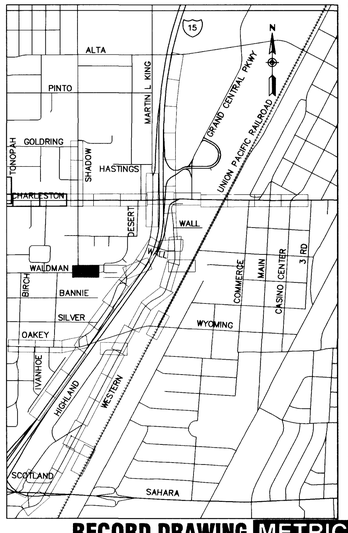

RECORD DRAWING METRIC

SCALE (H) 1:250	SCALE (V) 1:50
FLD. BK. # N/A	DATE DEC 17, 1999

PROJECT # 31604
DESIGN BY BPP

PARSONS BRINCKERHOFF
Los Vegas, Nevada

REVISIONS

	DATE
RECORD DRAWING	4/30/03

CITY OF LAS VEGAS NEVADA

DEPARTMENT OF PUBLIC WORKS

I-15 FREEWAY CHANNEL
CONSTRUCTION PLAN
"WD" 1+082 TO "WD" 1+200

ENGINEER STATE OF NEVADA JOHN P. CLARK CIVIL No. 11509 PROFESSIONAL

DRAWING No. R-14

110/241

52558 31604\Record-dwgs\r-14.dwg, 05/16/2003 03:37:46 PM, craftr

327-V254