


3288

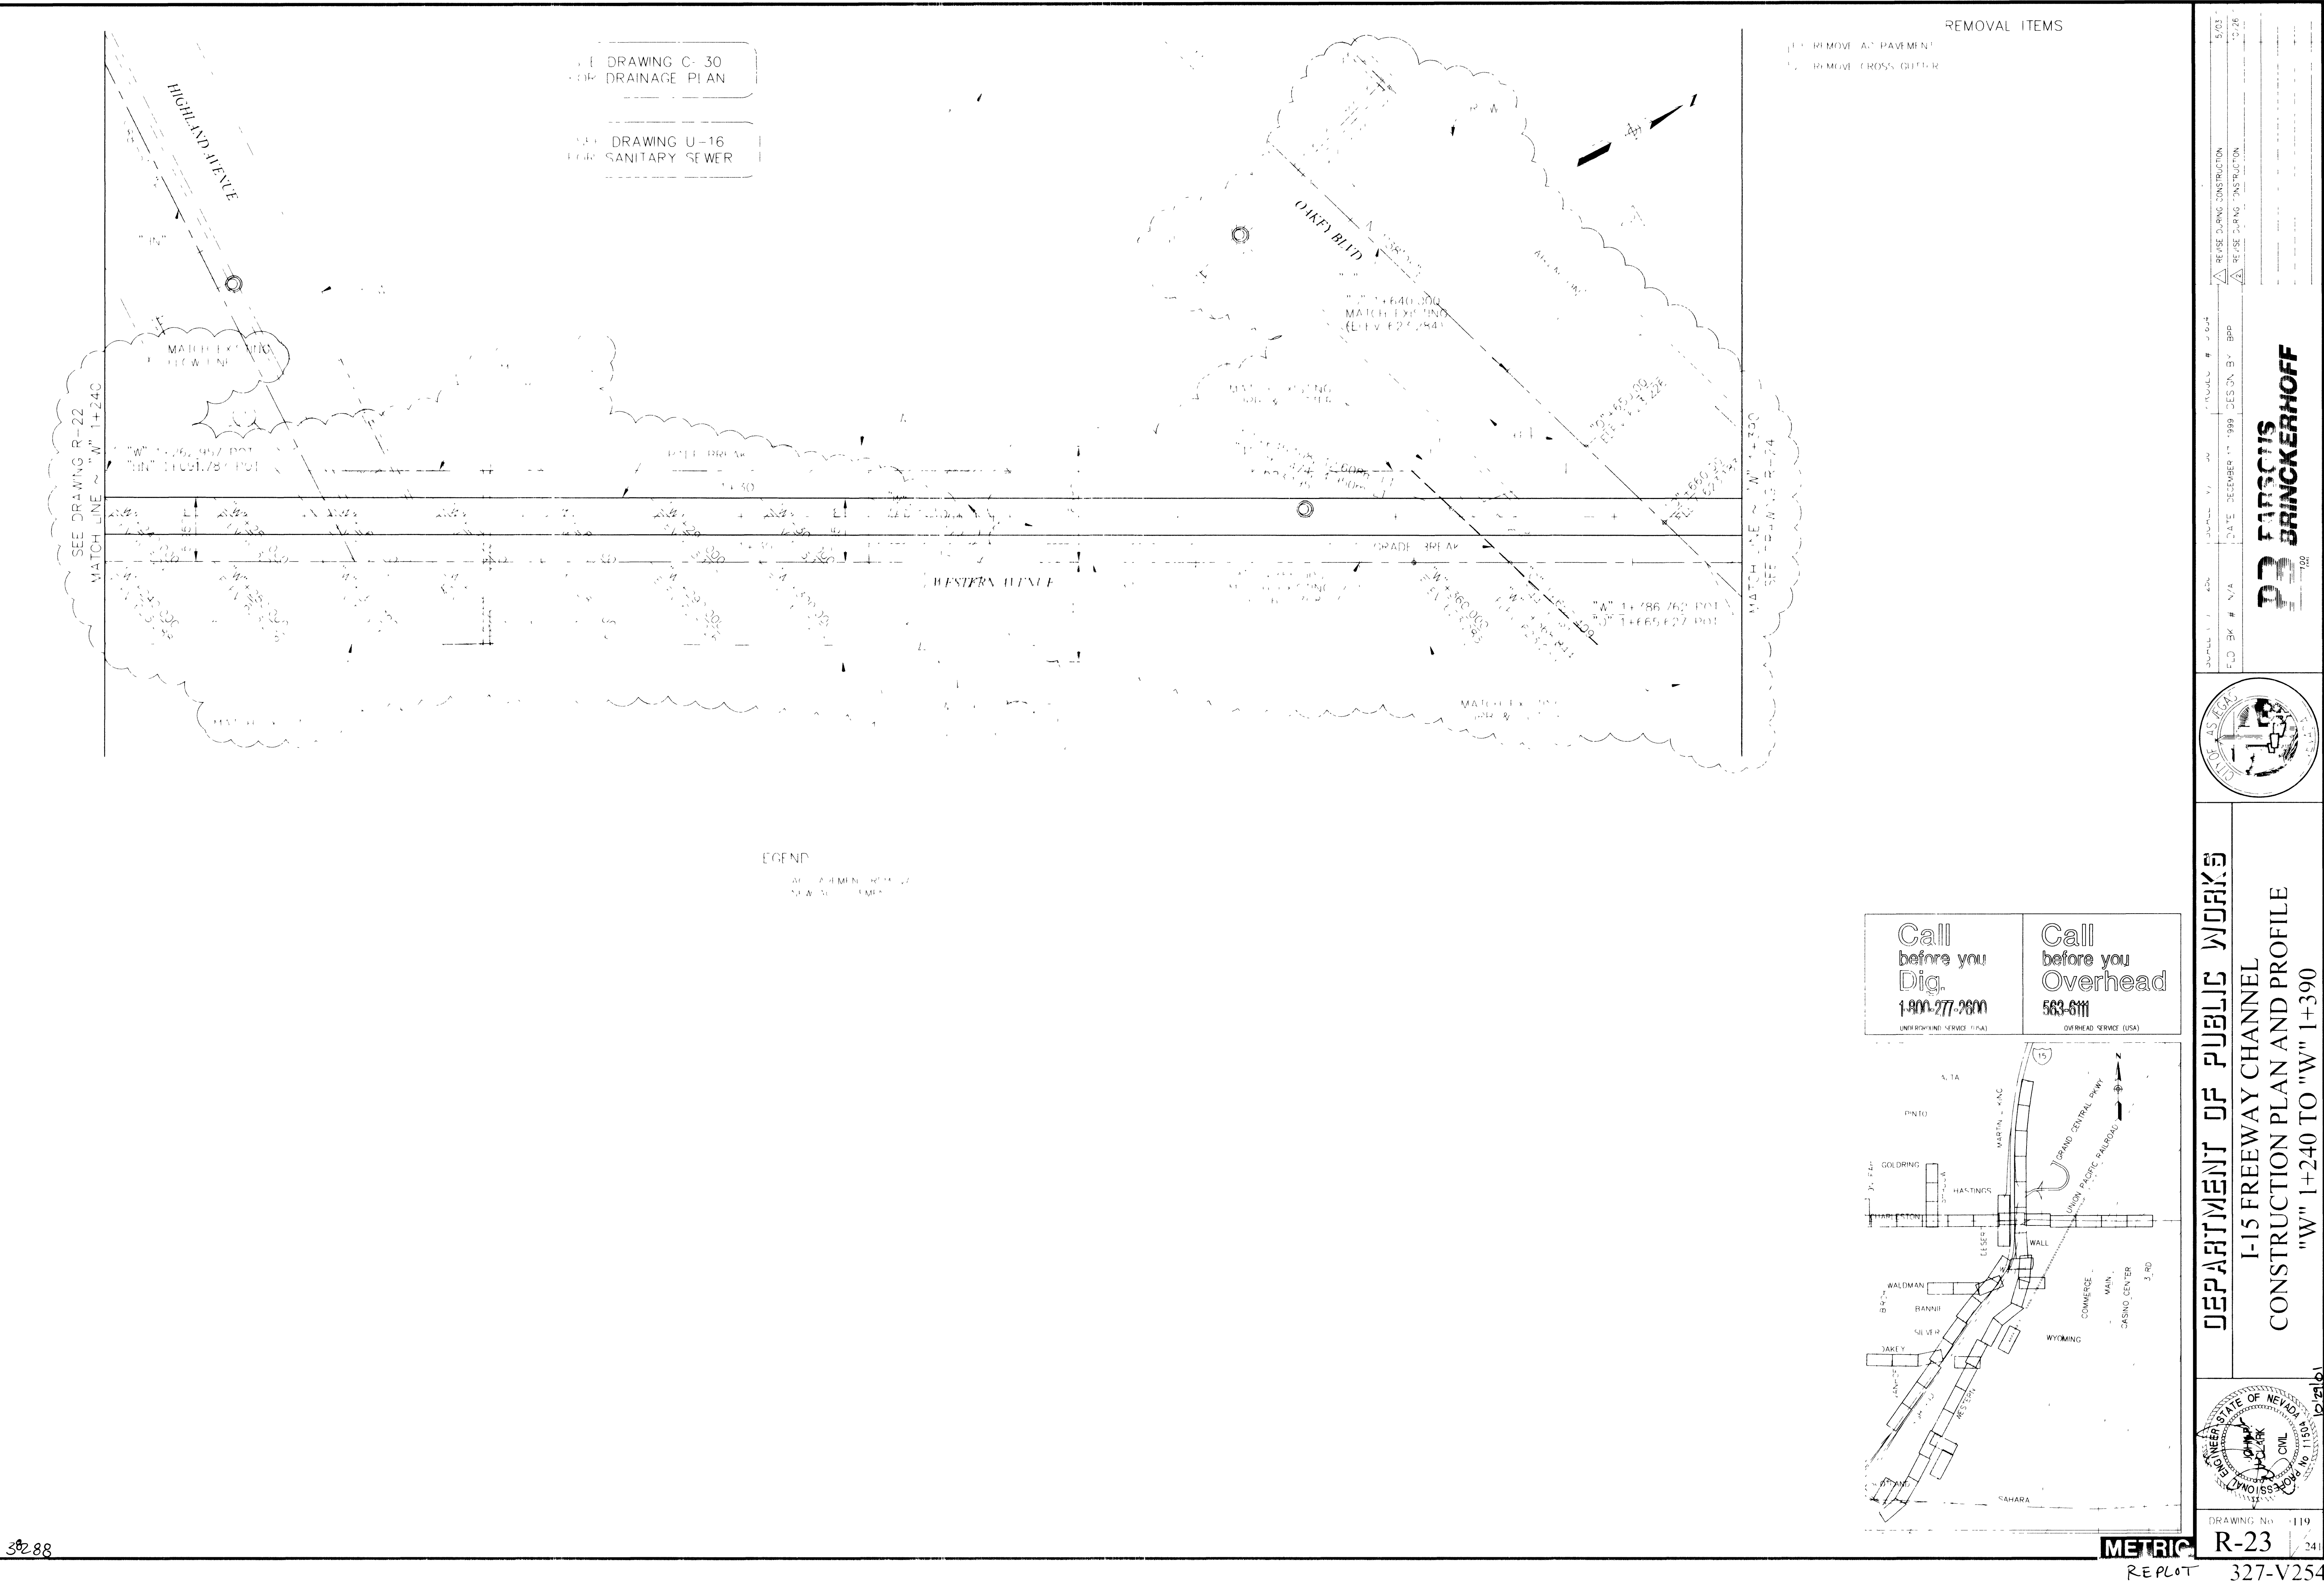

DRAWING C-30
FOR DRAINAGE PLAN

DRAWING U-16
FOR SANITARY SEWER

REMOVAL ITEMS



LEGEND

REMOVE EXISTING PAVEMENT
REMOVE EXISTING GUTTER


Call before you Dig.
1-800-277-2686
UNDERGROUND SERVICE (USA)

Call before you Overhead
563-6111
OVERHEAD SERVICE (USA)

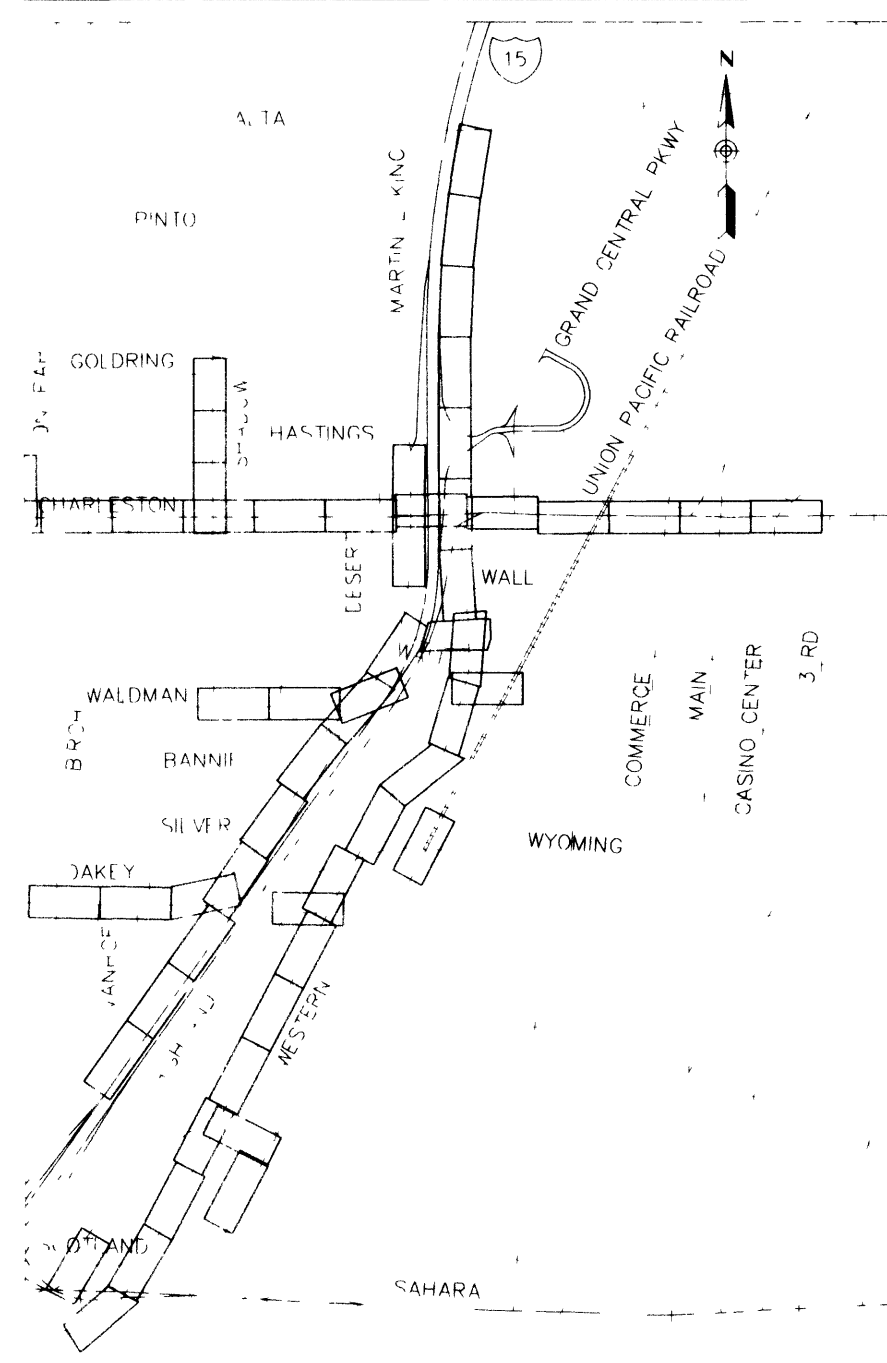

DEPARTMENT OF PUBLIC WORKS

I-15 FREEWAY CHANNEL
CONSTRUCTION PLAN AND PROFILE
"W" 1+240 TO "W" 1+390

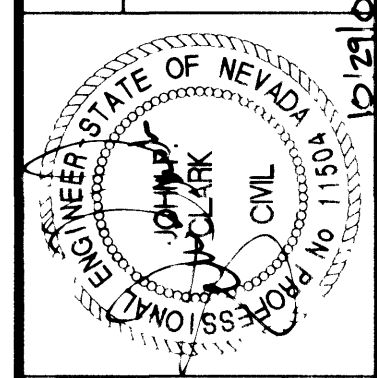

DRAWING No. R-23

DESIGN BY: BPP
DATE: 5/02
REVISION: 10/26

P3 PARSONS BRINCKERHOFF