




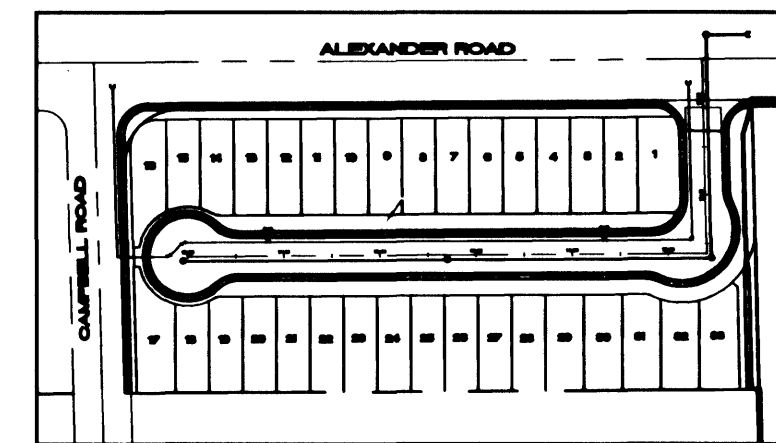


KEY MAP
NO SCALE

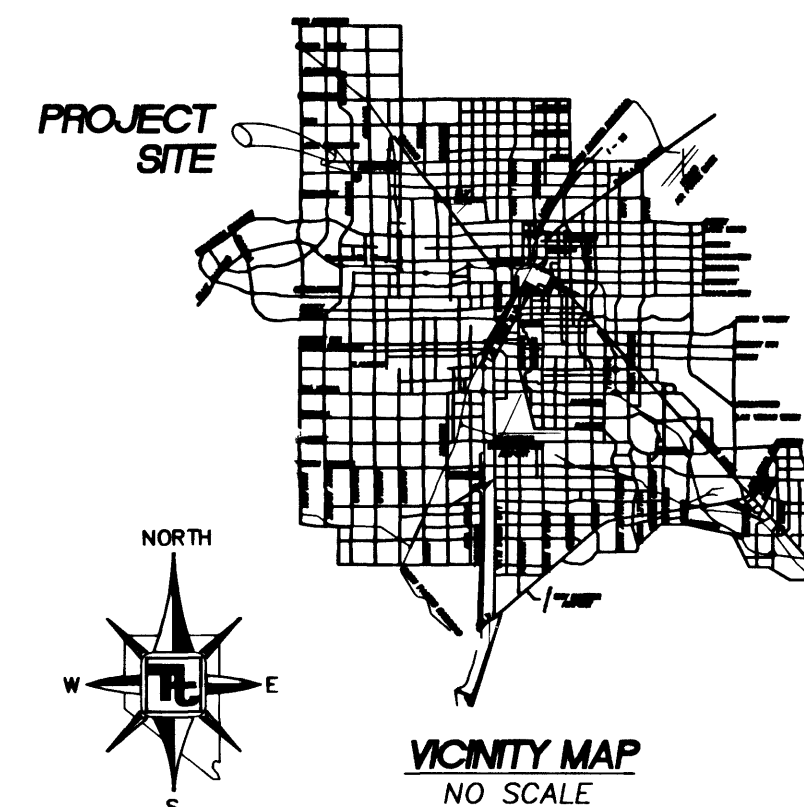


VICINITY MAP
NO SCALE

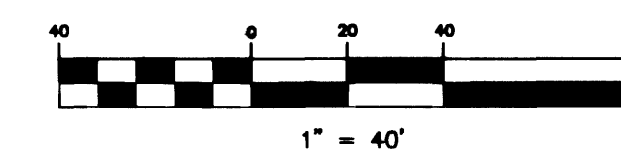

CAMPBELL ROAD - PROFILE

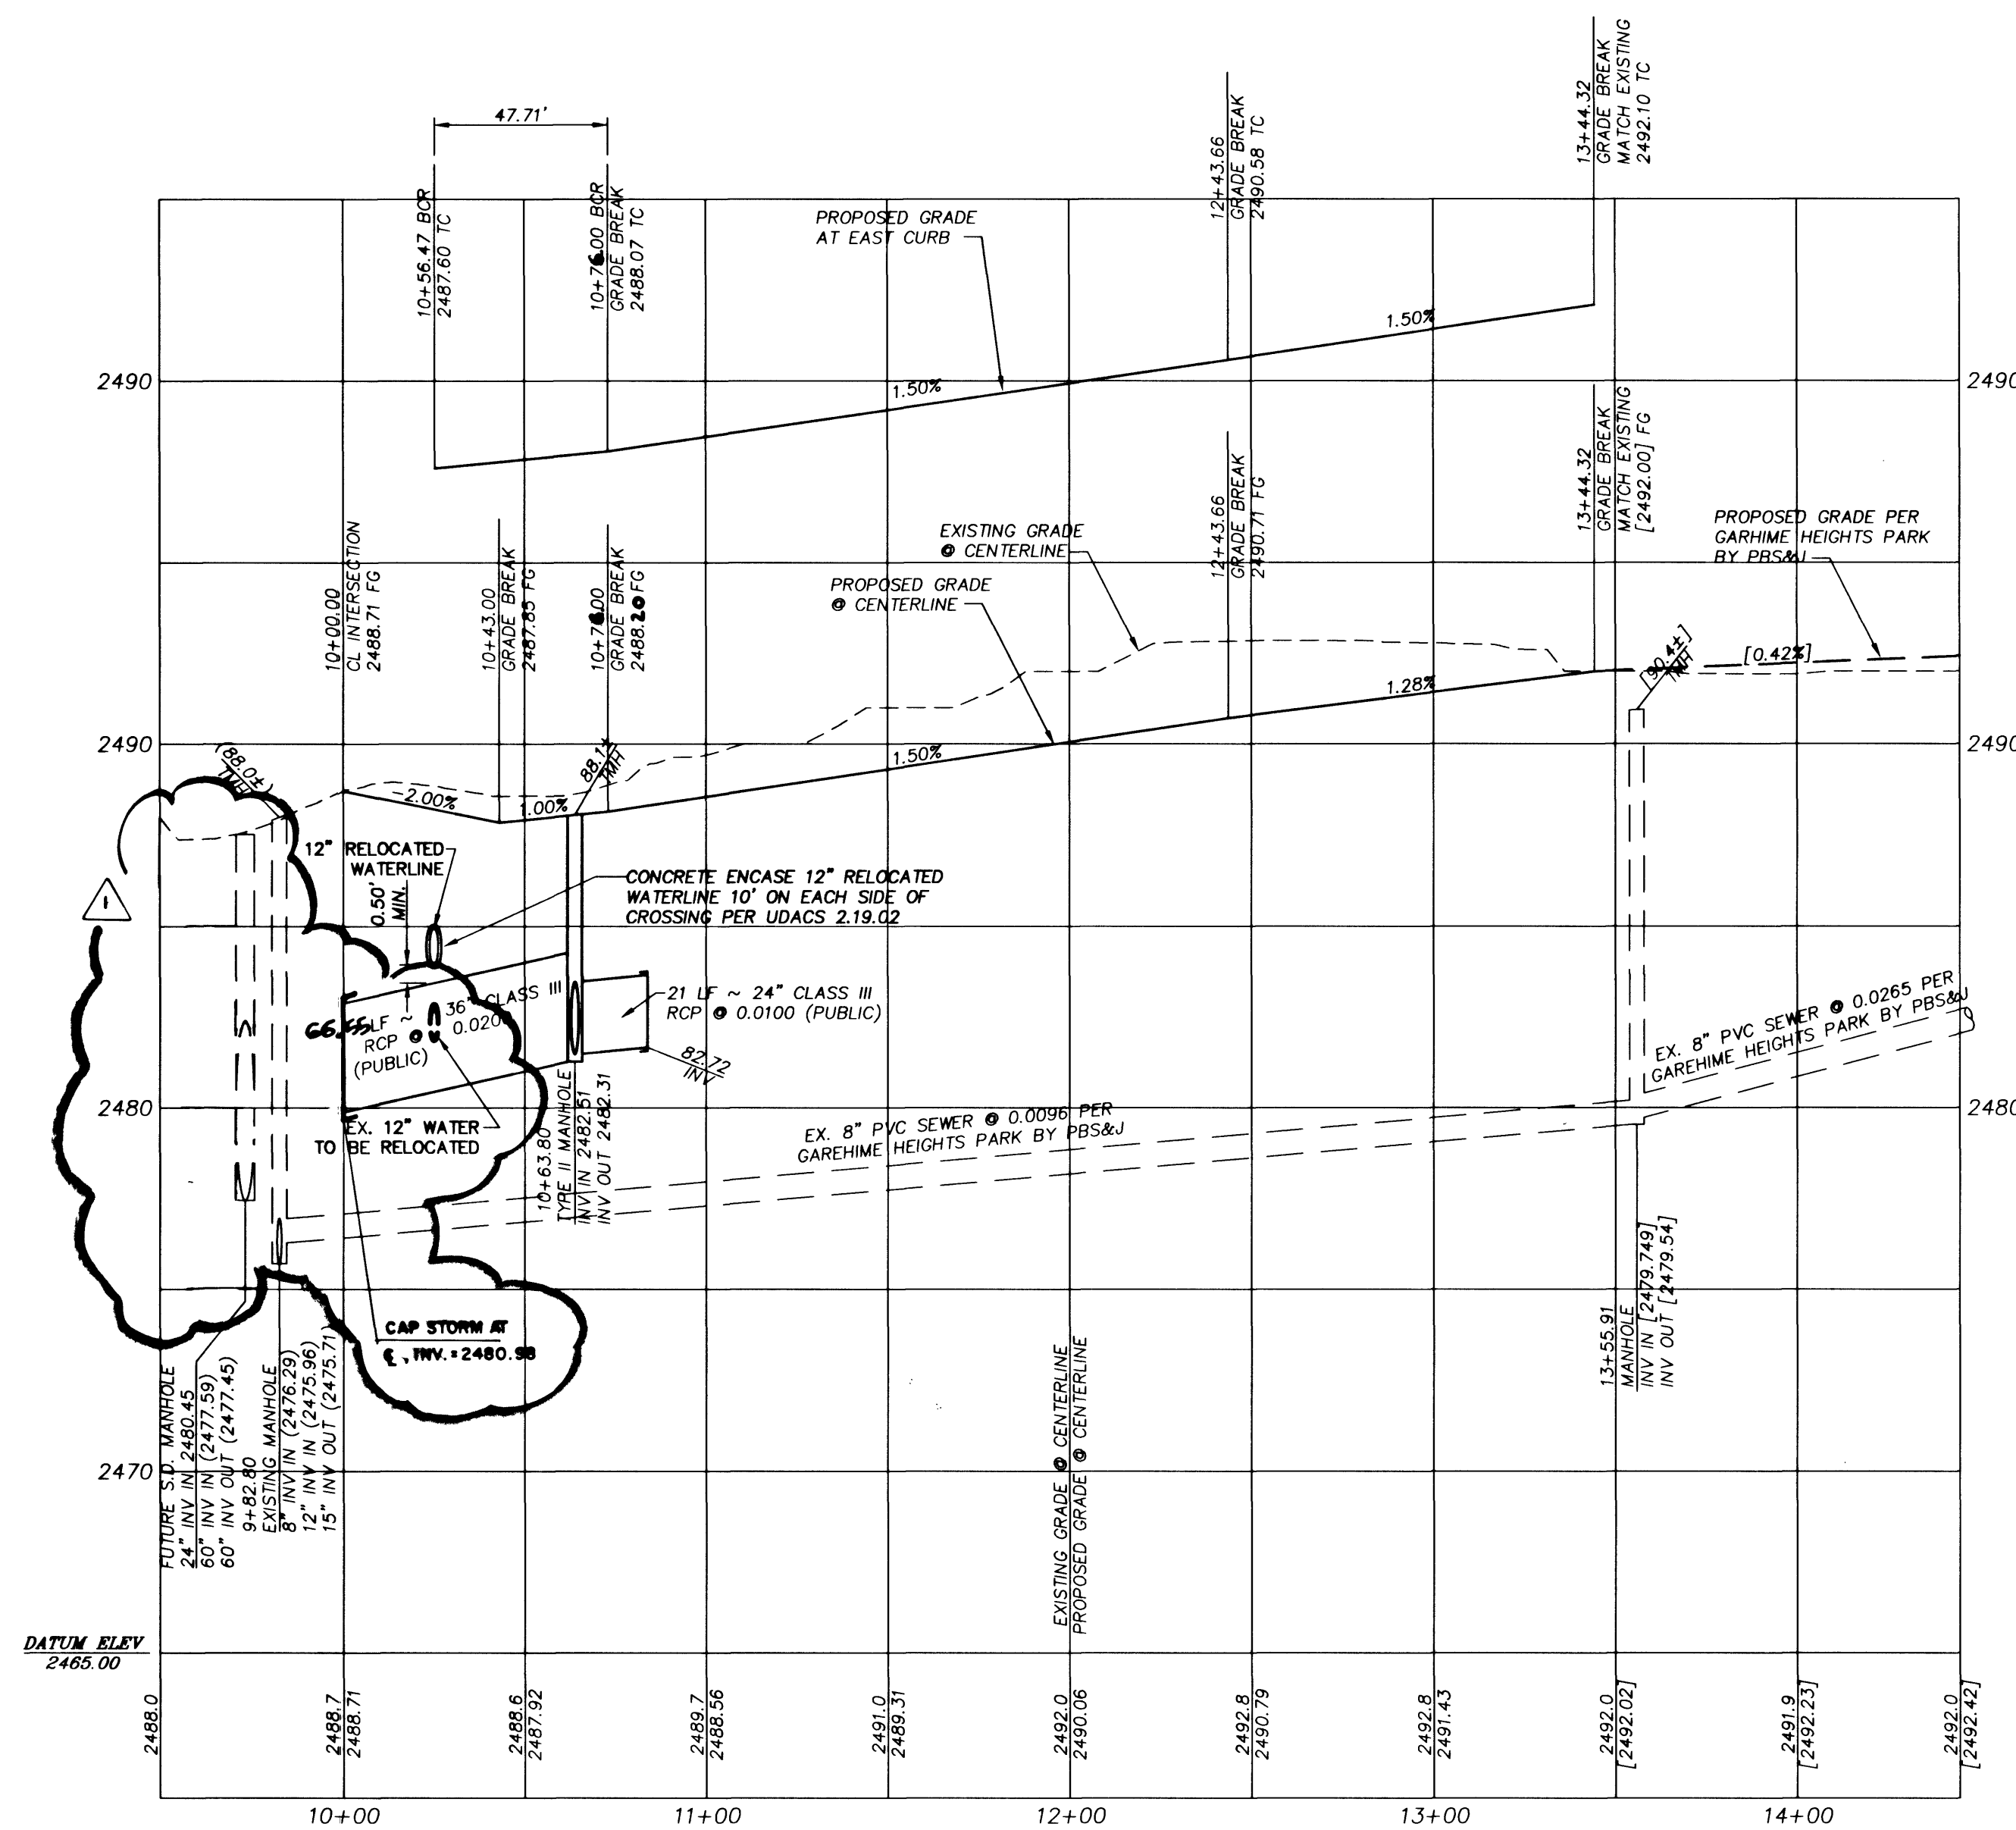

CAMPBELL ROAD - PROFILE
HORIZONTAL SCALE: 1"=40' PUBLIC STREET

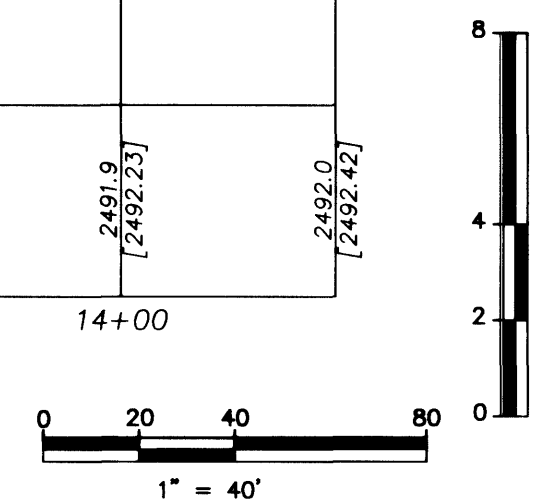

LEGEND

-
- PROPERTY LINE / RIGHT-OF-WAY
- "L" TYPE CURB AND GUTTER
- "A" TYPE CURB
- EXISTING CURB AND GUTTER
- PROPOSED WATER LINE (SIZE AS SHOWN)
- PROPOSED SEWER LINE (SIZE AS SHOWN)
- EXISTING UTILITY (AS SHOWN)
- CROSS GUTTER
- WHEELCHAIR RAMP
- CUT OR FILL SLOPE
- PROPOSED PAVEMENT AREA
- PROPOSED ELEVATION (DESCRIPTION AS SHOWN)
- EXISTING ELEVATION (DESCRIPTION AS SHOWN)
- EXISTING DESIGN ELEVATION (DESCRIPTION AS SHOWN)
- DETAIL OR SECTION NUMBER
SHEET DETAIL IS SHOWN
- PHASE LINE
- BLOCK WALL
- RETAINING WALL
- EXISTING PAVEMENT TO BE REMOVED
AND REPLACED

CONSTRUCTION NOTES

- ① CONSTRUCT 2" AC PAVING OVER 6" TYPE II ON 6" TYPE I PER STD. DWG. 207
- ② CONSTRUCT 3" AC PAVING OVER 4" TYPE II ON 6" TYPE I BASE PER STD. DWG. 205
- ③ CONSTRUCT 5" AC PAVING OVER 4" TYPE II ON 9" TYPE I BASE PER STD. DWG. 203
- ④ CONSTRUCT SIDEWALK RAMP PER STD. DWG. 235
- ⑤ CONSTRUCT "L" TYPE CURB AND GUTTER PER STD. DWG. 216
- ⑥ CONSTRUCT CONCRETE SIDEWALK PER STD. DWG. 234
- ⑦ CONSTRUCT 8" CROSS GUTTER PER STD. DWG. 228
- ⑧ CONSTRUCT UNDERSIDEWALK DRAIN PER STD. DWG. 236
- ⑨ CONSTRUCT 2' VALLEY GUTTER PER DETAIL H, SHEET D71
- ⑩ CONSTRUCT TYPE "QM" MODIFIED DROP INLET
D=3.00', L=32', NG = 8
- ⑪ CONSTRUCT 48" TYPE II MANHOLE PER STD. DWG. 405
- ⑫ CONSTRUCT 24.66 LF $\approx$ 30" CLASS III RCP STORM DRAIN @ 0.0200
- ⑬ CONSTRUCT 111.33 LF $\approx$ 36" CLASS III RCP STORM DRAIN @ 0.0200
- ⑭ SAWCUT TO CLEAN EDGE. MATCH EXISTING
- ⑮ TRENCH AND BACKFILL PER DCSWCS TYPE SD--168
CONSTRUCT 5" AC PAVING OVER 4" TYPE II ON 9" TYPE I BASE PER STD. DWG. 203
- ⑯ CONSTRUCT 21 LF $\approx$ 24" CLASS III RCP STORM DRAIN @ 0.0100

BENCHMARK

CITY OF LAS VEGAS BENCHMARK - NO.18 1LV00-4SES RIVET AND SQUARE ALUMINUM PLATE IN TOP OF CURB, NORTHWEST RETURN OF ALEXANDER ROAD AND BUFFALO DRIVE

ELEVATION = 713.8497 METERS (NAVD88)
ELEVATION = 2342.0267 FEET (NAVD88)

BASIS OF BEARING

S 89°41'26" W BEING THE NORTH LINE OF THE NORTHWEST QUARTER (NW 1/4) OF THE NORTHWEST QUARTER (NW 1/4) OF SECTION 9, TOWNSHIP 20 SOUTH, RANGE 60 EAST, M.D.M., CITY OF LAS VEGAS, CLARK COUNTY, NEVADA AS SHOWN IN BOOK 89, PAGE 68 OF PLATS IN THE CLARK COUNTY RECORDER'S OFFICE, CLARK COUNTY, NEVADA.

H.C. RAMP DATA

PER STANDARD DRAWING. 235

NO.	"A"	"B"	CASE
A	8.0'	8.0'	III
B	4.5'	12.0'	III
C	8.0'	8.0'	I
D			
E			
F			

Avoid cutting underground utility lines. It's costly.

Call before you Dig

1-800-227-2600

UNDERGROUND SERVICE (USA)

Avoid overhead power
line contact.

**Call
before you
Overhead**

1-702-593-6111

**NEVADA POWER ENVIRONMENT
SAFETY SERVICES DEPARTMENT**

KB HOME NEVADA, INC.

STREET PLAN AND PROFILE
CAMPBELL ROAD


GOLDRUSH V(a)
CITY OF LAS VEGAS, NEVADA

TETRA TECH, INC.



GOLDRUSH V(a)

PROJECT NO. PNVKABO15

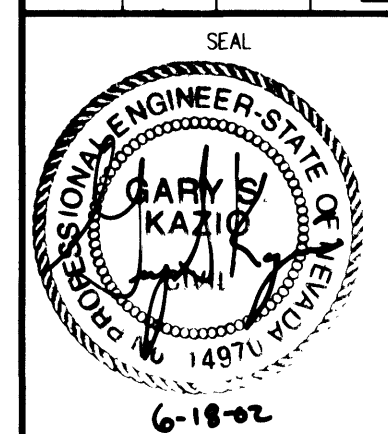

SHEET **PP3**
10 OF 13

327Y-4648-5a

69145 (702) 242-4200 P:\KB\015\Engineering\Imp\015-PROFILES.dwg 06/18/2002 09:55:14 AM PDT