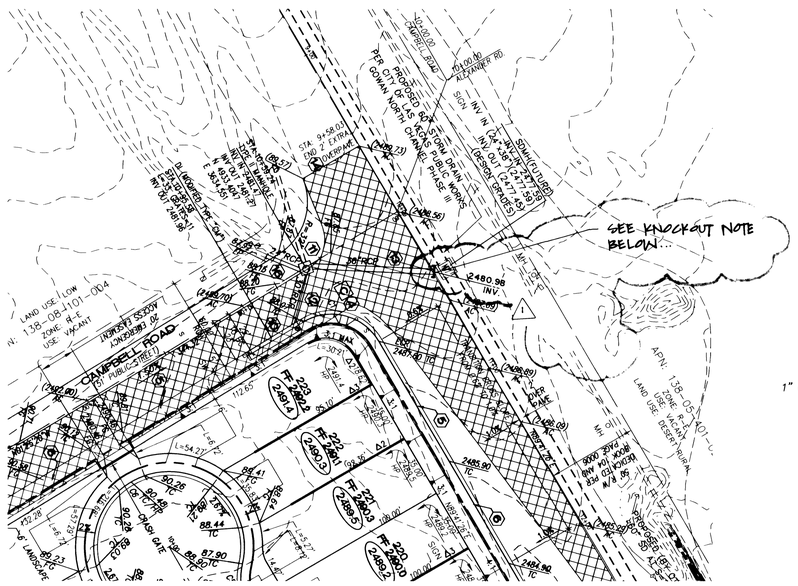
SEE KNOCKOUT NOTE BELOW...
CAMPBELL ROAD
LAND USE: LOW
APN: 138-08-101-004
ZONE: R-E
USE: VACANT
PER CITY OF LAS VEGAS GOMM NORTH CHANNEL PUBLIC WORKS PROJECT PHASE III
PROPOSED 60" STORM DRAIN
ALEXANDER RD
APN: 138-05-701-006
LAND USE: RESERVE/RURAL
PARK
2480.98 INV
2481.90 INV
