


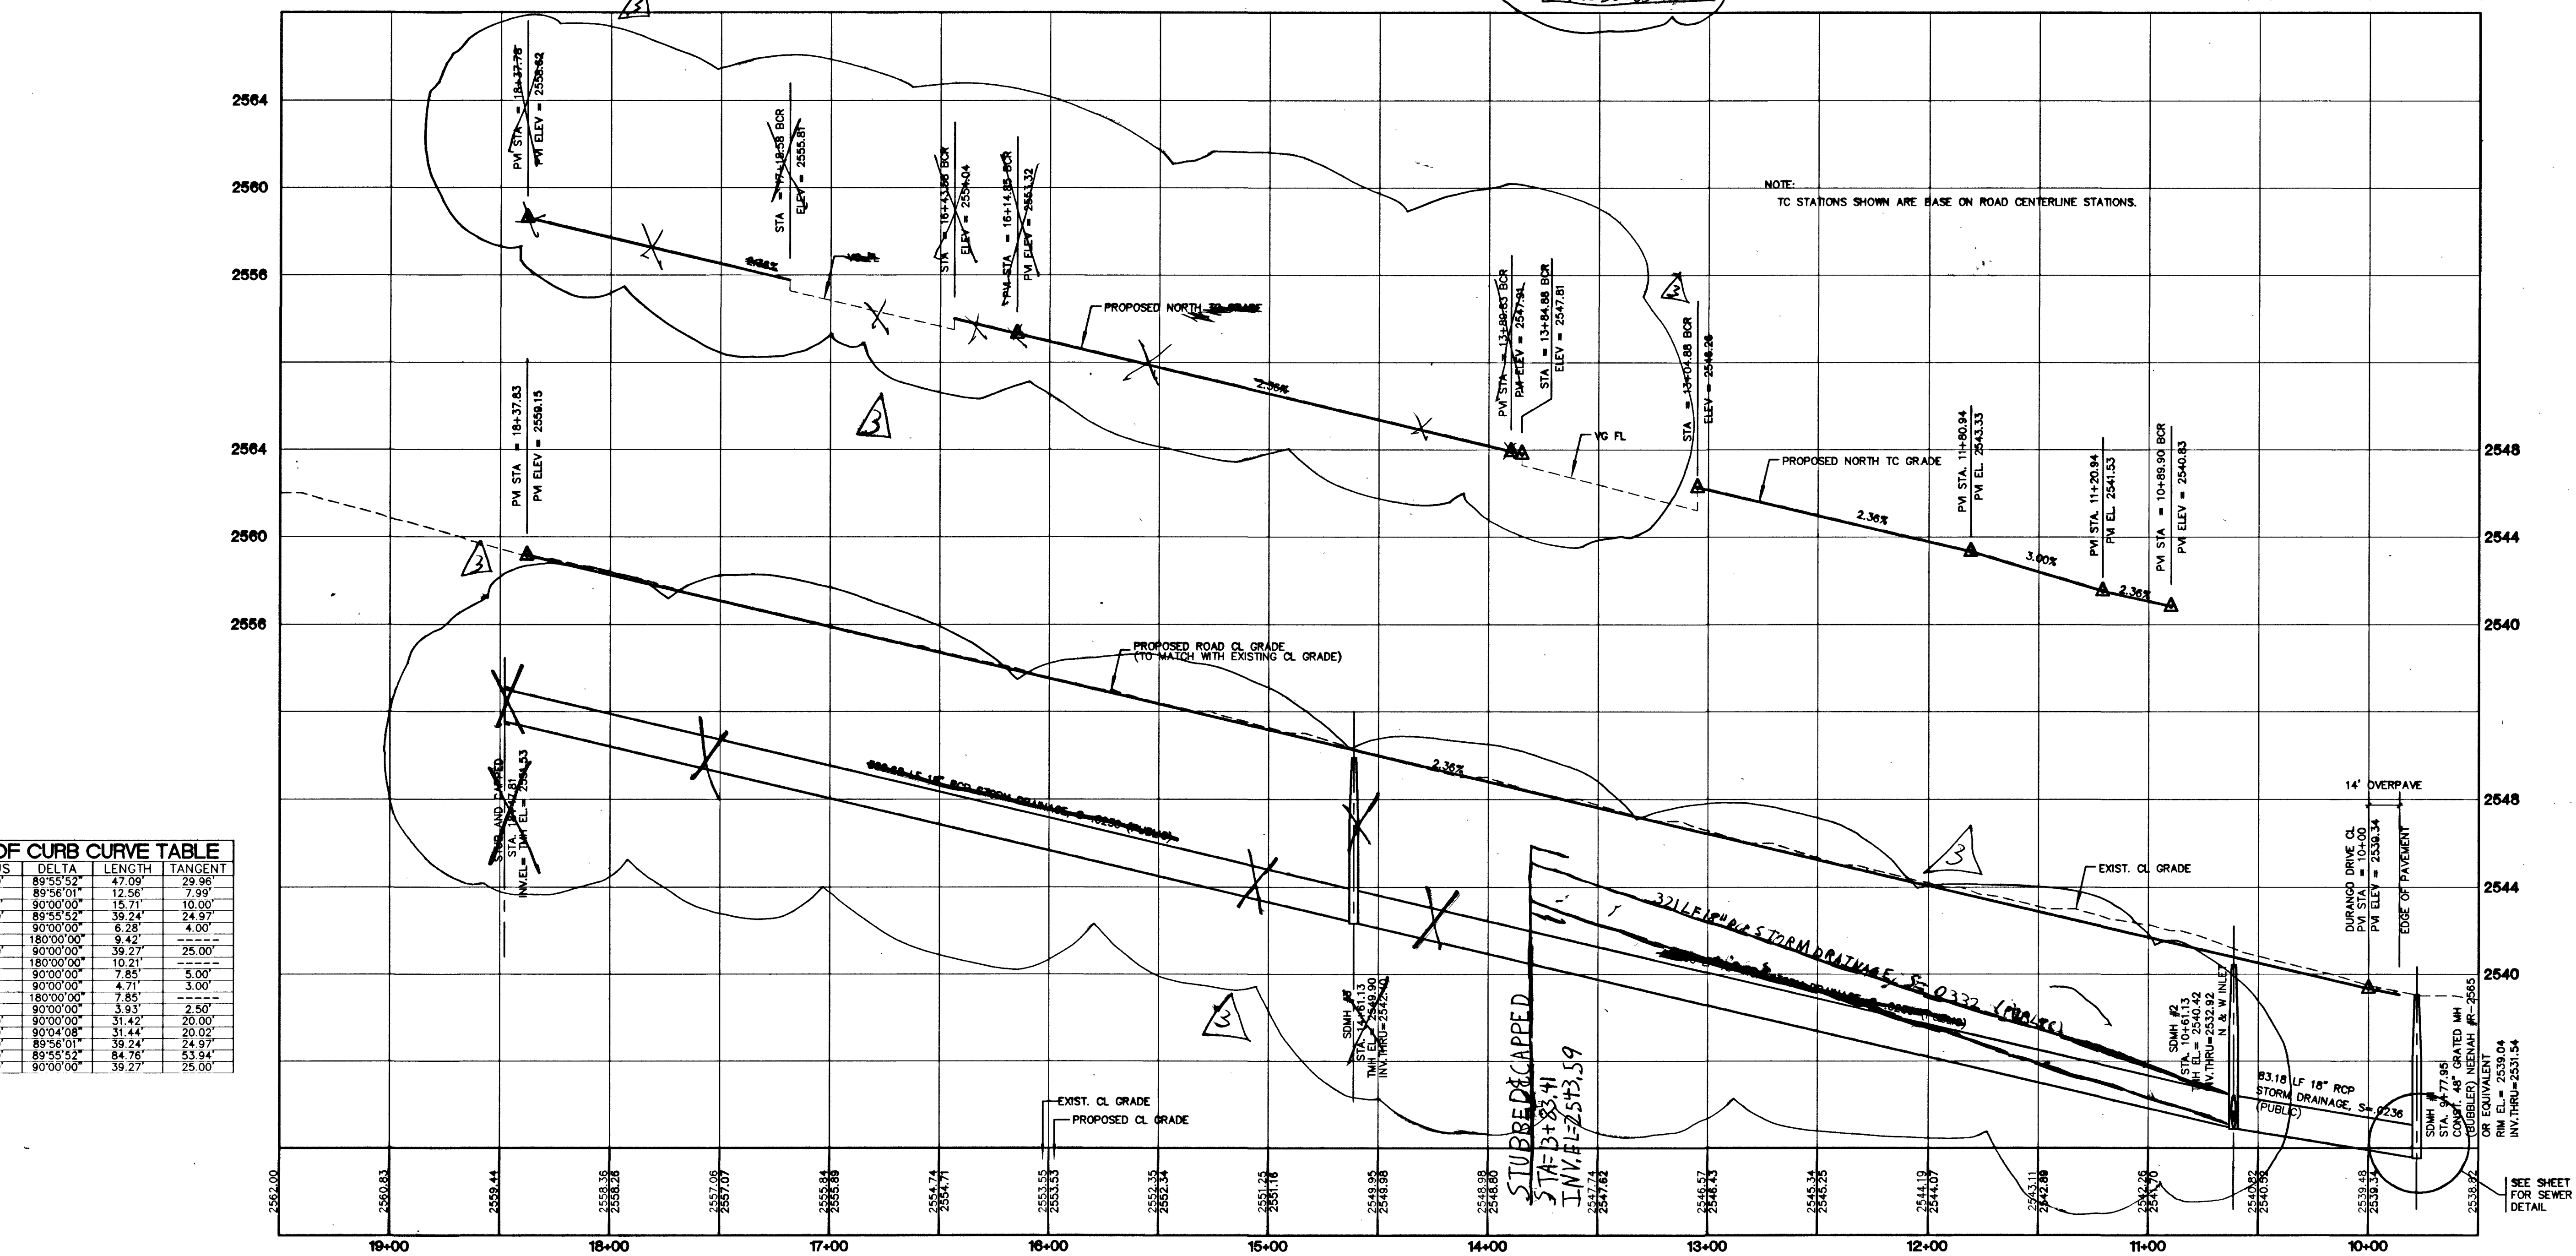

BACK OF CURB CURE TABLE				
NO.	RADIUS	DELTA	LENGTH	TANGENT
C1	30.00	89°55'52"	47.09	29.96
C2	8.00	89°56'01"	12.56	7.99
C3	25.00	90°00'00"	15.71	10.00
C17	25.00	90°00'00"	39.27	25.00

Avoid cutting underground utility lines. It's costly.

Call
before you
Dig
1-800-227-2600

Avoid overhead power line contact

Call
before you
OVERHEAD
1-702-593-6111

BASIS OF BEARINGS

NORTH 00°05'38" EAST, BEING THE BEARING OF THE EAST LINE OF THE SOUTHEAST QUARTER (SE 1/4) OF THE SOUTHEAST QUARTER (SE 1/4) OF SECTION 8, AS SHOWN ON A RECORD OF SURVEY ON FILE IN THE CLARK COUNTY, NEVADA, RECORDER'S OFFICE IN FILE 88 OF SURVEYS, AT PAGE 15.

BENCHMARK

NAVD VERTICAL DATUM
CITY OF LAS VEGAS BENCHMARK 1LV90-0NES
NAVD88 ELEVATION : 771.9689 METERS (2532.70 FEET)
BLM BRASS CAP LOCATED AT DURANGO DRIVE AND IRON MOUNTAIN ROAD.

SOUTHWEST DESERT EQUITIES

**STREET PLAN AND PROFILE
STORM DRAIN RCP PROFILE
GRAND TETON DRIVE**

GRAND TETON/DURANGO

DRAWN BY:

	NOV.1999
VAV	

DESIGNED BY:
VAV
NOV.1999

CHECKED BY: _____ NOV.1999

PROJECT NO:	SCALE: 40	HOP
-------------	-----------	-----

SEAL



Professional Engineer - State of Nevada
THOMAS HAYES
CIVIL
No. 9428

1/26/0

SHEET
S1
7 OF 11 SHEETS

DRAWING NO.
3274-4660

1/26/0
ET
1
11 SHEETS
IG NO.
60