
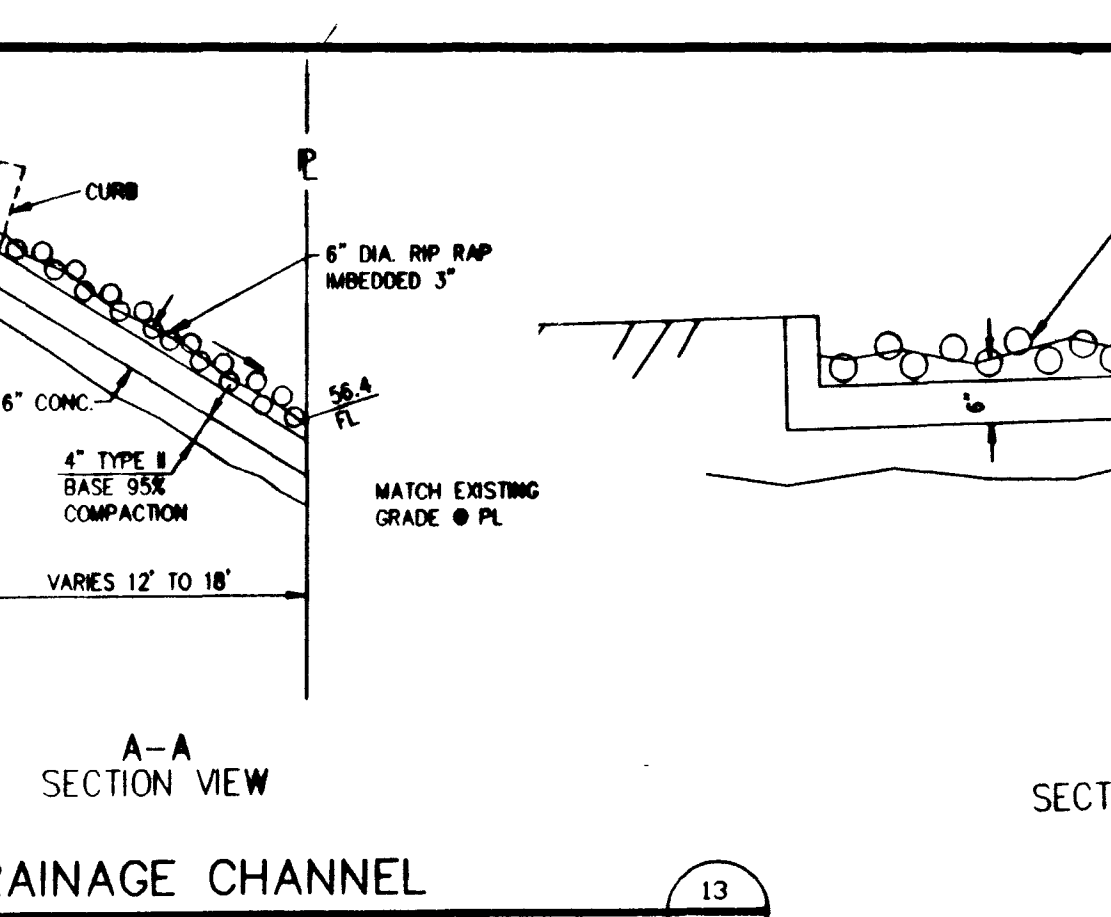
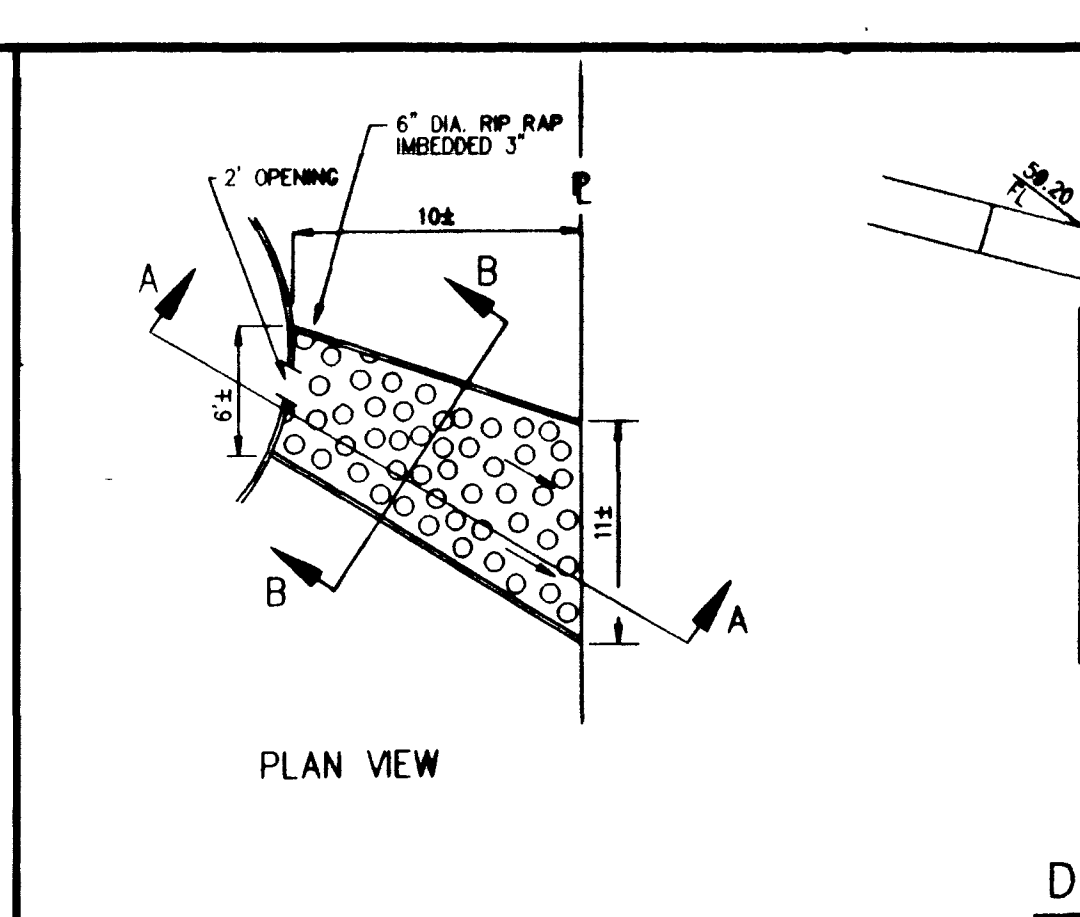
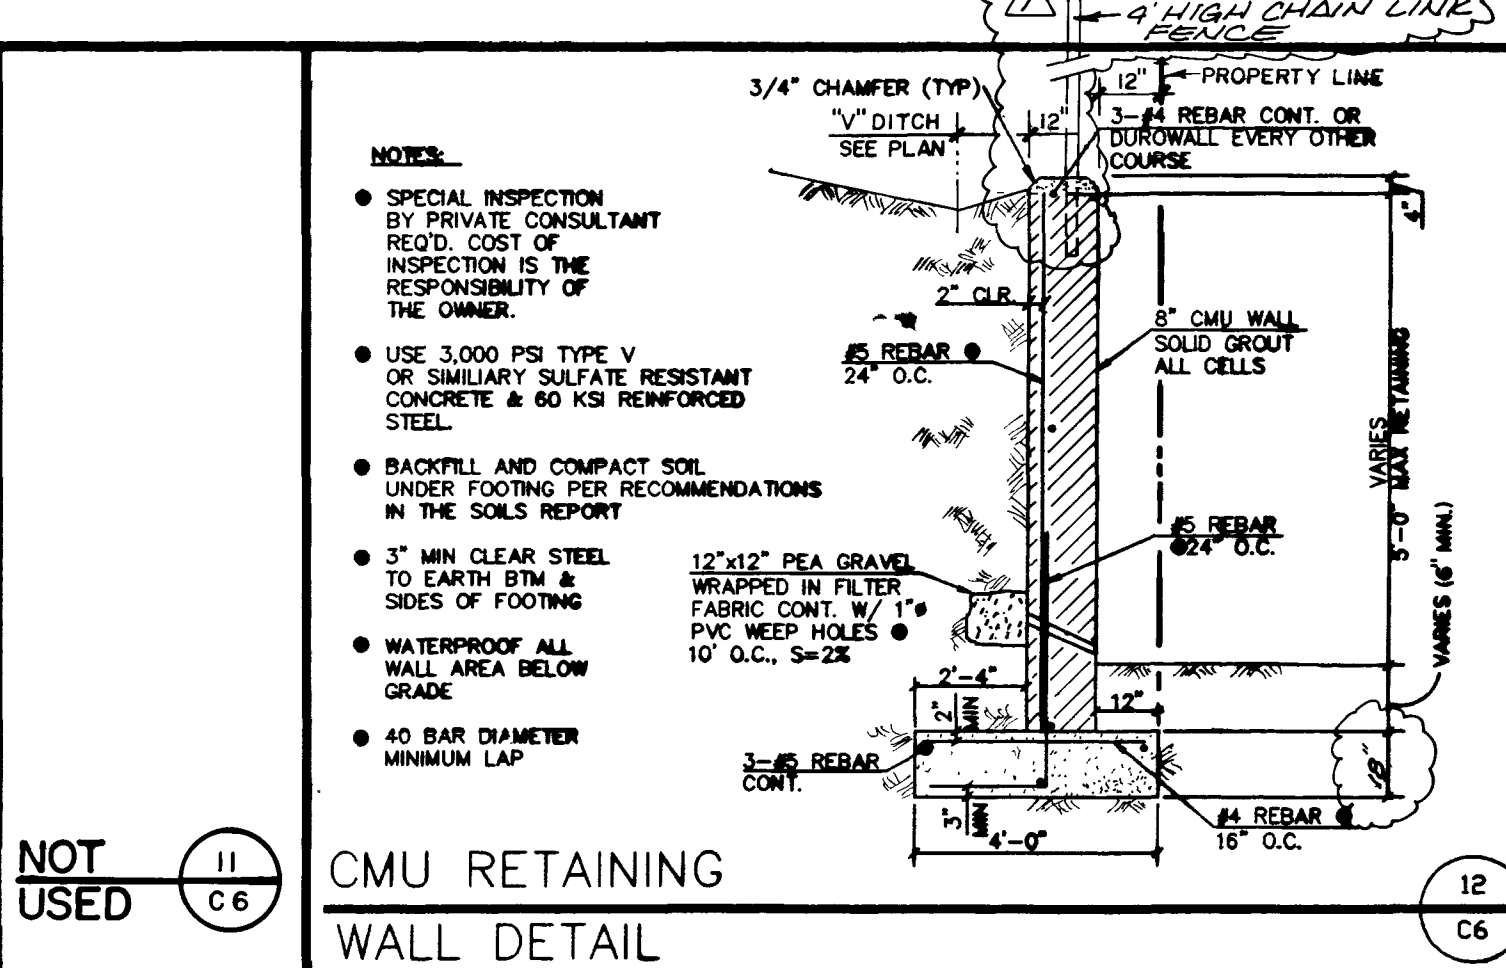
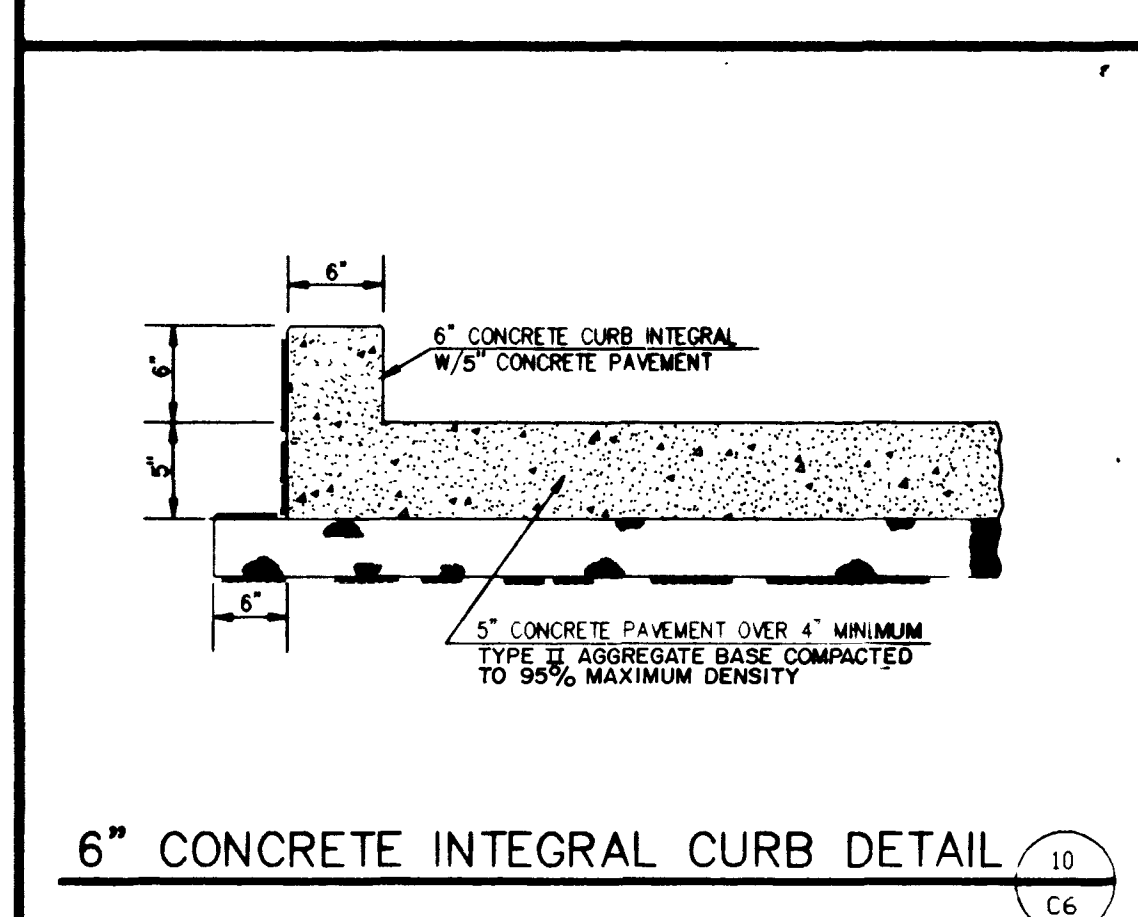
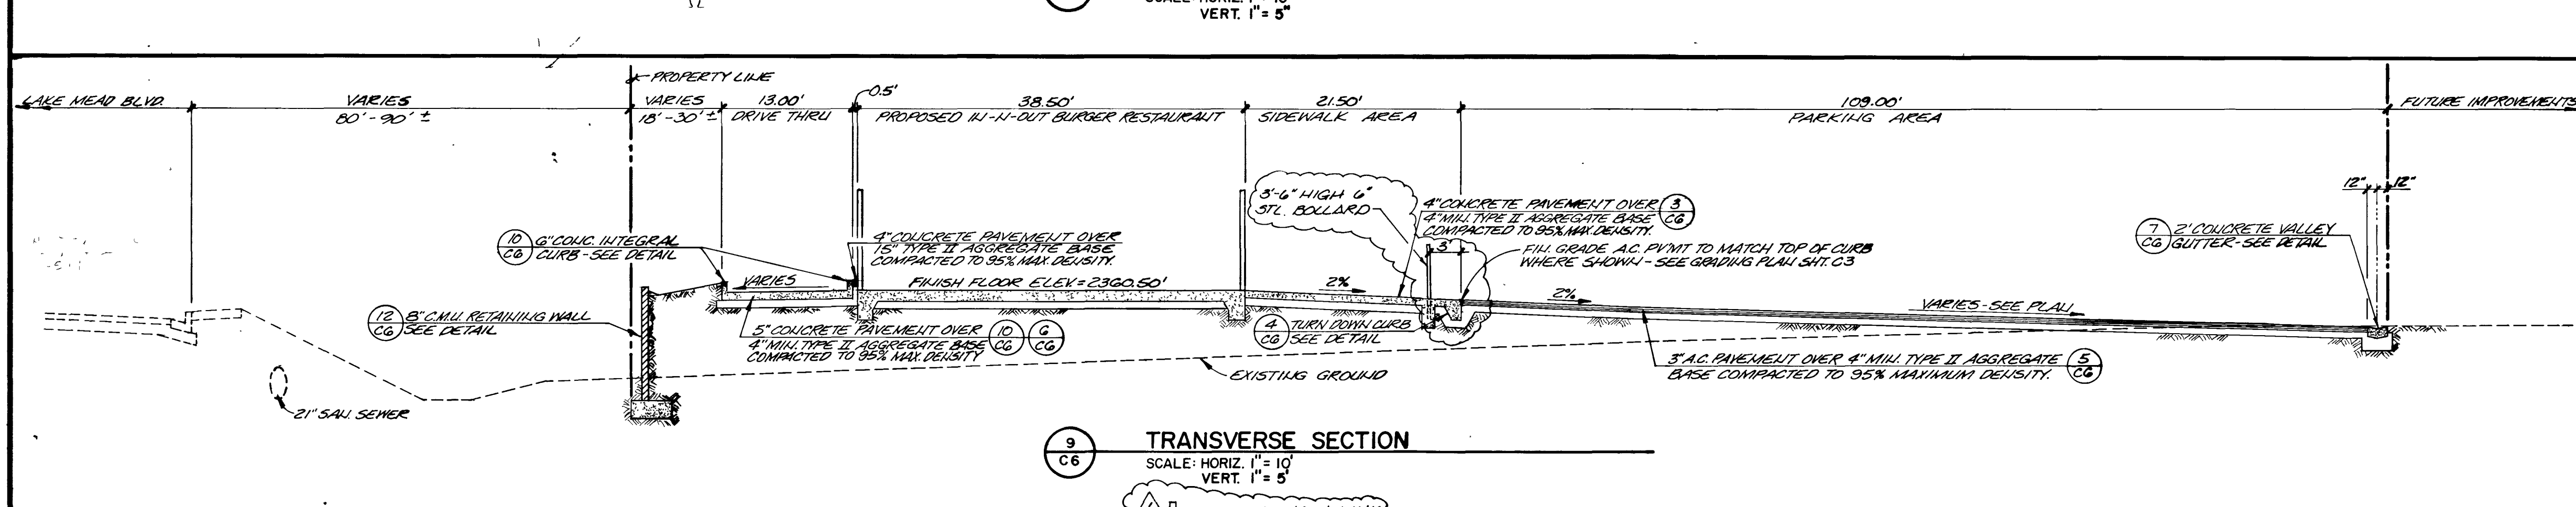
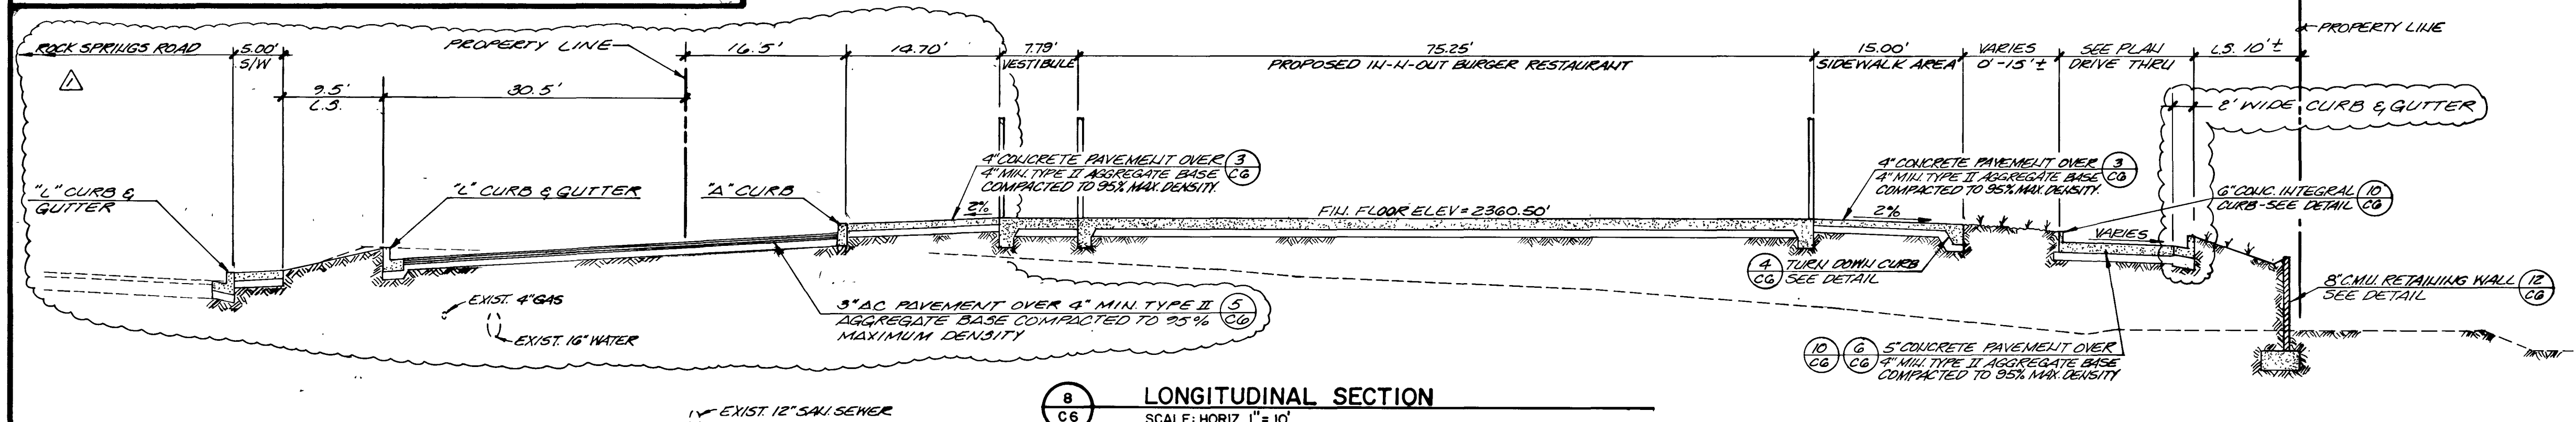
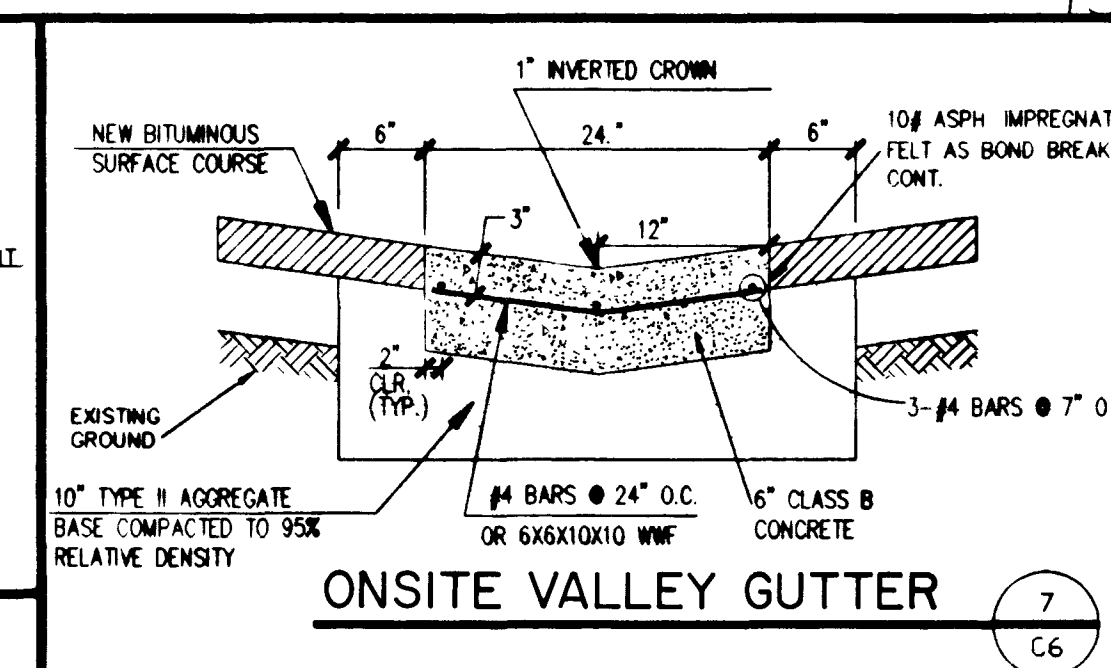
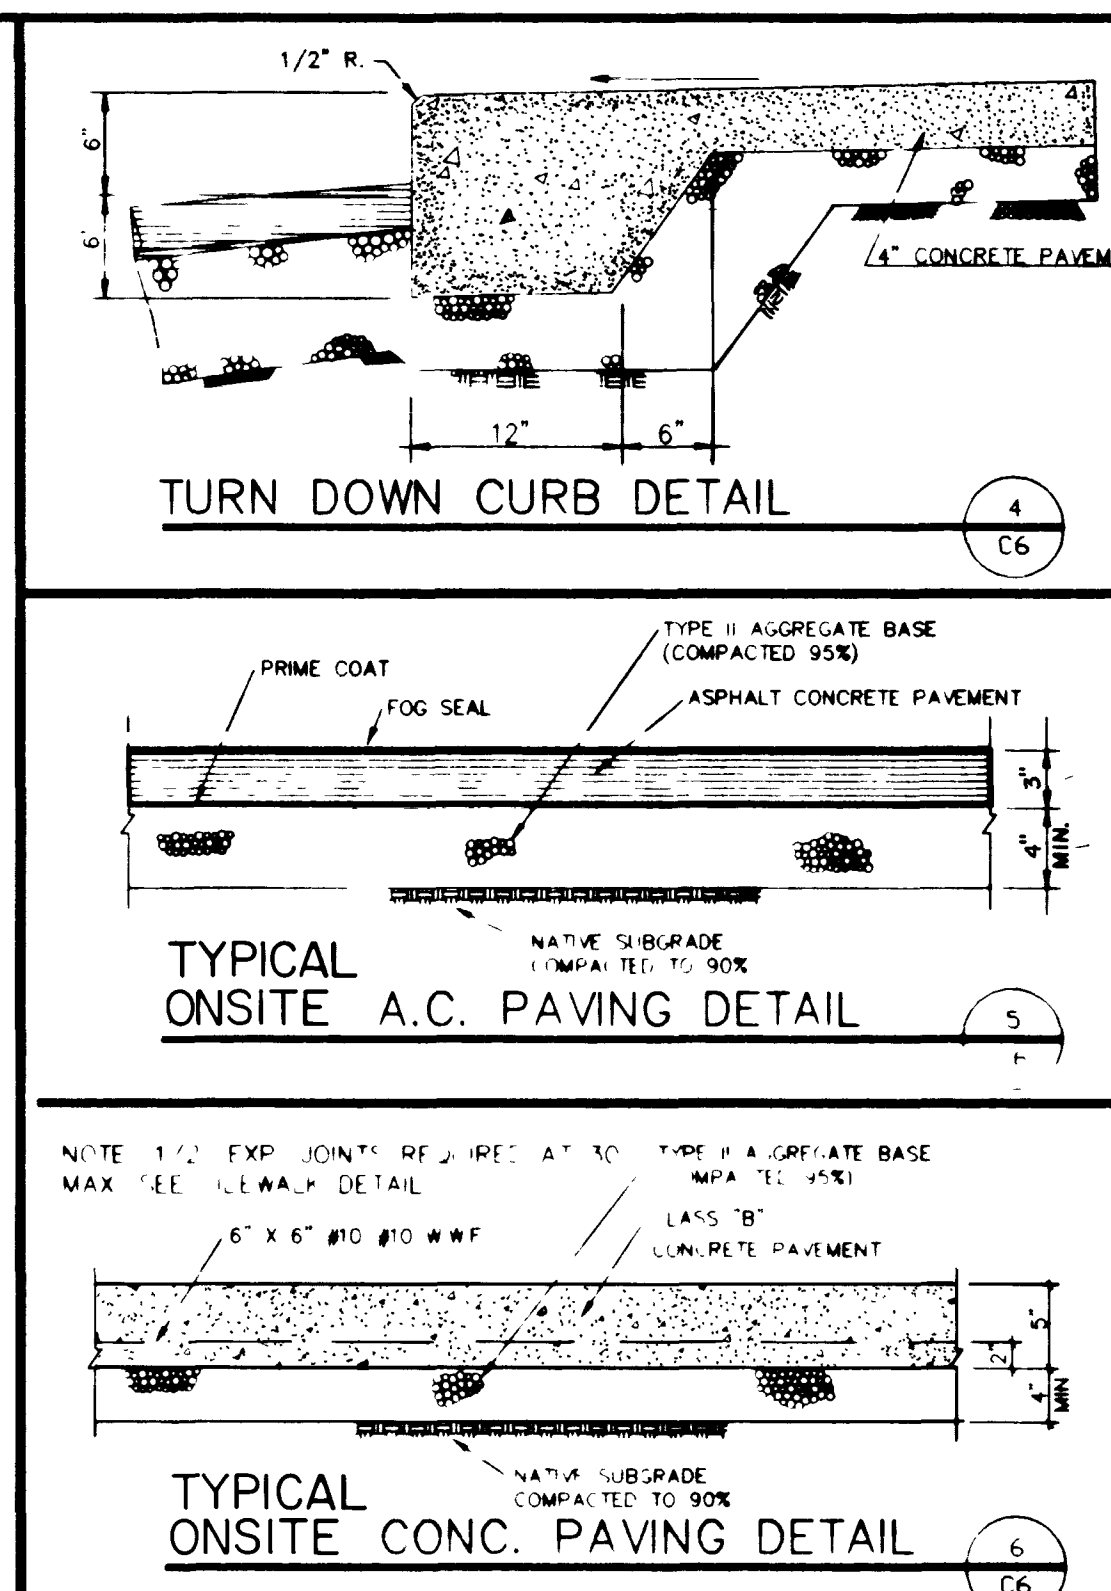
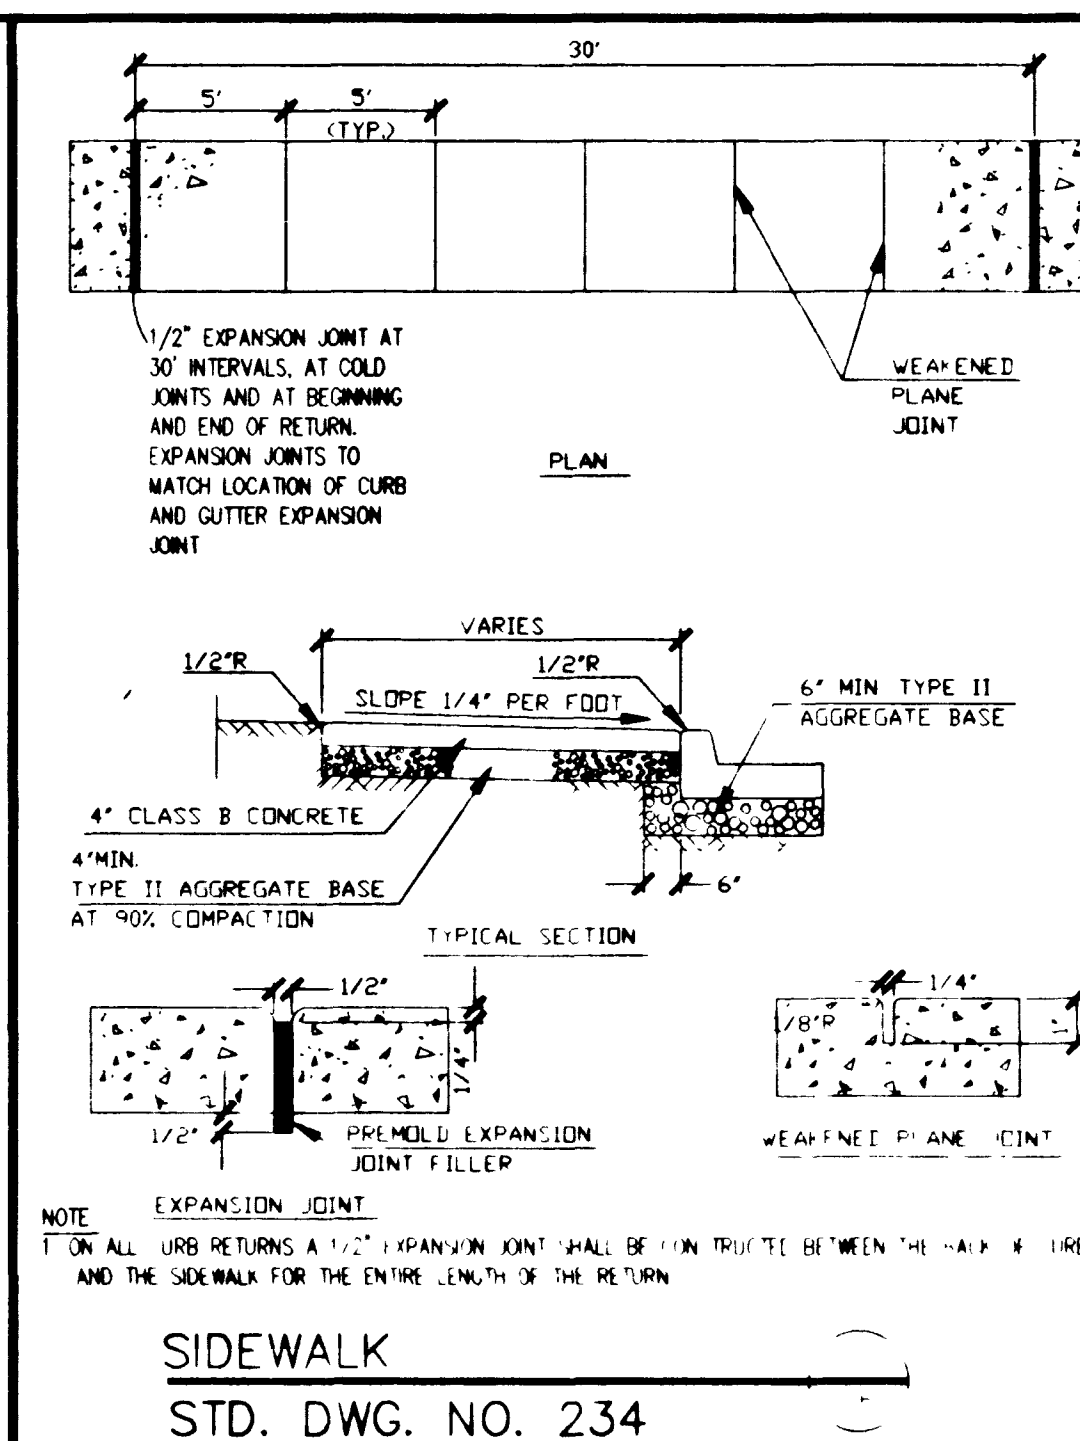
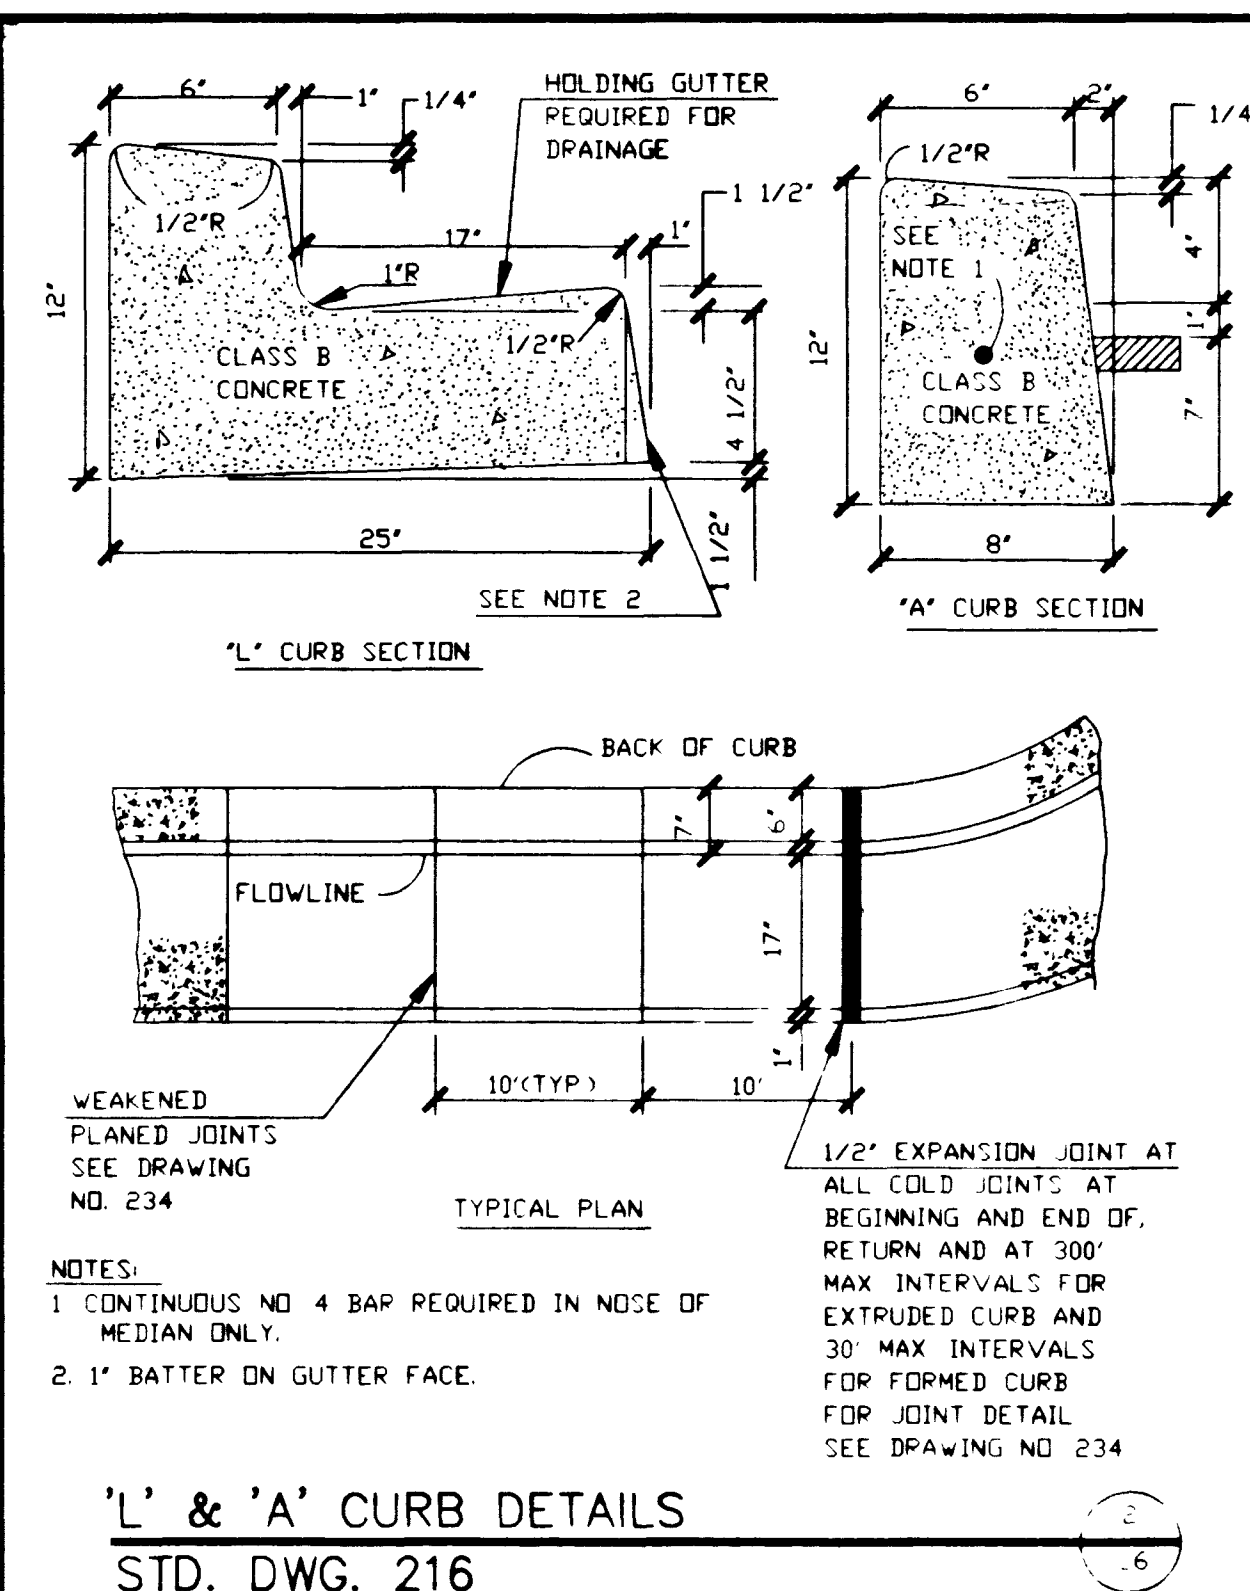


project manager
designed by
drawn by

job no.
sheet no.

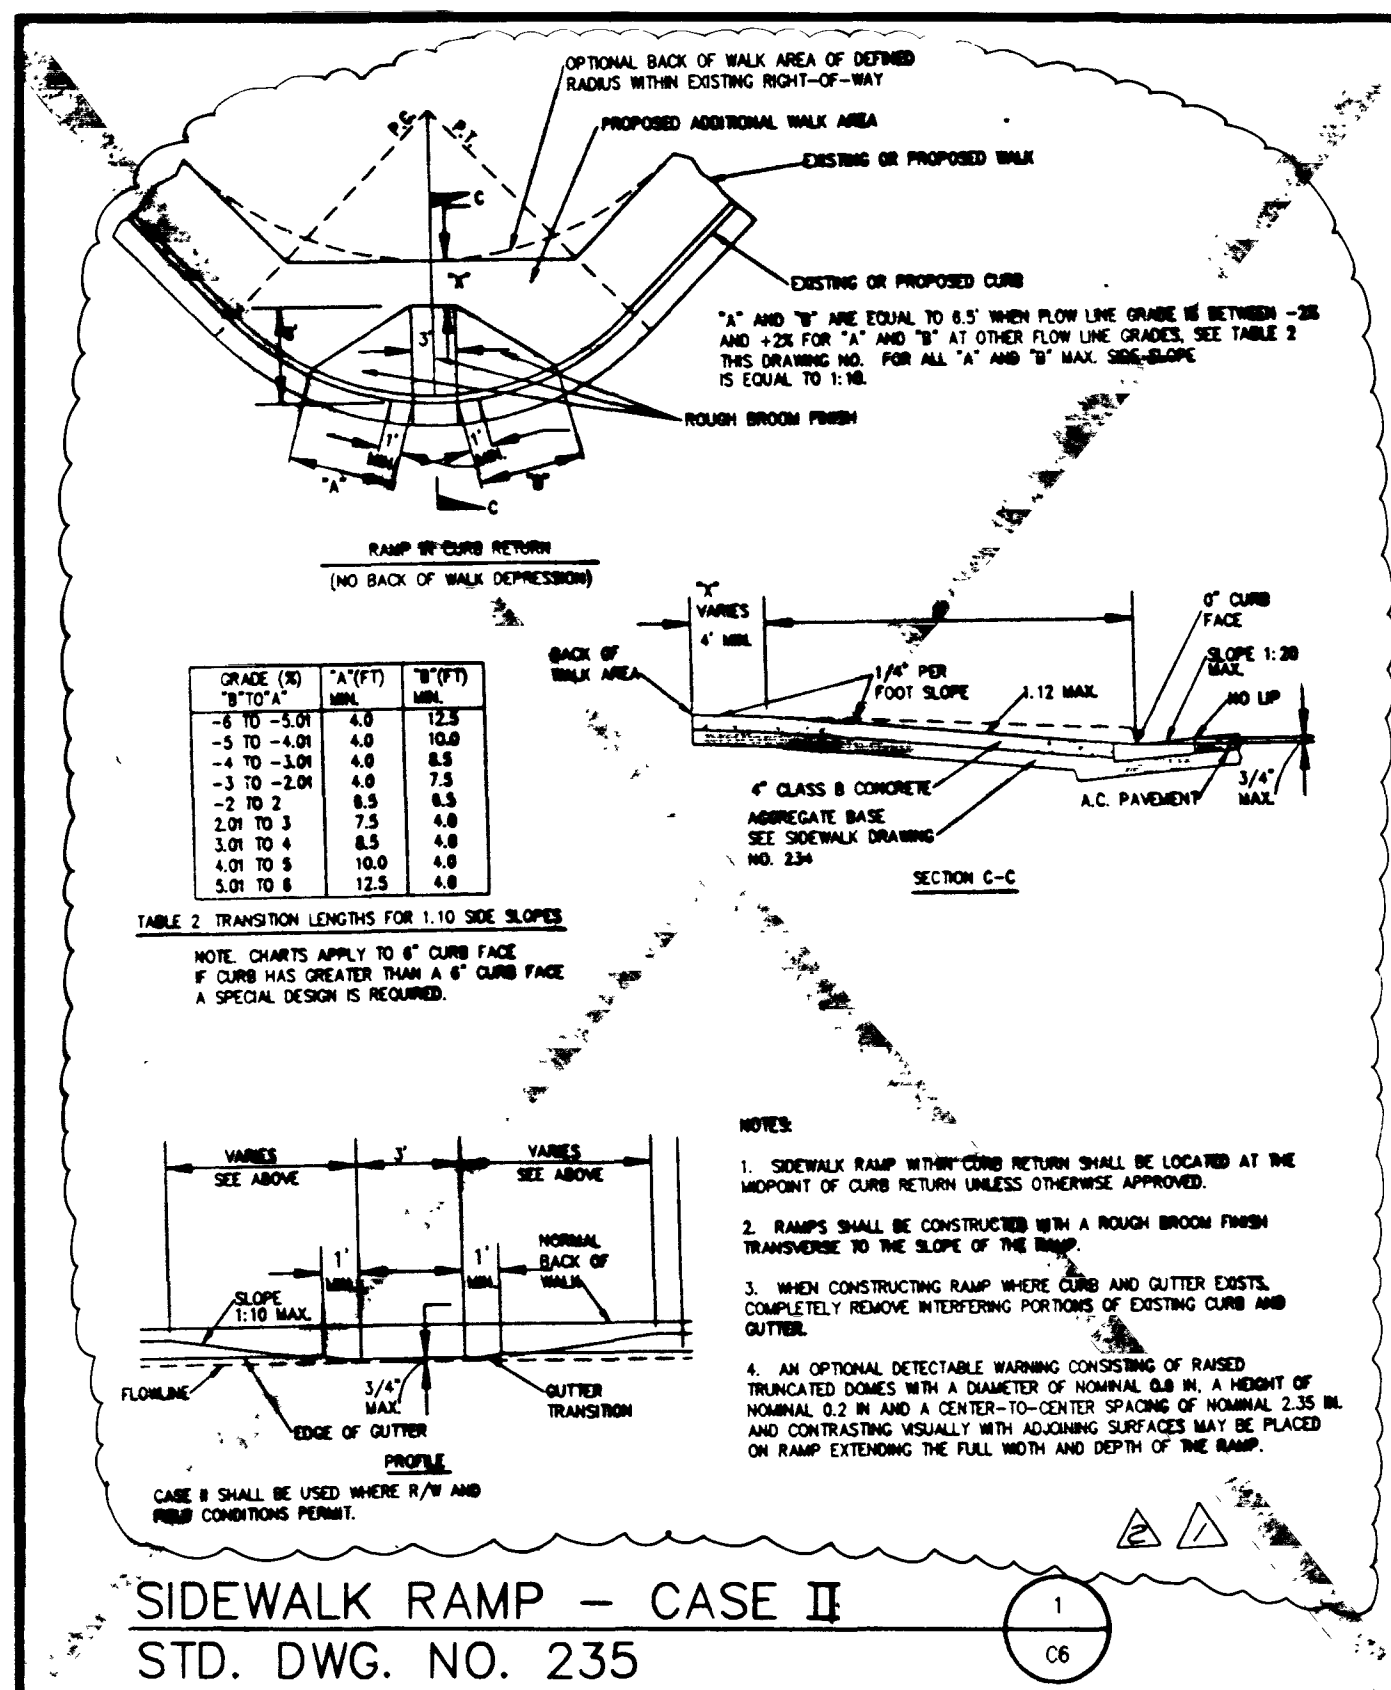

PROFESSIONAL ENGINEER
MARK L. HEDGECOCK
No. 8445
7-27-93

MARTIN & MARTIN
13502 EAST VIRGINA AVENUE
BALDWIN PARK, CA 91706
(818) 338-5587

IN-N-OUT BURGER
LAKE MEAD BLVD. AND
ROCK SPRINGS ROAD

no.	description of revisions	date	name
1	PER ROCK SPRINGS ROAD PLANS	7-28-93	M.L.H.
2	REVISED SECTION	10-23-93	M.L.H.
3	REVISED DETAIL	10-23-93	M.L.H.

date 6-24-93
job number 1250.02
design by K. MIZE
drawn by R. YOUNG
checked by J. DAVIS

sheet number
C6 OF 6

107-V2200

