
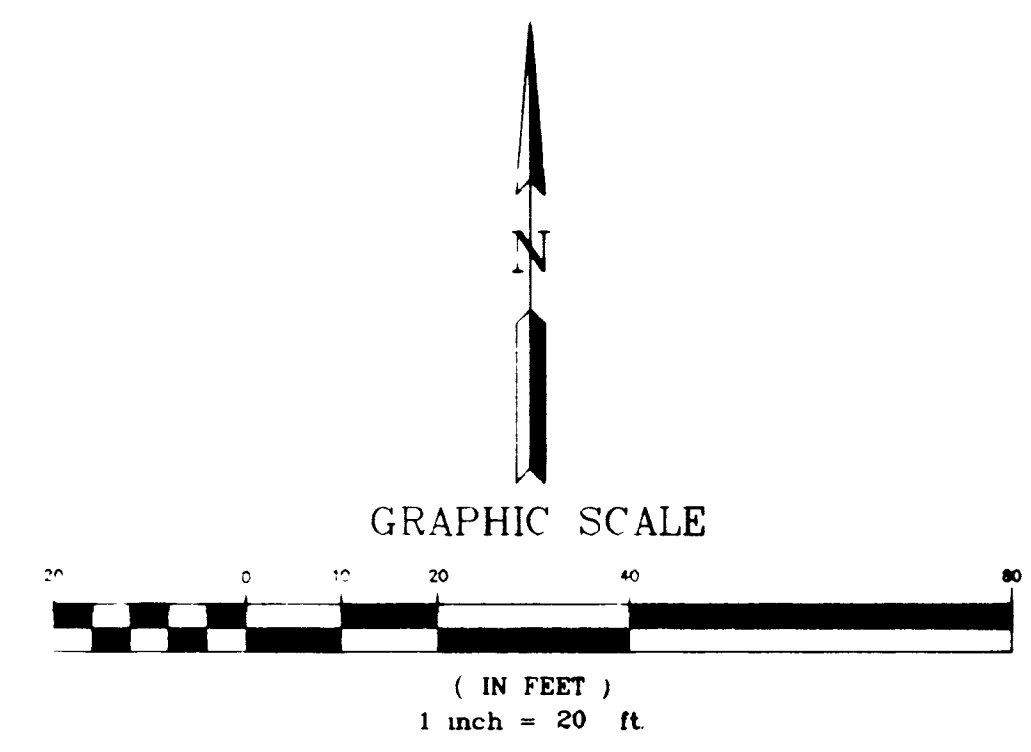
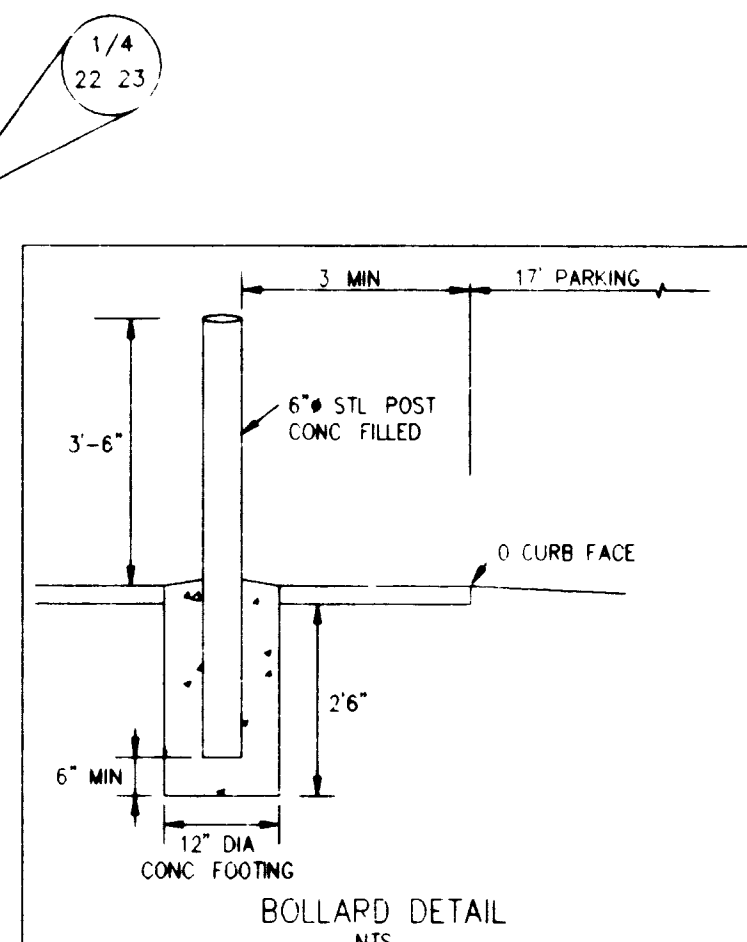


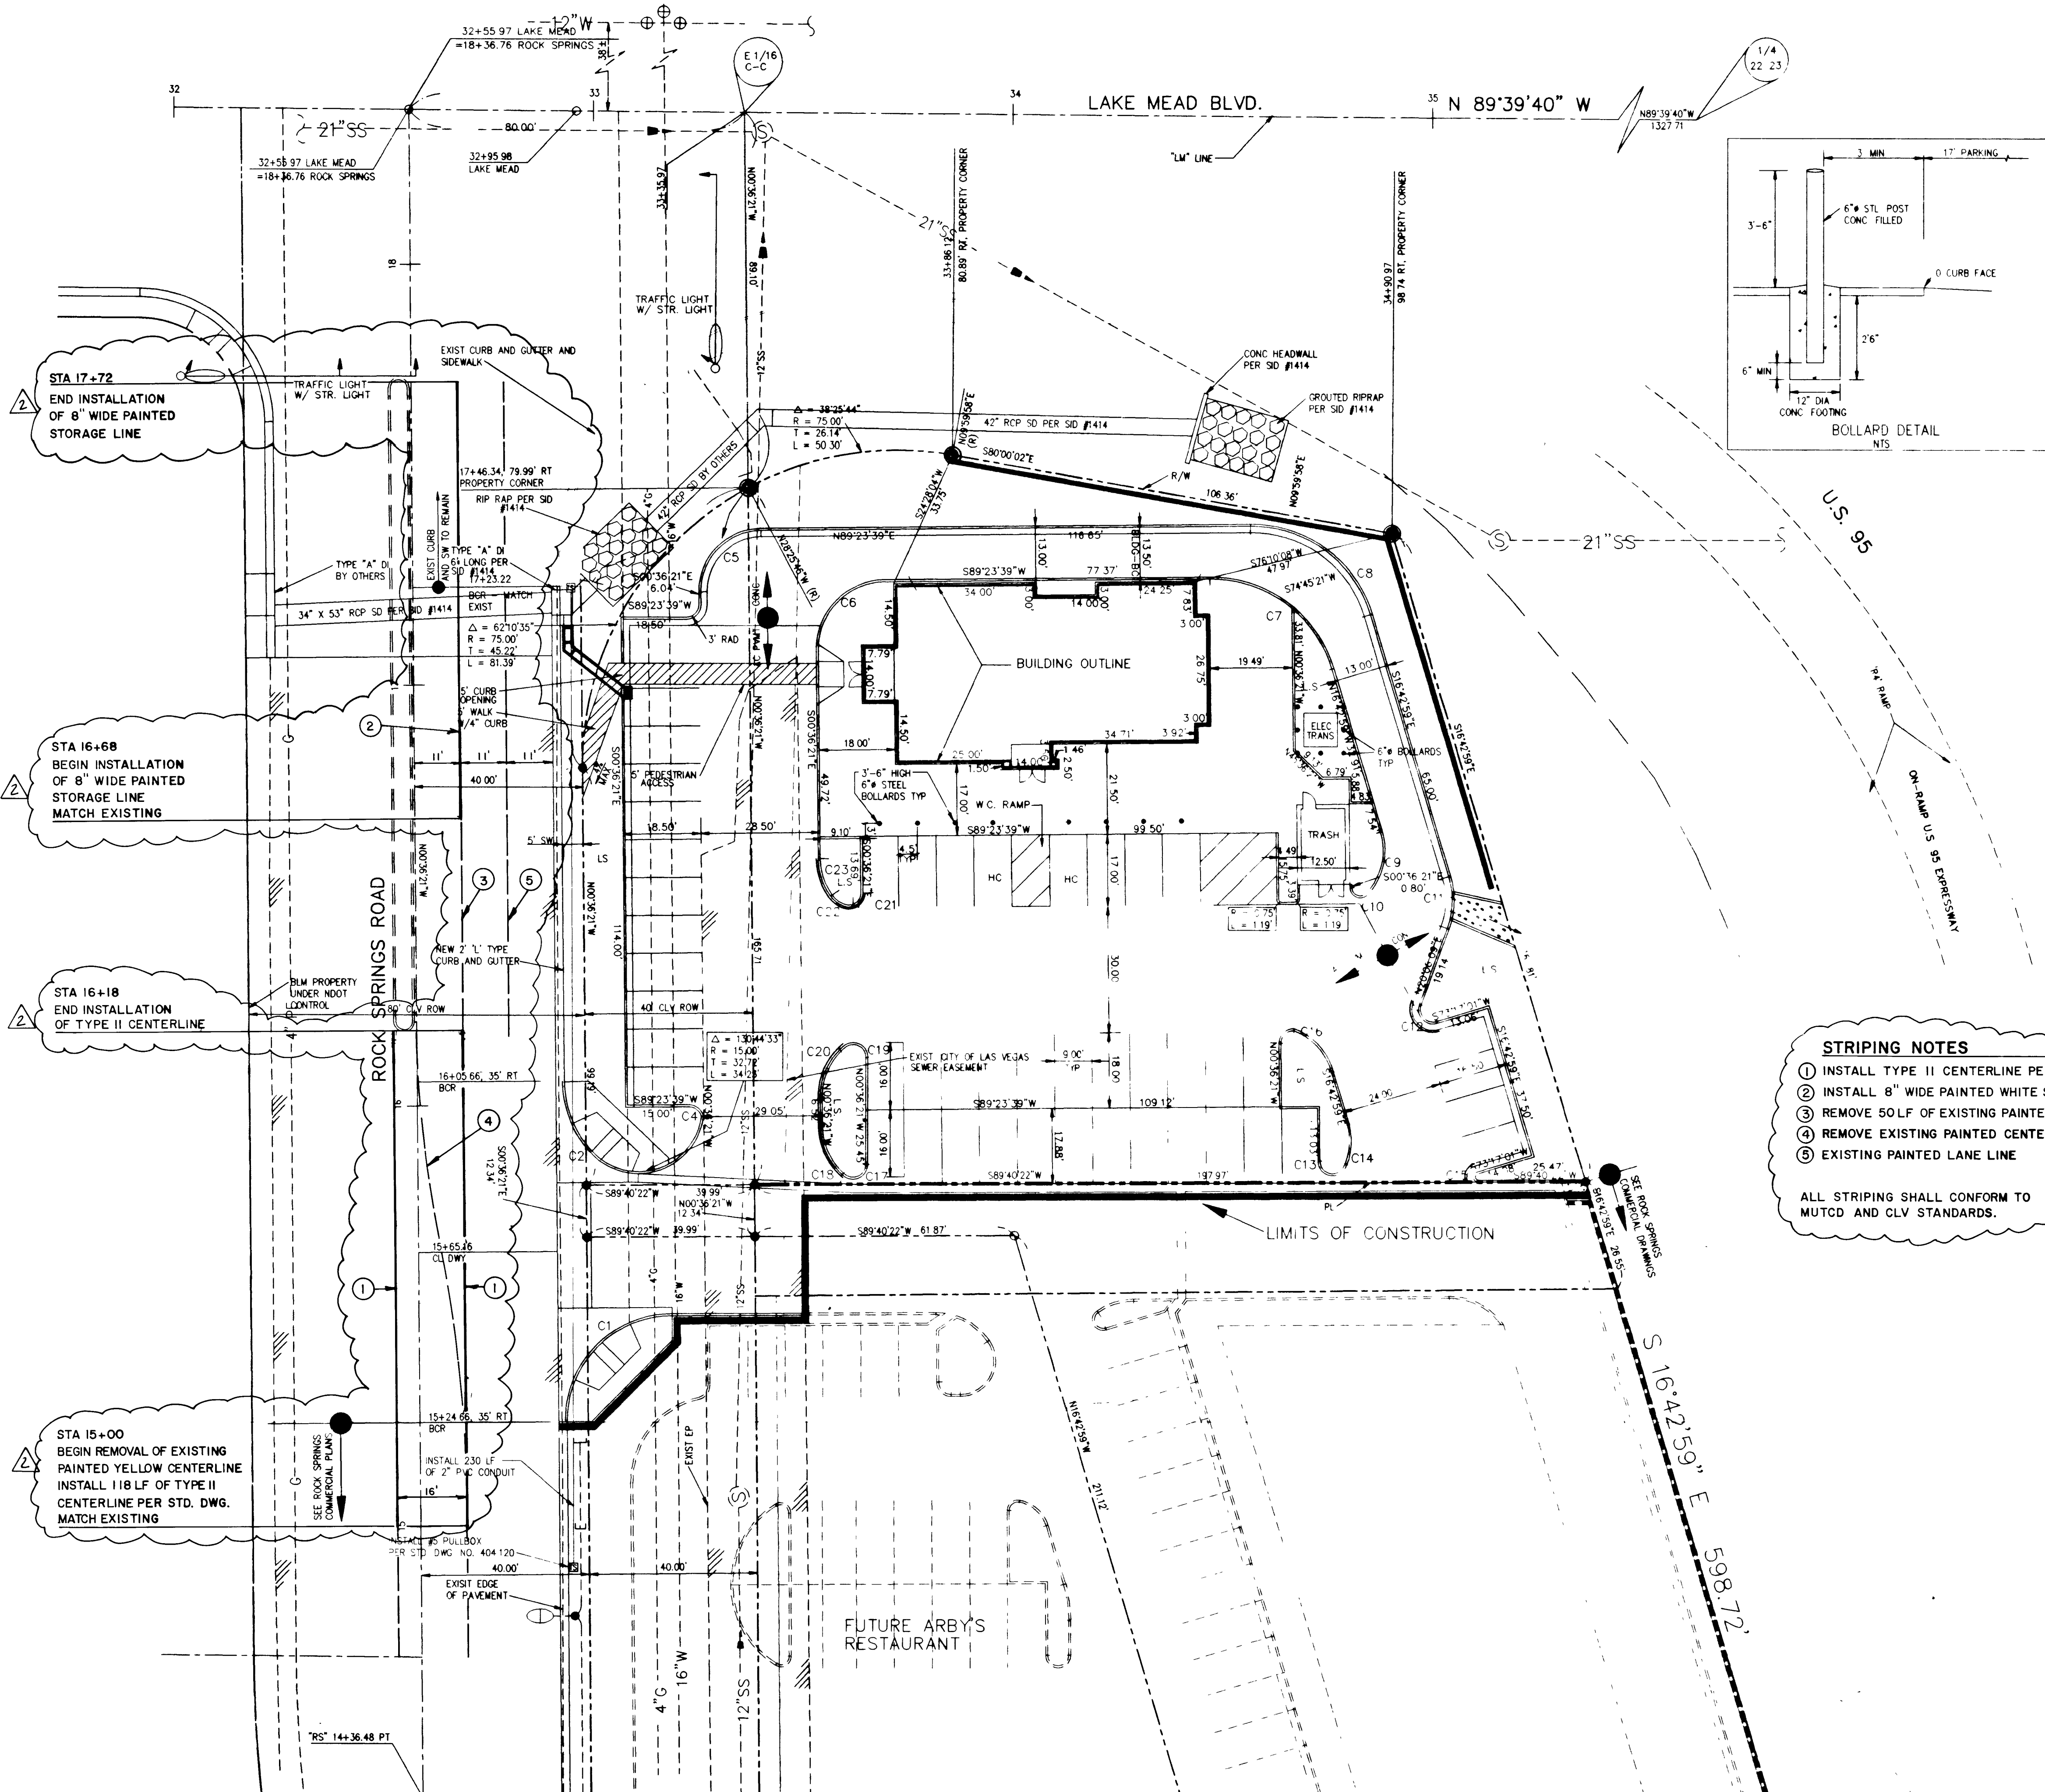

CURVE	RADIUS	LENGTH	TANGENT	DELTA
C1	25.00'	39.39'	25.12'	90°16'44"
C2	25.00'	18.13'	9.49'	88°18'57"
C3	15.00'	12.80'	8.24'	91°41'03"
C4	3.00'	4.71'	3.00'	90°00'00"
C5	15.00'	23.56'	15.00'	90°00'00"
C6	16.00'	25.13'	16.00'	90°00'00"
C7	30.00'	38.69'	22.56'	73°53'23"
C8	30.00'	38.69'	22.56'	73°53'23"
C9	15.00'	15.60'	8.69'	89°34'35"
C10	1.97'	4.69'	4.94'	136°32'03"
C11	20.00'	12.85'	6.66'	36°49'07"
C12	3.00'	6.64'	5.99'	126°49'07"
C13	3.00'	8.67'	23.57'	165°30'24"
C14	15.00'	9.55'	4.95'	36°29'44"
C15	0.75'	2.14'	5.21'	163°36'39"
C16	3.00'	4.74'	3.03'	90°36'21"
C17	3.00'	7.08'	7.27'	120°00'00"
C18	15.00'	13.47'	7.23'	60°00'00"
C19	3.00'	7.08'	7.27'	120°00'00"
C20	15.00'	14.09'	7.61'	60°00'00"
C21	3.00'	4.73'	3.01'	90°16'43"
C22	3.00'	4.35'	2.66'	83°09'02"
C23	15.00'	9.27'	4.79'	35°25'13"

BENCHMARK:
 CITY OF LAS VEGAS, BM # 1, V0023, SWMS
 BOLT & ALUM. PLATE IN TOP OF CURB NORTH-EAST
 CORNER RAINBOW BLVD. & ESCALON ST
 NEAR PC RAINBOW
 ELEVATION = 2351.30

BASIS OF BEARINGS:
 THE BASIS OF BEARINGS FOR THIS SURVEY IS THE
 SOUTH LINE OF THE SOUTHEAST QUARTER OF SECTION 22,
 TOWNSHIP 20 SOUTH, RANGE 60 EAST, M.D.M., AS SHOWN
 IN FILE 42, PAGE 33, OFFICIAL RECORDS, CLARK COUNTY,
 NEVADA. SAID LINE BEARS $N 89^{\circ}34'54'' W$

- STRIPING NOTES**
1. INSTALL TYPE II CENTERLINE PER STD. DWG.
 2. INSTALL 8" WIDE PAINTED WHITE STORAGE LANE LINE.
 3. REMOVE 50 LF OF EXISTING PAINTED STORAGE LANE LINE.
 4. REMOVE EXISTING PAINTED CENTERLINE TAPER.
 5. EXISTING PAINTED LANE LINE
- ALL STRIPING SHALL CONFORM TO MUTCD AND CLV STANDARDS.

NOTES:
 1. ALL DIMENSIONS ARE TO THE BACK OF CURB UNLESS OTHERWISE NOTED

MARTIN & MARTIN
 CIVIL ENGINEERS
 1909 S. JONES BLVD
 SUITE B
 LAS VEGAS, NEVADA 89102
 PHONE (702) 448-8000

PREPARED FOR
IN-N-OUT BURGER, INC.
 4199 CAMPOS DRIVE
 IRVINE, CA 92715
 (714) 509-0200

IN-N-OUT BURGER
 9900 LAKE MEAD BLVD. AND
 ROCK SPRINGS ROAD

no	description of revisions	date	name
1	REVISE SITE LAYOUT, WATER AND FIRE SERVICES	7-8-94	MJM
2	REVISE STRIPING	3-3-95	TTE

date 7-9-93
 job number 1250
 design by M. HEDGE
 drawn by R. YOUNG
 checked by J. DAVIS

sheet number
C2 OF 6











