

PLAN NOTES

P	DESCRIPTION
P1.	DASHED LINE INDICATES STRUCTURE ABOVE
P2.	TELEPHONE
P3.	NEW CONCRETE STAIR AND WALL TO MATCH EXISTING
P4.	ALIGN WALL BETWEEN WINDOWS. AUDITORIUM WALLS SHALL BE WITH 2" THICK FABRIC ACOUSTICAL WALL PANELS SEE INTERIOR ELEVATIONS
P5.	NEW ACCESSIBLE RAMP AND RAILING
P6.	FIRE EXTINGUISHER CABINET. SEE 14/A9.01.
P7.	NEW STAIR AND HANDRAIL
P8.	MECHANICAL/MOTORIZED LIFT TO PLATFORM
P9.	RELOCATED ELECTRICAL PANEL SYSTEM. SEE ELECTRICAL DRAWINGS.
P10.	NEW CASEWORK
P11.	NEW TWO-BAY SINK. SEE PLUMBING DWGS.
P12.	NEW REFRIGERATOR - N.J.C.
P13.	NEW CMU WALL ENCLOSURE SEE 5/AS2.01.
P14.	STEEL BOLLARD. SEE DETAIL SHEET AS2.01
P15.	CONCRETE PIER. SEE STRUCTURAL DWGS.
P16.	GATE ENCLOSURE-SEE DETAIL 6/AS2.01
P17.	LINE OF EXISTING SKYLIGHT TO BE RESTORED.
P18.	REMOVEABLE RAILING FOR TRUCK DELIVERY. SEE DETAIL 1/A1.33.
P19.	PROVIDE HORIZONTAL MANUAL WINDOW BLIND AT THIS WINDOW.
P20.	EXISTING CONCRETE COLUMN TO REMAIN.
P21.	DRINKING FOUNTAIN. SEE PLUMBING DWGS.
P22.	EXISTING FOUNTAIN TO BE RENOVATED.
P23.	EXISTING COVERED BREEZEWAY
P24.	EXISTING CONSTRUCTION TO BE REMOVED AND/OR RESTORED WITH DOORS AND/OR WINDOWS TO MATCH HISTORIC ERA- REFER TO WINDOW AND DOOR SCHEDULE
P25.	FURNITURE SHOWN ON PLAN SHALL BE TENANT FURNISHED AND TENANT INSTALLED NEW SINK. SEE PLUMBING DWGS.
P26.	EXISTING BASEMENT STAIR TO REMAIN.
P27.	INFILL STAIRWELL & CAP WITH CONC. SLAB. EXISTING CONCRETE WALL TO BE REMOVED SAND AND FINISH EXISTING CONCRETE WALL FOR PAINT
P28.	NEW BABY CHANGING STATION.
P29.	ALIGN FACE OF NEW PARTITION WITH FACE OF EXISTING CONCRETE
P30.	NEW COUNTER TRASH DISPOSAL.
P31.	ACCESS LADDER AND HATCH SEE 5/A7.31
P32.	NEW CONCRETE. SEE 11/AS2.01.
P33.	1" RECESS INFILL PER 4/A9.05
P34.	LINE INDICATE DIRECTION OF WOOD PLANK FLOORING. SEE STRUCTURAL DWGS.
P35.	RECONSTRUCT SEGMENT OF PARTIAL HEIGHT WALL TO MATCH ADJACENT EXISTING WALL
P36.	REMOVE DOOR, INFILL OPENING WITH CONCRETE. FLUSH TO EXTERIOR WALL. MATCH EXISTING FINISH AND TEXTURE.
P37.	PATTERNED GLASS WINDOW PER SPEC.
P38.	EXISTING METAL GATE
P39.	ROOF DRAIN SEE DETAIL 3/A7.31
P40.	INSTALL NEW CABINET DOORS ON EXISTING CABINET. SEE DETAIL 5/A8.02
P41.	STAGELAM HIGH TRAFFIC FLOORING
P42.	EXISTING CONCRETE PAD TO REMAIN
P43.	EXISTING DIVIDED LIGHT TRANSOM/DOOR ASSEMBLY
P44.	CONCRETE SUMP PIT W/ STEEL GRATE
P45.	FURR OVER WINDOW.


GENERAL NOTES

- DIMENSIONS ARE TO FACE OF STUD. FACE OF MASONRY OR FACE OF CONCRETE UNLESS NOTED OTHERWISE.
- INFORM ARCHITECT OF ANY DISCREPANCIES BEFORE BEGINNING WORK
- PRIOR TO CONSTRUCTION, CONTRACTOR SHALL FIELD VERIFY ALL EXISTING CONDITIONS, IN AREAS REQUIRING REPAIR AND/OR REMOVAL, CONTRACTOR SHALL PATCH AND PREP SURFACES FOR NEW FINISH.
- PATCH ALL HOLES IN EXTERIOR CONCRETE WALLS INCLUDING LADDER HOLES, CONDUIT, AND PIPE HOLES, ETC. CAUSED BY DEMO. REPAIR AND PAINT ALL GRAML SPACE VENT GRILLES - TYPICAL.



WALL TYPES

- NOTES**
- WALL TYPES WITH AN "S" SUBSCRIPT INDICATE FIBERGLASS ACOUSTICAL INSULATION FULL HEIGHT AND DEPTH OF PARTITION NOTED AND REQUIRES THE GYP. BOARD TO EXTEND FROM TOP OF FLOOR SLAB TO UNDERSIDE OF STRUCTURE ABOVE ON ONE SIDE OF PARTITION THAT OTHERWISE WOULD NOT EXTEND TO THE STRUCTURE ABOVE.
 - PROVIDE HEAVY GAGE METAL STUDS IN LIEU OF LIGHT GAGE METAL STUDS AT WALLS WITH ANY WALL HUNG TYPE ATTACHMENTS AND/ OR SUPPORTING ATTACHMENTS SUCH AS WALL SINKS, GRAB BARS, WALL CABINETS AND OTHER MISC. EQUIPMENT.
 - ALL WALLS IN WET AREAS SHALL HAVE 5/8" TYPE "X" WATER-RESISTANT GYPSUM BOARD IN LIEU OF 5/8" TYPE "X" (REGULAR) GYPSUM BOARD.
 - ALL INTERIOR PARTITIONS ARE NON-BEARING.
 - WALLS WITH SUBSCRIPT "I" INDICATES WALLS WITH THERMAL INSULATION FOR THE FULL HEIGHT OF THE WALL.

WALL LEGEND

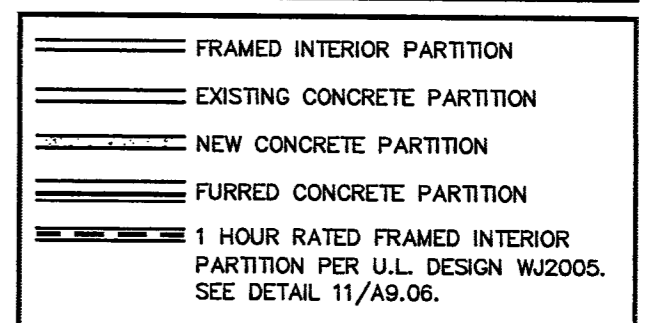

BUILDING MAP

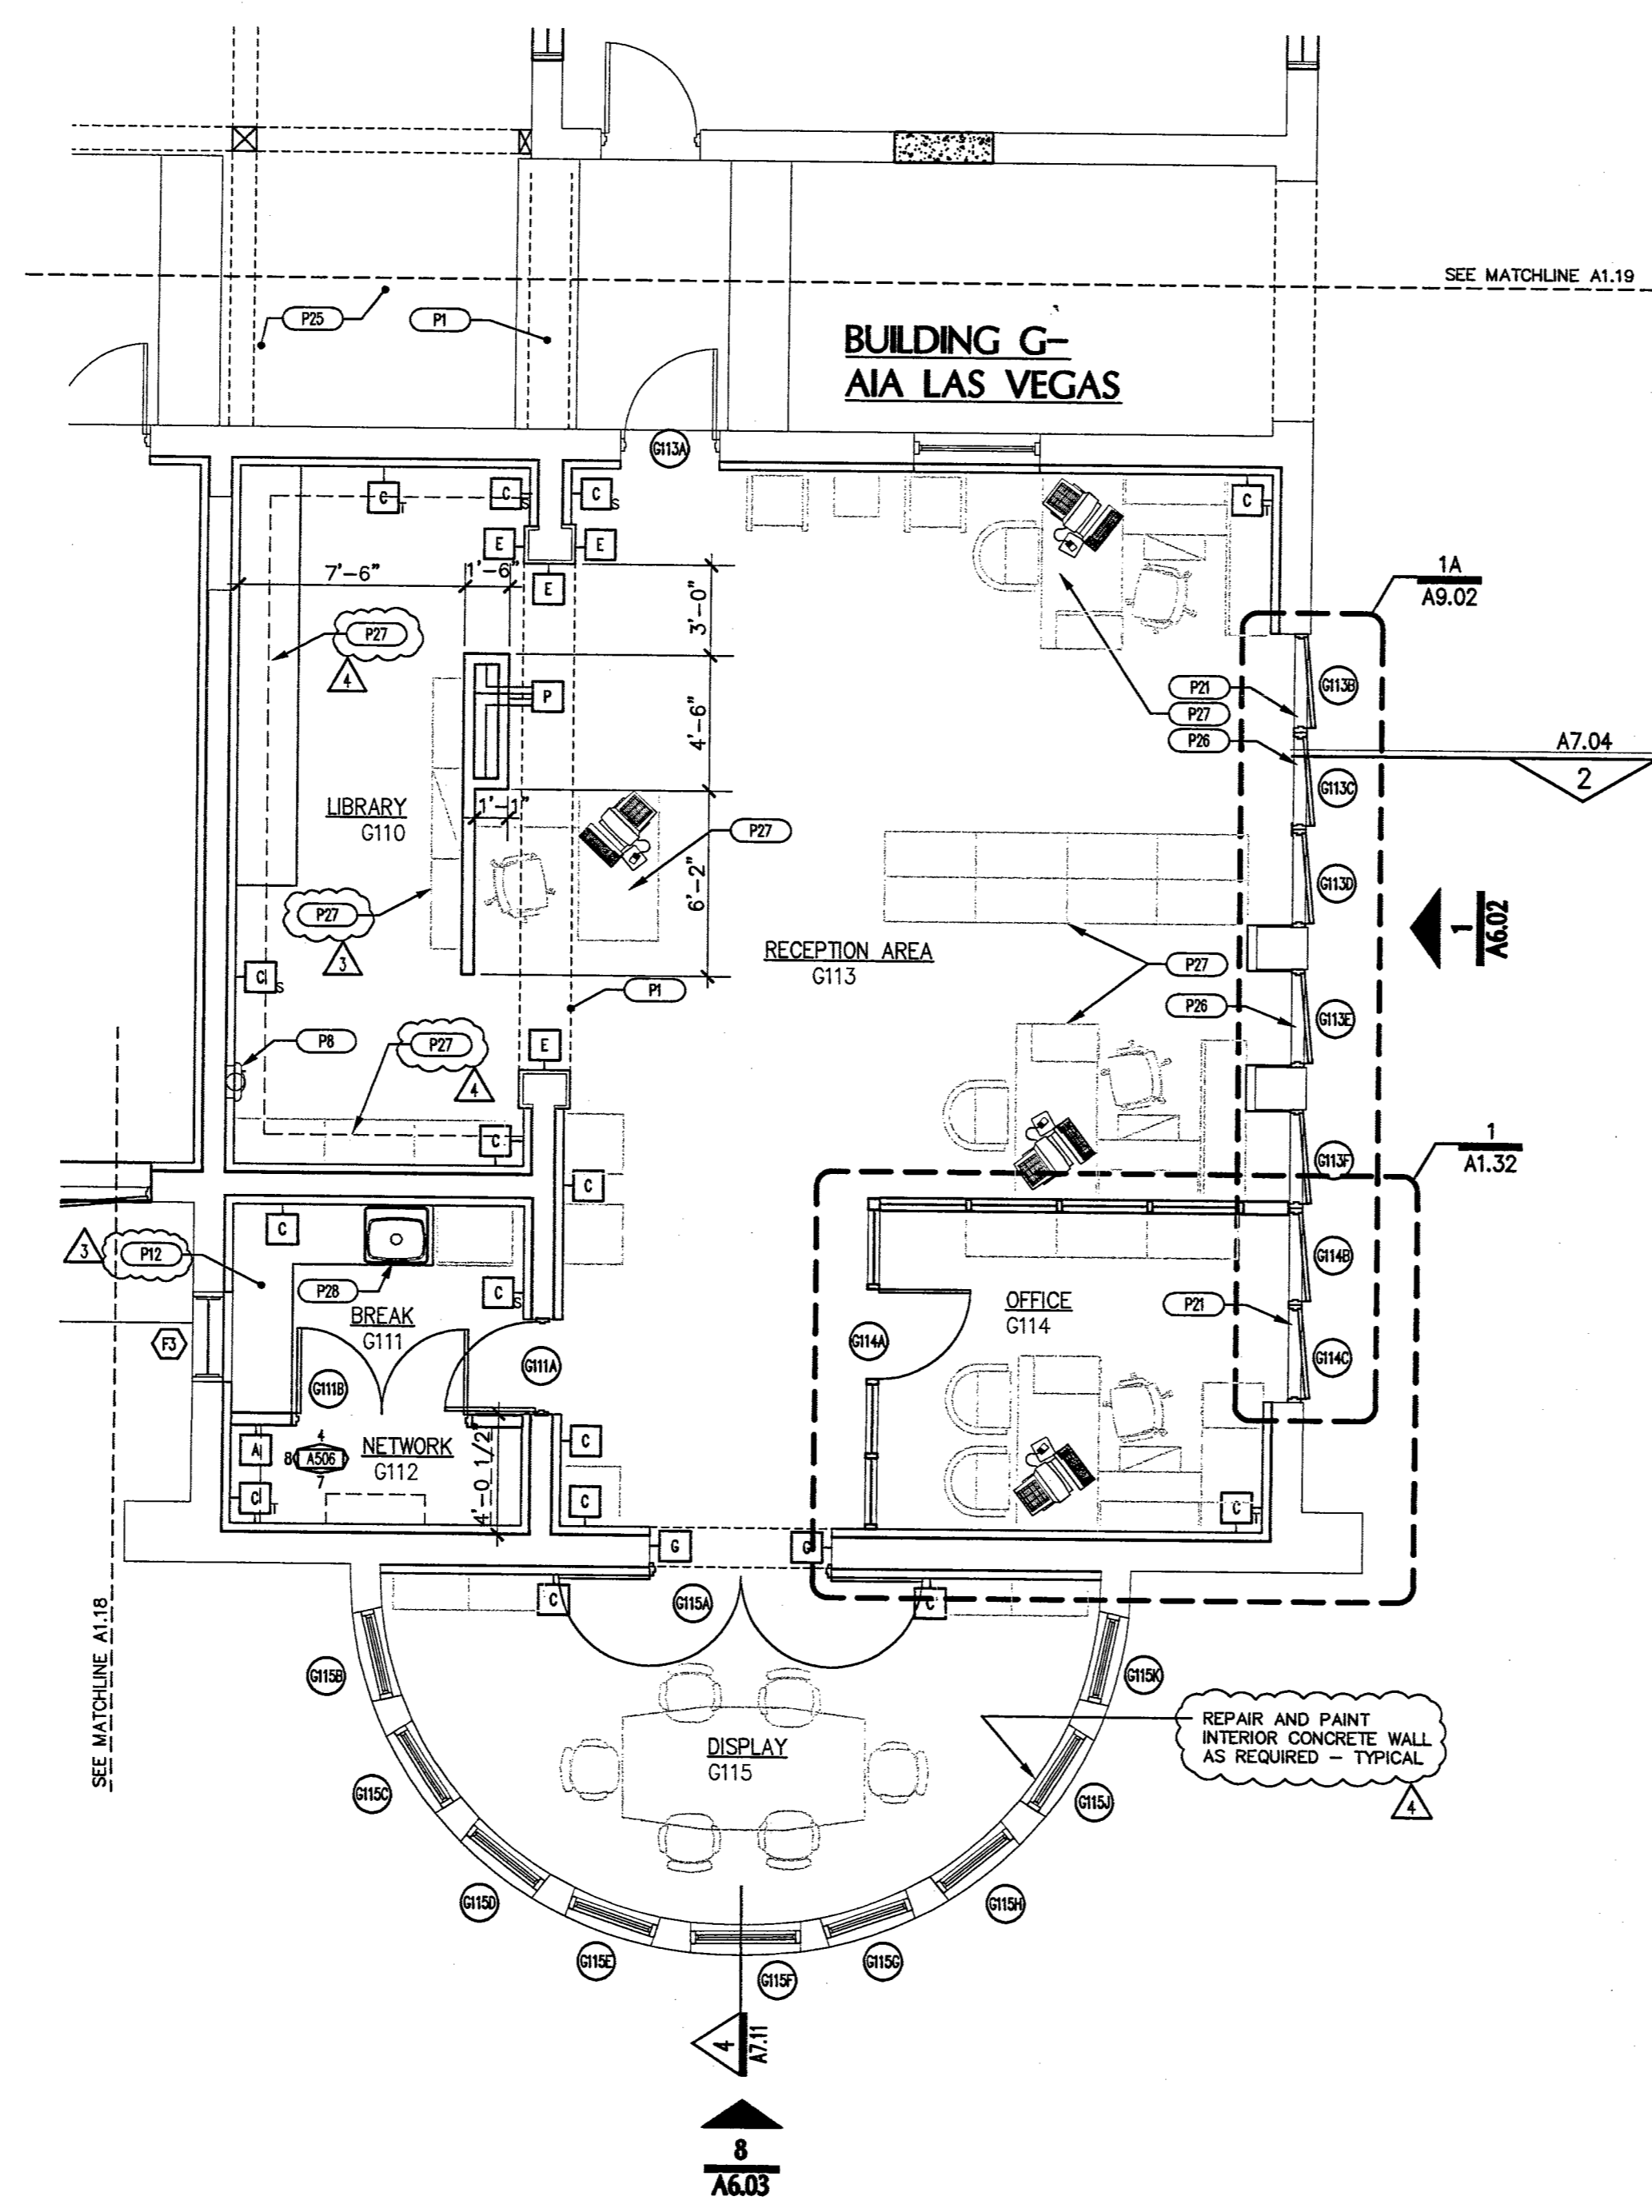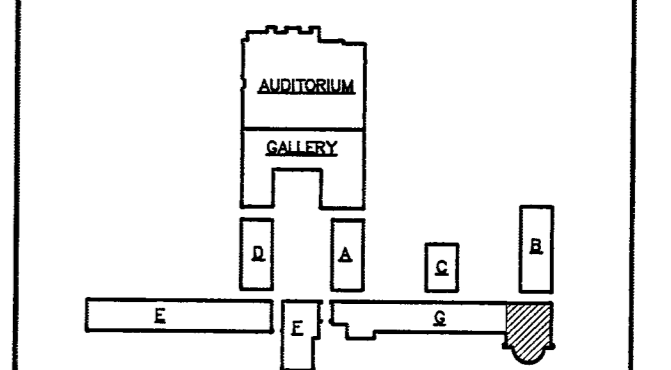

RECEIVED
FEB 08 2007
CITY OF LAS VEGAS
BUILDING DEPT.

PLANS APPROVED
ARCHITECTURAL
Stamping & Seal
Chief Architect, Nevada
FEB 09 2007
Not a "Seal" as Nevada City Ordinance

CLV COMMENTS
OWNER COMMENTS

CONSULTANT
KGA ARCHITECTURE
4485 SOUTH POLARIS AVENUE
LAS VEGAS, NEVADA 89103
WWW.KGARCHITECTURE.COM
TELEPHONE 702.397.4000
FACSIMILE 702.397.2943
HERITAGE ARCHITECTURE & PLANNING
PHONE 408.229.7188

OWNER
CITY OF LAS VEGAS
REDEVELOPMENT AGENCY

STRUCTURAL
BARKER DROTTER ASSOCIATES
STRUCTURAL ENGINEERS
PHONE 702.29.8000

Mechanical - Plumbing - Electrical - Life Safety - Acoustical - General Lighting
JSA CONSULTING ENGINEERS
PHONE 702.462.8811

Stage Lighting & Design
CDM LIGHTING DESIGN GROUP
PHONE 408.229.2222

LANDSCAPE
JWZUNINO & ASSOCIATES
PHONE 702.253.2180

Cost Estimating
REIDER HUNT
LEVETT & BAILEY
PHONE 702.277.8888

ADA Accessibility
ENDELMAN AND ASSOCIATES
PHONE 202.332.6462

CITY OF LAS VEGAS
REDEVELOPMENT AGENCY
FIFTH STREET SCHOOL
REHABILITATION
BUILDING DEPARTMENT SUBMITTAL

REVISION 02/07

OWNER: CITY OF LAS VEGAS
DEPARTMENT OF PUBLIC WORKS
ARCHITECTURAL SERVICES

400 EAST STEWART AVENUE
LAS VEGAS, NEVADA 89101
PHONE: (702) 384-8638
FAX: (702) 384-4846
TDD: (702) 384-6108

ENLARGED AIA PLAN
DATE: 12/12/2006
SCALE: 1/4" = 1'-0"
DWG NO: 513-65E
SHEET NO: A1.20