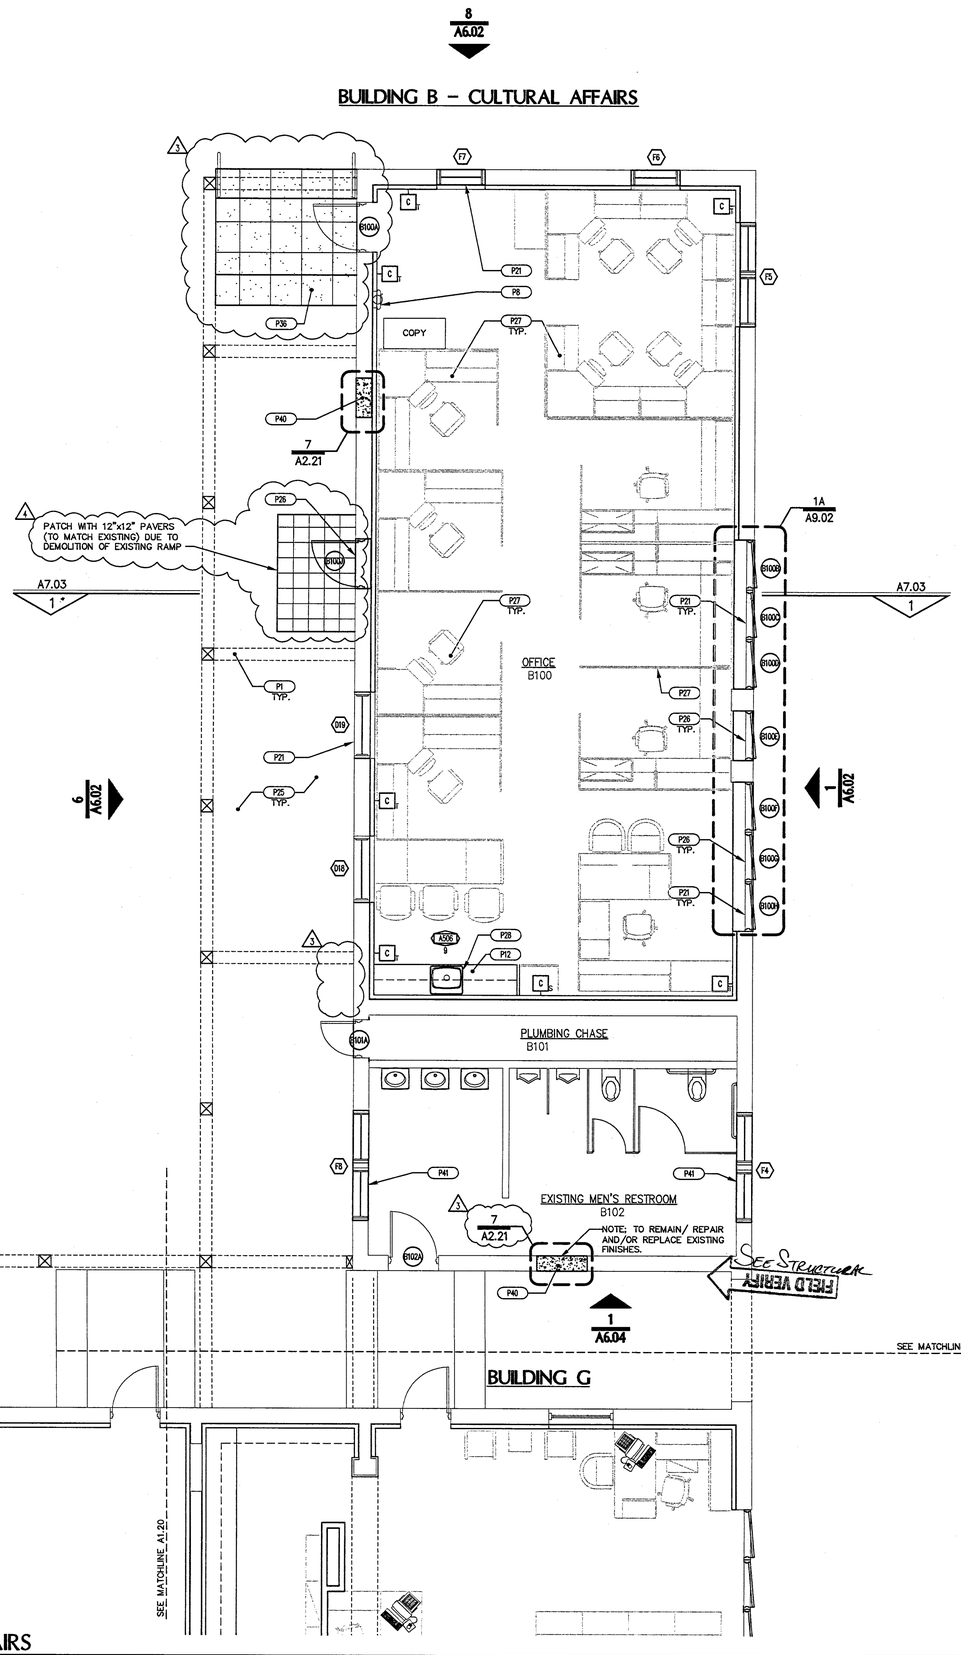

ENLARGED FLOOR PLAN – CULTURAL AFFAIRS

SCALE: 1/4" = 1'-0"

PLAN NOTES

P	DESCRIPTION
P1.	DASHED LINE INDICATES STRUCTURE ABOVE
P2.	TELEPHONE
P3.	NEW CONCRETE STAIR AND WALL TO MATCH EXISTING.
P4.	ALIGN WALL BETWEEN WINDOWS.
P5.	AUDITORIUM WALLS SHALL BE WITH 2" THICK FABRIC ACOUSTICAL WALL PANELS SEE INTERIOR ELEVATIONS
P6.	CLERESTORY AUDITORIUM AND PLATFORM WINDOW SHALL HAVE MOTORIZED BLACKOUT SHADES
P7.	NEW ACCESSIBLE RAMP AND RAILING
P8.	FIRE EXTINGUISHER CABINET. SEE 14/A9.01.
P9.	NEW STAIR AND HANDRAIL
P10.	MECHANICAL/MOTORIZED LIFT TO PLATFORM
P11.	RELOCATED ELECTRICAL PANEL SYSTEM. SEE ELECTRICAL DRAWINGS.
P12.	NEW CASEWORK.
P13.	NEW TWO-BAY SINK. SEE PLUMBING DWGS.
P14.	NEW REFRIGERATOR – N.I.C.
P15.	NEW CMU WALL ENCLOSURE. SEE 5/AS2.01.
P16.	STEEL BOLLARD. SEE DETAIL SHEET AS2.01
P17.	CONCRETE PIER. SEE STRUCTURAL DWGS.
P18.	GATE ENCLOSURE–SEE DETAIL 6/AS2.01
P19.	LINE OF EXISTING SKYLIGHT TO BE RESTORED.
P20.	REMOVEABLE RAILING FOR TRUCK DELIVERY. SEE DETAIL 1/A1.33.
P21.	PROVIDE HORIZONTAL MANUAL WINDOW BLIND AT THIS WINDOW.
P22.	EXISTING CONCRETE COLUMN TO REMAIN.
P23.	DRINKING FOUNTAIN. SEE PLUMBING DWGS.
P24.	EXISTING FOUNTAIN TO BE RENOVATED.
P25.	EXISTING COVERED BREEZEWAY
P26.	EXISTING CONSTRUCTION TO BE REMOVED AND/OR RESTORED WITH DOORS AND/OR WINDOWS TO MATCH HISTORIC ERA– REFER TO WINDOW AND DOOR SCHEDULE
P27.	FURNITURE SHOWN ON PLAN SHALL BE TENANT FURNISHED AND TENANT INSTALLED
P28.	NEW SINK. SEE PLUMBING DWGS.
P29.	EXISTING BASEMENT STAIR TO REMAIN. INFILL STAIRWELL & CAP WITH CONC. SLAB.
P30.	EXISTING CONCRETE WALL TO BE REMOVED
P31.	SAND AND FINISH EXISTING CONCRETE WALL FOR PAINT
P32.	NEW BABY CHANGING STATION.
P33.	ALIGN FACE OF NEW PARTITION WITH FACE OF EXISTING CONCRETE
P34.	NEW COUNTER TRASH DISPOSAL.
P35.	ACCESS LADDER AND HATCH SEE 5/A7.31
P36.	NEW CONCRETE. SEE 11/AS2.01.
P37.	1" RECESS INFILL PER 4/A9.05
P38.	LINES INDICATE DIRECTION OF WOOD PLANK FLOORING. SEE STRUCTURAL DWGS.
P39.	RECONSTRUCT SEGMENT OF PARTIAL HEIGHT WALL TO MATCH ADJACENT EXISTING WALL
P40.	REMOVE DOOR, INFILL OPENING WITH CONCRETE, FLUSH TO EXTERIOR WALL. MATCH EXISTING FINISH AND TEXTURE.
P41.	PATTERNED GLASS WINDOW PER SPEC.
P42.	EXISTING METAL GATE
P43.	ROOF DRAIN SEE DETAIL 3/A7.31
P44.	INSTALL NEW CABINET DOORS ON EXISTING CABINET. SEE DETAIL 5/A8.02
P45.	STAGELAM HIGH TRAFFIC FLOORING
P46.	EXISTING CONCRETE PAD TO REMAIN
P47.	EXISTING DIVIDED LIGHT TRANSOM/DOOR ASSEMBLY
P48.	CONCRETE SUMP PIT W/ STEEL GRATE
P49.	FURR OVER WINDOW.

GENERAL NOTES

1. DIMENSIONS ARE TO FACE OF STUD, FACE OF MASONRY OR FACE OF CONCRETE UNLESS NOTED OTHERWISE.
2. INFORM ARCHITECT OF ANY DISCREPANCIES BEFORE BEGINNING WORK.
3. PRIOR TO CONSTRUCTION, CONTRACTOR SHALL FIELD VERIFY ALL EXISTING CONDITIONS. IN AREAS REQUIRING REPAIR AND/OR REMOVAL, CONTRACTOR SHALL PATCH AND PREP SURFACES FOR NEW FINISH.
4. PATCH ALL HOLES IN EXTERIOR CONCRETE WALLS INCLUDING LADDER HOLES, CONDUIT, AND PIPE HOLES, ETC. CAUSED BY DEMO.
5. REPAIR AND PAINT ALL CRAWL SPACE VENT GRILLES – TYPICAL.

WALL TYPES

A/S — WALL TYPE SYMBOL – SEE SHEET A2.32 & A2.33 FOR WALL TYPES

NOTES

1. WALL TYPES WITH AN 'S' SUBSCRIPT INDICATE FIBERGLASS ACOUSTICAL INSULATION FULL HEIGHT AND DEPTH OF PARTITION NOTED AND REQUIRES THE GYP. BOARD TO EXTEND FROM TOP OF FLOOR SLAB TO UNDERSIDE OF STRUCTURE ABOVE ON ONE SIDE OF PARTITION THAT OTHERWSE WOULD NOT EXTEND TO THE STRUCTURE ABOVE.
2. PROVIDE HEAVY GAGE METAL STUDS IN LIEU OF LIGHT GAGE METAL STUDS AT WALLS WITH ANY WALL HUNG TYPE ATTACHMENTS AND/ OR SUPPORTING ATTACHMENTS SUCH AS WALL SINKS, GRAB BARS, WALL CABINETS AND OTHER MISC. EQUIPMENT.
3. ALL WALLS IN WET AREAS SHALL HAVE 5/8" TYPE 'X' WATER-RESISTANT GYPSUM BOARD IN LIEU OF 5/8" TYPE 'X' (REGULAR) GYPSUM BOARD.
4. ALL INTERIOR PARTITIONS ARE NON-BEARING.
5. WALLS WITH SUBSCRIPT 'T' INDICATES WALLS WITH THERMAL INSULATION FOR THE FULL HEIGHT OF THE WALL.

WALL LEGEND

- FRAMED INTERIOR PARTITION
- EXISTING CONCRETE PARTITION
- NEW CONCRETE PARTITION
- FURRED CONCRETE PARTITION
- 1 HOUR RATED FRAMED INTERIOR PARTITION PER U.L. DESIGN WJ2005. SEE DETAIL 11/A9.06.

BUILD AS PER RED-LINES AND/OR ATTACHED CLV DESIGN **OR** PROVIDE COMPLETE REVISIONS

RECEIVED
FEB 08 2007
CITY OF LAS VEGAS
BUILDING DEPT.

PLANS APPROVED
ARCHITECTURAL
Building & Safety Dept.
City of Las Vegas, Nevada
JCF FEB 09 2007
Does Not Include Electrical, Plumbing, Mechanical, Structural or Off-Site Improvements. Make No Change Without Approval. Plan is Not a Permit to Violate Any Ordinance

BUILDING MAP

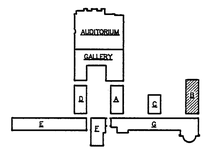

1

723–FLR.dwg

REVISIONS
1 CLV COMMENTS 1-4-2007
2 OWNER COMMENTS 2-5-2007

CONSULTANT
KGA ARCHITECTURE
6496 SOUTH POLARIS AVENUE
LAS VEGAS, NEVADA 89183
WWW.KGAARCHITECTURE.COM
TELEPHONE 702 . 367 . 9900
FACSIMILE 702 . 367 . 2043
HISTORICAL –
HERITAGE ARCHITECTURE & PLANNING
PHONE 619-239-7588
CIVIL –
VTN NEVADA
PHONE 702-873-7500
STRUCTURAL –
BARKER DROTTAR ASSOCIATES STRUCTURAL ENGINEERS
PHONE 702-38-9000
MECHANICAL – PLUMBING – ELECTRICAL – LIFE SAFETY – ACOUSTICAL – GENERAL LIGHTING
JBA CONSULTING ENGINEERS
PHONE 702-362-5200
STAGE LIGHTING & DIDEN –
CDAN LIGHTING DESIGN GROUP
PHONE 858-259-2323
LANDSCAPE –
JMCUBBINS & ASSOCIATES
PHONE 702-221-5290
COST ESTIMATING –
RIDER HUNT LEVETT & BAILEY
702-227-6858
ADA ACCESSIBILITY
ENDELMAN AND ASSOCIATES
PHONE 310-264-6462

CITY OF LAS VEGAS NEVADA

FIFTH STREET SCHOOL REHABILITATION BUILDING DEPARTMENT SUBMITTAL

REVISED 6/27/07

CITY OF LAS VEGAS REDEVELOPMENT AGENCY

STAMP
GARLOCK NEVADA REGISTERED ARCHITECT STATE OF NEVADA
FEB 17 2007

OWNER: CITY OF LAS VEGAS DEPARTMENT OF PUBLIC WORKS ARCHITECTURAL SERVICES

400 EAST STEWART AVENUE
LAS VEGAS, NEVADA 89101
PHONE: (702) 229-6251
FAX: (702) 384-4849
TDD: (702) 386-9108

DRAWN
FILE
CULTURAL AFFAIRS PLAN
DATE 12/12/2006
SCALE 1/4" = 1'-0"
BID NO
CLV DWG NO 513-65E
SHT NO A1.19

DRAWINGS AS INSTRUMENTS OF SERVICE ARE THE PROPERTY OF THE DESIGN PROFESSIONAL WHOSE SEAL OF CERTIFICATION APPEARS ON THE DRAWINGS AND SPECIFICATIONS. ANY USE OR REPRODUCTION, IN WHOLE OR IN PART, WITHOUT WRITTEN CONSENT IS STRICTLY PROHIBITED. COPIES OF THE DRAWINGS AND SPECIFICATIONS RETAINED BY THE CLIENT MAY BE UTILIZED ONLY FOR OCCUPYING THE PROJECT FOR WHICH THEY WERE PREPARED AND NOT FOR THE CONSTRUCTION OF ANY OTHER PROJECT IN A C 623-780.

REVISED 6/27/07