


BREAK ROOM - G111

SCALE: 3/8" = 1'-0"


723E061

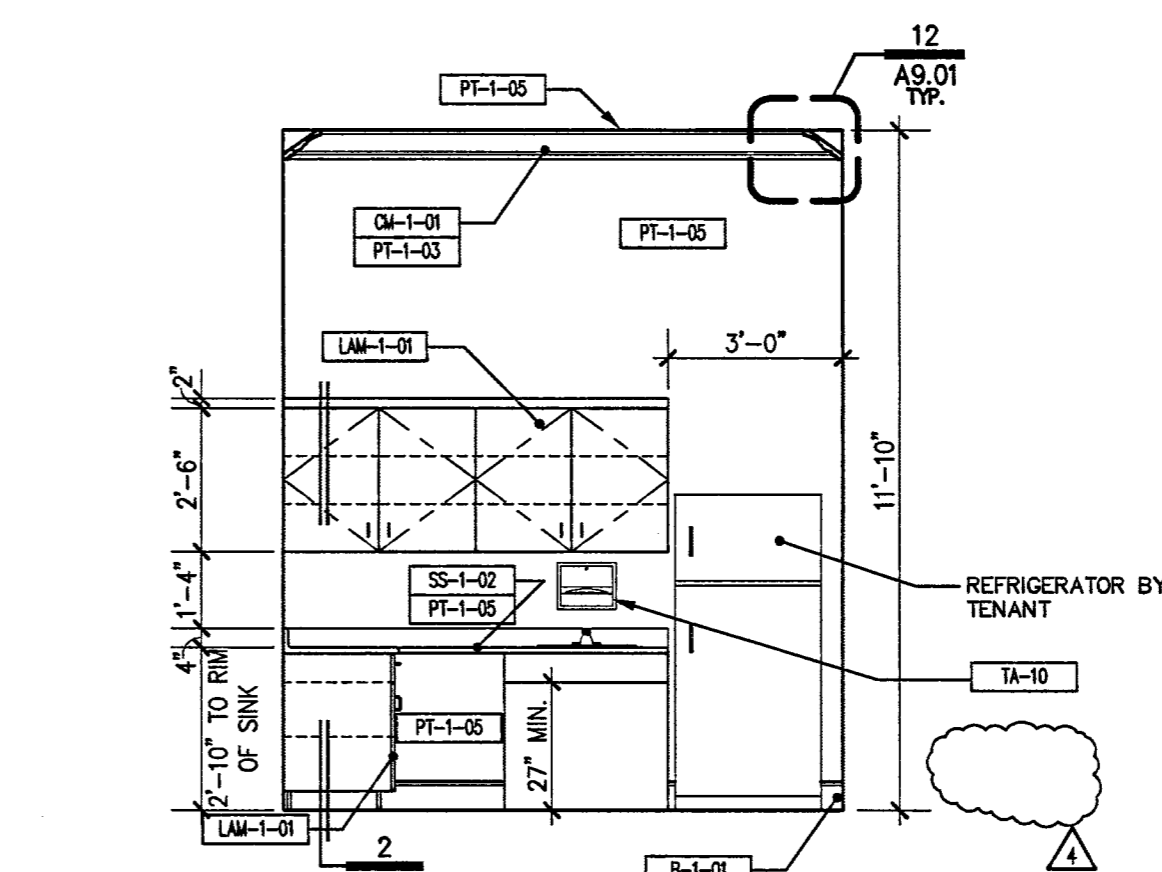

BREAK ROOM - G111

SCALE: 3/8" = 1'-0"


723E059

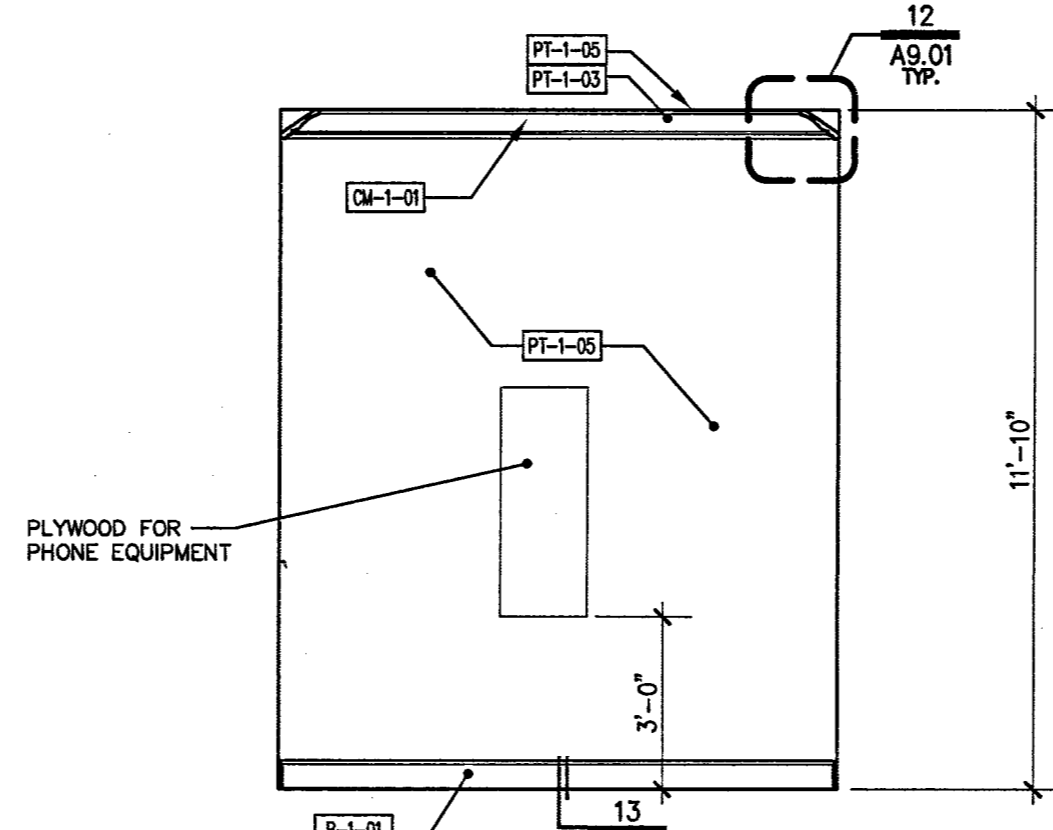

BREAK ROOM - G111

SCALE: 3/8" = 1'-0"


723E060

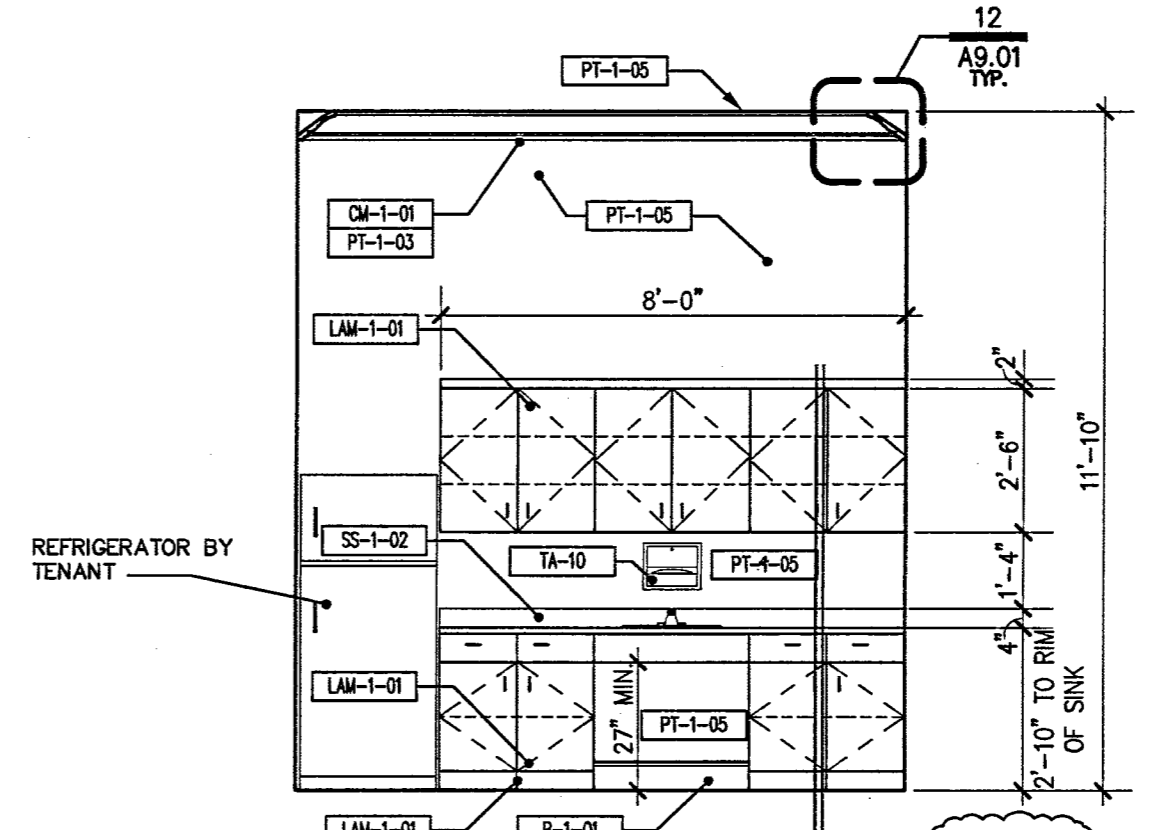

TEACHER'S LOUNGE - E103

SCALE: 3/8" = 1'-0"


723E057

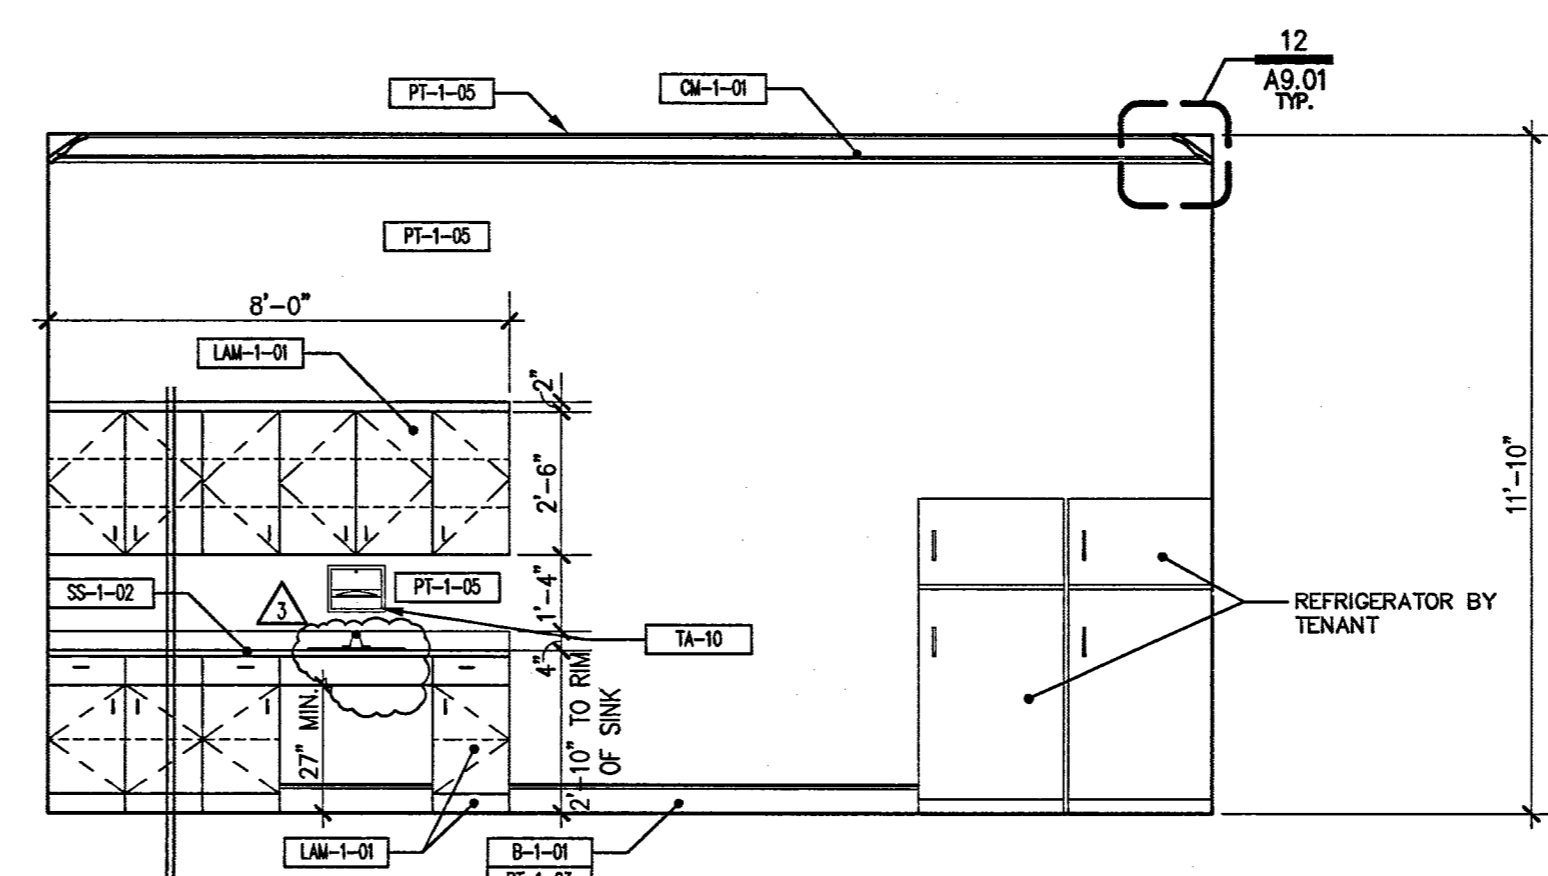

BREAK ROOM - G104

SCALE: 3/8" = 1'-0"

723E058

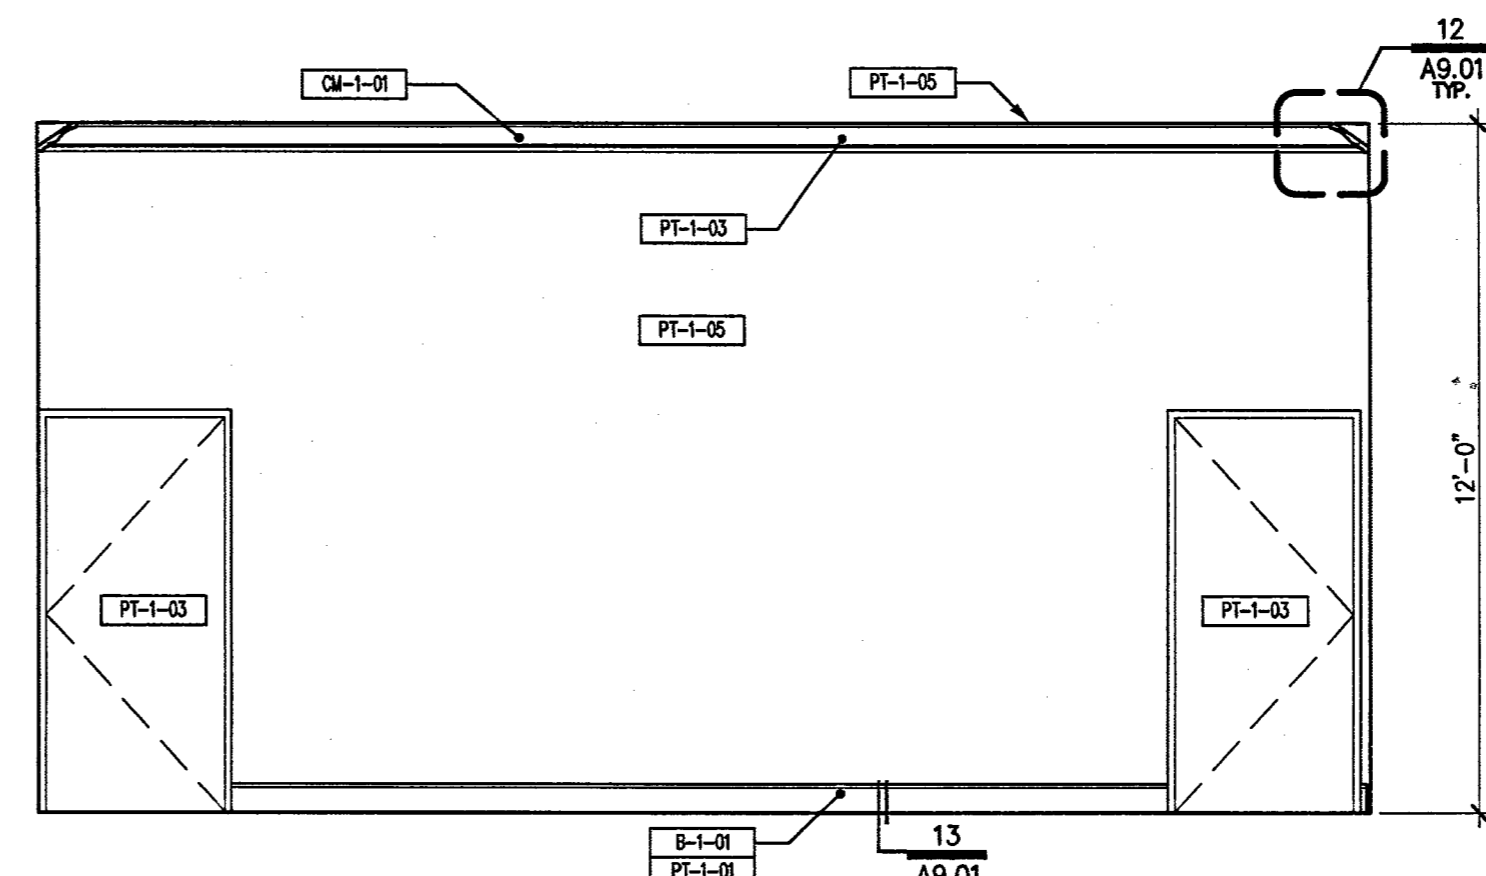

OFFICE ROOM - F100

SCALE: 3/8" = 1'-0"

723E054

TOILET ACCESSORIES

TA-#	DESCRIPTION
TA-1	SEM-RECESSED PAPER TOWEL DISPENSER/WASTE RECEPTACLE (BOBRICK B-3944), MOUNT TOP OF CABINET AT 60 1/2" A.F.F. COUNTER OR LAVATORY- MOUNTED LIQUID SOAP DISPENSER (BOBRICK B-522)
TA-2	FABRIC BURN GUARD-BOBRICK
TA-3	MIRROR-POLISHED EDGE PARTITION - MOUNTED MULTI-ROLL TOILET TISSUE AT 28" A.F.F. (BOBRICK B-4288)
TA-4	PARTITION - MOUNTED TOILET SEAT COVERS AND TOILET TISSUE DISPENSER (BOBRICK B-504)
TA-5	RECESSED TOILET SEAT COVER AND TOILET TISSUE DISPENSER (BOBRICK B-3571)
TA-6	GRAB BAR "L" SHAPED 36"x34" (BOBRICK B-5837), MOUNT CENTER OF BAR AT 34" A.F.F. SEE DETAIL 4/A9.07
TA-7	TOILET PARTITION: SEE DETAIL 2/A9.07
TA-8	SURFACE-MOUNTED PAPER TOWEL DISPENSER (BOBRICK B-282)
TA-9	GRAB BARS (BOBRICK B-5808) X 42", MOUNT CENTER OF BAR AT 34" A.F.F. WITH CENTER OF FLANGE AT 12" FROM BACK WALL. SEE DETAIL 4/A9.07
TA-10	SEM-RECESSED TOILET PAPER DISPENSER (BOBRICK B-697)
TA-11	RECESSED PAPER TOWEL DISPENSER (BOBRICK B-3590)
TA-12	GRAB BAR "L" SHAPED 30" X 42" (BOBRICK B-5837), MOUNT CENTER OF BAR AT 34" A.F.F. SEE DETAIL 4/A9.07
TA-13	SOAP DISPENSER (BOBRICK B-2112)
TA-14	TOILET SEAT COVER DISPENSER (BOBRICK B-4221)
TA-15	DRINKING FOUNTAIN
TA-16	CERAMIC TILE SHOWER BASE WITH DRAIN. SEE DETAIL 6/A9.07
TA-17	DOOR STOP. SEE DETAIL 3/A9.07
TA-18	12" CONCRETE LEDGE
TA-19	CARPET TO TILE FLOOR TRANSITION DETAIL. SEE DETAIL 5/A9.07
TA-20	GARBAGE DISPOSAL
TA-21	URINAL SCREEN

GENERAL NOTE

1. PROVIDE BACKING FOR ALL FIXTURES AND ACCESSORIES

INTERIOR FINISH SCHEDULE

KEY	DESCRIPTION
AF-1-01	ACOUSTIC WALL PANEL FABRIC-SEE FINISH SCHEDULE SHT. ID1.00/ID1.01
AP-1-01	ACOUSTIC WALL PANEL-SEE FINISH SCHEDULE SHT. ID1.00/ID1.01
AP-1-03	ACOUSTIC CEILING-SEE FINISH SCHEDULE SHT. ID1.00/ID1.01
B-1-01	CUSTOM BASE TO MATCH EXISTING-SEE FINISH SCHEDULE SHT. ID1.00/ID1.01
B-1-02	CUSTOM BASE TO MATCH EXISTING-SEE FINISH SCHEDULE SHT. ID1.00/ID1.01
CM-1-01	C & A CHOAS 15021 CASSIA BARK SEE FINISH SCHEDULE SHT. ID1.00/ID1.01
DL-1-01	LITECONTROL - CIROS SEE FINISH SCHEDULE SHT. EG1.02
DL-1-04	WAC 1126 SEE FINISH SCHEDULE SHT. EG1.02
DL-1-06	STAGE - SEE FINISH SCHEDULE SHT. LTI.01 & LTI.02
DL-1-07	6" APERTURE - NON IC WHITE CLW-SEE FINISH SCHEDULE SHT. EG1.02
DL-1-08	PENDANT FIXTURE-SEE FINISH SCHEDULE SHT. EG1.02
HA-1-01	HANGING ART BRUSHED NICKEL-SEE FINISH SCHEDULE SHT. ID1.00/ID1.01
LAM-1-01	LAMINATE-SEE FINISH SCHEDULE SHT. ID1.00/ID1.01
MB-1-01	MARKER/CORD BOARD CHERRY-SEE FINISH SCHEDULE SHT. ID1.00/ID1.01
PT-1-01	PAINT-SEE FINISH SCHEDULE SHT. ID1.00/ID1.01
PT-1-02	PAINT-SEE FINISH SCHEDULE SHT. ID1.00/ID1.01
PT-1-03	PAINT-SEE FINISH SCHEDULE SHT. ID1.00/ID1.01
PT-1-04	PAINT-SEE FINISH SCHEDULE SHT. ID1.00/ID1.01
PT-1-05	PAINT-SEE FINISH SCHEDULE SHT. ID1.00/ID1.01
PT-1-06	PAINT-SEE FINISH SCHEDULE SHT. ID1.00/ID1.01
PT-1-07	PAINT-SEE FINISH SCHEDULE SHT. ID1.00/ID1.01
PT-1-08	PAINT-SEE FINISH SCHEDULE SHT. ID1.00/ID1.01
SF-1-01	STAGE LAMINATE-SEE FINISH SCHEDULE SHT. ID1.00/ID1.01
SS-1-01	SOLID SURFACING COPPER NUGGET-SEE FINISH SCHEDULE SHT. ID1.00/ID1.01
SS-1-02	SOLID SURFACING BLACK LAVA-SEE FINISH SCHEDULE SHT. ID1.00/ID1.01
T-1-01	FIORITO NOCE FR21-SEE FINISH SCHEDULE SHT. ID1.00/ID1.01
T-1-02	KEYSTONES UNGLAZED BLACK-SEE FINISH SCHEDULE SHT. ID1.00/ID1.01
T-1-03	FIORITO NOCE FR21-SEE FINISH SCHEDULE SHT. ID1.00/ID1.01
T-1-04	FIORITO GOTTA FR24-SEE FINISH SCHEDULE SHT. ID1.00/ID1.01
T-1-05	VILLAGE BLEND NOCE FR21-SEE FINISH SCHEDULE SHT. ID1.00/ID1.01
TP-1-01	POWDER COATED STEEL PARTITIONS-SEE FINISH SCHEDULE SHT. ID1.00/ID1.01
WD-1-01	WOOD FLOOR-SEE FINISH SCHEDULE SHT. ID1.00/ID1.01
WD-1-02	WOOD PANELS-SEE FINISH SCHEDULE SHT. ID1.00/ID1.01
WD-1-03	WOOD PANELS-SEE FINISH SCHEDULE SHT. ID1.00/ID1.01
WS-1-01	EQUINOX 0100-0110 NEUTRAL-MOTORIZED SEE FINISH SCHEDULE SHT. ID1.00/ID1.01
WS-1-02	WINDOWMATES - CREAM SEE FINISH SCHEDULE SHT. ID1.00/ID1.01

RECEIVED
FEB 08 2007
CITY OF LAS VEGAS
BUILDING DEPT.

PLANS APPROVED
ARCHITECTURAL
City of Las Vegas
FEB 09 2007
Does Not Include Electrical, Plumbing, Mechanical, Structural or CE-5/6/7/999/1000

CITY OF LAS VEGAS

 FIFTH STREET SCHOOL

 REHABILITATION

 BUILDING DEPARTMENT SUBMITTAL

 REVISED

 FEB 12 2007

 CITY OF LAS VEGAS

 REDEVELOPMENT AGENCY

 OWNER: CITY OF LAS VEGAS

 DEPARTMENT OF PUBLIC WORKS

 ARCHITECTURAL SERVICES

 400 EAST STEPHAN AVENUE

 LAS VEGAS, NEVADA 89101

 PHONE: (702) 388-8330

 FAX: (702) 388-4844

 TDD: (702) 388-9141

 DATE:

 INTERIOR ELEVATIONS

 DATE:

 12/12/2006

 SCALE:

 3/8" = 1'-0"

 SHEET NO:

 513-65E

 SHEET NO:

 A5.06

 REVISION 02/03

113299