

DOOR AND FRAME SCHEDULE


ENTIRE SHEET REVISED

DOOR NO.	ROOM NO.	DOOR				FRAME				HDW	SCOPE	REMARKS	
		TYPE	WIDTH	HT	THK	MATL	HEAD	JAMB	SILL				
AUDITORIUM- SEE SHEET A111													
100A	100	D	3'-4"	7'-1"	1 3/4"	WOOD	1/A2.31 SIM.	3/A2.31 SIM.	3/A2.31 SIM.	-	06	NEW	EXISTING OPENING- NON-HISTORIC DOOR
100B	100	B (PAIR)	6'-4 1/2"	7'-4"	1 3/4"	WOOD	1/A2.31 SIM.	3/A2.31 SIM.	3/A2.31 SIM.	-	01	RF	
100C	100	B (PAIR)	6'-4 1/2"	7'-4"	1 3/4"	WOOD	1/A2.31 SIM.	3/A2.31 SIM.	3/A2.31 SIM.	-	01	RF	
100D	100	B (PAIR)	6'-4 1/2"	7'-4"	1 3/4"	WOOD	1/A2.31 SIM.	3/A2.31 SIM.	3/A2.31 SIM.	-	01	RF	
100E	100	G (PAIR)	6'-2"	8'-8"	1 3/4"	WOOD	1/A2.31 SIM.	3/A2.31 SIM.	3/A2.31 SIM.	-	02	RPR	
100G	100	D	3'-3"	7'-2"	1 3/4"	WOOD	1/A2.31 SIM.	3/A2.31 SIM.	3/A2.31 SIM.	-	14	NEW	
100H	100	D	3'-3"	7'-1 1/2"	1 3/4"	WOOD	3/A2.21 SIM.	3/A2.21	3/A2.21	-	14	NEW	
101A	101	D	3'-3"	7'-2"	1 3/4"	WOOD	5/A2.21 SIM.	5/A2.21	5/A2.21	-	6	NEW	
101B	101	B	3'-3"	7'-2"	1 3/4"	WOOD	1/A2.31 SIM.	3/A2.31 SIM.	3/A2.31 SIM.	4/A2.31	06	RPR	
102A	102	D	3'-3"	7'-2"	1 3/4"	WOOD	5/A2.21 SIM.	5/A2.21	5/A2.21	-	15	NEW	
103A	103	D (PAIR)	6'-4"	7'-2"	1 3/4"	WOOD	4/A2.21 SIM.	4/A2.21	4/A2.21	-	10	NEW	
103B	103	D	3'-2 1/2"	7'-1 1/2"	1 3/4"	WOOD	4/A2.21 SIM.	4/A2.21	4/A2.21	-	6	NEW	
103C	103	D (PAIR)	6'-2"	8'-8"	1 3/4"	WOOD	1/A2.31 SIM.	3/A2.31 SIM.	3/A2.31 SIM.	4/A2.31	03	NEW	
103D	103	B	3'-2"	7'-1 1/2"	1 3/4"	WOOD	1/A2.31 SIM.	3/A2.31 SIM.	3/A2.31 SIM.	4/A2.31	06	RPR	
115A	115	D	3'-3"	7'-0"	1 3/4"	WOOD	1/A2.21	2/A2.21	2/A2.21	4/A2.31	07	TRR	OPERABLE HARDWARE (STORAGE RM. SHEET A1.11)
116A	116	D	3'-3"	7'-0"	1 3/4"	WOOD	1/A2.21	2/A2.21	2/A2.21	4/A2.31	07	TRR	OPERABLE HARDWARE (STORAGE RM. SHEET A1.11)
GALLERY- SEE SHEET A1.12													
104A	104	D	3'-3"	7'-2"	1 3/4"	WOOD	1/A2.21	2/A2.21	2/A2.21	-	16	NEW	
105A	105	D	3'-0" LEFT 2'-0" R	7'-2"	1 3/4"	WOOD	4/A2.21 SIM.	4/A2.21	4/A2.21	-	11	NEW	
106A	106	B	3'-2 1/2"	7'-1 3/4"	1 3/4"	WOOD	1/A2.31 SIM.	3/A2.31 SIM.	3/A2.31 SIM.	4/A2.31	06	TRR	
106C	110	D	3'-2 1/2"	7'-1 3/4"	1 3/4"	WOOD	1/A2.31 SIM.	3/A2.31 SIM.	3/A2.31 SIM.	4/A2.31	01	RF	
107A	107	D	3'-3"	7'-2"	1 3/4"	WOOD	1/A2.21	2/A2.21	2/A2.21	-	16	NEW	
108A	108	D	3'-3"	7'-2"	1 3/4"	WOOD	1/A2.21	2/A2.21	2/A2.21	-	15	NEW	
109A	109	D	3'-3"	7'-2"	1 3/4"	WOOD	1/A2.21	2/A2.21	2/A2.21	-	15	NEW	
109B	109	B (PAIR)	5'-3"	7'-2"	1 3/4"	WOOD	1/A2.31 SIM.	3/A2.31 SIM.	3/A2.31 SIM.	4/A2.31	1	RF	
110A	110	D	3'-3"	7'-2"	1 3/4"	WOOD	3/A2.21 SIM.	3/A2.21	3/A2.21	4/A2.31	06	NEW	
110B	110	B	3'-3"	7'-2"	1 3/4"	WOOD	3/A2.21 SIM.	3/A2.21	3/A2.21	4/A2.31	06	NEW	
111A	111	D	3'-3"	7'-2"	1 3/4"	WOOD	1/A2.21	2/A2.21	2/A2.21	-	18	NEW	
112A	112	D	3'-3"	7'-2"	1 3/4"	WOOD	1/A2.21	2/A2.21	2/A2.21	-	19	NEW	
113A	113	D	3'-3"	7'-2"	1 3/4"	WOOD	1/A2.21	2/A2.21	2/A2.21	-	15	NEW	
113B	113	B	2'-2"	7'-2"	1 3/4"	WOOD	1/A2.31 SIM.	3/A2.31 SIM.	3/A2.31 SIM.	-	07	RPR	
114A	114	D	3'-3"	7'-0"	1 3/4"	WOOD	1/A2.21	2/A2.21	2/A2.21	-	15	NEW	
BUILDING E- NEVADA SCHOOL OF THE ARTS- SEE SHEET A1.13													
E101A	E101	A	3'-2 1/2"	7'-1 1/2"	1 3/4"	WOOD	1/A2.31 SIM.	3/A2.31 SIM.	3/A2.31 SIM.	4/A2.31	06	TRR	OPERABLE HARDWARE
E101B	E101	D (PAIR)	6'-3"	7'-2"	1 3/4"	WOOD	1/A2.21	2/A2.21	2/A2.21	-	12	NEW	
E101C	E101	D (PAIR)	6'-3"	7'-2"	1 3/4"	WOOD	1/A2.21	2/A2.21	2/A2.21	-	12	NEW	
E101D	E101	D (PAIR)	6'-3"	7'-2"	1 3/4"	WOOD	1/A2.21	2/A2.21	2/A2.21	-	12	NEW	
E101E	E101	J-1	3'-2 1/2"	7'-2"	1 3/4"	WOOD	1/A2.31	8/A2.31	7/A2.31	4/A2.31	01	TRR	
E101G	E101	J-2	3'-2 1/2"	7'-2"	1 3/4"	WOOD	1/A2.31	7/A2.31	7/A2.31	4/A2.31	01	TRR	
E101H	E101	J-3	3'-2 1/2"	7'-2"	1 3/4"	WOOD	1/A2.31	7/A2.31	8/A2.31	4/A2.31	01	TRR	
E101J	E101	K	3'-2 1/2"	7'-2"	1 3/4"	WOOD	1/A2.31	8/A2.31	8/A2.31	4/A2.31	01	NEW	
E101K	E101	J-1	3'-2 1/2"	7'-2"	1 3/4"	WOOD	1/A2.31	8/A2.31	7/A2.31	4/A2.31	01	TRR	
E101L	E101	J-2	3'-2 1/2"	7'-2"	1 3/4"	WOOD	1/A2.31	7/A2.31	7/A2.31	4/A2.31	01	TRR	
E101M	E101	J-3	3'-2 1/2"	7'-2"	1 3/4"	WOOD	1/A2.31	7/A2.31	8/A2.31	4/A2.31	01	TRR	
E102A	E102	D	3'-3"	7'-0"	1 3/4"	WOOD	1/A2.21	2/A2.21	2/A2.21	-	16	NEW	
E103A	E103	D	3'-3"	7'-0"	1 3/4"	WOOD	1/A2.21	2/A2.21	2/A2.21	-	17	NEW	
E104A	E104	D	3'-3"	7'-0"	1 3/4"	WOOD	1/A2.21	2/A2.21	2/A2.21	-	20	NEW	
E104B	A	3'-2 1/2"	7'-2"	1 3/4"	WOOD					1	RF	INSIDE FACE OF GLAZING TO BE PAINTED	
E105A	E105	D	3'-3"	7'-0"	1 3/4"	WOOD	4/A2.21 SIM.	4/A2.21	4/A2.21	-	22	NEW	
E105B	E105	J-1	3'-2 1/2"	7'-2"	1 3/4"	WOOD	1/A2.31	8/A2.31	7/A2.31	4/A2.31	01	TRR	
E105C	E105	J-2	3'-2 1/2"	7'-2"	1 3/4"	WOOD	1/A2.31	7/A2.31	7/A2.31	4/A2.31	01	TRR	
E105D	E105	J-3	3'-2 1/2"	7'-2"	1 3/4"	WOOD	1/A2.31	7/A2.31	8/A2.31	4/A2.31	01	TRR	
E105E	E105	K	3'-2 1/2"	7'-2"	1 3/4"	WOOD	1/A2.31	8/A2.31	8/A2.31	4/A2.31	01	NEW	
E105G	E105	J-1	3'-2 1/2"	7'-2"	1 3/4"	WOOD	1/A2.31	8/A2.31	7/A2.31	4/A2.31	01	TRR	
E105H	E105	J-2	3'-2 1/2"	7'-2"	1 3/4"	WOOD	1/A2.31	7/A2.31	7/A2.31	4/A2.31	01	TRR	
E105J	E105	J-3	3'-2 1/2"	7'-2"	1 3/4"	WOOD	1/A2.31	7/A2.31	8/A2.31	4/A2.31	01	TRR	

DOOR AND FRAME SCHEDULE

DOOR NO.	ROOM NO.	DOOR				FRAME				HDW	SCOPE	REMARKS	
		TYPE	WIDTH	HT	THK	MATL	HEAD	JAMB	SILL				
BUILDING E- NEVADA SCHOOL OF THE ARTS- SEE SHEET A1.14													
E106A	E106	A	3'-3"	7'-2"	1 3/4"	WOOD	1/A2.31 SIM.	3/A2.31 SIM.	3/A2.31 SIM.	4/A2.31	06	TRR	OPERABLE HARDWARE
E106B	E106	A	3'-3"	7'-2"	1 3/4"	WOOD	1/A2.31 SIM.	3/A2.31 SIM.	3/A2.31 SIM.	4/A2.31	06	TRR	OPERABLE HARDWARE
E108A	E108	D	3'-3"	7'-0"	1 3/4"	WOOD	1/A2.21	2/A2.21	2/A2.21	-	20	NEW	
E108B	E108	J-1	3'-2 1/2"	7'-2"	1 3/4"	WOOD	1/A2.31	8/A2.31	7/A2.31	4/A2.31	01	TRR	
E108C	E108	J-2	3'-2 1/2"	7'-2"	1 3/4"	WOOD	1/A2.31	7/A2.31	7/A2.31	4/A2.31	01	TRR	
E108D	E108	J-3	3'-2 1/2"	7'-2"	1 3/4"	WOOD	1/A2.31	7/A2.31	8/A2.31	4/A2.31	01	TRR	
E109A	E109	D	3'-3"	7'-0"	1 3/4"	WOOD	1/A2.21	2/A2.21	2/A2.21	-	22	NEW	
E109B	E109	K	3'-2 1/2"	7'-2"	1 3/4"	WOOD	1/A2.31	8/A2.31	8/A2.31	4/A2.31	01	NEW	
E109C	E109	J-1	3'-2 1/2"	7'-2"	1 3/4"	WOOD	1/A2.31	8/A2.31	7/A2.31	4/A2.31	01	TRR	
E109D	E109	J-2	3'-2 1/2"	7'-2"	1 3/4"	WOOD	1/A2.31	7/A2.31	7/A2.31	4/A2.31	01	TRR	
E109E	E109	J-3	3'-2 1/2"	7'-2"	1 3/4"	WOOD	1/A2.31	7/A2.31	8/A2.31	4/A2.31	01	TRR	
E110A	E110	D	3'-3"	7'-0"	1 3/4"	WOOD	1/A2.21	2/A2.21	2/A2.21	-	22	NEW	
E110B	E110	J-1	3'-2 1/2"	7'-2"	1 3/4"	WOOD	1/A2.31	8/A2.31	7/A2.31	4/A2.31	01	TRR	
E110C	E110	J-2	3'-2 1/2"	7'-2"	1 3/4"	WOOD	1/A2.31	7/A2.31	7/A2.31	4/A2.31	01	TRR	
E110D	E110	J-3	3'-2 1/2"	7'-2"	1 3/4"	WOOD	1/A2.31	7/A2.31	8/A2.31	4/A2.31	01	TRR	
E110E	E110	K	3'-2 1/2"	7'-2"	1 3/4"	WOOD	1/A2.31	8/A2.31	8/A2.31	4/A2.31	01	NEW	
BUILDING E- NEVADA SCHOOL OF THE ARTS- SEE SHEET A1.14													
E111A	E111	D	3'-3"	7'-0"	1 3/4"	WOOD	1/A2.21	2/A2.21	2/A2.21	-	22	NEW	
E112A	E112	D	3'-3"	7'-0"	1 3/4"	WOOD	1/A2.21	2/A2.21	2/A2.21	-	22	NEW	
E112B	E112	J-3	3'-2 1/2"	7'-2"	1 3/4"	WOOD	1/A2.31	7/A2.31	8/A2.31	4/A2.31	01	TRR	
E113A	E113	J-2	3'-2 1/2"	7'-2"	1 3/4"	WOOD	1/A2.31	8/A2.31	7/A2.31	4/A2.31	01	TRR	
E113B	E113	J-1	3'-2 1/2"	7'-2"	1 3/4"	WOOD	1/A2.31	7/A2.31	7/A2.31	4/A2.31	01	TRR	
E114A	E114	D	3'-3"	7'-0"	1 3/4"	WOOD	1/A2.21	2/A2.21	2/A2.21	-	16	NEW	

DOOR TYPES

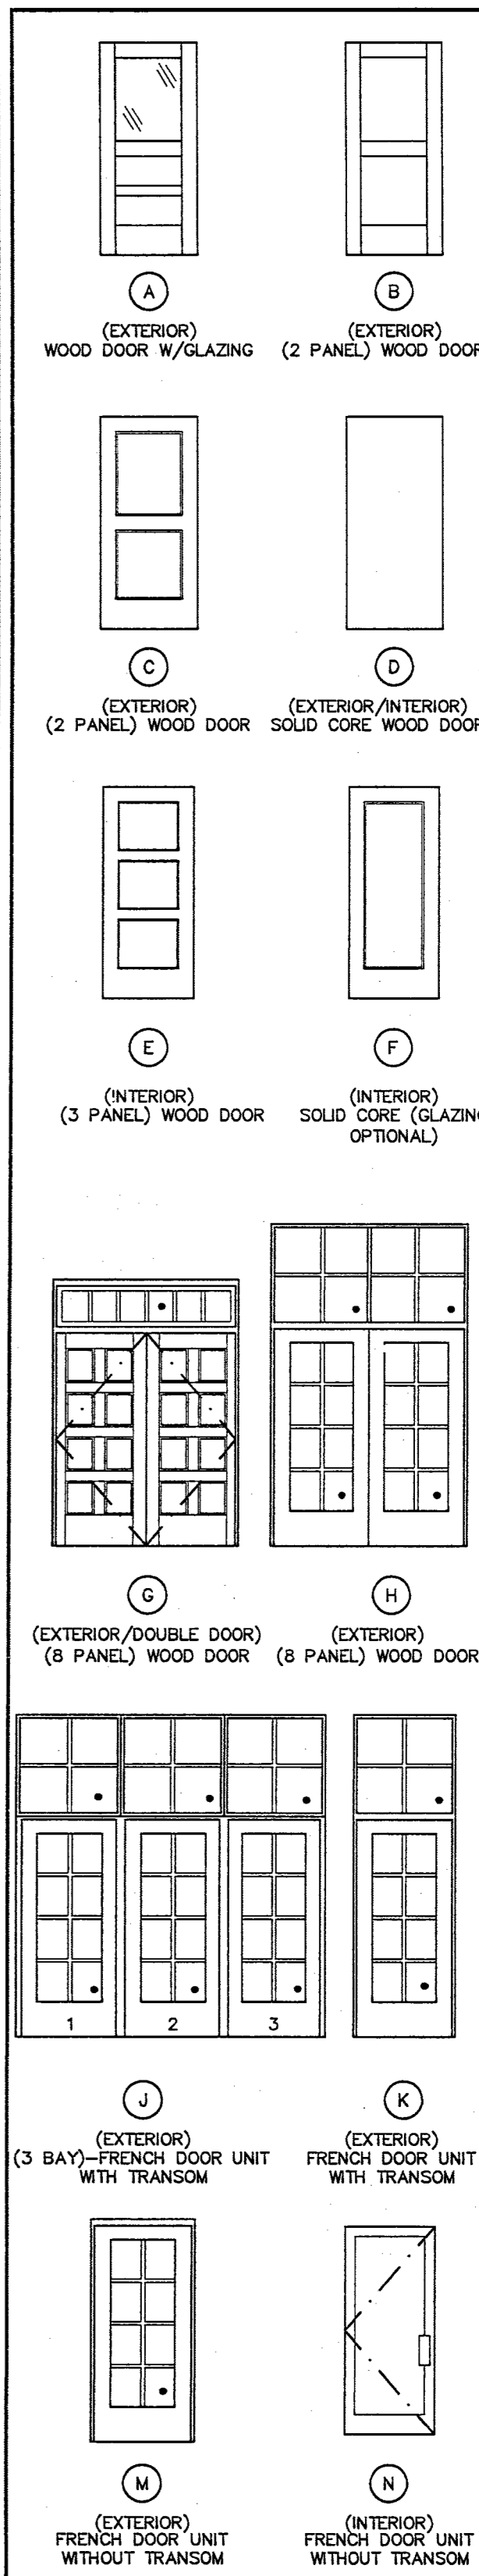

GLAZING TYPES

DESCRIPTION

COORDINATE GLAZING TYPES WITH WINDOW RESTORATION SCHEDULE AND TRANSOM DOOR ASSEMBLY RESTORATION SCHEDULE.

INDICATES TEMPERED GLASS IN ENTIRE DOOR ASSEMBLY

SCOPE LEGEND

RF REPLACEMENT/FURRED OVER ON INSIDE WALL. 100% NEW, VISIBLE FROM EXTERIOR ONLY.

TRR TOTALLY REPLACED/REPLICATED. 100% NEW

R RESTORE ORIGINAL

RPR RESTORE/PARTIALLY REPLICATE. SCOPE OF WORK FOR EACH WINDOW/DOOR OPENING TO BE IDENTIFIED. SEE SHEET A2.11 FOR RESTORATION SCHEDULE AND INFORMATION.

VERIFY DIMENSION OF ALL EXISTING OPENINGS CONTACT ARCHITECT OF ANY DISCREPANCIES BETWEEN FIELD CONDITIONS AND THE DOCUMENTS PRIOR TO CONSTRUCTION.

RECEIVED
FEB 15 2007
CITY OF LAS VEGAS
PERMITS

PLANS APPROVED
ARCHITECTURAL
FEB 15 2007

CLV COMMENTS
14-007

OWNER COMMENTS
2-0-007

CONSULTANT
KGA ARCHITECTURE
445 SOUTH POLARIS AVENUE
LAS VEGAS, NV 89101
WWW.KGAARCHITECTURE.COM
PHONE: