

**BASIS OF BEARINGS**  
 THE BASIS OF BEARINGS FOR THIS PROJECT IS NORTH 27°54'38" EAST - THE CENTERLINE OF LAS VEGAS BOULEVARD FROM STATION "B" (1077+00.00 POT TO STATION "B" 1155+93.64 POT (AND FREMONT AVENUE) BEARS NORTH 27°54'38" EAST PER NEVADA DEPARTMENT OF HIGHWAY DRAWINGS, PROJECT NUMBER F005-(1), AS SHOWN BY THAT RECORD OF SURVEY ON FILE IN THE OFFICE OF THE COUNTY RECORDER, CLARK COUNTY, NEVADA, IN FILE #7 OF SURVEYS, AT PAGE 79.



**PROJECT BENCHMARK**  
 PROJECT DATUM: CITY OF LAS VEGAS BENCH MARK NO. CLVBM FREMONT 5 - RIVET AND PLATE IN THE TOP OF CURB AT THE NORTHEAST RETURN OF FREMONT AND LAS VEGAS BOULEVARD.

NAVD88 ELEVATION: 2007.32 METERS (6586.70 FEET)

**Call before you Overhead**  
 1-702-227-2929

**Call before you Dig**  
 1-800-227-2600

**Call before you Underground**  
 1-702-455-7511  
 1-702-229-5611

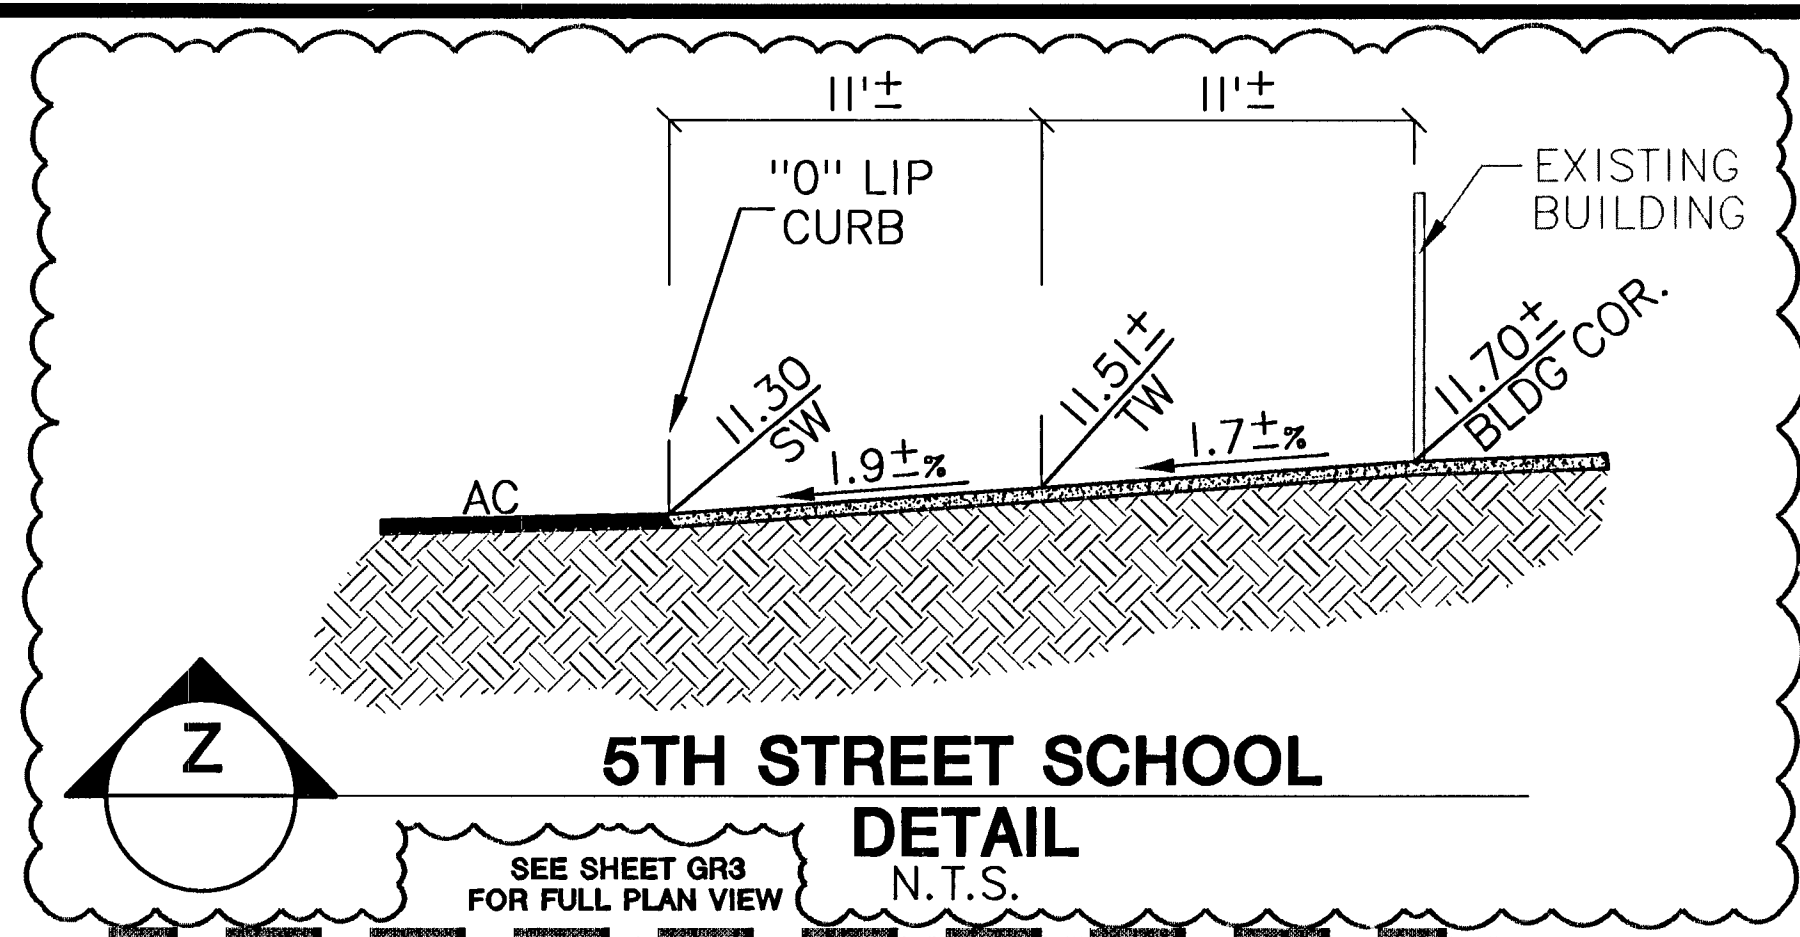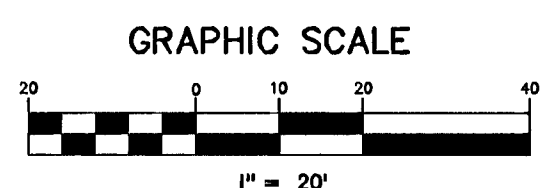

- ABBREVIATIONS**
- FG FINISH GRADE
  - FL FLOW LINE
  - TRC TOP OF CURB
  - EP EDGE OF PAVEMENT
  - FUT. FUTURE
  - EX. EXISTING
  - VG VALLEY GUTTER
  - NG NATURAL GROUND
  - H.P. HIGH POINT
  - L.P. LOW POINT
  - C/L CENTER LINE
  - O/C OFFSET CROWN
  - B/C BACK OF CURB
  - BCR BEGIN CURB RETURN
  - TF TOP OF FOOTING
  - GR GRADE BREAK
  - PC POINT OF CURVATURE
  - S/W SIDEWALK

- LEGEND**
- EX. BUS STOP
  - EX. CATCH BASIN
  - EX. CENTERLINE
  - EX. CHAIN LINK FENCE
  - EX. ELECTRIC VAULT/PULL BOX
  - EX. BUILDING
  - EX. FIRE HYDRANT
  - EX. FLAG POLE
  - EX. FOUND MONUMENT AS NOTED
  - EX. GAS VALVE
  - EX. GUARD POST
  - EX. LIGHT
  - EX. PARKING METER
  - EX. RIGHT OF WAY LINE
  - EX. SANITARY SEWER MANHOLE
  - EX. SIGN
  - EX. STORM DRAIN MANHOLE
  - EX. STREET LIGHT
  - EX. STREET LIGHT PULL BOX
  - EX. TELEPHONE MANHOLE
  - EX. TELEPHONE PULL BOX
  - EX. TRAFFIC LANE DELINEATION
  - EX. VAULT
  - EX. WALL
  - EX. WATER METER
  - EX. WATER VALVE
  - EX. WHEEL CHAIR ACCESS RAMP
  - EX. WROUGHT IRON FENCE
  - ADA ACCESS ROUTE
  - SITE VISIBILITY ZONE


**5.5\"/>

**4\"/>

**4\"/>

**NEW 4\"/>

**EXISTING 5\"/>**********

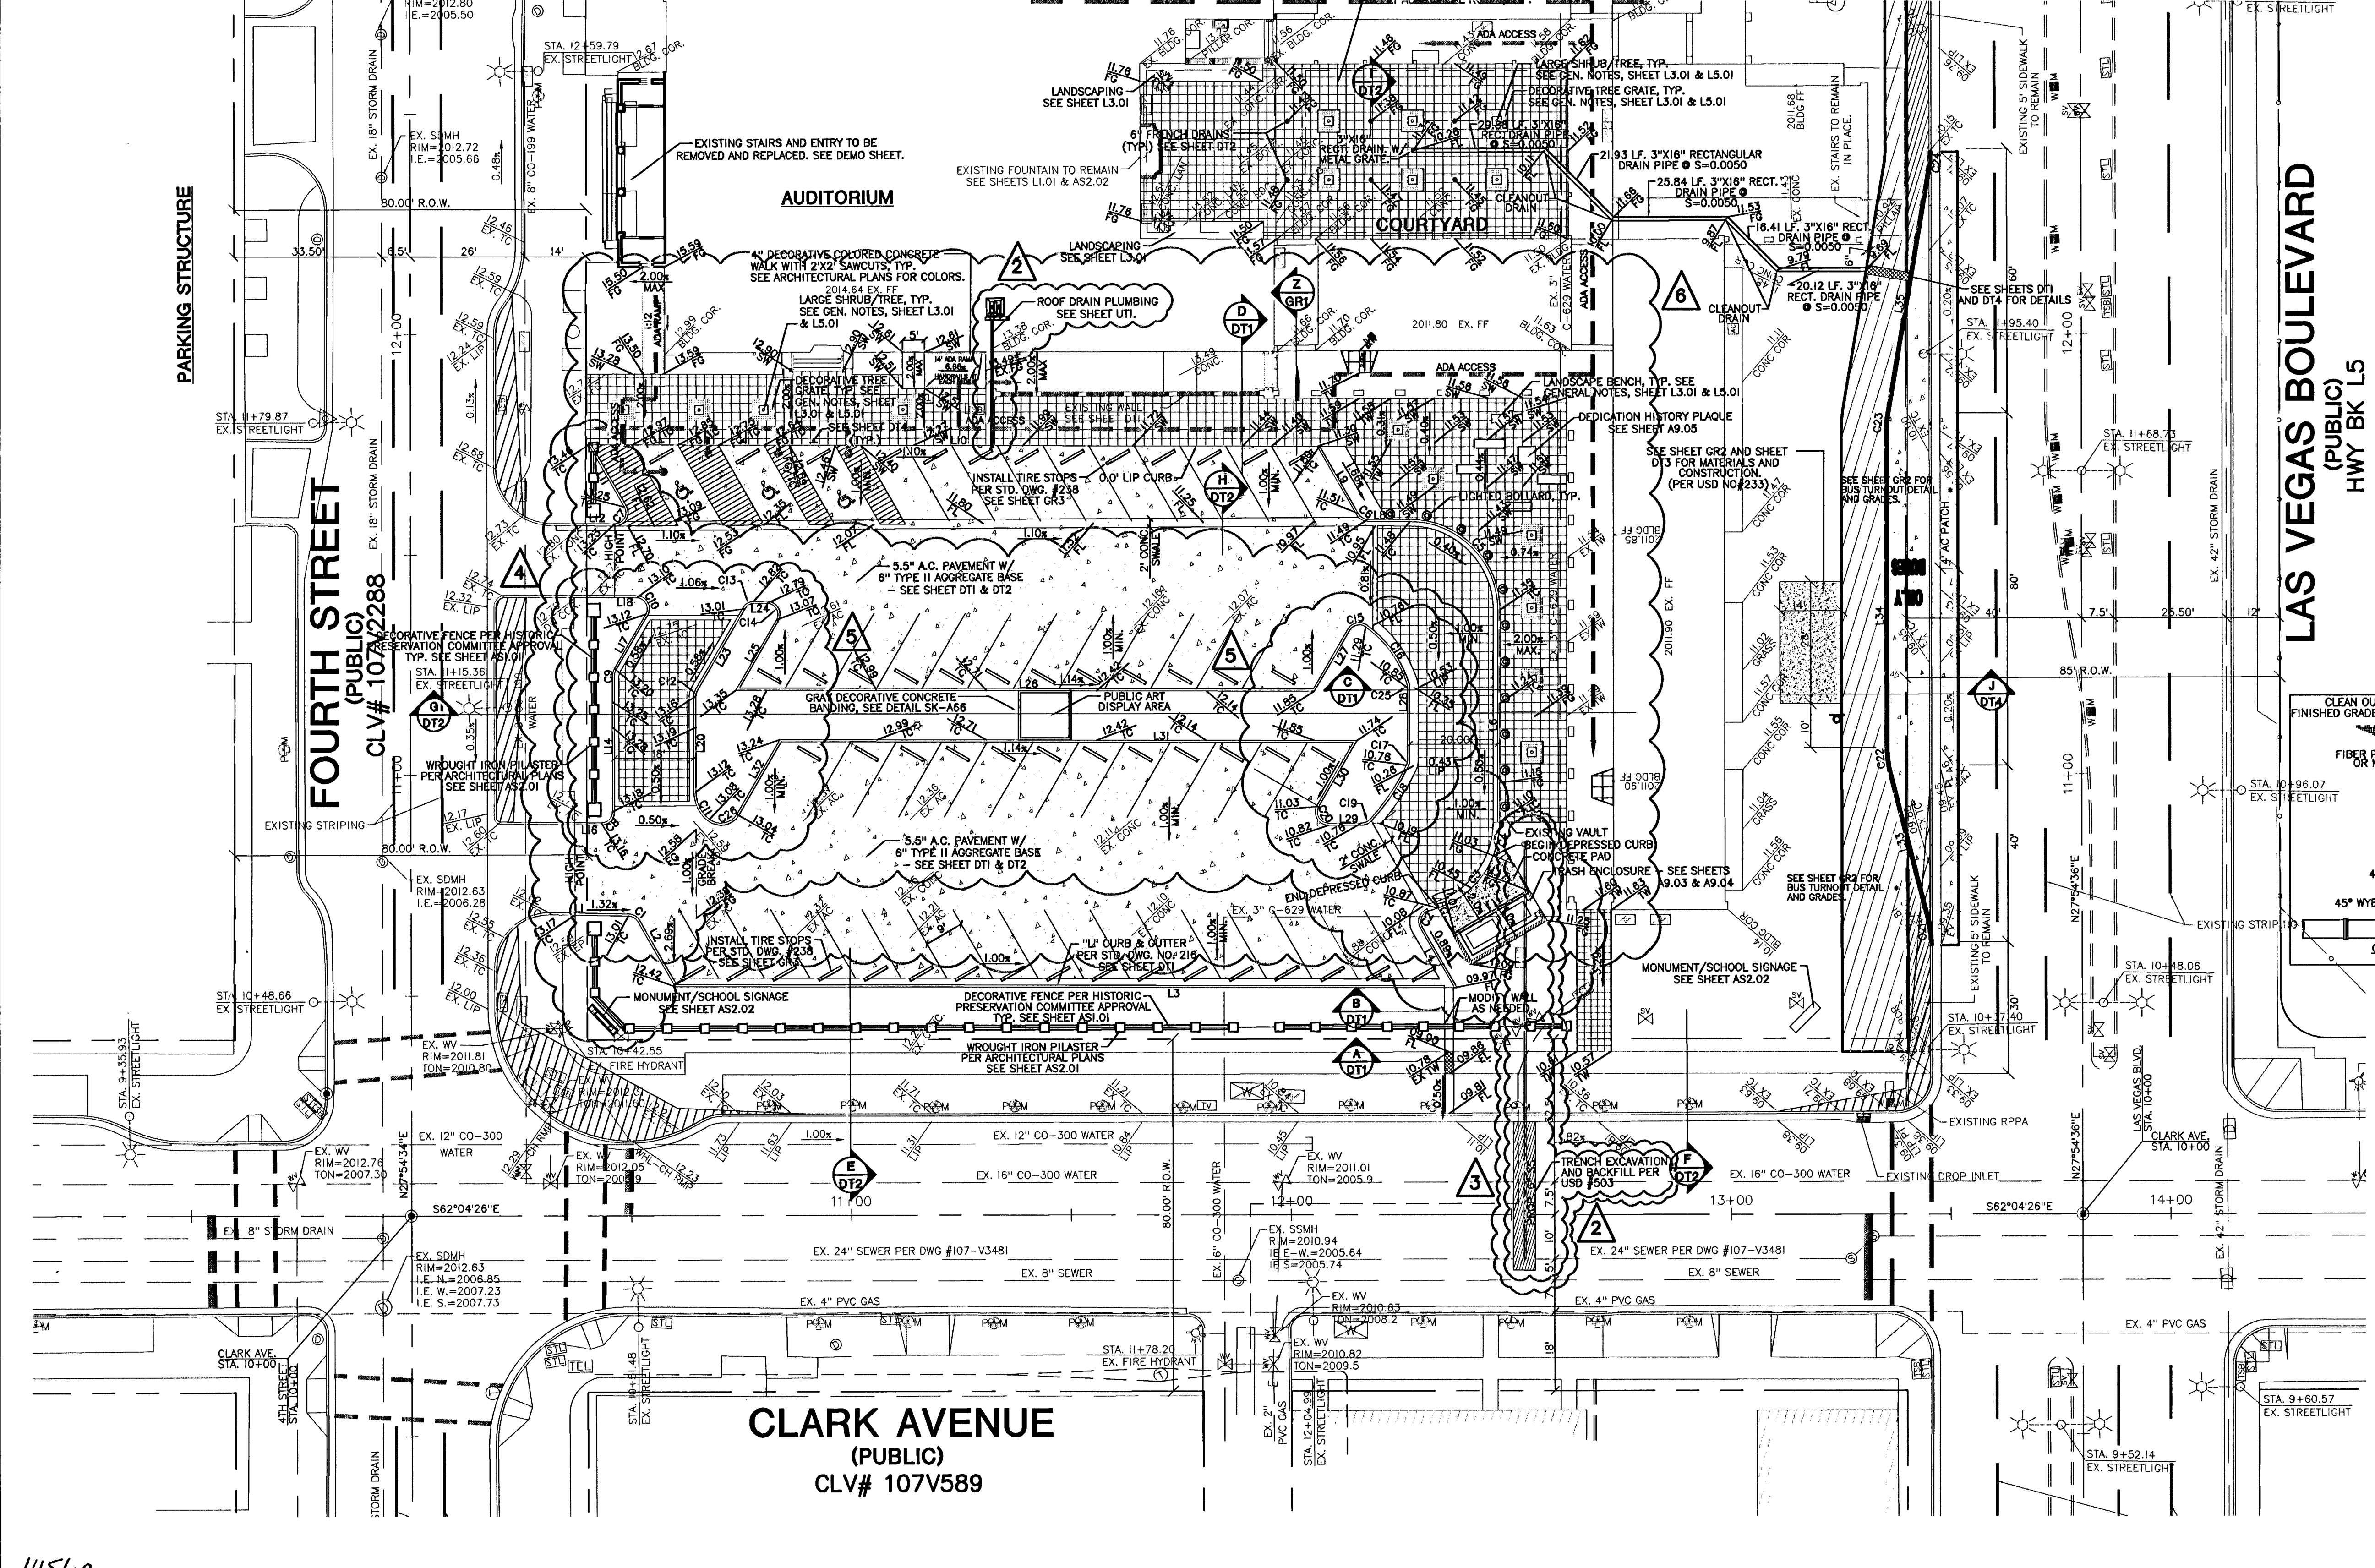

**LAS VEGAS BOULEVARD (PUBLIC) HWY Bk L5**

**CLARK AVENUE (PUBLIC) CLV# 107V589**

**LINE TABLE**

LINE	LENGTH	BEARING	
L1	12.10	S61°24'04\"/> <tr><td>L2</td><td>17.07</td><td>S01°56'08\"/&gt; <tr><td>L3</td><td>188.22</td><td>S61°56'08\"/&gt; <tr><td>L4</td><td>18.94</td><td>N01°56'08\"/&gt; <tr><td>L5</td><td>48.24</td><td>N28°03'52\"/&gt; <tr><td>L6</td><td>9.53</td><td>N61°56'08\"/&gt; <tr><td>L7</td><td>17.90</td><td>N01°56'08\"/&gt; <tr><td>L8</td><td>16.23</td><td>N61°56'07\"/&gt; <tr><td>L9</td><td>3.18</td><td>S01°56'08\"/&gt; <tr><td>L10</td><td>19.20</td><td>N27°55'09\"/&gt; <tr><td>L11</td><td>30.78</td><td>N27°55'09\"/&gt; <tr><td>L12</td><td>5.90</td><td>S61°56'08\"/&gt; <tr><td>L13</td><td>6.08</td><td>S61°33'51\"/&gt; <tr><td>L14</td><td>14.28</td><td>N58°03'52\"/&gt; <tr><td>L15</td><td>14.25</td><td>S61°54'25\"/&gt; <tr><td>L16</td><td>21.73</td><td>N27°54'49\"/&gt; <tr><td>L17</td><td>5.66</td><td>N27°54'49\"/&gt; <tr><td>L18</td><td>1.38</td><td>N27°54'49\"/&gt; <tr><td>L19</td><td>21.54</td><td>N58°03'52\"/&gt; <tr><td>L20</td><td>2.99</td><td>N61°57'57\"/&gt; <tr><td>L21</td><td>18.47</td><td>S58°35'2\"/&gt; <tr><td>L22</td><td>13.67</td><td>S61°56'08\"/&gt; <tr><td>L23</td><td>15.99</td><td>N58°03'52\"/&gt; <tr><td>L24</td><td>16.65</td><td>S28°03'52\"/&gt; <tr><td>L25</td><td>7.59</td><td>N61°56'08\"/&gt; <tr><td>L26</td><td>17.30</td><td>N58°03'52\"/&gt; <tr><td>L27</td><td>131.25</td><td>S61°56'08\"/&gt; <tr><td>L28</td><td>19.64</td><td>N61°53'37\"/&gt; <tr><td>L29</td><td>36.21</td><td>N13°25'07\"/&gt; <tr><td>L30</td><td>71.81</td><td>N27°52'57\"/&gt; <tr><td>L31</td><td>57.40</td><td>N37°32'38\"/&gt; <tr><td>L32</td><td>7.32</td><td>N62°04'26\"/&gt; </td></tr><tr><td>L27</td><td>131.25</td><td>S61°56'08\"/&gt; <tr><td>L28</td><td>19.64</td><td>N61°53'37\"/&gt; <tr><td>L29</td><td>36.21</td><td>N13°25'07\"/&gt; <tr><td>L30</td><td>71.81</td><td>N27°52'57\"/&gt; <tr><td>L31</td><td>57.40</td><td>N37°32'38\"/&gt; <tr><td>L32</td><td>7.32</td><td>N62°04'26\"/&gt; </td></tr>
	L3	188.22	S61°56'08\"/> <tr><td>L4</td><td>18.94</td><td>N01°56'08\"/&gt; <tr><td>L5</td><td>48.24</td><td>N28°03'52\"/&gt; <tr><td>L6</td><td>9.53</td><td>N61°56'08\"/&gt; <tr><td>L7</td><td>17.90</td><td>N01°56'08\"/&gt; <tr><td>L8</td><td>16.23</td><td>N61°56'07\"/&gt; <tr><td>L9</td><td>3.18</td><td>S01°56'08\"/&gt; <tr><td>L10</td><td>19.20</td><td>N27°55'09\"/&gt; <tr><td>L11</td><td>30.78</td><td>N27°55'09\"/&gt; <tr><td>L12</td><td>5.90</td><td>S61°56'08\"/&gt; <tr><td>L13</td><td>6.08</td><td>S61°33'51\"/&gt; <tr><td>L14</td><td>14.28</td><td>N58°03'52\"/&gt; <tr><td>L15</td><td>14.25</td><td>S61°54'25\"/&gt; <tr><td>L16</td><td>21.73</td><td>N27°54'49\"/&gt; <tr><td>L17</td><td>5.66</td><td>N27°54'49\"/&gt; <tr><td>L18</td><td>1.38</td><td>N27°54'49\"/&gt; <tr><td>L19</td><td>21.54</td><td>N58°03'52\"/&gt; <tr><td>L20</td><td>2.99</td><td>N61°57'57\"/&gt; <tr><td>L21</td><td>18.47</td><td>S58°35'2\"/&gt; <tr><td>L22</td><td>13.67</td><td>S61°56'08\"/&gt; <tr><td>L23</td><td>15.99</td><td>N58°03'52\"/&gt; <tr><td>L24</td><td>16.65</td><td>S28°03'52\"/&gt; <tr><td>L25</td><td>7.59</td><td>N61°56'08\"/&gt; <tr><td>L26</td><td>17.30</td><td>N58°03'52\"/&gt; <tr><td>L27</td><td>131.25</td><td>S61°56'08\"/&gt; <tr><td>L28</td><td>19.64</td><td>N61°53'37\"/&gt; <tr><td>L29</td><td>36.21</td><td>N13°25'07\"/&gt; <tr><td>L30</td><td>71.81</td><td>N27°52'57\"/&gt; <tr><td>L31</td><td>57.40</td><td>N37°32'38\"/&gt; <tr><td>L32</td><td>7.32</td><td>N62°04'26\"/&gt; </td></tr>	L21	18.47	S58°35'2\"/> <tr><td>L22</td><td>13.67</td><td>S61°56'08\"/&gt; <tr><td>L23</td><td>15.99</td><td>N58°03'52\"/&gt; <tr><td>L24</td><td>16.65</td><td>S28°03'52\"/&gt; <tr><td>L25</td><td>7.59</td><td>N61°56'08\"/&gt; <tr><td>L26</td><td>17.30</td><td>N58°03'52\"/&gt; <tr><td>L27</td><td>131.25</td><td>S61°56'08\"/&gt; <tr><td>L28</td><td>19.64</td><td>N61°53'37\"/&gt; <tr><td>L29</td><td>36.21</td><td>N13°25'07\"/&gt; <tr><td>L30</td><td>71.81</td><td>N27°52'57\"/&gt; <tr><td>L31</td><td>57.40</td><td>N37°32'38\"/&gt; <tr><td>L32</td><td>7.32</td><td>N62°04'26\"/&gt; </td></tr>
<tr><td>L21</td><td>18.47</td><td>S58°35'2\"/&gt; <tr><td>L22</td><td>13.67</td><td>S61°56'08\"/&gt; <tr><td>L23</td><td>15.99</td><td>N58°03'52\"/&gt; <tr><td>L24</td><td>16.65</td><td>S28°03'52\"/&gt; <tr><td>L25</td><td>7.59</td><td>N61°56'08\"/&gt; <tr><td>L26</td><td>17.30</td><td>N58°03'52\"/&gt; <tr><td>L27</td><td>131.25</td><td>S61°56'08\"/&gt; <tr><td>L28</td><td>19.64</td><td>N61°53'37\"/&gt; <tr><td>L29</td><td>36.21</td><td>N13°25'07\"/&gt; <tr><td>L30</td><td>71.81</td><td>N27°52'57\"/&gt; <tr><td>L31</td><td>57.40</td><td>N37°32'38\"/&gt; <tr><td>L32</td><td>7.32</td><td>N62°04'26\"/&gt; </td></tr>
	L14	14.28	N58°03'52\"/> <tr><td>L15</td><td>14.25</td><td>S61°54'25\"/&gt; <tr><td>L16</td><td>21.73</td><td>N27°54'49\"/&gt; <tr><td>L17</td><td>5.66</td><td>N27°54'49\"/&gt; <tr><td>L18</td><td>1.38</td><td>N27°54'49\"/&gt; <tr><td>L19</td><td>21.54</td><td>N58°03'52\"/&gt; <tr><td>L20</td><td>2.99</td><td>N61°57'57\"/&gt; <tr><td>L21</td><td>18.47</td><td>S58°35'2\"/&gt; <tr><td>L22</td><td>13.67</td><td>S61°56'08\"/&gt; <tr><td>L23</td><td>15.99</td><td>N58°03'52\"/&gt; <tr><td>L24</td><td>16.65</td><td>S28°03'52\"/&gt; <tr><td>L25</td><td>7.59</td><td>N61°56'08\"/&gt; <tr><td>L26</td><td>17.30</td><td>N58°03'52\"/&gt; <tr><td>L27</td><td>131.25</td><td>S61°56'08\"/&gt; <tr><td>L28</td><td>19.64</td><td>N61°53'37\"/&gt; <tr><td>L29</td><td>36.21</td><td>N13°25'07\"/&gt; <tr><td>L30</td><td>71.81</td><td>N27°52'57\"/&gt; <tr><td>L31</td><td>57.40</td><td>N37°32'38\"/&gt; <tr><td>L32</td><td>7.32</td><td>N62°04'26\"/&gt; </td></tr>
67</td><td>S61°56'08\"/&gt; <tr><td>L23</td><td>15.99</td><td>N58°03'52\"/&gt; <tr><td>L24</td><td>16.65</td><td>S28°03'52\"/&gt; <tr><td>L25</td><td>7.59</td><td>N61°56'08\"/&gt; <tr><td>L26</td><td>17.30</td><td>N58°03'52\"/&gt; <tr><td>L27</td><td>131.25</td><td>S61°56'08\"/&gt; <tr><td>L28</td><td>19.64</td><td>N61°53'37\"/&gt; <tr><td>L29</td><td>36.21</td><td>N13°25'07\"/&gt; <tr><td>L30</td><td>71.81</td><td>N27°52'57\"/&gt; <tr><td>L31</td><td>57.40</td><td>N37°32'38\"/&gt; <tr><td>L32</td><td>7.32</td><td>N62°04'26\"/&gt; </td></tr>
</td></tr></td></tr></td></tr>	L15	14.25	S61°54'25\"/> <tr><td>L16</td><td>21.73</td><td>N27°54'49\"/&gt; <tr><td>L17</td><td>5.66</td><td>N27°54'49\"/&gt; <tr><td>L18</td><td>1.38</td><td>N27°54'49\"/&gt; <tr><td>L19</td><td>21.54</td><td>N58°03'52\"/&gt; <tr><td>L20</td><td>2.99</td><td>N61°57'57\"/&gt; <tr><td>L21</td><td>18.47</td><td>S58°35'2\"/&gt; <tr><td>L22</td><td>13.67</td><td>S61°56'08\"/&gt; <tr><td>L23</td><td>15.99</td><td>N58°03'52\"/&gt; <tr><td>L24</td><td>16.65</td><td>S28°03'52\"/&gt; <tr><td>L25</td><td>7.59</td><td>N61°56'08\"/&gt; <tr><td>L26</td><td>17.30</td><td>N58°03'52\"/&gt; <tr><td>L27</td><td>131.25</td><td>S61°56'08\"/&gt; <tr><td>L28</td><td>19.64</td><td>N61°53'37\"/&gt; <tr><td>L29</td><td>36.21</td><td>N13°25'07\"/&gt; <tr><td>L30</td><td>71.81</td><td>N27°52'57\"/&gt; <tr><td>L31</td><td>57.40</td><td>N37°32'38\"/&gt; <tr><td>L32</td><td>7.32</td><td>N62°04'26\"/&gt; </td></tr>
<tr><td>L26</td><td>17.30</td><td>N58°03'52\"/&gt; <tr><td>L27</td><td>131.25</td><td>S61°56'08\"/&gt; <tr><td>L28</td><td>19.64</td><td>N61°53'37\"/&gt; <tr><td>L29</td><td>36.21</td><td>N13°25'07\"/&gt; <tr><td>L30</td><td>71.81</td><td>N27°52'57\"/&gt; <tr><td>L31</td><td>57.40</td><td>N37°32'38\"/&gt; <tr><td>L32</td><td>7.32</td><td>N62°04'26\"/&gt; </td></tr>
<tr><td>L27</td><td>131.25</td><td>S61°56'08\"/&gt; <tr><td>L28</td><td>19.64</td><td>N61°53'37\"/&gt; <tr><td>L29</td><td>36.21</td><td>N13°25'07\"/&gt; <tr><td>L30</td><td>71.81</td><td>N27°52'57\"/&gt; <tr><td>L31</td><td>57.40</td><td>N37°32'38\"/&gt; <tr><td>L32</td><td>7.32</td><td>N62°04'26\"/&gt; </td></tr>

<tr><td>L28</td><td>19.64</td><td>N61°53'37\"/&gt; <tr><td>L29</td><td>36.21</td><td>N13°25'07\"/&gt; <tr><td>L30</td><td>71.81</td><td>N27°52'57\"/&gt; <tr><td>L31</td><td>57.40</td><td>N37°32'38\"/&gt; <tr><td>L32</td><td>7.32</td><td>N62°04'26\"/&gt; </td></tr><tr><td>L29</td><td>36.21</td><td>N13°25'07\"/&gt; <tr><td>L30</td><td>71.81</td><td>N27°52'57\"/&gt; <tr><td>L31</td><td>57.40</td><td>N37°32'38\"/&gt; <tr><td>L32</td><td>7.32</td><td>N62°04'26\"/&gt; </td></tr>

<tr><td>L26</td><td>17.30</td><td>N58°03'52\"/&gt; <tr><td>L27</td><td>131.25</td><td>S61°56'08\"/&gt; <tr><td>L28</td><td>19.64</td><td>N61°53'37\"/&gt; <tr><td>L29</td><td>36.21</td><td>N13°25'07\"/&gt; <tr><td>L30</td><td>71.81</td><td>N27°52'57\"/&gt; <tr><td>L31</td><td>57.40</td><td>N37°32'38\"/&gt; <tr><td>L32</td><td>7.32</td><td>N62°04'26\"/&gt; </td></tr>

	L20	2.99	N61°57'57\"/> <tr><td>L21</td><td>18.47</td><td>S58°35'2\"/&gt; <tr><td>L22</td><td>13.67</td><td>S61°56'08\"/&gt; <tr><td>L23</td><td>15.99</td><td>N58°03'52\"/&gt; <tr><td>L24</td><td>16.65</td><td>S28°03'52\"/&gt; <tr><td>L25</td><td>7.59</td><td>N61°56'08\"/&gt; <tr><td>L26</td><td>17.30</td><td>N58°03'52\"/&gt; <tr><td>L27</td><td>131.25</td><td>S61°56'08\"/&gt; <tr><td>L28</td><td>19.64</td><td>N61°53'37\"/&gt; <tr><td>L29</td><td>36.21</td><td>N13°25'07\"/&gt; <tr><td>L30</td><td>71.81</td><td>N27°52'57\"/&gt; <tr><td>L31</td><td>57.40</td><td>N37°32'38\"/&gt; <tr><td>L32</td><td>7.32</td><td>N62°04'26\"/&gt; </td></tr>

	L22	13.67	S61°56'08\"/> <tr><td>L23</td><td>15.99</td><td>N58°03'52\"/&gt; <tr><td>L24</td><td>16.65</td><td>S28°03'52\"/&gt; <tr><td>L25</td><td>7.59</td><td>N61°56'08\"/&gt; <tr><td>L26</td><td>17.30</td><td>N58°03'52\"/&gt; <tr><td>L27</td><td>131.25</td><td>S61°56'08\"/&gt; <tr><td>L28</td><td>19.64</td><td>N61°53'37\"/&gt; <tr><td>L29</td><td>36.21</td><td>N13°25'07\"/&gt; <tr><td>L30</td><td>71.81</td><td>N27°52'57\"/&gt; <tr><td>L31</td><td>57.40</td><td>N37°32'38\"/&gt; <tr><td>L32</td><td>7.32</td><td>N62°04'26\"/&gt; </td></tr>



	L28	19.64	N61°53'37\"/> <tr><td>L29</td><td>36.21</td><td>N13°25'07\"/&gt; <tr><td>L30</td><td>71.81</td><td>N27°52'57\"/&gt; <tr><td>L31</td><td>57.40</td><td>N37°32'38\"/&gt; <tr><td>L32</td><td>7.32</td><td>N62°04'26\"/&gt; </td></tr>






**CURVE TABLE**

CURVE	LENGTH	RADIUS	TANGENT	DELTA	
C1	3.10	3.00	1.70	59°56'54\"/> <tr><td>C2</td><td>4.69</td><td>2.50</td><td>3.40</td><td>107°24'01\"/&gt; <tr><td>C3</td><td>19.94</td><td>20.50</td><td>10.84</td><td>55°34'31\"/&gt; <tr><td>C4</td><td>7.75</td><td>20.50</td><td>3.93</td><td>21°40'48\"/&gt; <tr><td>C5</td><td>32.20</td><td>20.50</td><td>20.50</td><td>90°00'00\"/&gt; <tr><td>C6</td><td>2.62</td><td>2.50</td><td>1.44</td><td>59°59'59\"/&gt; <tr><td>C7</td><td>5.24</td><td>2.50</td><td>4.34</td><td>120°05'05\"/&gt; <tr><td>C8</td><td>3.95</td><td>3.50</td><td>2.52</td><td>30°34'12\"/&gt; <tr><td>C9</td><td>1.85</td><td>3.50</td><td>0.95</td><td>30°21'52\"/&gt; <tr><td>C10</td><td>5.11</td><td>2.50</td><td>4.09</td><td>117°05'04\"/&gt; <tr><td>C11</td><td>7.16</td><td>7.80</td><td>3.85</td><td>52°33'41\"/&gt; <tr><td>C12</td><td>1.32</td><td>2.50</td><td>0.67</td><td>30°09'04\"/&gt; <tr><td>C13</td><td>2.52</td><td>2.50</td><td>1.39</td><td>57°45'31\"/&gt; <tr><td>C14</td><td>5.20</td><td>2.50</td><td>4.27</td><td>119°15'12\"/&gt; <tr><td>C15</td><td>4.16</td><td>2.50</td><td>2.74</td><td>95°17'55\"/&gt; <tr><td>C16</td><td>16.39</td><td>24.94</td><td>8.51</td><td>37°39'24\"/&gt; <tr><td>C17</td><td>4.10</td><td>2.50</td><td>0.56</td><td>25°19'25\"/&gt; <tr><td>C18</td><td>14.91</td><td>48.46</td><td>7.51</td><td>17°37'26\"/&gt; <tr><td>C19</td><td>2.06</td><td>2.50</td><td>1.09</td><td>47°12'09\"/&gt; <tr><td>C20</td><td>5.24</td><td>2.50</td><td>4.33</td><td>120°00'00\"/&gt; <tr><td>C21</td><td>4.97</td><td>25.00</td><td>2.50</td><td>11°24'02\"/&gt; <tr><td>C22</td><td>4.80</td><td>25.05</td><td>2.41</td><td>10°58'14\"/&gt; <tr><td>C23</td><td>3.44</td><td>25.00</td><td>1.73</td><td>7°52'22\"/&gt; <tr><td>C24</td><td>3.42</td><td>25.00</td><td>1.71</td><td>7°50'22\"/&gt; <tr><td>C25</td><td>0.74</td><td>2.50</td><td>0.37</td><td>17°24'11\"/&gt; <tr><td>C26</td><td>7.05</td><td>4.30</td><td>4.62</td><td>94°13'55\"/&gt; </td></tr>	C9	1.85	3.50	0.95	30°21'52\"/> <tr><td>C10</td><td>5.11</td><td>2.50</td><td>4.09</td><td>117°05'04\"/&gt; <tr><td>C11</td><td>7.16</td><td>7.80</td><td>3.85</td><td>52°33'41\"/&gt; <tr><td>C12</td><td>1.32</td><td>2.50</td><td>0.67</td><td>30°09'04\"/&gt; <tr><td>C13</td><td>2.52</td><td>2.50</td><td>1.39</td><td>57°45'31\"/&gt; <tr><td>C14</td><td>5.20</td><td>2.50</td><td>4.27</td><td>119°15'12\"/&gt; <tr><td>C15</td><td>4.16</td><td>2.50</td><td>2.74</td><td>95°17'55\"/&gt; <tr><td>C16</td><td>16.39</td><td>24.94</td><td>8.51</td><td>37°39'24\"/&gt; <tr><td>C17</td><td>4.10</td><td>2.50</td><td>0.56</td><td>25°19'25\"/&gt; <tr><td>C18</td><td>14.91</td><td>48.46</td><td>7.51</td><td>17°37'26\"/&gt; <tr><td>C19</td><td>2.06</td><td>2.50</td><td>1.09</td><td>47°12'09\"/&gt; <tr><td>C20</td><td>5.24</td><td>2.50</td><td>4.33</td><td>120°00'00\"/&gt; <tr><td>C21</td><td>4.97</td><td>25.00</td><td>2.50</td><td>11°24'02\"/&gt; <tr><td>C22</td><td>4.80</td><td>25.05</td><td>2.41</td><td>10°58'14\"/&gt; <tr><td>C23</td><td>3.44</td><td>25.00</td><td>1.73</td><td>7°52'22\"/&gt; <tr><td>C24</td><td>3.42</td><td>25.00</td><td>1.71</td><td>7°50'22\"/&gt; <tr><td>C25</td><td>0.74</td><td>2.50</td><td>0.37</td><td>17°24'11\"/&gt; <tr><td>C26</td><td>7.05</td><td>4.30</td><td>4.62</td><td>94°13'55\"/&gt; </td></tr>
73</td><td>7°52'22\"/&gt; <tr><td>C24</td><td>3.42</td><td>25.00</td><td>1.71</td><td>7°50'22\"/&gt; <tr><td>C25</td><td>0.74</td><td>2.50</td><td>0.37</td><td>17°24'11\"/&gt; <tr><td>C26</td><td>7.05</td><td>4.30</td><td>4.62</td><td>94°13'55\"/&gt; </td></tr>
</td></tr></td></tr>	C6	2.62	2.50	1.44	59°59'59\"/> <tr><td>C7</td><td>5.24</td><td>2.50</td><td>4.34</td><td>120°05'05\"/&gt; <tr><td>C8</td><td>3.95</td><td>3.50</td><td>2.52</td><td>30°34'12\"/&gt; <tr><td>C9</td><td>1.85</td><td>3.50</td><td>0.95</td><td>30°21'52\"/&gt; <tr><td>C10</td><td>5.11</td><td>2.50</td><td>4.09</td><td>117°05'04\"/&gt; <tr><td>C11</td><td>7.16</td><td>7.80</td><td>3.85</td><td>52°33'41\"/&gt; <tr><td>C12</td><td>1.32</td><td>2.50</td><td>0.67</td><td>30°09'04\"/&gt; <tr><td>C13</td><td>2.52</td><td>2.50</td><td>1.39</td><td>57°45'31\"/&gt; <tr><td>C14</td><td>5.20</td><td>2.50</td><td>4.27</td><td>119°15'12\"/&gt; <tr><td>C15</td><td>4.16</td><td>2.50</td><td>2.74</td><td>95°17'55\"/&gt; <tr><td>C16</td><td>16.39</td><td>24.94</td><td>8.51</td><td>37°39'24\"/&gt; <tr><td>C17</td><td>4.10</td><td>2.50</td><td>0.56</td><td>25°19'25\"/&gt; <tr><td>C18</td><td>14.91</td><td>48.46</td><td>7.51</td><td>17°37'26\"/&gt; <tr><td>C19</td><td>2.06</td><td>2.50</td><td>1.09</td><td>47°12'09\"/&gt; <tr><td>C20</td><td>5.24</td><td>2.50</td><td>4.33</td><td>120°00'00\"/&gt; <tr><td>C21</td><td>4.97</td><td>25.00</td><td>2.50</td><td>11°24'02\"/&gt; <tr><td>C22</td><td>4.80</td><td>25.05</td><td>2.41</td><td>10°58'14\"/&gt; <tr><td>C23</td><td>3.44</td><td>25.00</td><td>1.73</td><td>7°52'22\"/&gt; <tr><td>C24</td><td>3.42</td><td>25.00</td><td>1.71</td><td>7°50'22\"/&gt; <tr><td>C25</td><td>0.74</td><td>2.50</td><td>0.37</td><td>17°24'11\"/&gt; <tr><td>C26</td><td>7.05</td><td>4.30</td><td>4.62</td><td>94°13'55\"/&gt; </td></tr>
<tr><td>C15</td><td>4.16</td><td>2.50</td><td>2.74</td><td>95°17'55\"/&gt; <tr><td>C16</td><td>16.39</td><td>24.94</td><td>8.51</td><td>37°39'24\"/&gt; <tr><td>C17</td><td>4.10</td><td>2.50</td><td>0.56</td><td>25°19'25\"/&gt; <tr><td>C18</td><td>14.91</td><td>48.46</td><td>7.51</td><td>17°37'26\"/&gt; <tr><td>C19</td><td>2.06</td><td>2.50</td><td>1.09</td><td>47°12'09\"/&gt; <tr><td>C20</td><td>5.24</td><td>2.50</td><td>4.33</td><td>120°00'00\"/&gt; <tr><td>C21</td><td>4.97</td><td>25.00</td><td>2.50</td><td>11°24'02\"/&gt; <tr><td>C22</td><td>4.80</td><td>25.05</td><td>2.41</td><td>10°58'14\"/&gt; <tr><td>C23</td><td>3.44</td><td>25.00</td><td>1.73</td><td>7°52'22\"/&gt; <tr><td>C24</td><td>3.42</td><td>25.00</td><td>1.71</td><td>7°50'22\"/&gt; <tr><td>C25</td><td>0.74</td><td>2.50</td><td>0.37</td><td>17°24'11\"/&gt; <tr><td>C26</td><td>7.05</td><td>4.30</td><td>4.62</td><td>94°13'55\"/&gt; </td></tr>
	C8	3.95	3.50	2.52	30°34'12\"/> <tr><td>C9</td><td>1.85</td><td>3.50</td><td>0.95</td><td>30°21'52\"/&gt; <tr><td>C10</td><td>5.11</td><td>2.50</td><td>4.09</td><td>117°05'04\"/&gt; <tr><td>C11</td><td>7.16</td><td>7.80</td><td>3.85</td><td>52°33'41\"/&gt; <tr><td>C12</td><td>1.32</td><td>2.50</td><td>0.67</td><td>30°09'04\"/&gt; <tr><td>C13</td><td>2.52</td><td>2.50</td><td>1.39</td><td>57°45'31\"/&gt; <tr><td>C14</td><td>5.20</td><td>2.50</td><td>4.27</td><td>119°15'12\"/&gt; <tr><td>C15</td><td>4.16</td><td>2.50</td><td>2.74</td><td>95°17'55\"/&gt; <tr><td>C16</td><td>16.39</td><td>24.94</td><td>8.51</td><td>37°39'24\"/&gt; <tr><td>C17</td><td>4.10</td><td>2.50</td><td>0.56</td><td>25°19'25\"/&gt; <tr><td>C18</td><td>14.91</td><td>48.46</td><td>7.51</td><td>17°37'26\"/&gt; <tr><td>C19</td><td>2.06</td><td>2.50</td><td>1.09</td><td>47°12'09\"/&gt; <tr><td>C20</td><td>5.24</td><td>2.50</td><td>4.33</td><td>120°00'00\"/&gt; <tr><td>C21</td><td>4.97</td><td>25.00</td><td>2.50</td><td>11°24'02\"/&gt; <tr><td>C22</td><td>4.80</td><td>25.05</td><td>2.41</td><td>10°58'14\"/&gt; <tr><td>C23</td><td>3.44</td><td>25.00</td><td>1.73</td><td>7°52'22\"/&gt; <tr><td>C24</td><td>3.42</td><td>25.00</td><td>1.71</td><td>7°50'22\"/&gt; <tr><td>C25</td><td>0.74</td><td>2.50</td><td>0.37</td><td>17°24'11\"/&gt; <tr><td>C26</td><td>7.05</td><td>4.30</td><td>4.62</td><td>94°13'55\"/&gt; </td></tr>
42</td><td>25.00</td><td>1.71</td><td>7°50'22\"/&gt; <tr><td>C25</td><td>0.74</td><td>2.50</td><td>0.37</td><td>17°24'11\"/&gt; <tr><td>C26</td><td>7.05</td><td>4.30</td><td>4.62</td><td>94°13'55\"/&gt; </td></tr>
	C16	16.39	24.94	8.51	37°39'24\"/> <tr><td>C17</td><td>4.10</td><td>2.50</td><td>0.56</td><td>25°19'25\"/&gt; <tr><td>C18</td><td>14.91</td><td>48.46</td><td>7.51</td><td>17°37'26\"/&gt; <tr><td>C19</td><td>2.06</td><td>2.50</td><td>1.09</td><td>47°12'09\"/&gt; <tr><td>C20</td><td>5.24</td><td>2.50</td><td>4.33</td><td>120°00'00\"/&gt; <tr><td>C21</td><td>4.97</td><td>25.00</td><td>2.50</td><td>11°24'02\"/&gt; <tr><td>C22</td><td>4.80</td><td>25.05</td><td>2.41</td><td>10°58'14\"/&gt; <tr><td>C23</td><td>3.44</td><td>25.00</td><td>1.73</td><td>7°52'22\"/&gt; <tr><td>C24</td><td>3.42</td><td>25.00</td><td>1.71</td><td>7°50'22\"/&gt; <tr><td>C25</td><td>0.74</td><td>2.50</td><td>0.37</td><td>17°24'11\"/&gt; <tr><td>C26</td><td>7.05</td><td>4.30</td><td>4.62</td><td>94°13'55\"/&gt; </td></tr>

	C11	7.16	7.80	3.85	52°33'41\"/> <tr><td>C12</td><td>1.32</td><td>2.50</td><td>0.67</td><td>30°09'04\"/&gt; <tr><td>C13</td><td>2.52</td><td>2.50</td><td>1.39</td><td>57°45'31\"/&gt; <tr><td>C14</td><td>5.20</td><td>2.50</td><td>4.27</td><td>119°15'12\"/&gt; <tr><td>C15</td><td>4.16</td><td>2.50</td><td>2.74</td><td>95°17'55\"/&gt; <tr><td>C16</td><td>16.39</td><td>24.94</td><td>8.51</td><td>37°39'24\"/&gt; <tr><td>C17</td><td>4.10</td><td>2.50</td><td>0.56</td><td>25°19'25\"/&gt; <tr><td>C18</td><td>14.91</td><td>48.46</td><td>7.51</td><td>17°37'26\"/&gt; <tr><td>C19</td><td>2.06</td><td>2.50</td><td>1.09</td><td>47°12'09\"/&gt; <tr><td>C20</td><td>5.24</td><td>2.50</td><td>4.33</td><td>120°00'00\"/&gt; <tr><td>C21</td><td>4.97</td><td>25.00</td><td>2.50</td><td>11°24'02\"/&gt; <tr><td>C22</td><td>4.80</td><td>25.05</td><td>2.41</td><td>10°58'14\"/&gt; <tr><td>C23</td><td>3.44</td><td>25.00</td><td>1.73</td><td>7°52'22\"/&gt; <tr><td>C24</td><td>3.42</td><td>25.00</td><td>1.71</td><td>7°50'22\"/&gt; <tr><td>C25</td><td>0.74</td><td>2.50</td><td>0.37</td><td>17°24'11\"/&gt; <tr><td>C26</td><td>7.05</td><td>4.30</td><td>4.62</td><td>94°13'55\"/&gt; </td></tr>
	C25	0.74	2.50	0.37	17°24'11\"/> <tr><td>C26</td><td>7.05</td><td>4.30</td><td>4.62</td><td>94°13'55\"/&gt; </td></tr>	C26	7.05	4.30	4.62	94°13'55\"/>	


<tr><td>C21</td><td>4.97</td><td>25.00</td><td>2.50</td><td>11°24'02\"/&gt; <tr><td>C22</td><td>4.80</td><td>25.05</td><td>2.41</td><td>10°58'14\"/&gt; <tr><td>C23</td><td>3.44</td><td>25.00</td><td>1.73</td><td>7°52'22\"/&gt; <tr><td>C24</td><td>3.42</td><td>25.00</td><td>1.71</td><td>7°50'22\"/&gt; <tr><td>C25</td><td>0.74</td><td>2.50</td><td>0.37</td><td>17°24'11\"/&gt; <tr><td>C26</td><td>7.05</td><td>4.30</td><td>4.62</td><td>94°13'55\"/&gt; </td></tr>


	C22	4.80	25.05	2.41	10°58'14\"/> <tr><td>C23</td><td>3.44</td><td>25.00</td><td>1.73</td><td>7°52'22\"/&gt; <tr><td>C24</td><td>3.42</td><td>25.00</td><td>1.71</td><td>7°50'22\"/&gt; <tr><td>C25</td><td>0.74</td><td>2.50</td><td>0.37</td><td>17°24'11\"/&gt; <tr><td>C26</td><td>7.05</td><td>4.30</td><td>4.62</td><td>94°13'55\"/&gt; </td></tr>
C17	4.10	2.50	0.56	25°19'25\"/> <tr><td>C18</td><td>14.91</td><td>48.46</td><td>7.51</td><td>17°37'26\"/&gt; <tr><td>C19</td><td>2.06</td><td>2.50</td><td>1.09</td><td>47°12'09\"/&gt; <tr><td>C20</td><td>5.24</td><td>2.50</td><td>4.33</td><td>120°00'00\"/&gt; <tr><td>C21</td><td>4.97</td><td>25.00</td><td>2.50</td><td>11°24'02\"/&gt; <tr><td>C22</td><td>4.80</td><td>25.05</td><td>2.41</td><td>10°58'14\"/&gt; <tr><td>C23</td><td>3.44</td><td>25.00</td><td>1.73</td><td>7°52'22\"/&gt; <tr><td>C24</td><td>3.42</td><td>25.00</td><td>1.71</td><td>7°50'22\"/&gt; <tr><td>C25</td><td>0.74</td><td>2.50</td><td>0.37</td><td>17°24'11\"/&gt; <tr><td>C26</td><td>7.05</td><td>4.30</td><td>4.62</td><td>94°13'55\"/&gt; </td></tr>







THIS SITE IS LOCATED IN FLOOD ZONE "X" AS SHOWN ON FEMA PANEL #32003C2170E DATED SEPT. 27, 2002

HANSEN# 18021

**CITY OF LAS VEGAS**  
 400 EAST STEWART AVENUE  
 LAS VEGAS, NEVADA 89101  
 (702) 259-6535

**CITY OF LAS VEGAS, NEVADA**  
 2777 SOUTH RAINBOW BOULEVARD  
 LAS VEGAS, NEVADA 89146-5148  
 PH. (702) 873-7500 FAX (702) 362-2587 WEB WWW.VNV.COM

**GRADING PLAN FIFTH STREET SCHOOL**

**FIFTH STREET SCHOOL REHABILITATION BUILDING DEPARTMENT SUBMITTAL**

DATE: 8/18/07  
 REVISION: 2/22/07

SCALE: 1"=20' HORIZ. 1"=20' VERT.

PROJECT NO: 5716

SHEET 3 OF 11 SHEETS  
 DRAWING NO. CLV# 513-65E

DESIGNED BY: S.P.A.P.P.A.  
 CHECKED BY: S.P.A.P.P.A.

REGISTERED PROFESSIONAL ENGINEER STATE OF NEVADA  
 DANIEL J. HANSEN  
 LICENSE NO. 12811  
 CIVIL ENGINEER

111560

REPlot