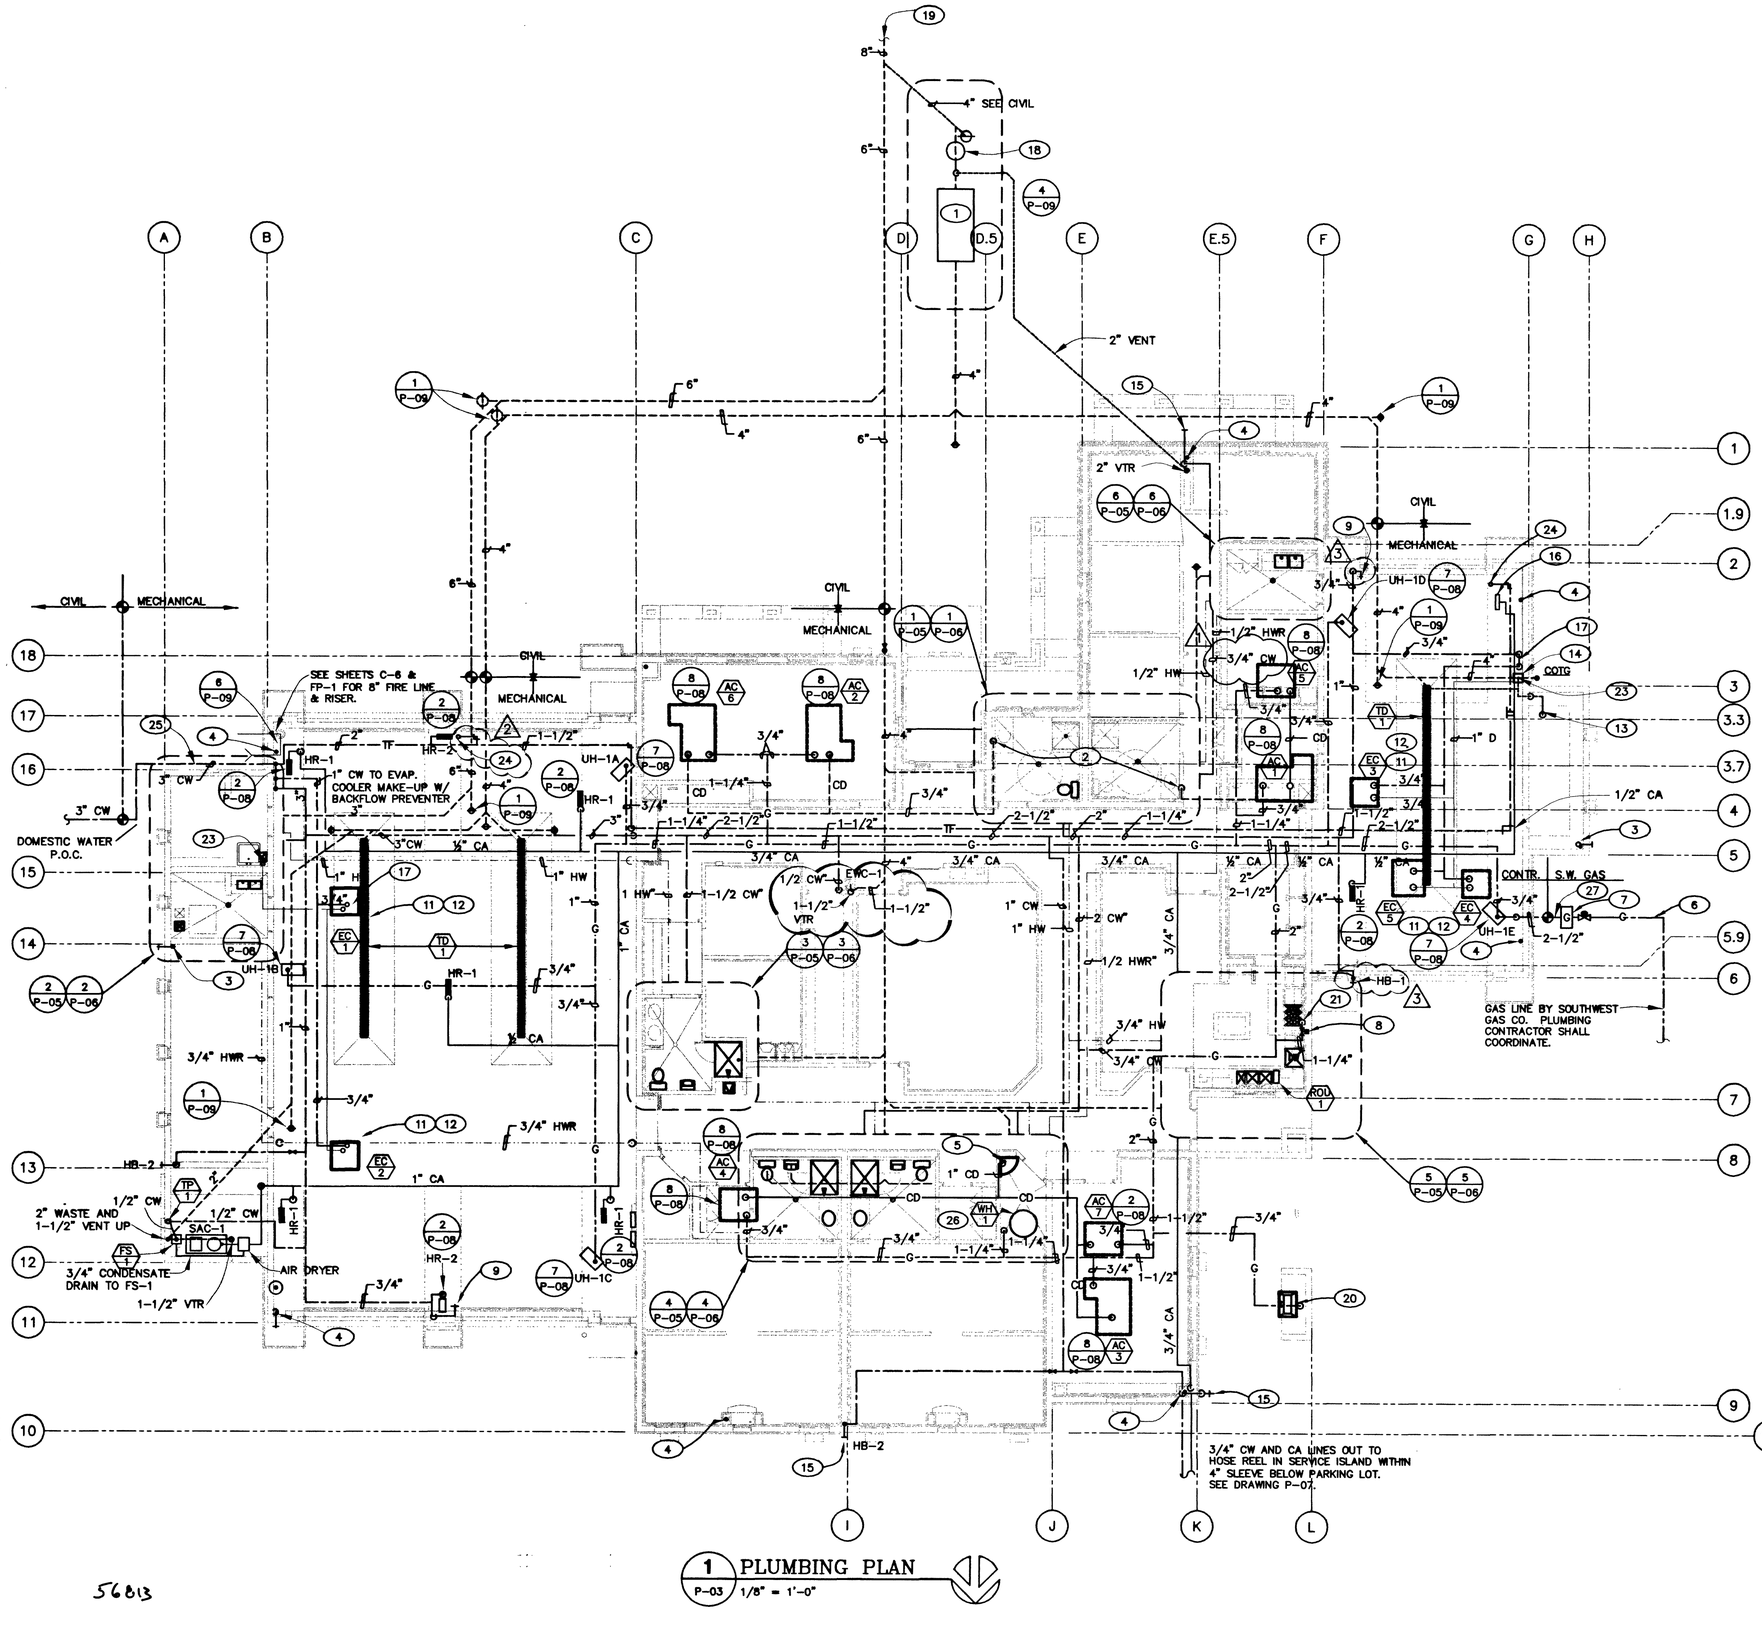

1 PLUMBING PLAN
P-03 1/8" = 1'-0"

KEYED NOTES (THIS SHEET ONLY)

1. JENSEN MODEL 750 EE SAND OIL INTERCEPTOR WITH MODEL 2432-Z SAMPLE BOX SEE CIVIL DRAWINGS FOR EXACT LOCATION.
2. 3/4" CONDENSATE DRAIN TO LAVATORY TAIL PIECE IS UNDER 200'
3. 4" ROOF DRAINS, SEE ARCHITECTURAL DRAWINGS AND DET. 5 ON P-08.
4. 5" ROOF DRAINS SEE ARCHITECTURAL DRAWINGS AND DET. 5 ON P-08.
5. 1" CONDENSATE DRAIN TO SERVICE SINK
6. GAS LINE BY SOUTHWEST GAS CORP. PLUMBING CONTRACTOR TO COORDINATE
7. GAS METER, 1218 CFH.
8. SOLENOID VALVE (SV-1) TO SHUT OFF GAS TO STOVE BY PLUMBING CONTRACTOR TO STOP GAS FLOW WHEN KITCHEN HOOD IS ON FIRE AND WHEN ANSUL FIRE PROTECTION IS ACTIVATED. SEE ELECTRCAL DRAWINGS. VALVE TO HAVE 120V COIL.
9. HB-1
10. HR-3 @ FUEL ISLAND
11. EVAP COOLER ON ROOF BY MECHANICAL CONTRACTOR, PLUMBING CONTRACTOR TO COORDINATE ALL PLUMBING CONNECTIONS.
12. ROUTE 1/2" DCW AND 3/4" DRAINS ON ROOF SEE DET 1/P-08
13. 1-1/2" VENT THRU ROOF
14. FS-1, SEE PLUMBING SCHEDULE.
15. HOSE BIBB 2
16. HOSE REEL 1 (HR-1) FOR COMPRESSED AIR HOSE
17. EVAP COOLER COLD WATER SUPPLY SEE DET 6/P-08 FOR BACK FLOW PREVENTION
18. MANHOLE, SEE CIVIL DRAWINGS
19. SEE CIVIL DRAWINGS FOR CONTINUATION OF SEWER
20. TURBO G5TN BAR-B-QUE SEE 6/A10.1 75MBTUH INPUT
21. WOLF CHR-6-1829-HB RANGE 236MBTUH GAS INPUT
22. NOT USED
23. 1" EVAPORATIVE COOLER DRAIN TO FLOOR SINK.
24. ROUTE 1-1/2" COLD WATER LINE DOWN TO 36" A.F.F. WITH 2-1/2" QUARTER TURN BALL VALVE. USE NPT THREAD STANDARD (MALE).
25. SEE P-04 DET. 4 FOR CW ENTRANCE DETAIL.
26. WATER HEATER, SEE P-04 DET. 7
27. PROVIDE A TRANSITION FROM METER OUTLET TO 2-1/2".

GENERAL NOTES

1. PLUMBING CONTRACTOR TO PROVIDE GAS PRESSURE REGULATOR FOR EACH UNIT HEATER TO MEET GAS MANUFACTURERS RECOMMENDED GAS INLET PRESSURE.

56813

Q:\Projects\2000\0002406 FS#43\Mech\P-03.dwg, 06/14/2003 01:43:03 PM, Administrator

CITY OF LAS VEGAS NEVADA

REVISIONS
2 12/14/01 REVISIONS

CONSULTANT
DEC INC.
2900 So. RANCHO RD.
LAS VEGAS, NEVADA 89102
(702)871-5154

CITY OF LAS VEGAS, NEVADA
FIRE STATION #43

PLUMBING PLAN

DEPARTMENT OF PUBLIC WORKS
ARCHITECTURAL SERVICES
400 EAST STEWART AVENUE
LAS VEGAS, NEVADA 89101
PHONE: (702) 229-6535
FAX: (702) 382-2322
TDD: (702) 386-9108

DESIGN ENGINEERING CONSULTANT

DRAWN MRT
FILE
DATE 6/21/01 6/15/03
SCALE AS SHOWN
PROJECT 0206.00
SHT NO 87 OF 108

P-03

DRAWINGS & INSTRUMENTS OF SERVICE ARE THE PROPERTY OF THE DESIGN PROFESSIONAL WHOSE STAMP OF CERTIFICATION APPEARS ON THE DRAWINGS AND SPECIFICATIONS RESPECTIVELY BY THE COURT MAY BE UTILIZED ONLY FOR ADDITIONS THE PROJECT FOR WHICH THEY WERE PREPARED AND NOT FOR THE COMPLETION OF ANY OTHER PROJECT N.R.S. 623.300 COPIES OF THE DRAWINGS AND SPECIFICATIONS RESPECTIVELY BY THE COURT MAY BE UTILIZED ONLY FOR ADDITIONS THE PROJECT FOR WHICH THEY WERE PREPARED AND NOT FOR THE COMPLETION OF ANY OTHER PROJECT N.

