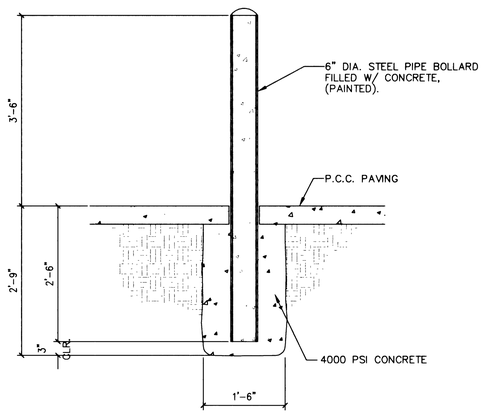

5 Bollard Detail

Scale: 3/4" = 1'-0" 02830-03 AS2-08

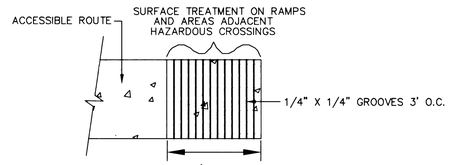

3 Accessible Route (On-Site)

NOT TO SCALE

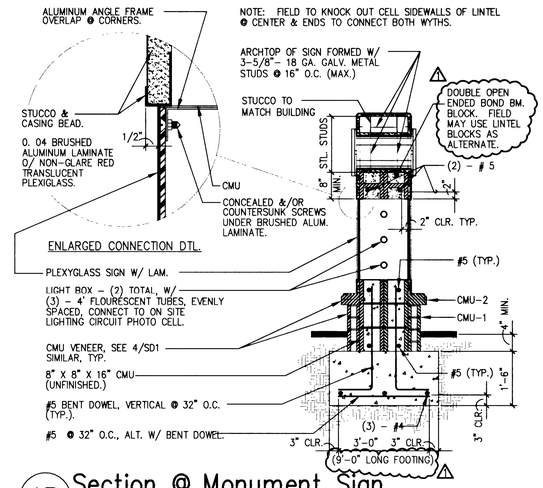

1B Section @ Monument Sign

Scale: 1/2" = 1'-0" XXXX-XX AS2-01B

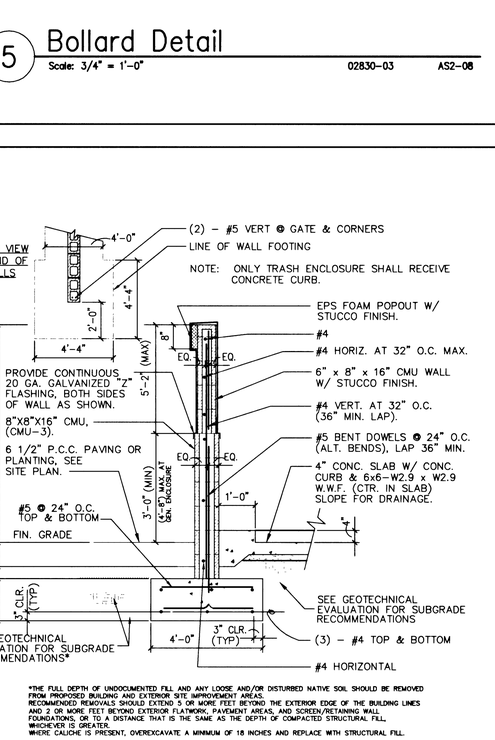

*THE FULL DEPTH OF UNDOCUMENTED FILL AND ANY LOOSE AND/OR DISTURBED NATIVE SOIL SHOULD BE REMOVED FROM PROPOSED BUILDING AND EXTERIOR SITE IMPROVEMENT AREAS. RECOMMENDED REMOVALS SHOULD EXTEND 5 OR MORE FEET BEYOND THE EXTERIOR EDGE OF THE BUILDING LINES AND 2 OR MORE FEET BEYOND EXTERIOR FLATWORK, PAVEMENT AREAS, AND SCREEN/RETAINING WALL FOUNDATIONS, OR TO A DISTANCE THAT IS THE SAME AS THE DEPTH OF COMPACTED STRUCTURAL FILL, WHICHEVER IS GREATER. WHERE CALICHE IS PRESENT, OVEREXCAVATE A MINIMUM OF 18 INCHES AND REPLACE WITH STRUCTURAL FILL.

4 Trash & Generator Enclosure Wall

Scale: 1/2" = 1'-0" 02830-05 AS2-07

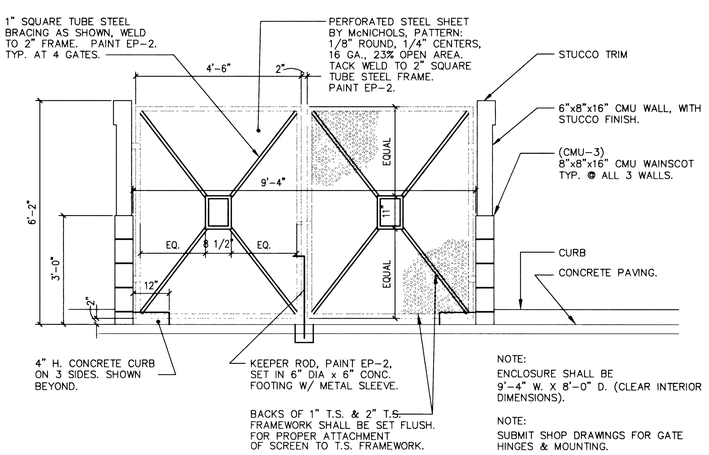

2 Trash Enclosure Gate

Scale: 1/2" = 1'-0" 02830-03 AS2-08

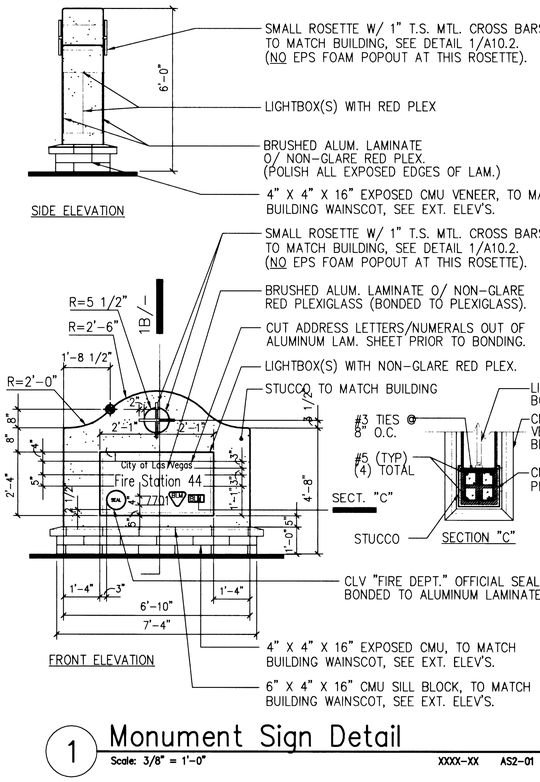

1 Monument Sign Detail

Scale: 3/8" = 1'-0" XXXX-XX AS2-01

REV	DESCRIPTION	BY	DATE	ASSN. APP.	DATE
1	ADD DIMENSION PER BUILDING & SAFTEY		8/10/01		

PROJ NO: AZ01002
DESIGN: RAC/LG
DATE: 09/26/01
SCALE: AS SHOWN
FILE: FS44_12

PROFESSIONAL ENGINEER-STATE OF NEVADA ALLEN E. KAYACAN No. 9029

STAMP DATE: 9-26-01

AZTEC ENGINEERING
3320 N Buffalo Dr., # 106, Las Vegas, NV 89129
Tel (702) 396-3426 Fax(702) 396-3758
Email: aztec@azteceng.com

CITY OF LAS VEGAS
FIRE STATION NO. 44
CONSTRUCTION DETAILS II

SHEET
C-12
12 OF 20 SHEETS

CLV DRAWING NO.
630.97

34837

F:\AZ01002\dwg\fs44_12.dwg, 09/25/01 04:08:23 PM, Lap Grids