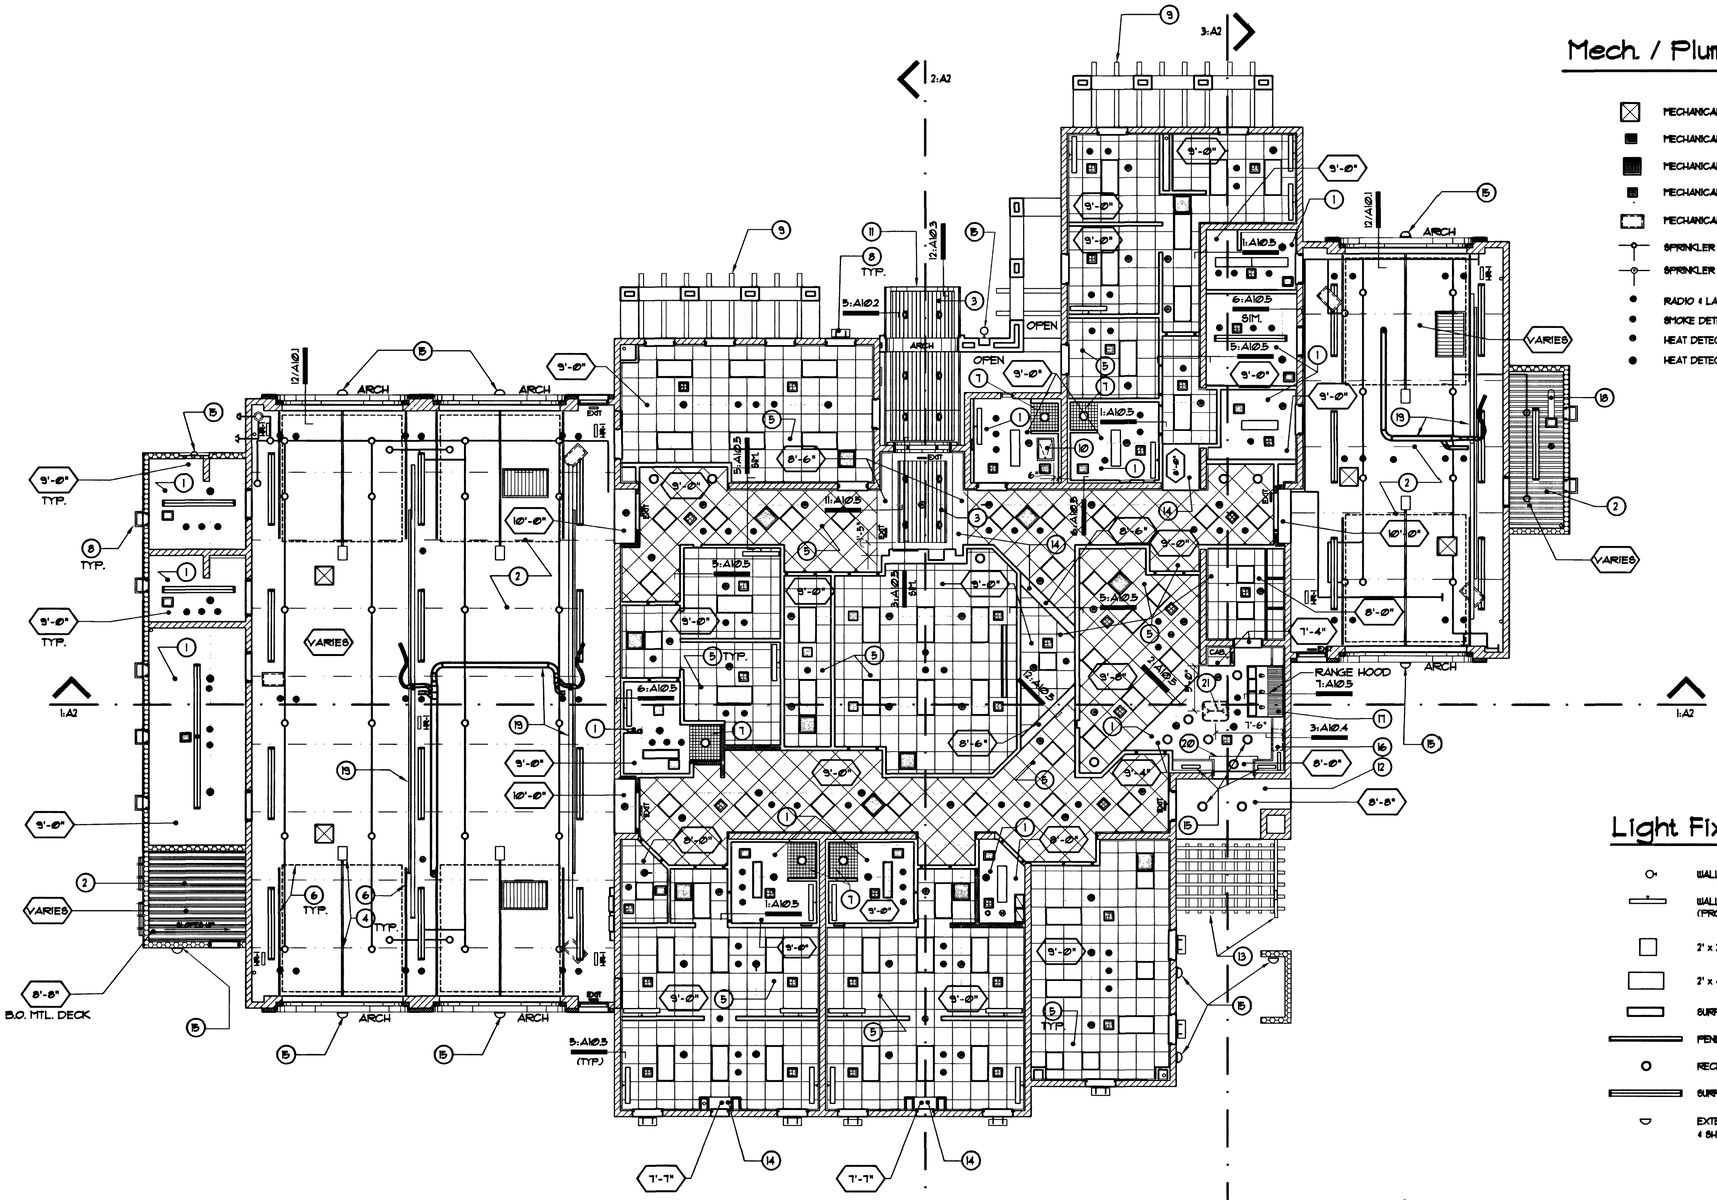

Reflected Ceiling Plan

Scale: 1/8"=1'-0"

Mech. / Plumb. Fixture Legend

- MECHANICAL DUCTWORK THRU CEILING, SEE MECH. DWGS.
- MECHANICAL GRILL, SEE MECHANICAL DRAWINGS.
- MECHANICAL GRILL, SEE MECHANICAL DRAWINGS.
- MECHANICAL GRILL, SEE MECHANICAL DRAWINGS.
- MECHANICAL EQUIPMENT, SEE MECHANICAL DRAWINGS.
- SPRINKLER HEAD & SPRINKLER LINES, SEE FIRE PROTECTION PLAN.
- SPRINKLER HEAD & SPRINKLER LINES, SEE FIRE PROTECTION PLAN.
- RADIO & LANDLINE SYSTEM SPEAKER, SEE SHEET E-4.1.
- SMOKE DETECTOR, SEE ELECTRICAL DRAWINGS, SHEET E-5.1.
- HEAT DETECTOR, SEE ELECTRICAL DRAWINGS, SHEET E-5.1.
- HEAT DETECTOR, SEE ELECTRICAL DRAWINGS, SHEET E-5.1.

Light Fixture Legend

- WALL MOUNTED INCANDESCENT FIXTURE
- WALL MOUNTED UP & DOWN FLUORESCENT FIXTURE (PROVIDE PROPER BLOCKING IN WALLS FOR WALL MOUNTED FIXTURES).
- 2' x 2' FLUORESCENT "PARAMAX" FIXTURE
- 2' x 4' FLUORESCENT "PARAMAX" FIXTURE
- SURFACE MOUNTED FLUORESCENT FIXTURE
- PENDANT MOUNTED "ELLIPTIPAR" FIXTURE
- RECESSED INCANDESCENT DOWN-LIGHT
- SURFACE MOUNTED STRIP FLUORESCENT FIXTURE
- EXTERIOR LIGHT FIXTURE, SEE ELECTRICAL DRAWINGS. & SHT. A4.1, A4.2 FOR MOUNTING HT. OF FIXTURES.

◀ Project North

Keynotes

1. 5/8" TYPE "X" GYP. BD. CEILING, PAINT PER FINISH LEGEND.
2. EXPOSED CEILING TRUSSES AND/ OR METAL ROOF DECK, PAINT TO MATCH WALLS.
3. METAL LINEAR CEILING STRIPS, SEE DETAIL 5/A10.2.
4. OVERHEAD DOOR OPENER AND TRACK (CENTERED ON DOOR OPENINGS, TYP.).
5. 2' X 2' SUSPENDED ACOUSTICAL TILE CEILING, SEE SPECIFICATIONS.
6. LINE OF OVERHEAD DOOR AND OVERHEAD DOOR TRACKS.
7. CERAMIC TILE TO MATCH RESTROOM WALL (USE FIELD COLOR).
8. WINDOW CANOPY, SEE DETAILS KEYED IN ON SHEETS A4.1, A4.2 & A10.2.
9. 6"X18" TRELLIS BEAM, FRAME AS PER DTL. 3/A10.2, STUCCO FINISH. PAINT PER FINISH LEGEND.
10. 22" X 30" CEILING ACCESS PANEL FOR 1 HR. RATED GREASE DUCT.
11. 6"X12" T.S. BEAM, ARCHED TO CANOPY RADIUS, SEE ELEVATIONS. PAINT PER FINISH SCHEDULE.

57 259

Keynotes

12. LIGHT SAND STUCCO FINISH TO MATCH BUILDING, SEE SPECIFICATIONS.
13. TUBE STEEL PATIO CANOPY, SEE DETAIL 2/A10.2 AND STRUCT'L DWGS. PAINT W/ COLOR: (EP-2).
14. 5/8" TYPE "X" GYP. BD. CEILING SOFFIT, PAINT.
15. LIGHT FIXTURE, SEE LIGHT FIXTURE LEGEND - THIS PAGE.
16. MICROWAVE, SEE INTERIOR ELEVATION DETAIL 26/A8.2.
17. RANGE HOOD, SEE MECHANICAL DRAWINGS.
18. EXPOSED DUCTWORK AND DIFFUSER, SEE MECHANICAL DWGS.
19. DIESEL EXHAUST HOSE AND TRACK SYSTEM, SEE MECHANICAL SHEET M-05.
20. 5/8" TYPE "X" GYP. BD. CEILING SOFFIT, SEE INT. ELEVATIONS.
21. HANGING POT RACK @ 6'-8" FROM FINISHED FLOOR.

General Notes:

1. SEE MECHANICAL DRAWINGS AND ARCHITECTURAL REFLECTED CEILING PLAN FOR LOCATIONS OF MAJOR SUPPLY, RETURN, AND EXHAUST GRILLES AS SHOWN ON THE REFLECTED CEILING PLAN. IT IS THE RESPONSIBILITY OF THE CONTRACTOR TO COORDINATE ALL LOCATIONS OF CEILING PENETRATIONS, & OPENINGS TO INCLUDE HVAC SERVICE GRILLES, LIGHT FIXTURES, SPEAKERS, FIRE SPRINKLER HEADS, ETC.
2. WORK ON THIS SHEET SHALL BE DONE IN CONJUNCTION WITH MECHANICAL, ELECTRICAL & ALXILIARY PLANS AND FIRE PROTECTION PLANS.
3. ROOF SCREWS SHALL NOT PENETRATE METAL ROOF DECK BY MORE THAN 1" INTO CEILING SPACE.
4. PROVIDE ACOUSTIC BATT. INSULATION DIRECTLY OVER ALL DORMITORY CEILINGS.
5. GENERAL CONTRACTOR TO WELD MTL. TABS TO BOTTOM OF METAL ROOF DECK FOR ACOUSTICAL CEILING GRID SUPPORT CONNECTION.

CITY OF LAS VEGAS NEVADA

REVISIONS

CONSULTANT

PUBLIC WORKS

CITY OF LAS VEGAS, NEVADA
FIRE STATION #44

Reflected Ceiling Plan

STAMP

OWNER: CITY OF LAS VEGAS
DEPARTMENT OF PUBLIC WORKS
ARCHITECTURAL SERVICES

400 EAST STEWART AVENUE
LAS VEGAS, NEVADA 89101
PHONE: (702) 229-6539
FAX: (702) 382-3232
TDD: (702) 386-9108

DRAWN	EPS
FILE	fs44-A5
DATE	10/29/01
SCALE	1/8" = 1'-0"
BID NO	02.15341.02
CLV DWG NO	630.97
	37 OF 106
SHT NO	A5

RECORD DRAWING
DEPARTMENT OF PUBLIC WORKS

DRAWINGS AS INSTRUMENTS OF SERVICE ARE THE PROPERTY OF THE DESIGN PROFESSIONAL WHOM STAMP OF CERTIFICATION APPEARS ON THE DRAWINGS AND SPECIFICATIONS AND SHALL NOT BE USED BY ANY PERSON OR ENTITY FOR ANY PROJECT OTHER THAN THE SPECIFIED PROJECT WITHOUT THE WRITTEN AUTHORIZATION OF THE DESIGN PROFESSIONAL. SUBMISSION OR DISTRIBUTION OF THE DRAWINGS AND SPECIFICATIONS TO MEET OFFICIAL REGULATORY REQUIREMENTS OR FOR PURPOSES IN CONNECTION WITH THE PROJECT IS NOT TO BE CONSTRUED AS PUBLICATION IN DEROGATION OF THE DESIGN PROFESSIONAL'S COMMON LAW COPYRIGHT OR OTHER RESERVED RIGHTS. REPRODUCTION OF THE DRAWINGS AND SPECIFICATIONS IN WHOLE OR IN PART WITHOUT WRITTEN CONSENT IS STRICTLY PROHIBITED. COPIES OF THE DRAWINGS AND SPECIFICATIONS RETAINED BY THE CLIENT MAY BE UTILIZED ONLY FOR OCCUPYING THE PROJECT FOR WHICH THEY WERE PREPARED AND NOT FOR THE CONSTRUCTION OF ANY OTHER PROJECT W.A.C. 623.700