

ABBREVIATIONS

Table of abbreviations for construction terms, including AC (Asphaltic Concrete Pavement), BS (Back of SideWalk), and others.

CLV GENERAL NOTES

- 1. All construction and materials shall be in accordance with the "Uniform Standard Specifications for Public Works Construction Off-Site Improvements, Clark County Area Nevada..."

LVVWD STANDARD NOTES

LVVWD PROJECT # 25517

- 1. No work shall begin until the water plans have been released for construction by the LVVWD. Following water plan approval, 48 hours notice shall be given to the LVVWD communication support center (258-7171) prior to the start of construction...

CLV FIRE DEPARTMENT NOTES

- 1. All work shall be done in strict accordance with the City of Las Vegas Fire Department's Ordinance No. 5115, "Hydrant Specifications", and "Hydrant Installation Specification".

CLV TRAFFIC NOTES

- 1. All construction signing, barricading, and traffic delineation shall conform to the "Nevada Work Zone Traffic Control Handbook", Latest Edition, and to the "Manual on Uniform Traffic Control Devices", Latest Edition.

DEVIATIONS FROM STANDARDS

DEVIATION FROM THE USD NO. 222a. THE DRIVEWAY RADIUS (STA 23+34.06, 35 RT) HAS BEEN MINIMIZED TO 15 FEET DUE TO EGRESS ONLY DESIGN.

LEGEND

Legend table defining symbols for various features: 10+00 CONTROL LINE, CENTERLINE, EASEMENT LINE, etc.

QUANTITIES

Table of quantities for construction items, including REMOVE EXISTING AC PAVEMENT, 4" AC PAVEMENT, CONCRETE PAVEMENT, etc.

CLV GRADING NOTES

- 1. In the event that any unforeseen conditions not covered by these notes are encountered during grading operations, the Owner/Engineer shall be immediately notified for direction.

CLV SEWER NOTES

- 1. All construction and materials shall be in accordance with the latest edition of the Design and Construction Standards for Wastewater Collection Systems and the Uniform Standard Specifications for Public Works Construction Off-Site Improvements, Clark County Area, Nevada, as amended.

CLV STREETLIGHT NOTES

- 1. All street lighting installations shall be in accordance with the street lighting plans, the "Uniform Standard Specifications for Public Works Construction Off-Site Improvements, Clark County Area, Nevada", Latest Revision, and the "Uniform Standard Drawings for Public Works Construction Off-Site Improvements, Clark County Area, Nevada", Latest Revision.

BENCHMARK

CITY OF LAS VEGAS STATION: 0LV00 28SEE6, BEING A RIVET & PLATE, NEVADA POWER VAULT #TTT-639, 7651 SUMMERLIN PARKWAY ELEV. 2489.56 FEET NAVD88

BASIS OF BEARING


S 88°57'35" W BEING THE NORTH LINE OF THE SOUTHEAST QUARTER (SE 1/4) OF SECTION 28, TOWNSHIP 20 SOUTH, RANGE 60 EAST, M.D.M., CITY OF LAS VEGAS, NEVADA, AS PER RECORD OF SURVEY FILE 74, PAGE 28 OF CLARK COUNTY OFFICIAL RECORDS. SAID LINE ALSO BEING THE CENTERLINE OF WASHINGTON AVENUE.

RECORD DRAWINGS AS-BUILT INFORMATION WAS PROVIDED BY THE CONTRACTOR. AZTEC ASSUMES NO LIABILITY FOR ACCURACY OF ITS CONTENTS.



Revision table with columns for REV, DESCRIPTION, DATE, and AS-BUILT DRAWINGS.

PROJ NO: AZ01002, DESIGN: RAC/LG, DATE: 04/22/03, SCALE: AS SHOWN, FILE: FS44_02

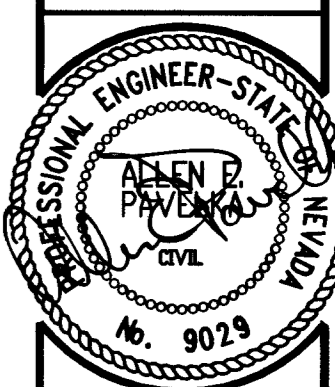

STAMP DATE: 4-22-03

AZTEC ENGINEERING, 3320 N. Buffalo Dr., # 100, Las Vegas, NV 89129, Tel (702) 396-3426 Fax(702) 396-3758, Email: aztec@azteceing.com

CITY OF LAS VEGAS FIRE STATION NO. 44, GENERAL NOTES & QUANTITIES

SHEET C-2, 2 OF 20 SHEETS, CLV DRAWING NO. 630.97