




REVISIONS

3	6/24/02 REVISIONS
2	12/14/01 REVISIONS

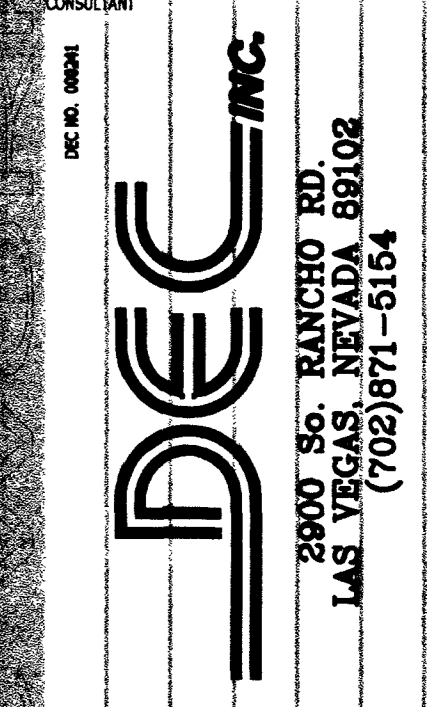

CITY OF LAS VEGAS, NEVADA
FIRE STATION #44
ROOF HVAC PLAN


DEPARTMENT OF PUBLIC WORKS
ARCHITECTURAL SERVICES
400 EAST STEWART AVENUE
LAS VEGAS, NEVADA 89101
PHONE: (702) 229-8333
FAX: (702) 392-8232
TDD: (702) 399-9108

DEKIN ENGINEERING CONSULTANT

DATE	7/15/01
SCALE	AS SHOWN
PROJECT	630.97
SHEET NO.	77 OF 106
	M-03

SHEET NOTES: (THIS SHEET ONLY)

- 1 6" FLUE FROM WATER HEATER WH-1.
- 2 4" FLUE FROM UNIT HEATER UH-1A THRU 1E.
- 3 NOT USED.
- 4 ROOF CAP (EXHAUST) GREENHECK MODEL GRS-12.
- 5 COMBUSTION AIR LOUVER, QTY 2, 12" x 8" WITH BIRD AND INSECT SCREEN. SEE M-02 FOR CONTINUATION. CONTRACTOR SHALL PROVIDE OPENING THROUGH PARAPET WALL.

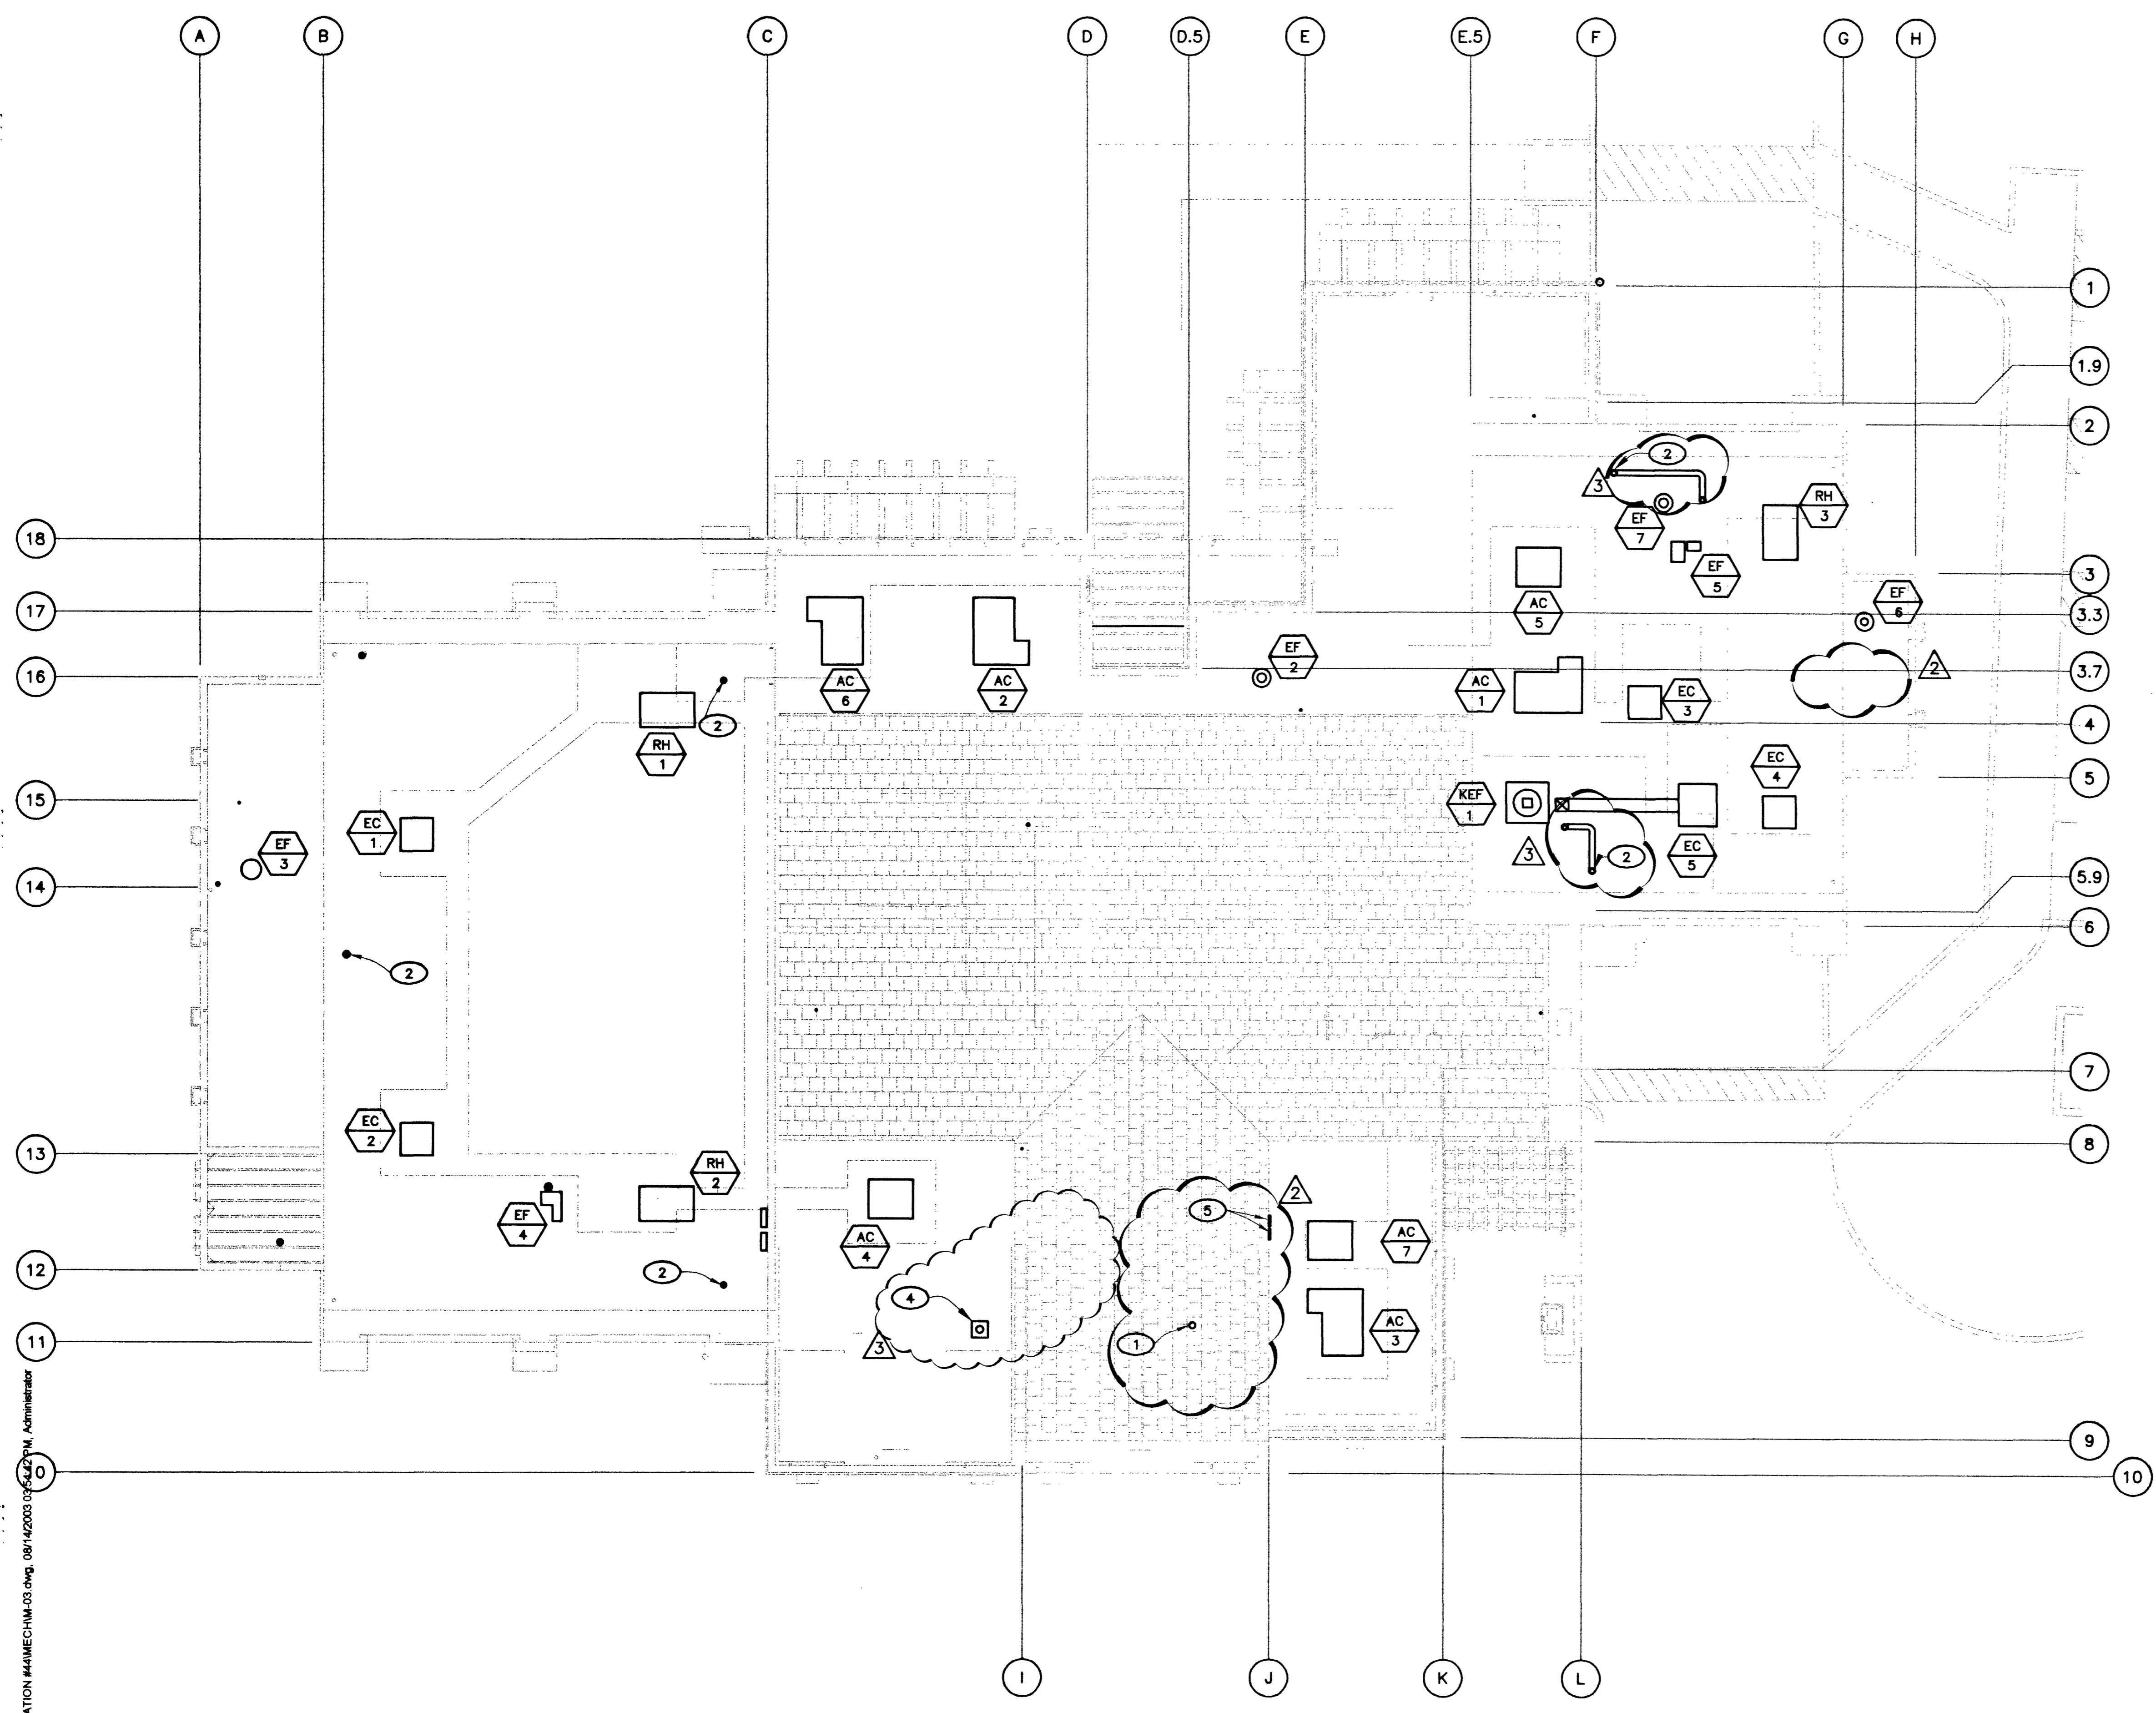

1 ROOF HVAC PLAN
M-03 1/8" = 1'-0"

57299

Q:\Projects\0000000241 FIRE STATION #44\MECH\1-M-03.dwg, 08/14/2003 09:54:21 AM, Administrator

