RECORD DRAWINGS
AS-BUILT INFORMATION WAS PROVIDED BY THE CONTRACTOR. AZTEC ASSUMES NO LIABILITY FOR ACCURACY OF IT'S CONTENTS.

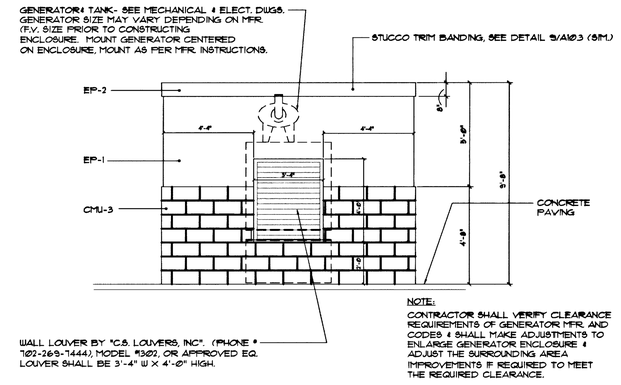

NOTE:
CONTRACTOR SHALL VERIFY CLEARANCE REQUIREMENTS OF GENERATOR MFR. AND CODES & SHALL MAKE ADJUSTMENTS TO ENLARGE GENERATOR ENCLOSURE & ADJUST THE SURROUNDING AREA IMPROVEMENTS IF REQUIRED TO MEET THE REQUIRED CLEARANCE.

8B Generator Enclosure - East Elevation

Scale: N.T.S. XXXX-XX A52-11

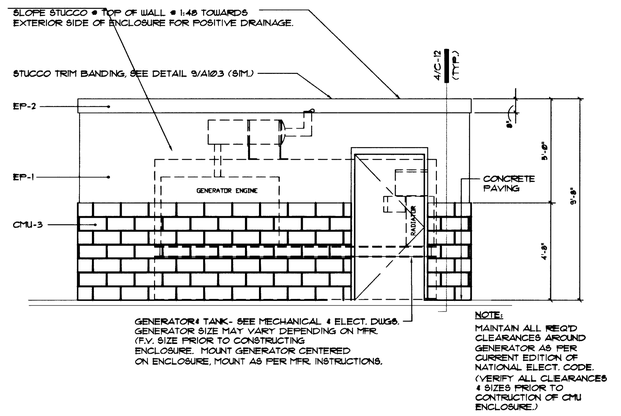

NOTE:
MAINTAIN ALL REQ'D CLEARANCES AROUND GENERATOR AS PER CURRENT EDITION OF NATIONAL ELECT. CODE. (VERIFY ALL CLEARANCES & SIZES PRIOR TO CONTRUCTION OF CMU ENCLOSURE.)

8A Generator Enclosure - South Elevation

Scale: N.T.S. XXXX-XX A52-11

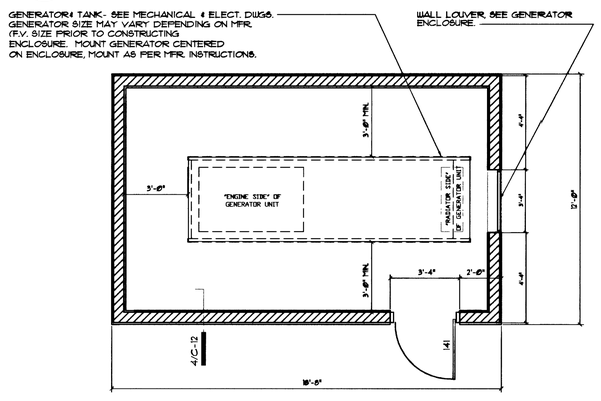

8 Generator Enclosure - Plan View

Scale: N.T.S. XXXX-XX A52-11

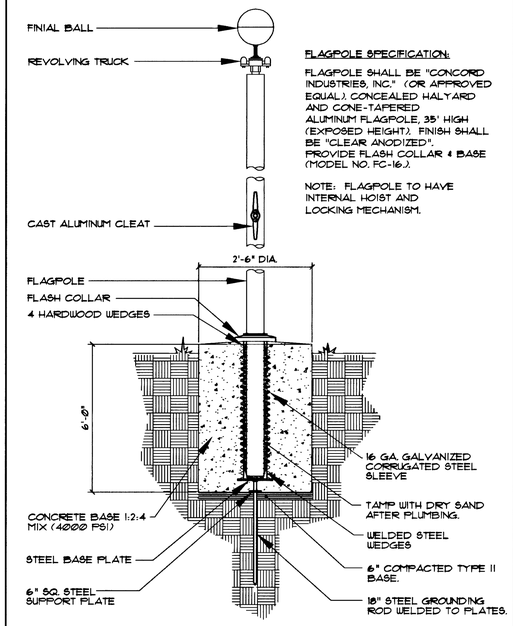

FLAGPOLE SPECIFICATION:

FLAGPOLE SHALL BE "CONCORD INDUSTRIES, INC." (OR APPROVED EQUAL). CONCEALED HALYARD AND CONE-TAPERED ALUMINUM FLAGPOLE, 35' HIGH (EXPOSED HEIGHT). FINISH SHALL BE "CLEAR ANODIZED". PROVIDE FLASH COLLAR & BASE (MODEL NO. FC-16.).

NOTE: FLAGPOLE TO HAVE INTERNAL HOIST AND LOCKING MECHANISM.

7 Flagpole Base Detail

Scale: N.T.S. 10350-01 A52-10

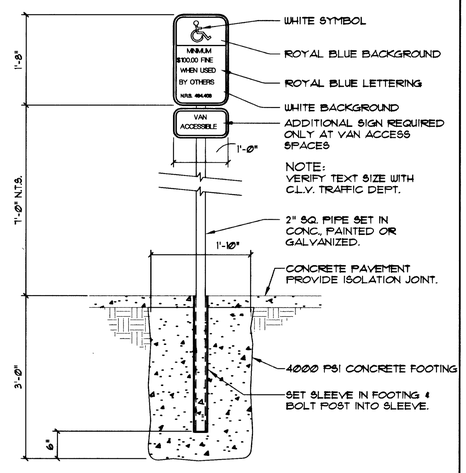

NOTE:
VERIFY TEXT SIZE WITH C.L.V. TRAFFIC DEPT.

6 Handicap Accessibility Sign

Scale: 3/4" = 1'-0" 10426-01 A52-09

REV.	DESCRIPTION	BY	DATE	AGEN. APP.	DATE

04-22-03 AS-BUILT DRAWINGS

PROJ NO:	AZ01002
DESIGN:	RAC/LG
DATE:	04/22/03
SCALE:	AS SHOWN
FILE:	FS44_13

STAMP DATE: 4-22-03

AZTEC ENGINEERING
3320 N Buffalo Dr. # 106, Las Vegas, NV 89129
Tel (702) 396-3426 Fax(702) 396-3758
Email: aztec@aztecengineering.com

CITY OF LAS VEGAS
FIRE STATION NO. 44

CONSTRUCTION DETAILS III

SHEET
C-13
13 OF 20 SHEETS

CLV DRAWING NO.
630.97

57238