This document, including the ideas and designs it contains, is an instrument of professional services rendered by the Architect / Engineer. This document may not be used or copied in whole, or in part, for any purpose other than this specific project without the expressed written consent of Westar Architectural Group, Inc.

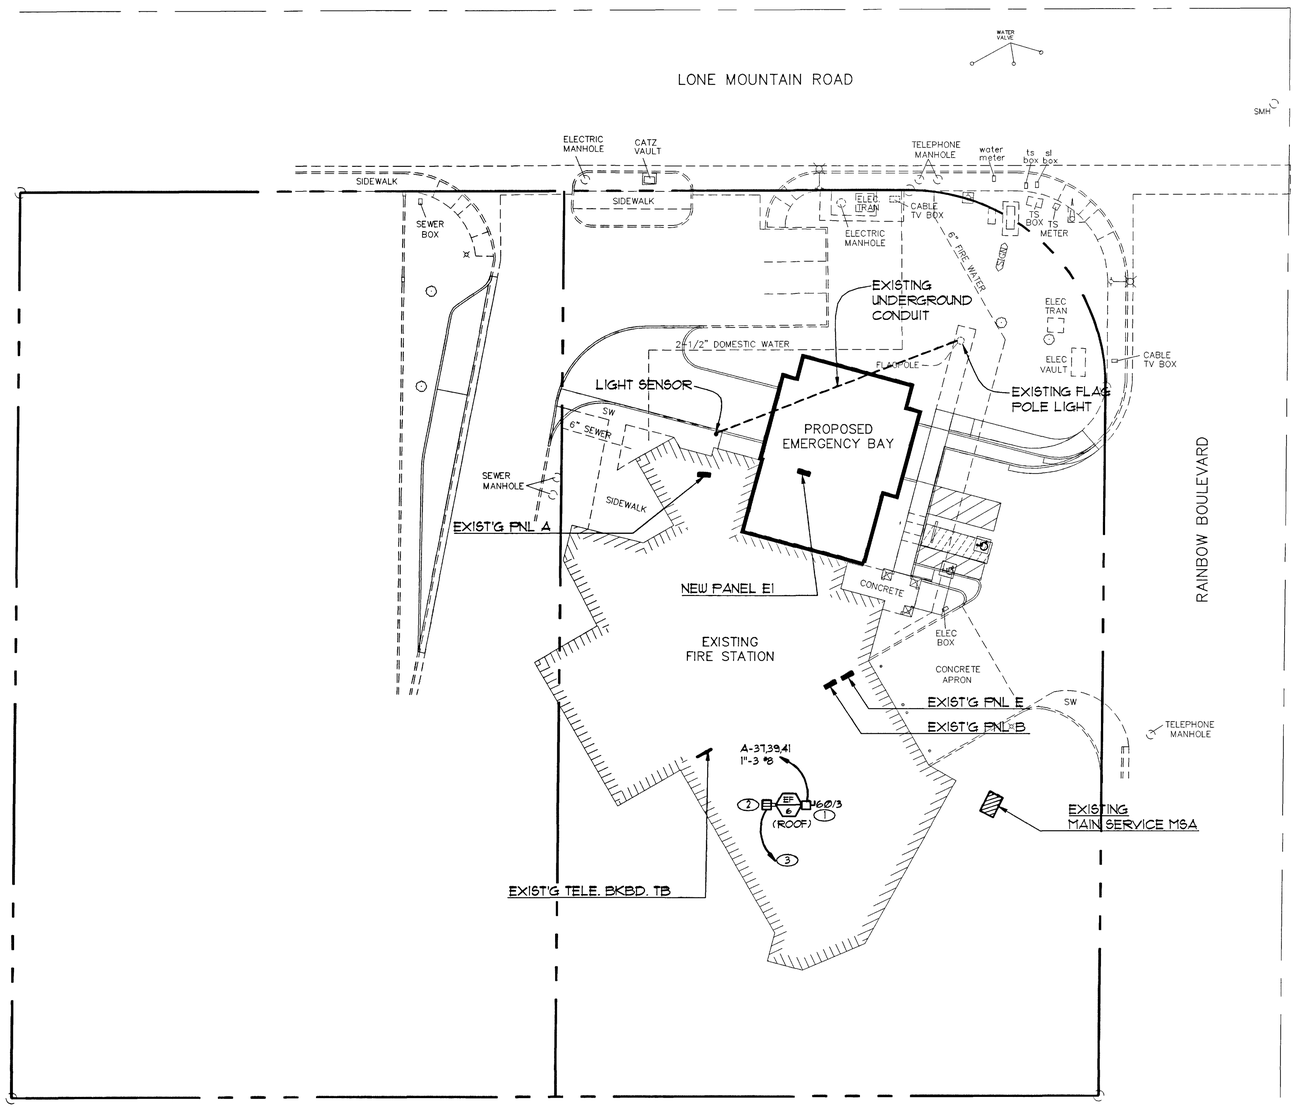

NORTH

ELECTRICAL SITE PLAN F.S. #9

1"=20'-0"

E5.9

ABF CONSULTING ENGINEERS

Las Vegas, Nevada 89103
Tel:(702)248-0338
Sparks, Nevada 89431
Tel:(775)674-2222
Phoenix, Arizona 85014
Tel:(602)274-1801

THE ENGINEER ACCEPTS NO LIABILITY FOR RESPONSIBILITY FOR THESE DOCUMENTS UNLESS HIS ORIGINAL SEAL AND SIGNATURE IS AFFIXED. COPYRIGHT PROTECTED

NOTES

1. PROVIDE UP COMBINATION FUSED DISCONNECT SWITCH WITH FUSES SIZED PER HVAC EQUIPMENT MANUFACTURER'S RECOMMENDATION. SIZE '1' STARTER, ON-OFF SWITCH, 120V CONTROL XFMR, AMBIENT COMP OVERLOADS, AUXILIARY CONTACTS AND OVERLOADS. VERIFY WITH MECHANICAL PRIOR TO INSTALLATION.
2. PROVIDE UP GFI DUPLEX MAINTENANCE RECEPTACLE ON ROOF.
3. CIRCUIT DOWN TO NEAREST 120V. RECEPTACLE CIRCUIT WITH SPARE AMPACITY.

RECORD DRAWINGS

AS BUILT INFORMATION WAS PROVIDED BY THE CONTRACTOR. WESTAR ARCHITECTURAL ASSUMES NO LIABILITY FOR ACCURACY OF ITS CONTENTS.

08/07/03

6.30.99

58602

65

#01-082

SEAL

W★E★S★T★A★R
ARCHITECTURAL GROUP, / NEVADA INC.
LAS VEGAS ★ PHOENIX
ARCHITECTURE ★ PLANNING ★ PROJECT MANAGEMENT
3900 MEADOWS LANE SUITE 220 LAS VEGAS, NEVADA 89107
TELEPHONE: (702) 878-0000 FAX: (702) 878-8430
WESTAR

A FACILITY IMPROVEMENT FOR,

FIRE STATION 2,7, & 9

LAS VEGAS, NEVADA

NUMBER	REVISION DESCRIPTION	DATE

PROJECT NUMBER	DRAWN BY	CHECKED BY
0903	NLB	QQQ
ISSUE DATE	SCALE	
08-13-01	1"=20'-0"	

SHEET NUMBER

ES.9