
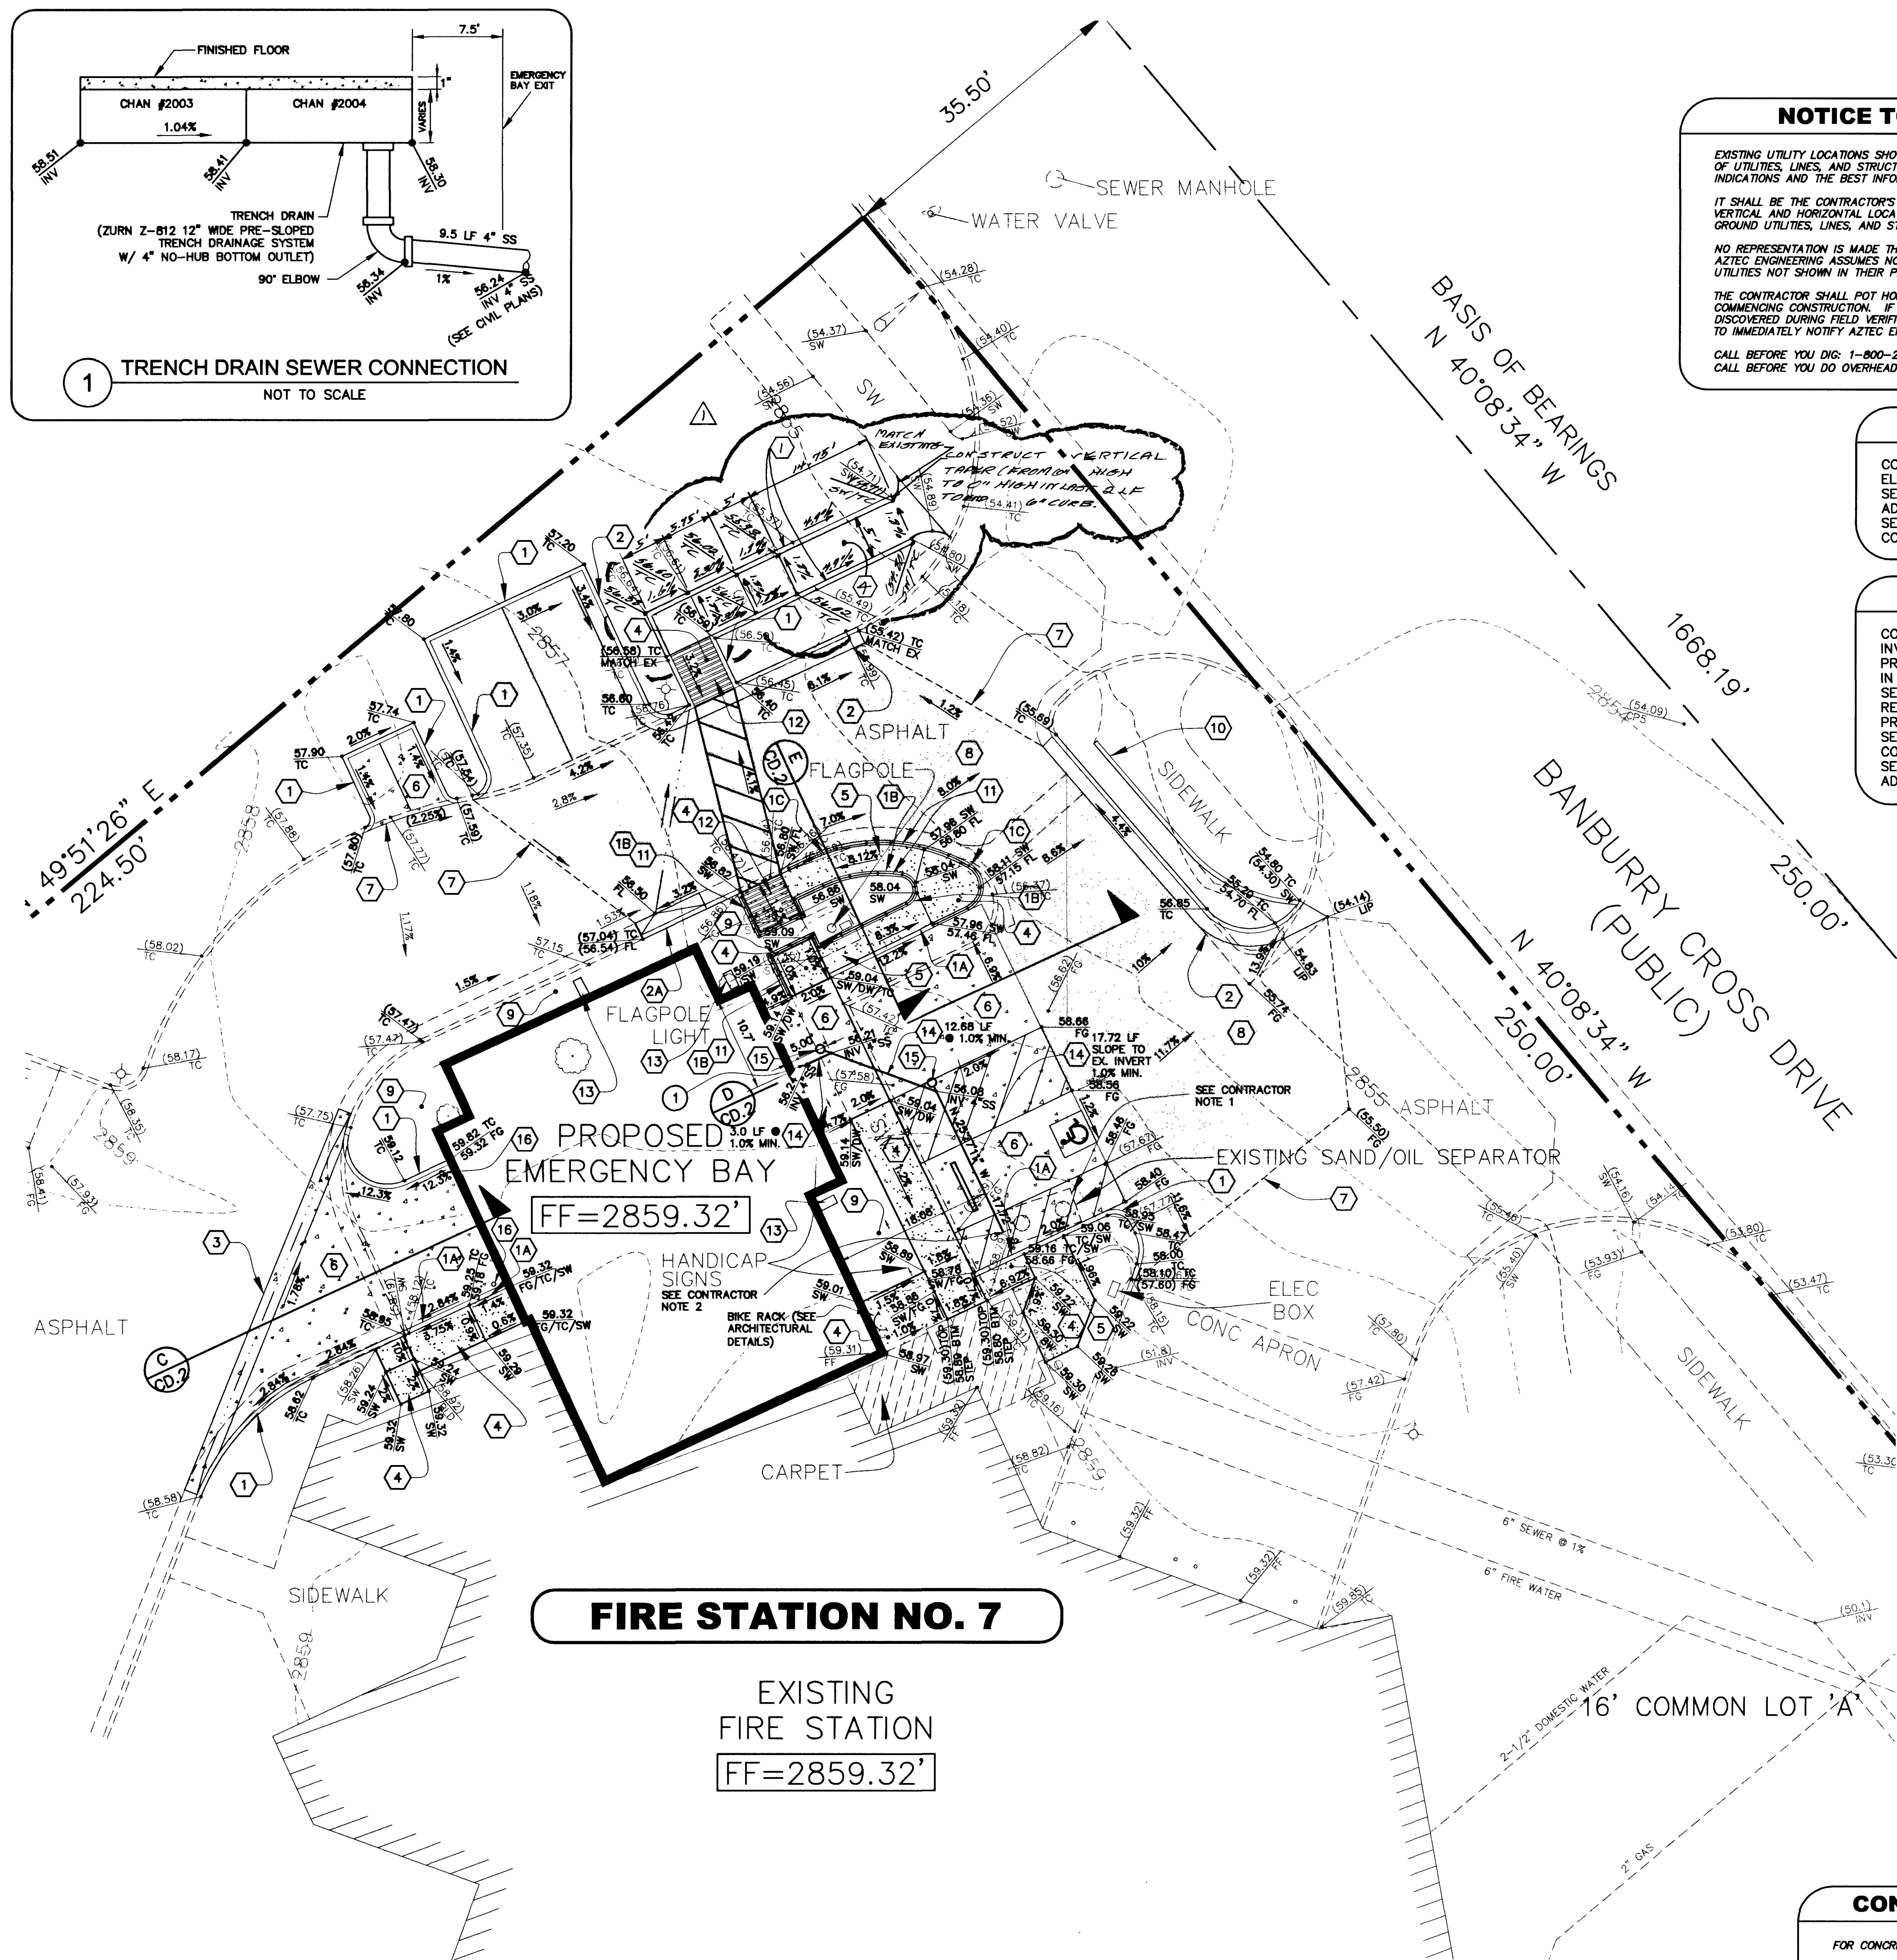


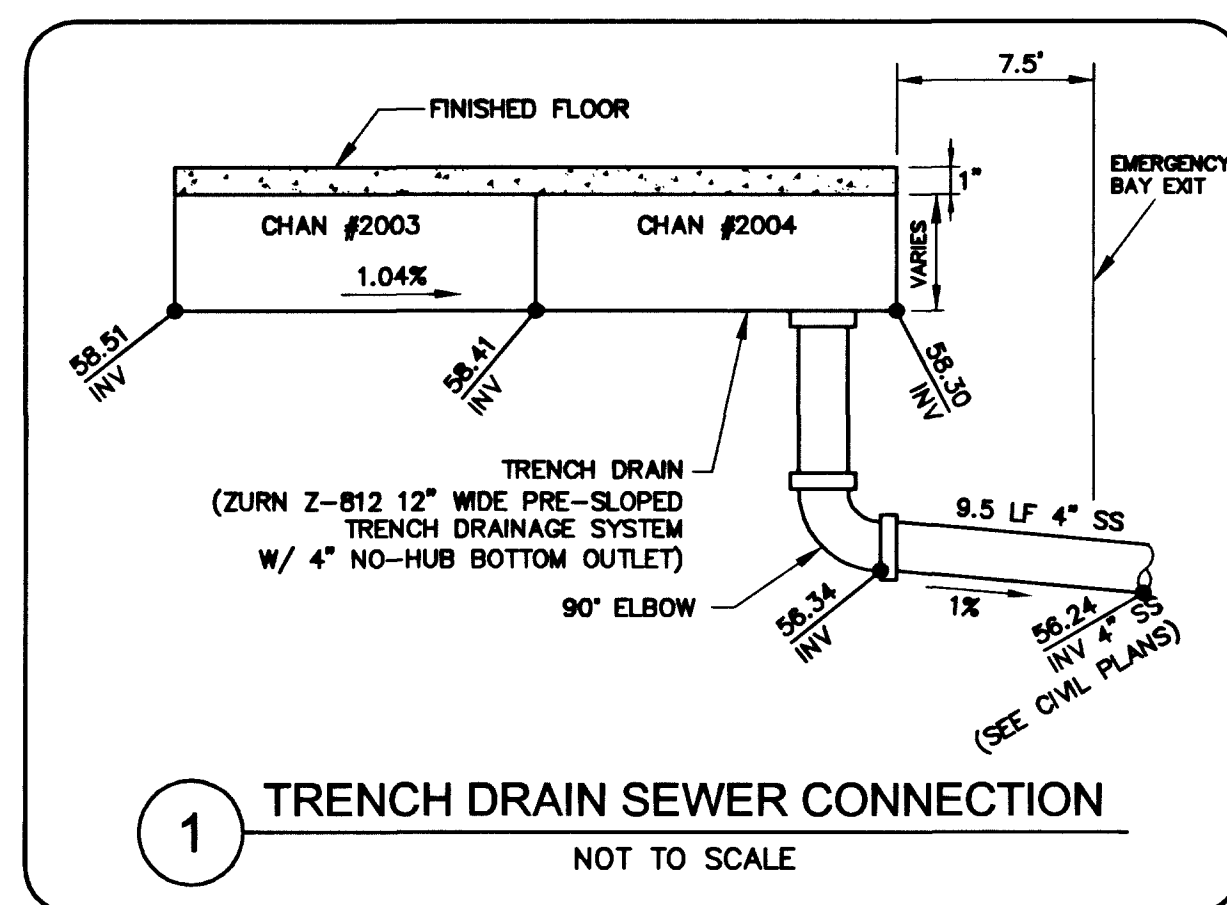

NOTICE TO CONTRACTORS

EXISTING UTILITY LOCATIONS SHOWN HEREON ARE APPROXIMATE ONLY. LOCATIONS OF UTILITIES, LINES, AND STRUCTURES HAVE BEEN DETERMINED BY SURFACE INDICATIONS AND THE BEST INFORMATION AVAILABLE FROM UTILITY COMPANIES.

IT SHALL BE THE CONTRACTOR'S RESPONSIBILITY TO DETERMINE THE EXACT VERTICAL AND HORIZONTAL LOCATION OF ALL EXISTING UNDERGROUND AND ABOVE GROUND UTILITIES, LINES, AND STRUCTURES PRIOR TO COMMENCING CONSTRUCTION.

NO REPRESENTATION IS MADE THAT ALL EXISTING UTILITIES ARE SHOWN HEREON. AZTEC ENGINEERING ASSUMES NO RESPONSIBILITY FOR UTILITIES NOT SHOWN, UTILITIES NOT SHOWN IN THEIR PROPER LOCATIONS, AND UTILITIES NOT OF RECORD.

THE CONTRACTOR SHALL POT HOLE AND FIELD VERIFY ALL UTILITIES PRIOR TO COMMENCING CONSTRUCTION. IF DISCREPANCIES IN UTILITY LOCATIONS ARE DISCOVERED DURING FIELD VERIFICATION, IT IS THE CONTRACTOR'S RESPONSIBILITY TO IMMEDIATELY NOTIFY AZTEC ENGINEERING.


CALL BEFORE YOU DIG: 1-800-227-2600
CALL BEFORE YOU DO OVERHEAD: (702) 593-6111

CONTRACTOR NOTE 1


CONTRACTOR TO VERIFY LOCATION AND ELEVATION OF EXISTING SAND/OIL SEPARATOR AND MAKE ALL NECESSARY ADJUSTMENTS TO EXISTING SAND/OIL SEPARATOR AS REQUIRED DURING CONSTRUCTION.

CONTRACTOR NOTE 2

CONTRACTOR TO VERIFY LOCATION AND INVERT ELEVATION OF EXISTING SEWER LINE PRIOR TO CONSTRUCTION. IF DISCREPANCY IN LOCATION OR ELEVATION OF EXISTING SEWER IS DISCOVERED, CONTRACTOR IS REQUIRED TO CONTACT AZTEC ENGINEERING PRIOR TO INSTALLATION OF 4\"/>

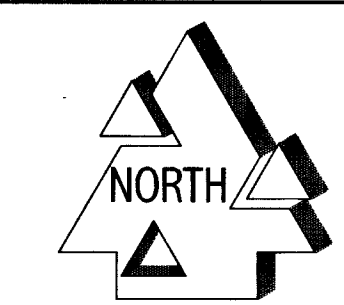

1\"/>

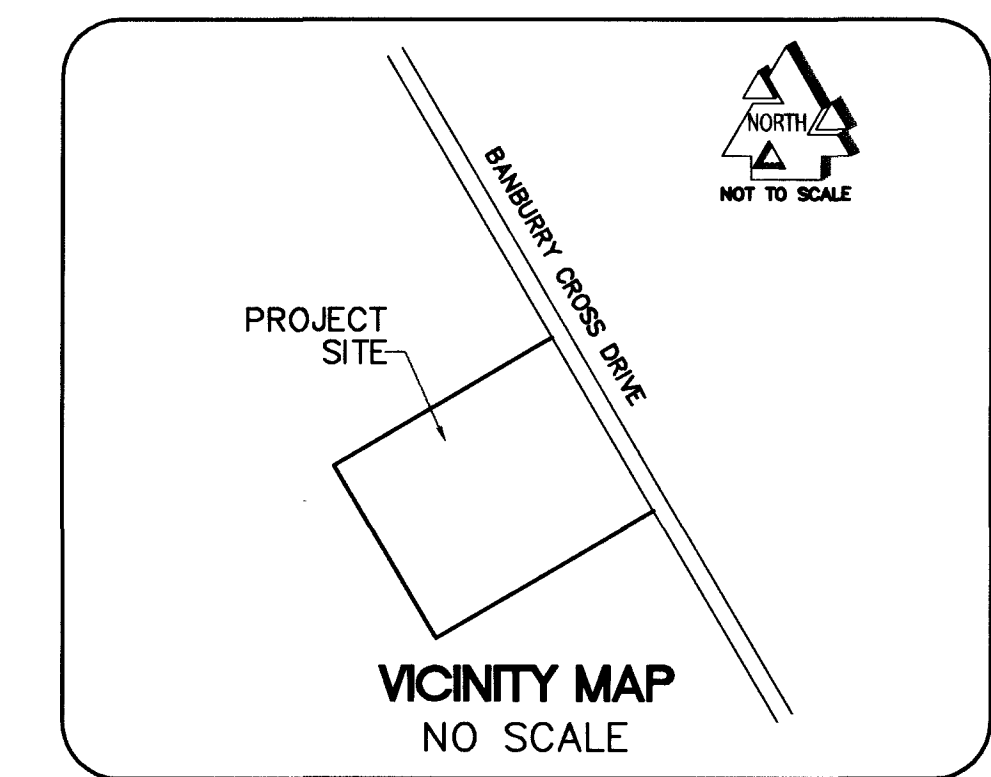

GRADING CONSTRUCTION NOTES

1. CONSTRUCT "A" TYPE CURB PER DETAIL 2 SHEET CD.1
- 1A. CONSTRUCT "A" TYPE CURB PER DETAIL 2 SHEET CD.1 WITH FACE TO TRANSITION FROM 0\"/>

Call before you Dig
1-800-227-2600
UNDERGROUND SERVICE (USA)

Call before you do overhead
1-702-593-6111

BENCHMARK (FIRE STATION 7)

CITY OF LAS VEGAS BENCHMARK #0LV00-30W4 RIMT AND PLATE IN TOP OF CURB ON THE WEST SIDE OF ROUNDABOUT OF TOWN CENTER DRIVE AND BANBURY CROSS DRIVE. ELEVATION = 2853.83 FEET, 869.849 METERS (NAV888).

BASIS OF BEARINGS (FIRE STATION 7)

N40°08'34\"/>

CONSTRUCTION JOINTS

FOR CONCRETE CONSTRUCTION JOINTS, REFER TO SHEET C7.1.

PROJ NO	AZ01035
DESIGN	ABM/LG/RAS
DATE	11/07/01
SCALE	AS SHOWN
CAD FILE	F7_C7.4

STAMP DATE: 11-7-01

AZTEC ENGINEERING
3320 N. Buffalo Dr., Ste. 106
Las Vegas, NV 89129
Tel (702) 396-3426 Fax (702) 396-3758
Email: aztec@azteceng.com

CITY OF LAS VEGAS FIRE STATION NO. 7	SITE IMPROVEMENTS	GRADING PLAN

SHEET
C7.4
10 of 17 Sheets
CLV PROJECT NO.
630.99