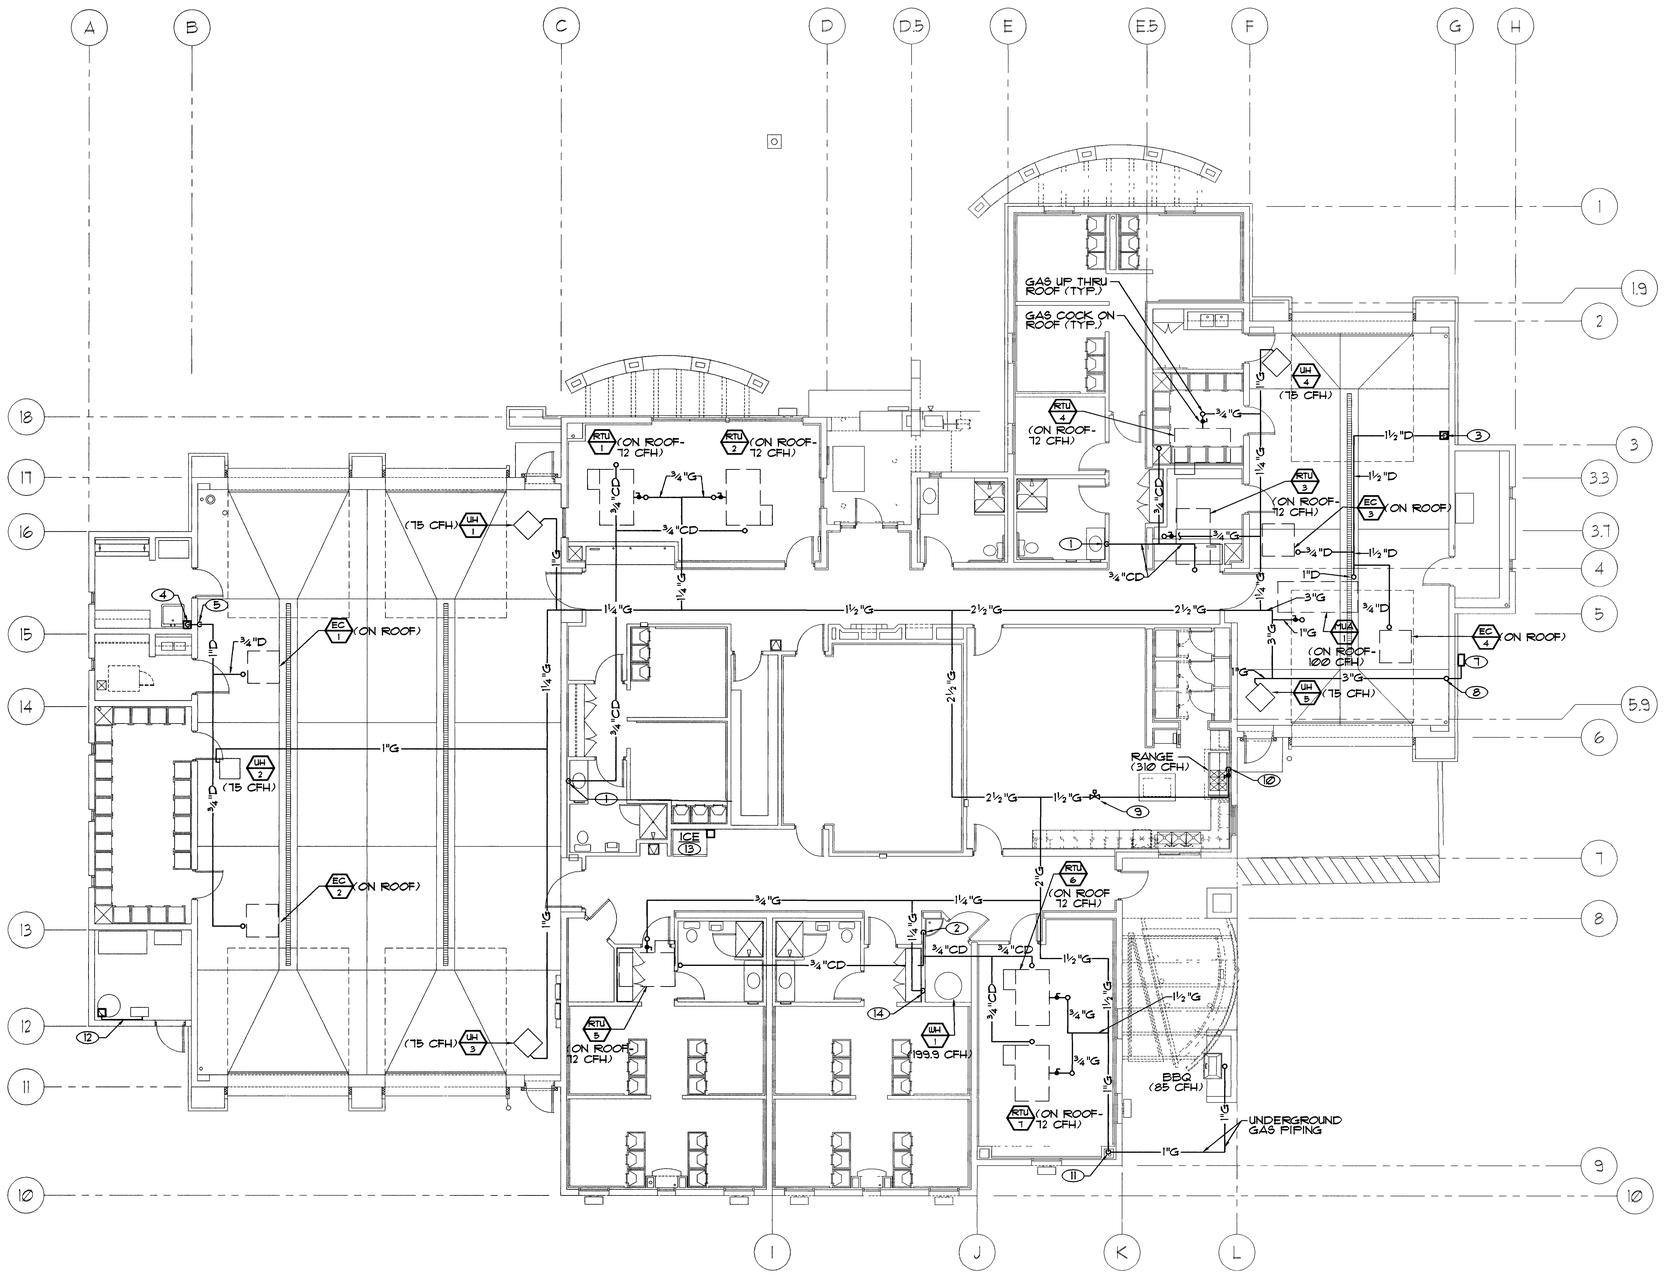

GENERAL NOTES

1. NO PLASTIC PIPING IS PERMITTED ABOVE GRADE SINCE THERE IS A RETURN AIR PLENUM.
2. LABEL ALL CONCEALED AND EXPOSED PIPING WITH PIPE MARKERS AND FLOW ARROWS COLOR CODED FOR EACH APPLICATION.

SHEET NOTES

1. ¾" CONDENSATE DRAIN DOWN TO LAVATORY TAILPIECE.
2. 1" CONDENSATE DRAIN DOWN TO SERVICE SINK.
3. 1½" DRAIN DOWN TO FLOOR SINK.
4. 1" DRAIN DOWN TO FLOOR SINK.
5. 1" DRAIN DOWN TO ADJACENT CEILING SPACE.
6. 1½" DRAIN DOWN TO FLOOR SINK.
7. PROPOSED GAS METER LOCATION (1573.9 CFH) TOTAL DEMAND AT 195 FT. FROM METER TO MOST REMOTE FIXTURE, UH-3.) GAS PIPING SIZED PER TABLE 12-3 2000 U.P.C. (200 FT. COLUMN). 1
8. 3"G UP TO BELOW ROOF.
9. GAS SOLENOID VALVE FOR GAS FLOW SHUT-DOWN WHEN ANSUL FIRE PROTECTION SYSTEM IS ACTIVIATED.
10. 1½"G DOWN.
11. 1"G DOWN IN WALL TO BELOW GRADE. REFER TO DETAIL 4/P2.
12. ROUTE FULL SIZE DRAIN PIPING FROM AIR DRYER TO FLOOR SINK.
13. ROUTE FULL SIZE DRAIN PIPING FROM ICE MACHINE TO FLOOR SINK.
14. 1¼"G DOWN.

PLUMBING FLOOR PLAN - CONDENSATE DRAIN AND GAS PIPING

Scale: 1/8"=1'-0"

◀ Project North

102886

RECORD DRAWING

CITY OF LAS VEGAS NEVADA

REVISIONS:
1 8/12/04 BLDG. DEPT. COMMENTS

CONSULTANT

COMFORT ENGINEERING
MECHANICAL • ELECTRICAL • PLUMBING
2550 SOUTH JONES BLVD. SUITE 5-28
LAS VEGAS, NEVADA 89146
TEL. (702) 367-0882 • FAX 367-1076
J. CARY COMFORT
P.E.

DEPARTMENT OF PUBLIC WORKS

CITY OF LAS VEGAS, NEVADA
FIRE STATION #8

PLUMBING FLOOR PLAN - CONDENSATE DRAIN AND GAS PIPING

STAMP

OWNER: CITY OF LAS VEGAS
DEPARTMENT OF PUBLIC WORKS
ARCHITECTURAL SERVICES

400 EAST STEWART AVENUE
LAS VEGAS, NEVADA 89101
PHONE: (702) 229-6535
FAX: (702) 382-3232
TDD: (702) 386-9108

DRAWN	DBB
FILE	
DATE	4/9/04
SCALE	1/8" = 1'-0"
BID NO	04.15341.04
CLV DWG NO	630-101
SHT NO	101

P3.1

DRAWINGS AS INSTRUMENTS OF SERVICE ARE THE PROPERTY OF THE DESIGN PROFESSIONAL. WHOSE STAMP OF CERTIFICATION APPEARS ON THE DRAWINGS AND SPECIFICATIONS. ANY USE OR REPRODUCTION IN WHOLE OR IN PART WITHOUT WRITTEN CONSENT IS STRICTLY PROHIBITED. COPIES OF THE DRAWINGS AND SPECIFICATIONS RETAINED BY THE OWNER MAY BE UTILIZED ONLY FOR OCCUPYING THE PROJECT FOR WHICH THEY WERE PREPARED AND NOT FOR THE CONSTRUCTION OF ANY OTHER PROJECT. N.A.C. 623.780