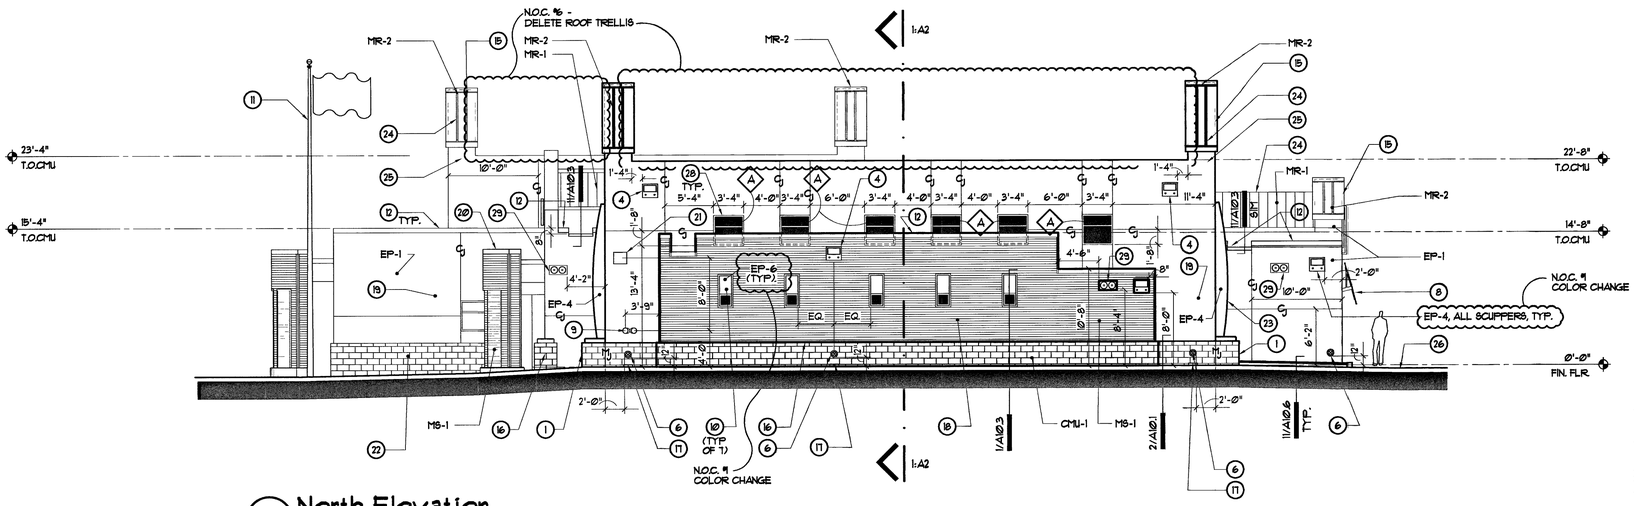

1 North Elevation

Scale: 1/8"=1'-0"

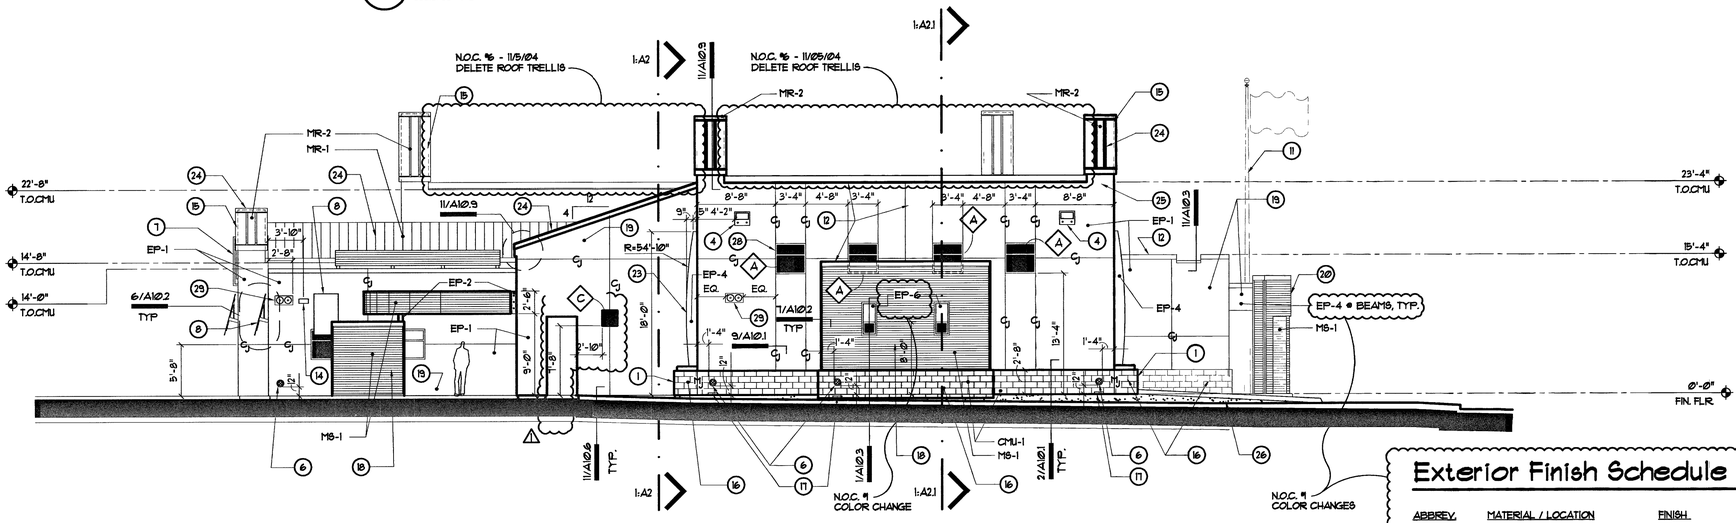

2 South Elevation

Scale: 1/8"=1'-0"

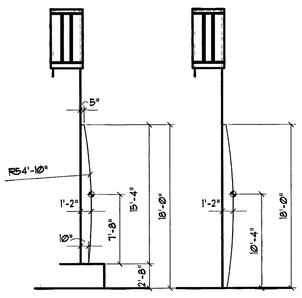

Keynotes

1. CMU BOLLARD, SEE DETAIL 1/A10.1.
2. NOT USED.
3. NOT USED
4. OVERFLOW ROOF SCUPPER, SEE DTL. 4/A10.5 & SHT A3 FOR EXACT LOCATION.
5. NOT USED.
6. ROOF DRAIN OUTLET, PROVIDE DOWNSPOUT NOZZLE PER PLUMBING DWGS.
7. GABLE VENT AND TUBE STEEL DECORATIVE BAR - SEE DETAIL 11/A10.2
8. WINDOW CANOPY - SEE DETAILS ON SHEET A10.2
9. FIRE DEPARTMENT CONNECTION, SEE PLUMBING DRAWINGS AND FIRE PROTECTION DWGS.
10. STUCCO NICHE AT CMU WALL, SEE DETAIL 1/A10.3 & 8/A10.9
11. FLAGPOLE, SEE CIVIL DRAWINGS FOR DETAILS.
12. METAL COPING, MATCH (MR-2) COLOR, FINISH, GUAGE, UNLESS NOTED OTHERWISE.
13. NOT USED
14. EXTERIOR LIGHT, SEE SPECIFICATIONS FOR DIFFERENT LIGHTS & LOCATIONS.
15. GABLE FLASHING - MATCH (MR-2) ROOF COLOR/GUAGE, SEE FINISH SCHEDULE & SEE DETAILS 4/A10.3.
16. EXPOSED CMU WAINSCOT - SEE DETAIL 2/A10.1.

Keynotes

17. SPLASH BLOCK, TYPICAL UNDER ALL ROOF DRAIN OUTLETS.
18. CMU WALL W/ MTL. SIDING & MTL. COPING, SEE FINISH SCHEDULE, SPECIFICATIONS & WALL LEGEND
19. LIGHT SAND STUCCO FINISH - SEE EXTERIOR FINISH SCHEDULE THIS SHEET & SPEC'S.
20. MTL. FRAMED TRELLIS W/ METAL SIDING (MS-1) AND STUCCO BEAM FINISH SEE DETAIL DTL. 3/A10.2.
21. HORN & STROBE, SEE SHEET FP-01 FOR ALL INFORMATION.
22. POURED-IN-PLACE CONCRETE WALL, SEE SHEET A2.1.
23. METAL FRAMED CURVED POPOUT AT GARAGE DOOR W/ STUCCO FINISH - SEE DETAILS (TYP)
24. STANDING SEAM ROOF, SEE FINISH SCHEDULE, SPECIFICATIONS & ROOF PLAN.
25. GABLE END POPOUT AND FLASHING - SEE DETAIL 11/A10.9
26. APPROXIMATE LINE OF FINISH GRADE, SEE CIVIL DRAWINGS.
27. 8"X8"X16" EXPOSED CMU WALL. (CMU-1).
28. CLERESTORY WINDOW IN APPAIRATUS RM. WALL BEHIND PARAPET, SEE WINDOW SCHEDULE & DETAIL 1/A3.1. (TYP. OF 10 WINDOWS TOTAL).
29. SPEAKERS, SEE ELECTRICAL DWGS. FOR ALL INFORMATION. MOUNT CENTER OF SPEAKERS AT 10'-0" A.F.F.

General Notes:

1. ALL EXTERIOR METAL TO BE SHOP PRIMED AND PAINTED PER FINISH SCHEDULE.
2. SEE FINISH SCHEDULE ON THIS SHEET FOR COLORS OF ALL MATERIALS KEYNOTED ON ELEVATIONS.
3. ANY PLACE WHERE A "CJ" IS SHOWN INDICATES A CONTROL JOINT RUNNING THE FACE OF THE WALL.
4. ANY PLACE WHERE A "1/2" IS SHOWN INDICATES A CONTROL JOINT RUNNING THE FACE OF THE EXPOSED CMU VENEER ONLY, (THIS IS NOT THE SAME AS THE CMU EXPANSION JOINT AS SHOWN IN THE STRUCTURAL DRAWINGS). SEE DETAIL 9/A10.9 FOR EXACT CONFIGURATION OF VENEER JOINT.

Exterior Finish Schedule

ABBREV.	MATERIAL / LOCATION	FINISH	COLOR & MFR.
EP-1	MAIN EXTERIOR COLOR ON STUCCO WALLS:	LIGHT SAND STUCCO FINISH, PAINTED	"SAND MOTIF", #422 MFR: ICI (OR APPROVED EQ.)
EP-1	EXTERIOR DOORS & FRAMES	PAINT (DOORS) / LIGHT SAND STUCCO FINISH (TRELLIS).	"SAND MOTIF", #422 MFR: ICI (OR APPROVED EQ.).
EP-2	CURVED METAL I-BEAM	SHOP PRIMED EXT'R METAL, PAINTED.	"MONARCH GOLD", #522 MFR: ICI (OR APPROVED EQ.).
EP-3	EXTERIOR ACCENT STUCCO WALL COLOR	LIGHT SAND STUCCO FINISH, PAINTED	"SALSA", #23 MFR: ICI (OR APPROVED EQ.).
EP-4	ACCENT STUCCO COLOR FOR STUCCO POPOUTS: STUCCO FINISH TRELLIS BEAMS: METAL @ TRASH ENCL. METAL @ PATIO CANOPY METAL W/WD. CANOPY FRAMES	LIGHT SAND STUCCO FINISH, PAINTED / SHOP PRIMED EXT'R METAL, PAINTED.	"WHITE-HIGH HIDING RM", #2013. MFR: ICI (OR APPROVED EQ.).
EP-5	METAL ROOF TRELLIS OVER APPARATUS BAYS	EPOXY PAINT TO MATCH MR-1	SUBMIT COLOR MATCH SAMPLE TO ARCHITECT FOR APPROVAL.
EP-6	EXTERIOR ACCENT STUCCO WALL COLOR	LIGHT SAND STUCCO FINISH, PAINTED	"NIGHT'S EDGE", # 1549 MFR: ICI (OR APPROVED EQ.).
CMU-1	EXPOSED CMU (8"X8X16") (4"X8"X16") CMU WAINSCOT.	EXPOSED CMU WALLS.	ASTRA-GLAZE-SW "FIRE ENGINE RED" MFR: "TRENWYTH" OR APPROVED EQ, SEE SPECIFICATIONS.
NUMBER-1	BLDG. ADDRESS NUMBERS: (18" HIGH)	BAKED ENAMEL FINISH	FONT: "HELVETICA", PAINT W/ "WHITE HIGH HIDING" #2013, BY MFR. ICI OR APPROVED EQ.
NUMBER-2	FIRE STATION NUMBER: (3'-0" HIGH)	GALV. STEEL, PAINTED.	MFR GEMINI, FONT: "HELVETICA" COLOR: "WHITE HIGH HIDING" #2013, OR APP. EQ.
MR-1	STND'G SEAM METAL ROOF'G -	FACTORY FINISH.	MFR. & STYLE: SEE SPEC'S COLOR: "RUSTIQUE" DURATECH 5000 ZINCALUME
*MR-2	STND'G SEAM METAL ROOF'G - *(GABLE PARAPETS, TYPICAL)	FACTORY FINISH.	MFR. & STYLE: SEE SPEC'S COLOR: "RUSTIQUE" DURATECH 5000 ZINCALUME
MS-1	CORRUGATED MTL SIDING - (CURVED COLUMN/TRELLIS, PATIO CANOPY & DESIGNATED BLDG WALLS)	FACTORY FINISH	MFR. & STYLE: SEE SPEC'S COLOR: "RUSTIQUE" DURATECH 5000 ZINCALUME

102828

RECORD DRAWING

CITY OF LAS VEGAS NEVADA

REVISIONS
1 BLDG DEPT - 5/27/03

CONSULTANT

DEPARTMENT OF PUBLIC WORKS

CITY OF LAS VEGAS
FIRE STATION #8

Exterior Elevations &
Exterior Finish Schedule

STAMP

OWNER: CITY OF LAS VEGAS
DEPARTMENT OF PUBLIC WORKS
ARCHITECTURAL SERVICES

ARCHITECT OF RECORD
SAMUEL D. TOLMAN, AIA, NCARB
400 EAST STEWART AVENUE
LAS VEGAS, NEVADA 89101
PHONE: (702) 229-6535
FAX: (702) 382-3232
TDD: (702) 386-9108

DRAWN	EPS
FILE	fs8-A41
DATE	6/8/04
SCALE	1/8"=1'-0"
BID NO	041534.04
CLV DWG NO	630-101
SHT NO	043

A4.1

DRAWINGS AS INSTRUMENTS OF SERVICE ARE THE PROPERTY OF THE DESIGN PROFESSIONAL. IMAGE STAMP OF CERTIFICATION APPEARS ON THE DRAWINGS AND SPECIFICATIONS REMAIN BY THE CLIENT MAY BE UTILIZED ONLY FOR OCCUPYING THE PROJECT FOR WHICH THEY WERE PREPARED AND NOT FOR THE CONSTRUCTION OF ANY OTHER PROJECT. N.A.C. 623.780. ALTERED COPIES OF THE DRAWINGS AND SPECIFICATIONS AND OR REPRODUCTION IN WHOLE OR IN PART WITHOUT WRITTEN CONSENT IS STRICTLY PROHIBITED COPIES OF THE DRAWINGS AND SPECIFICATIONS