
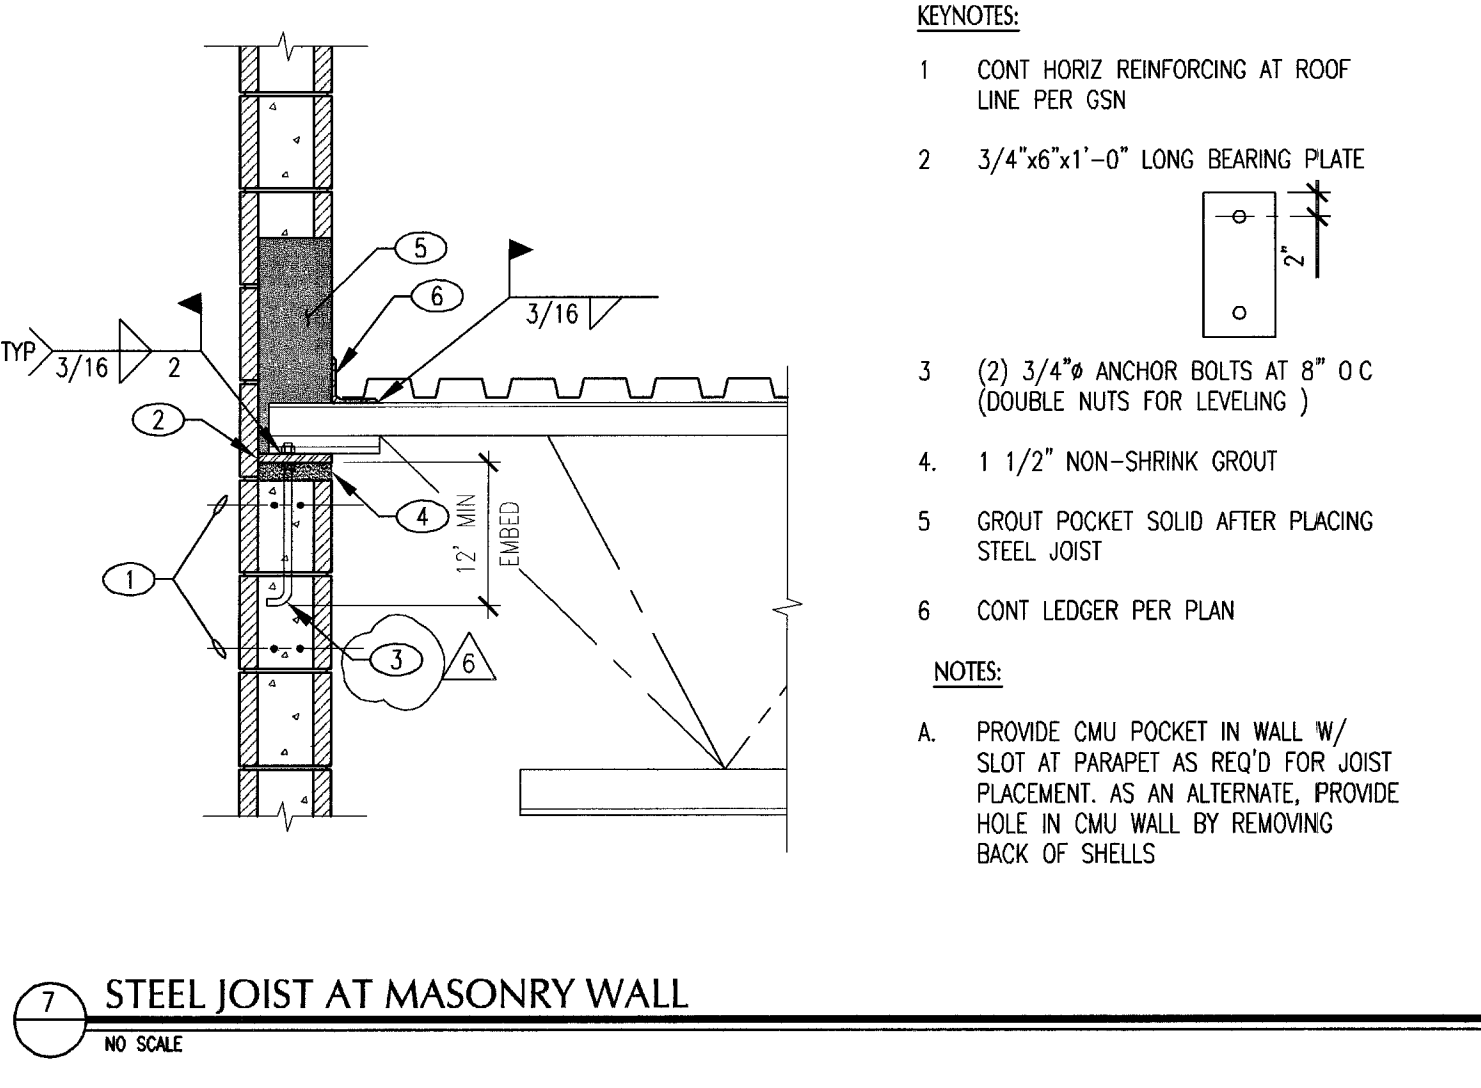
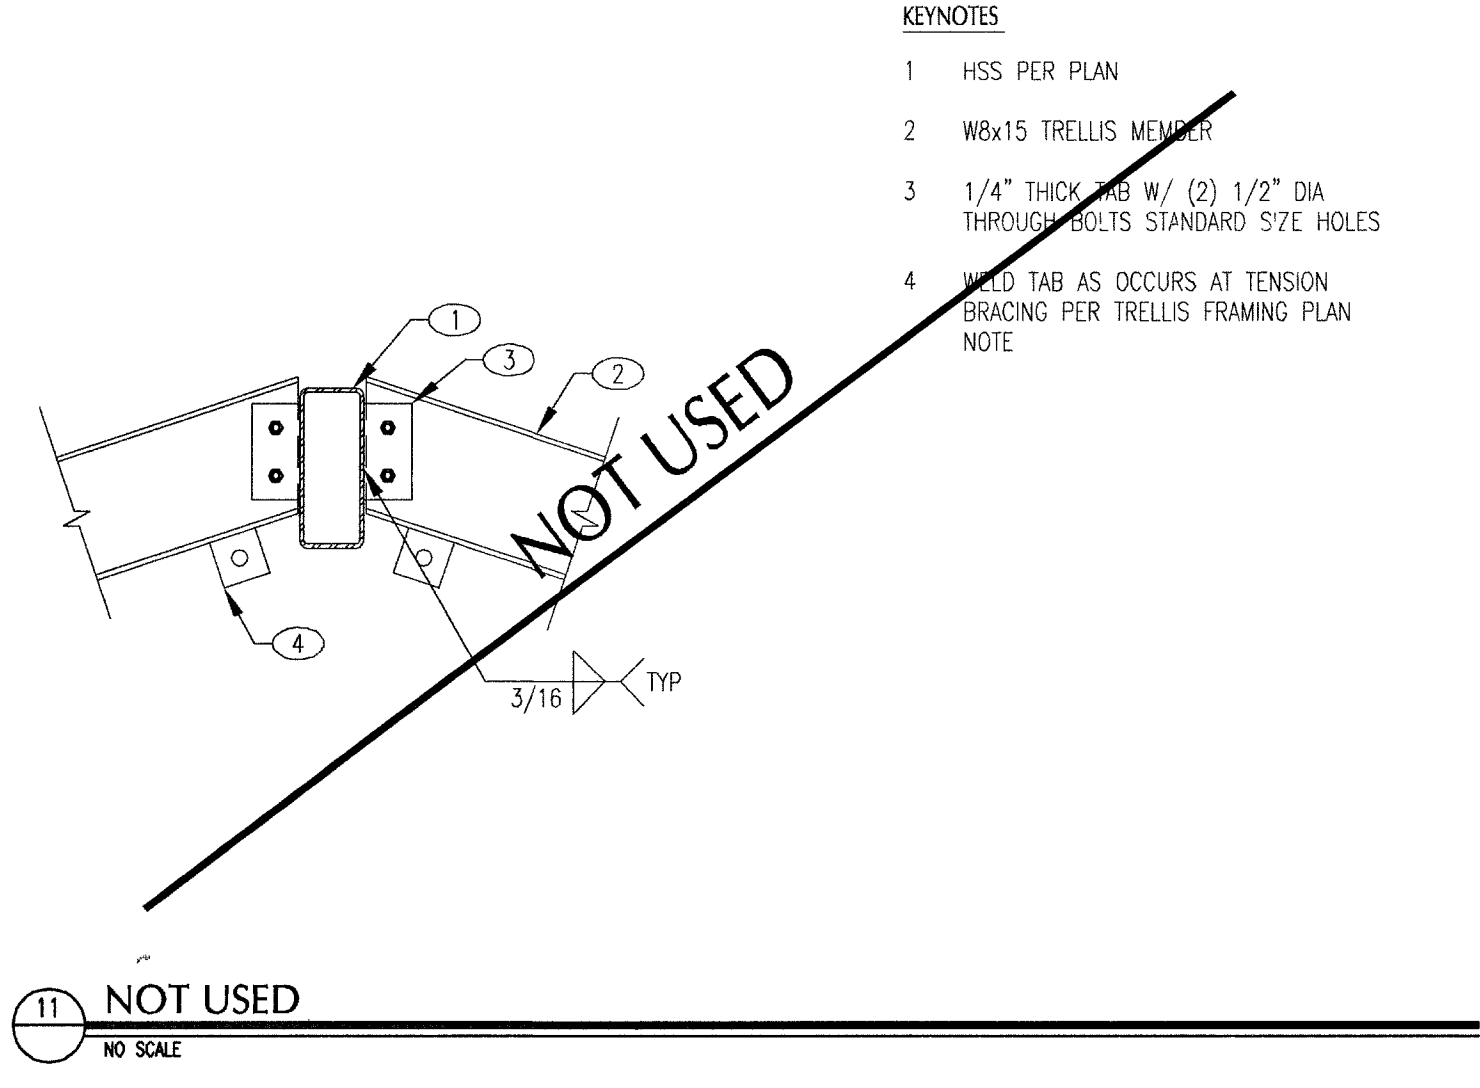
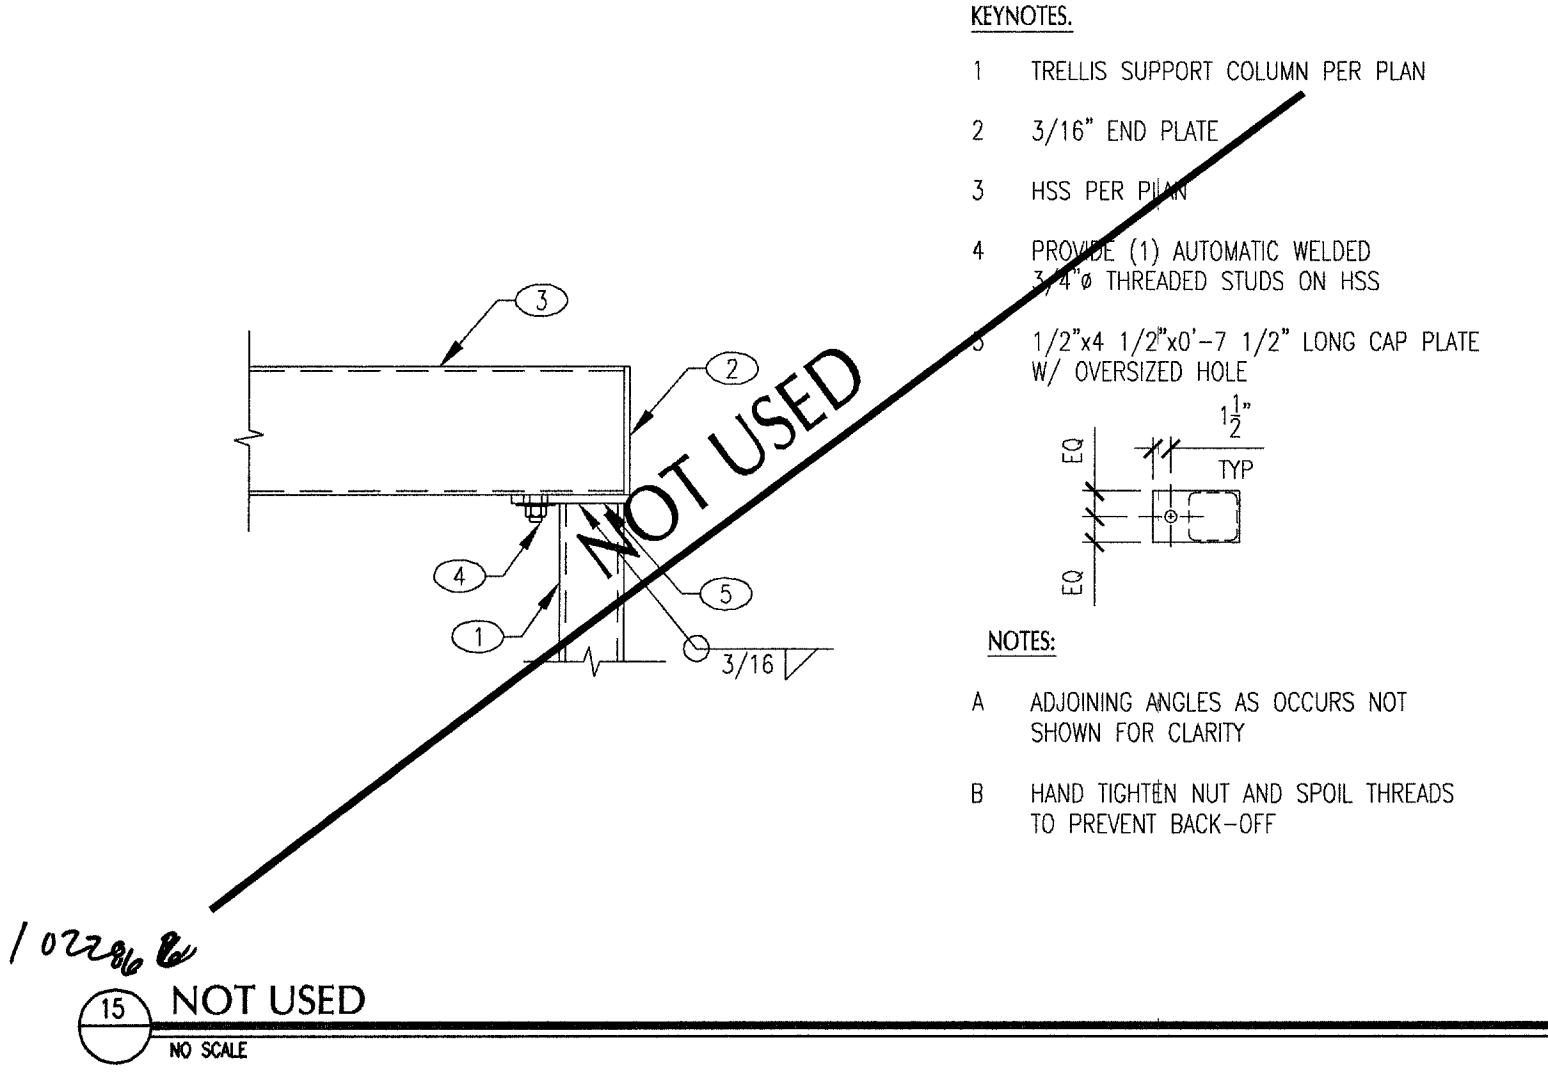
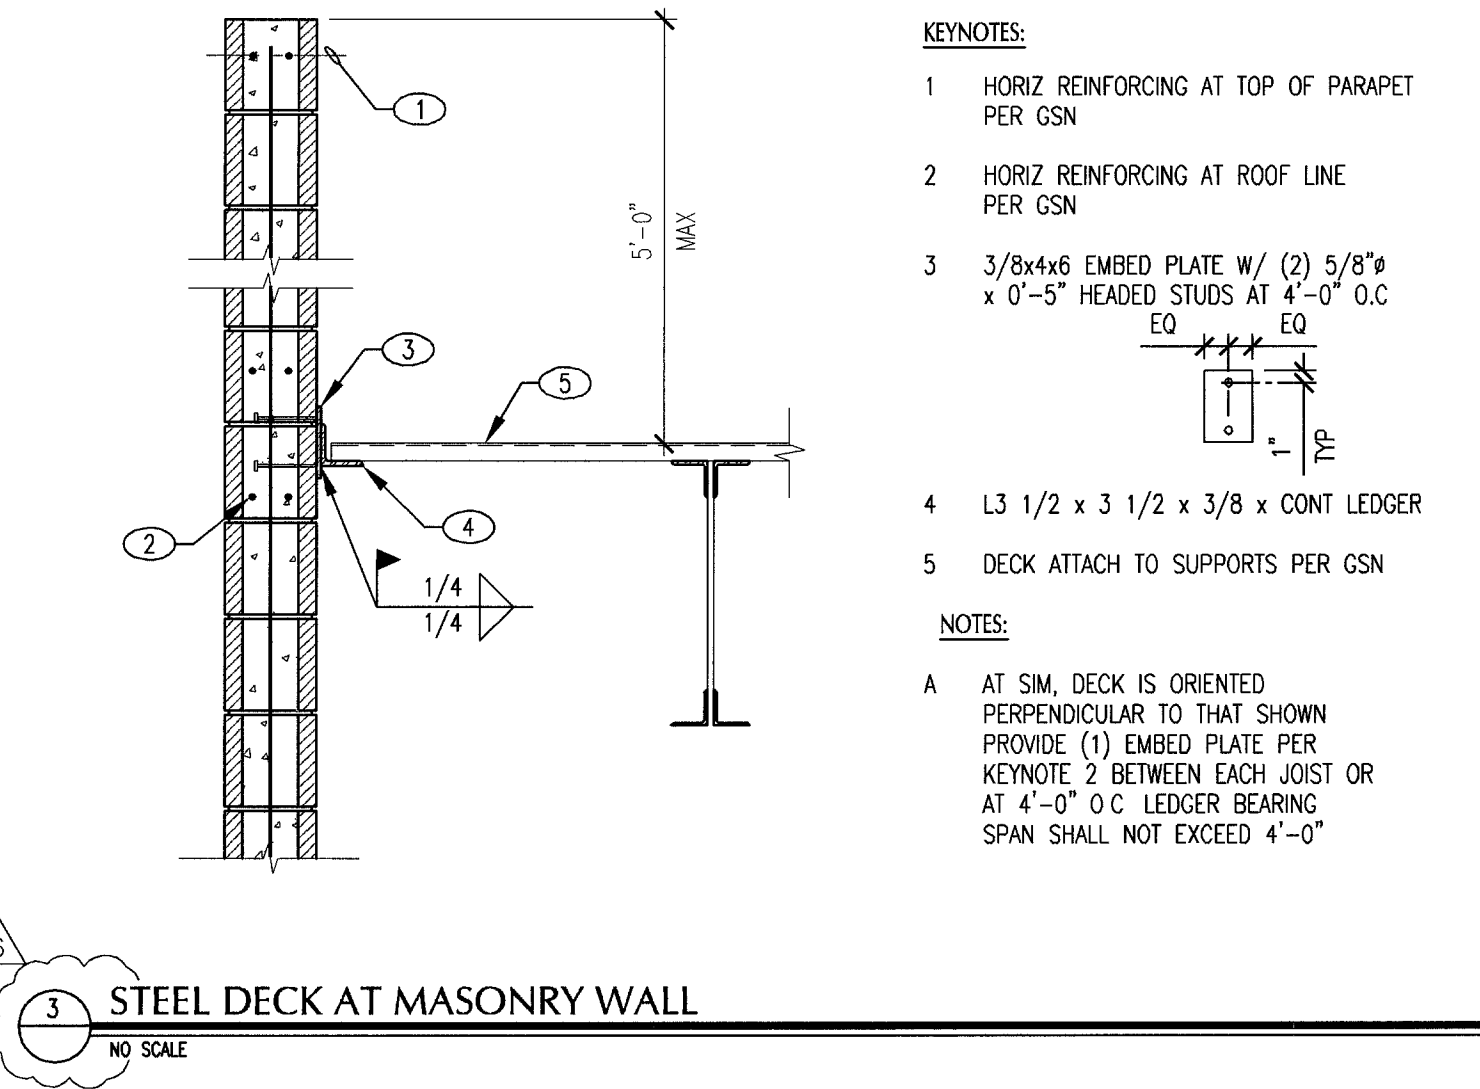
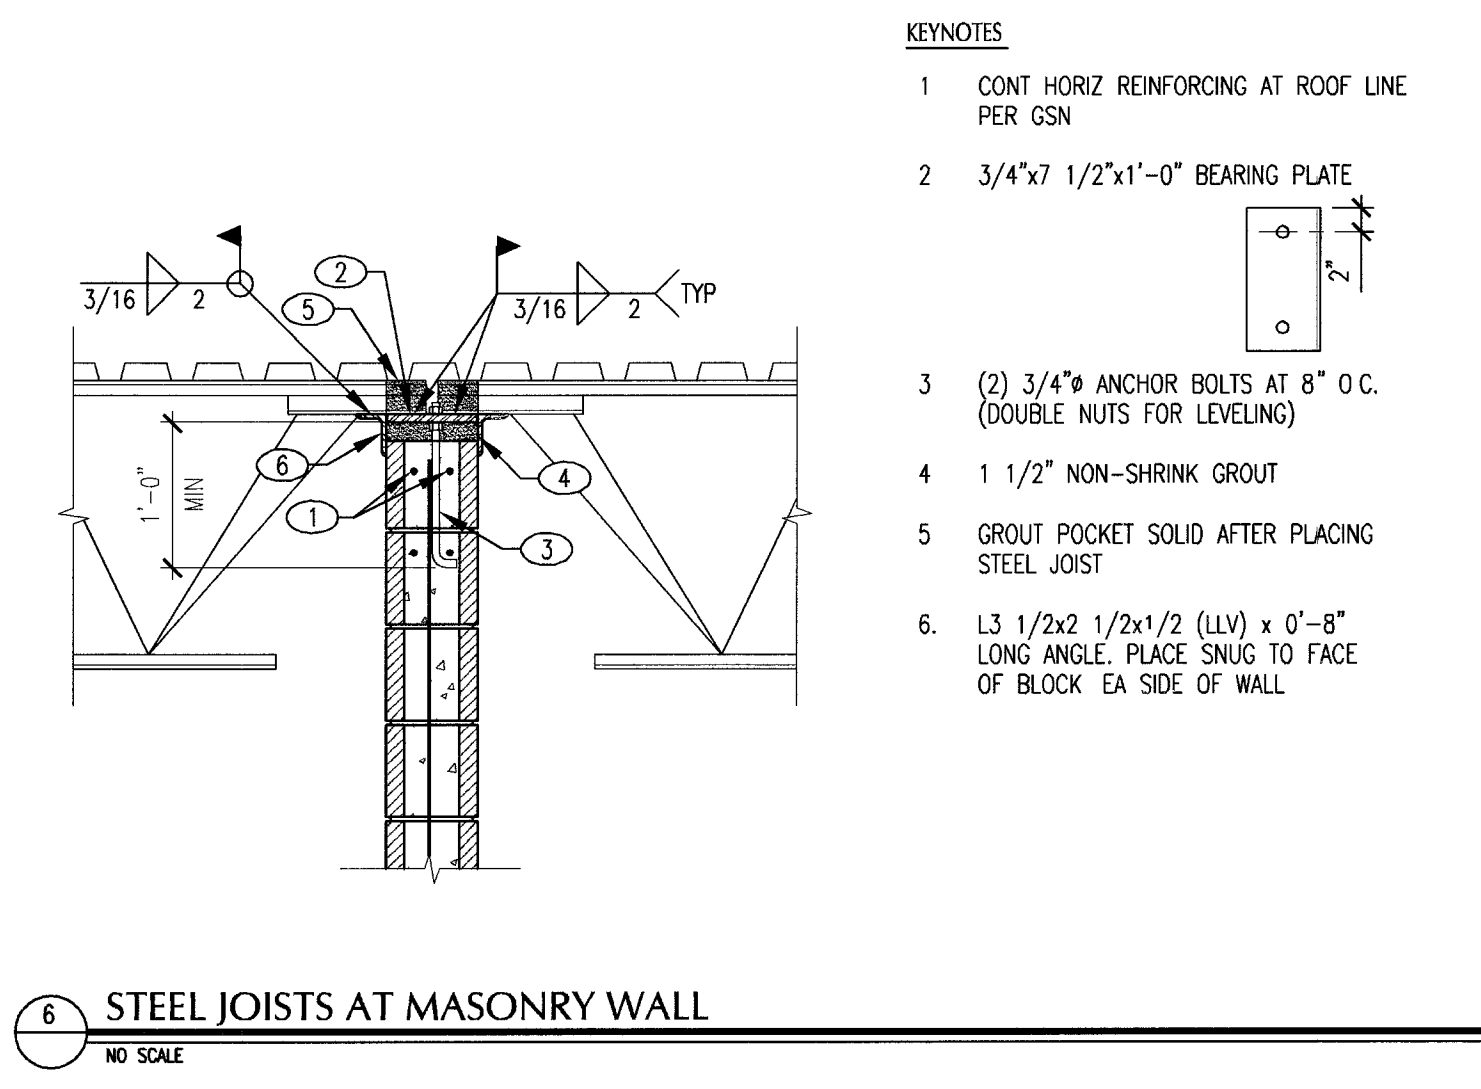
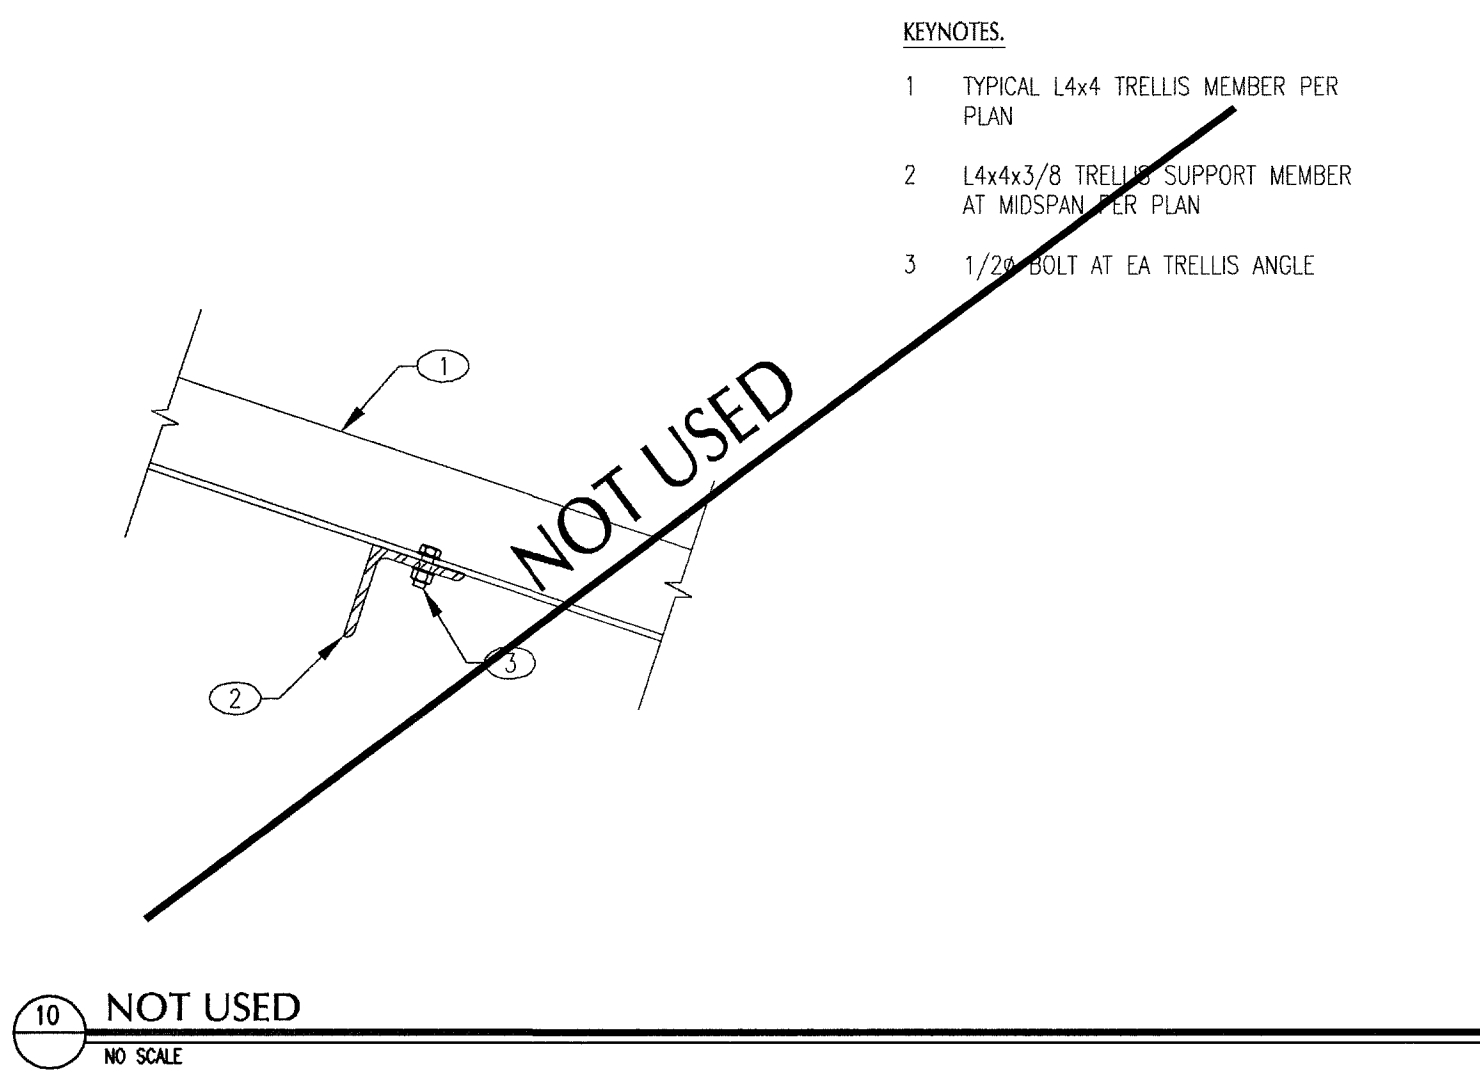
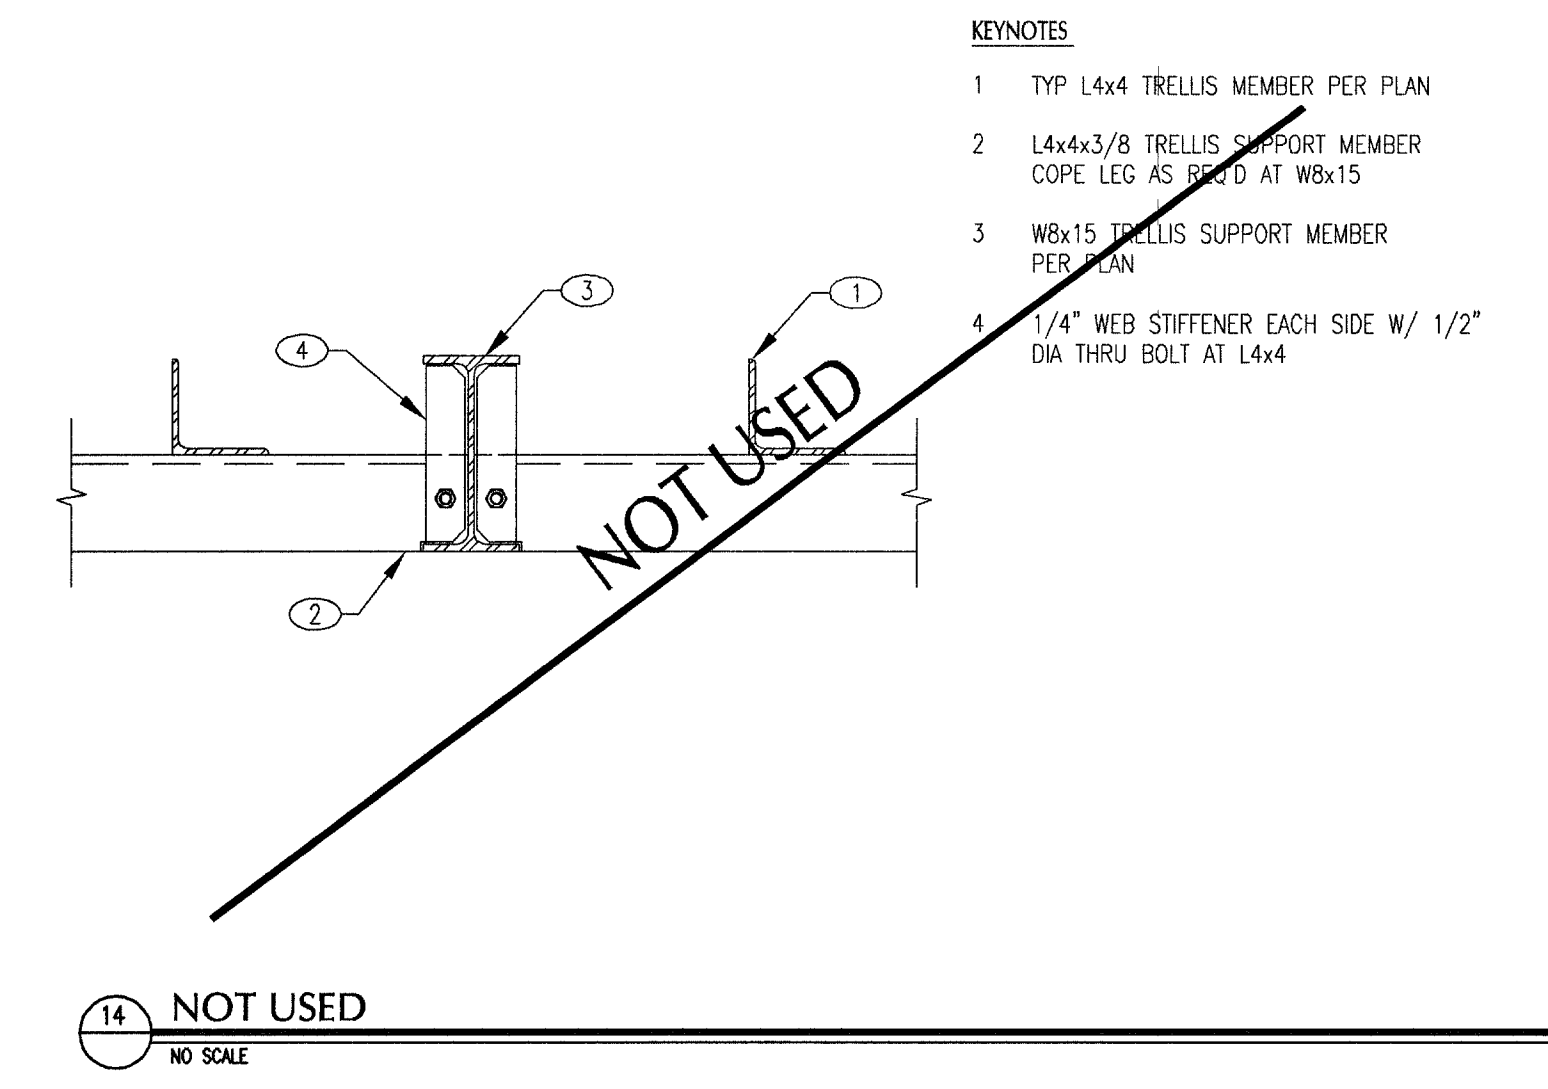
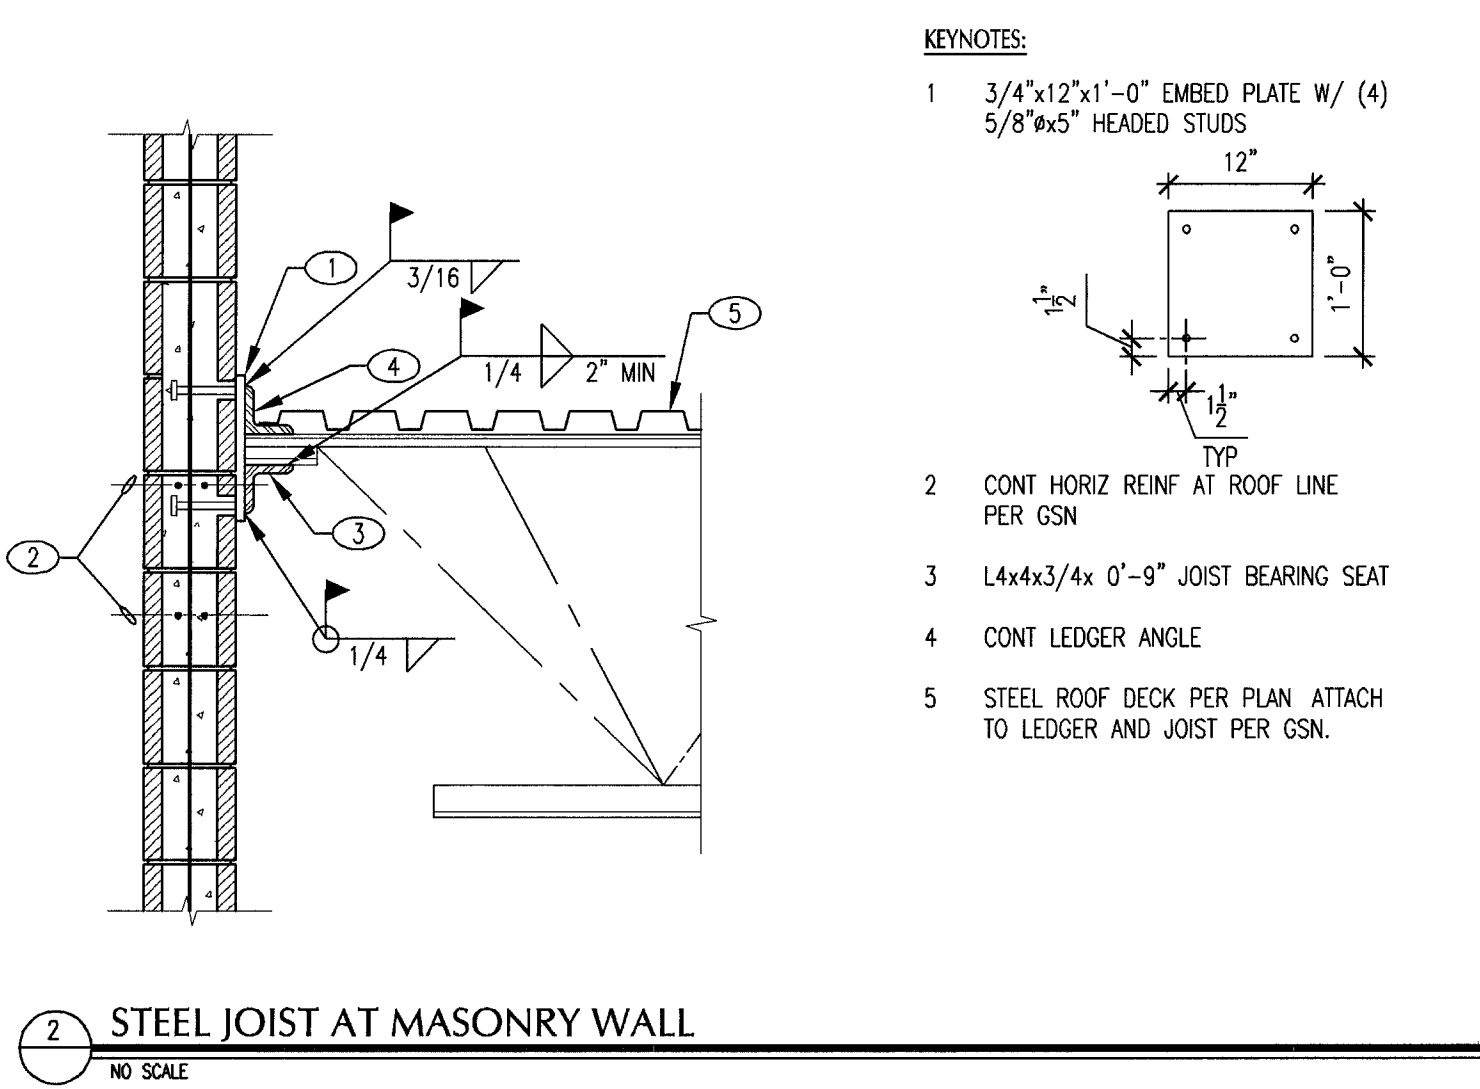
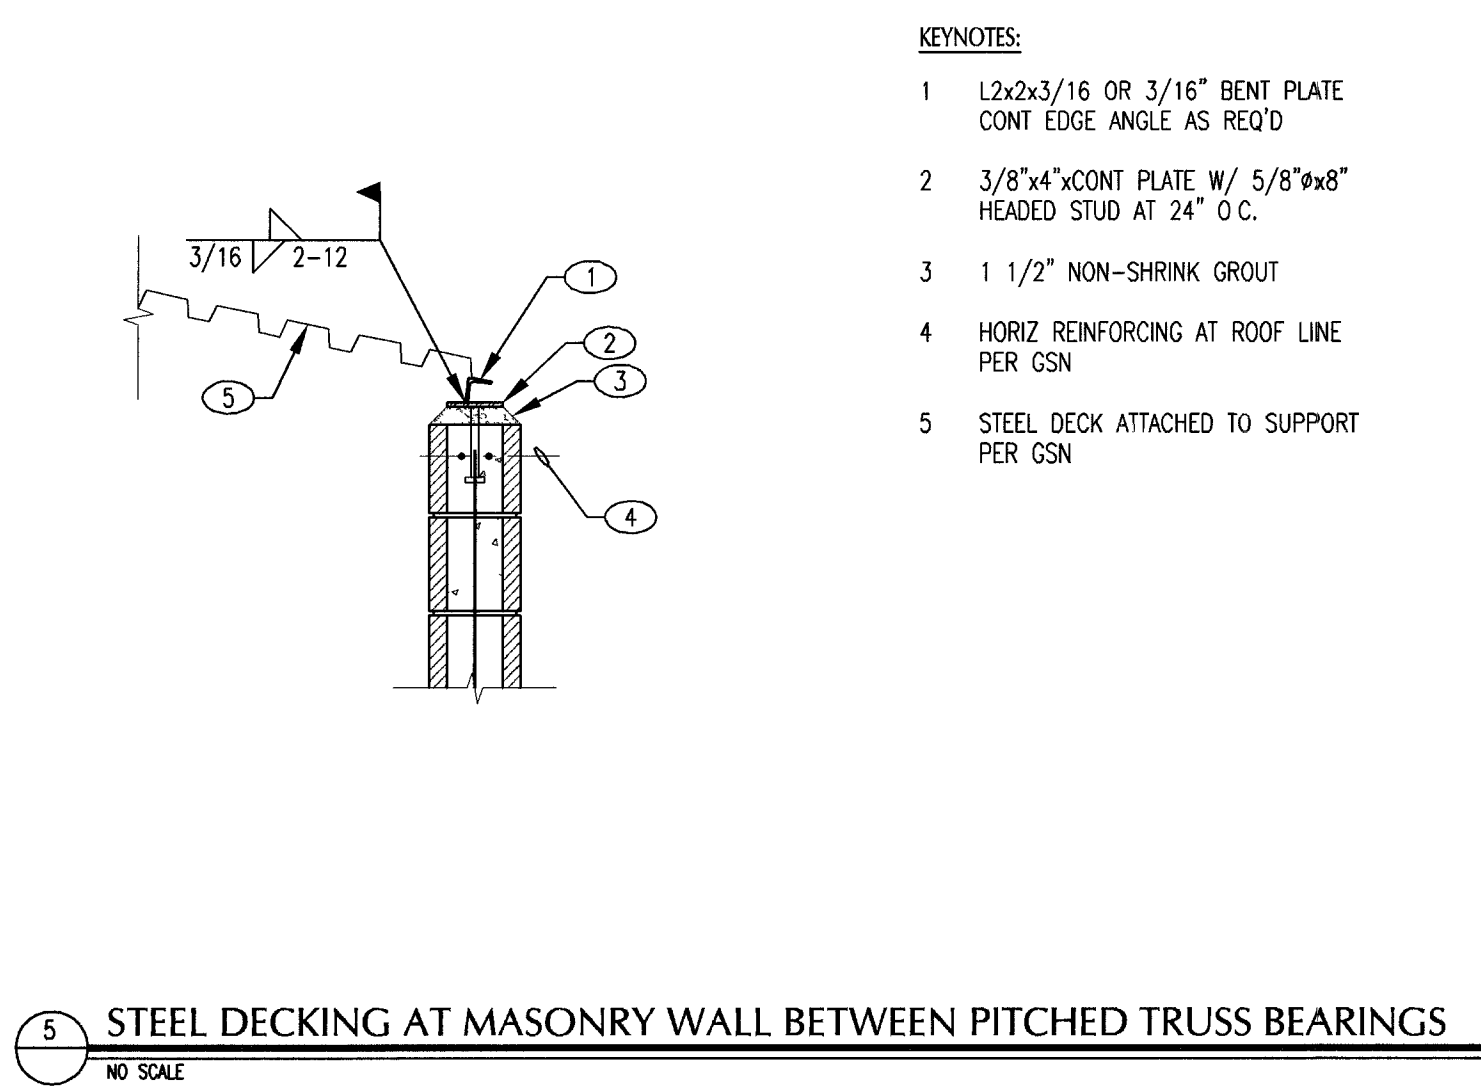
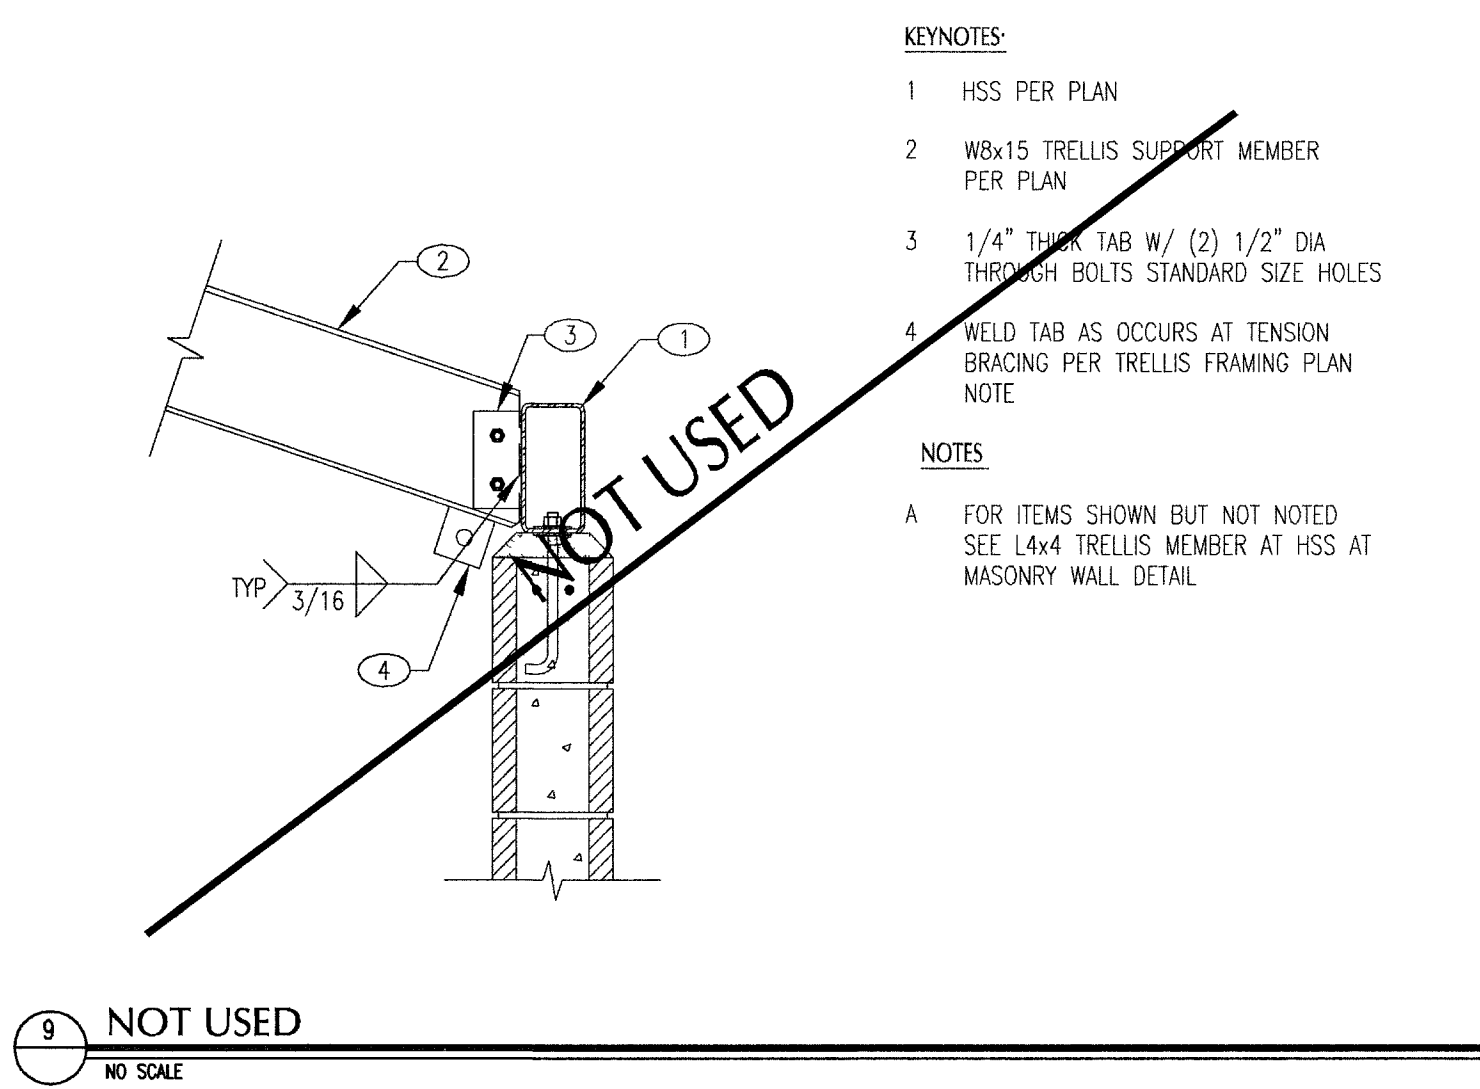
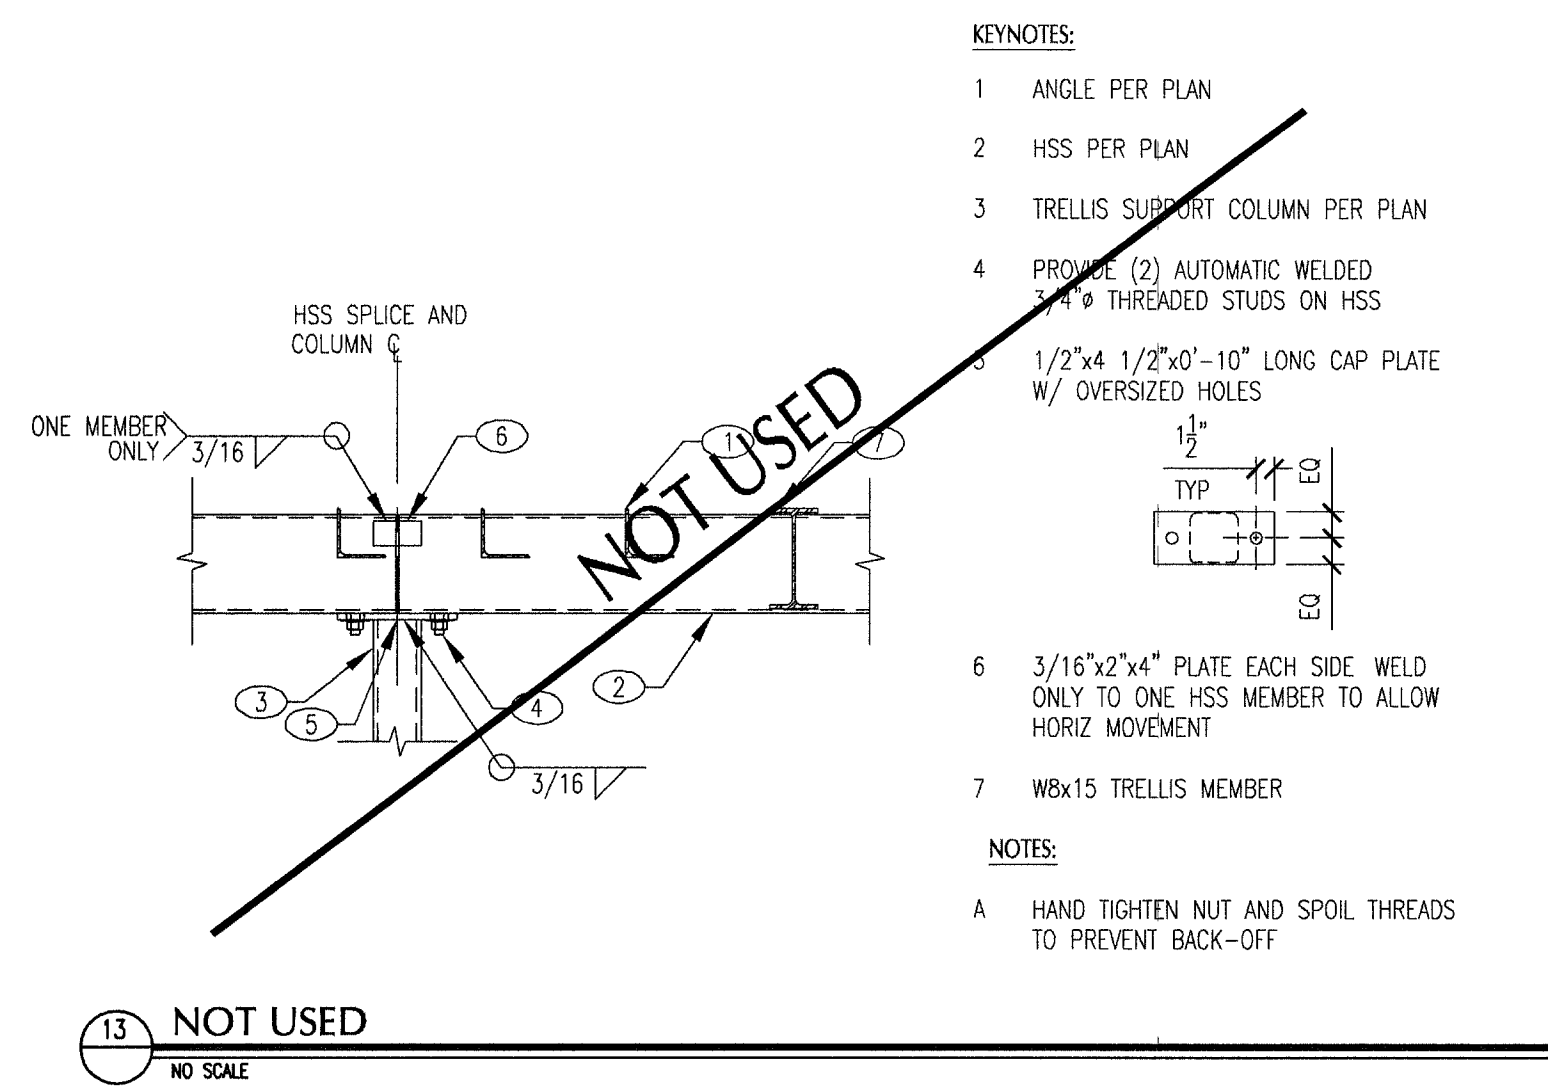
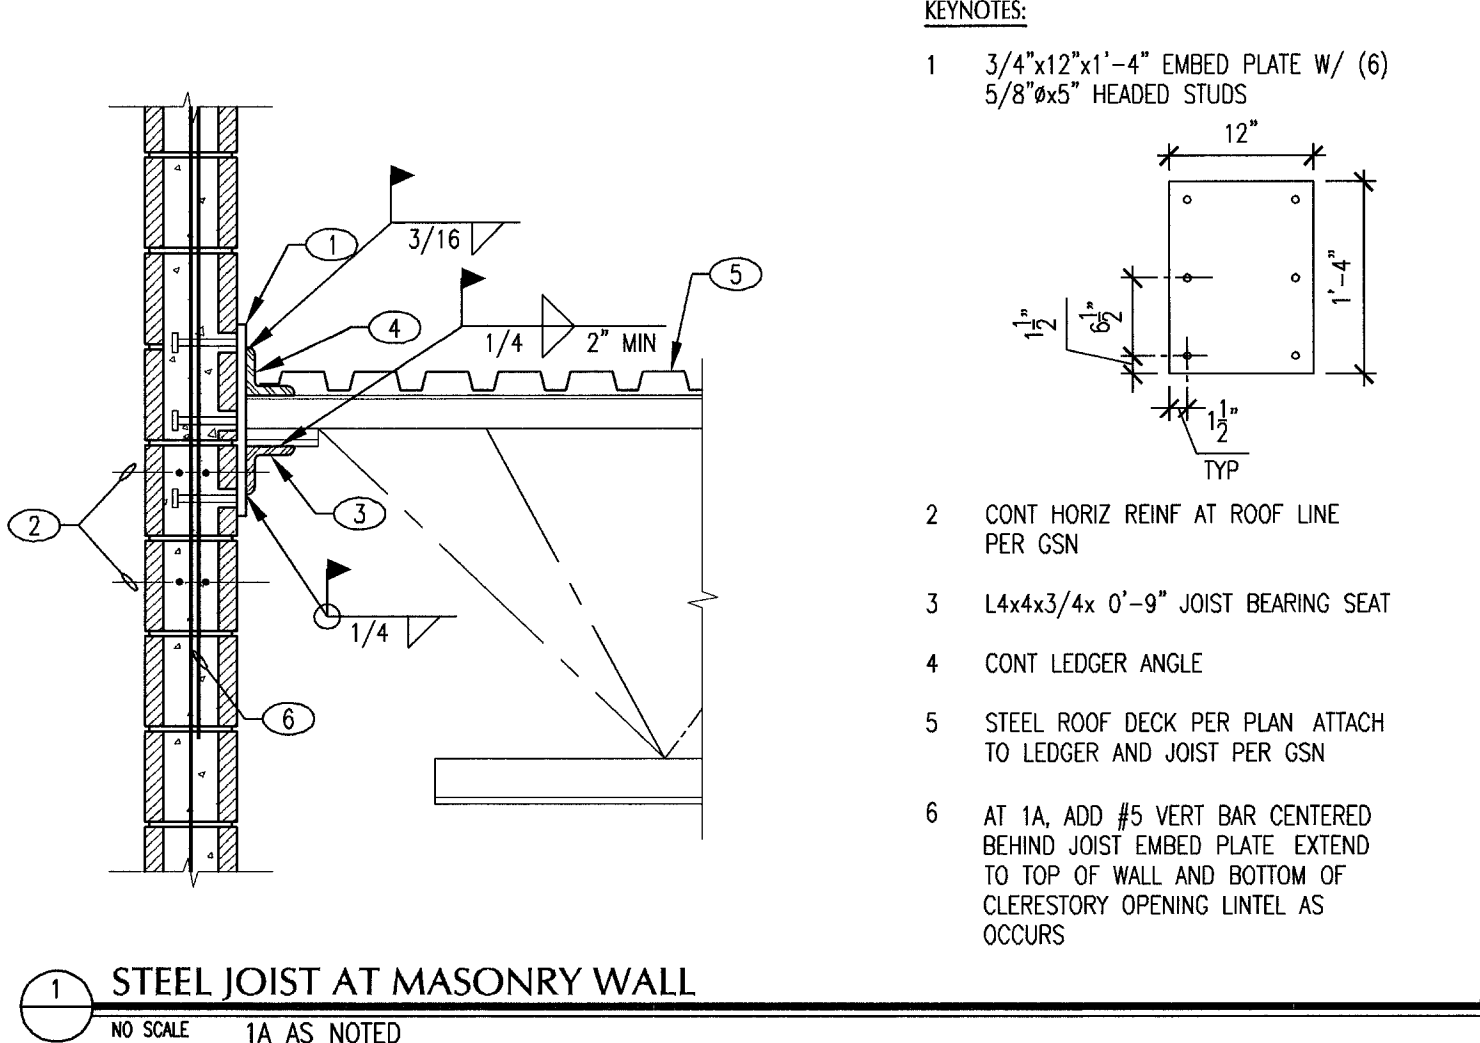
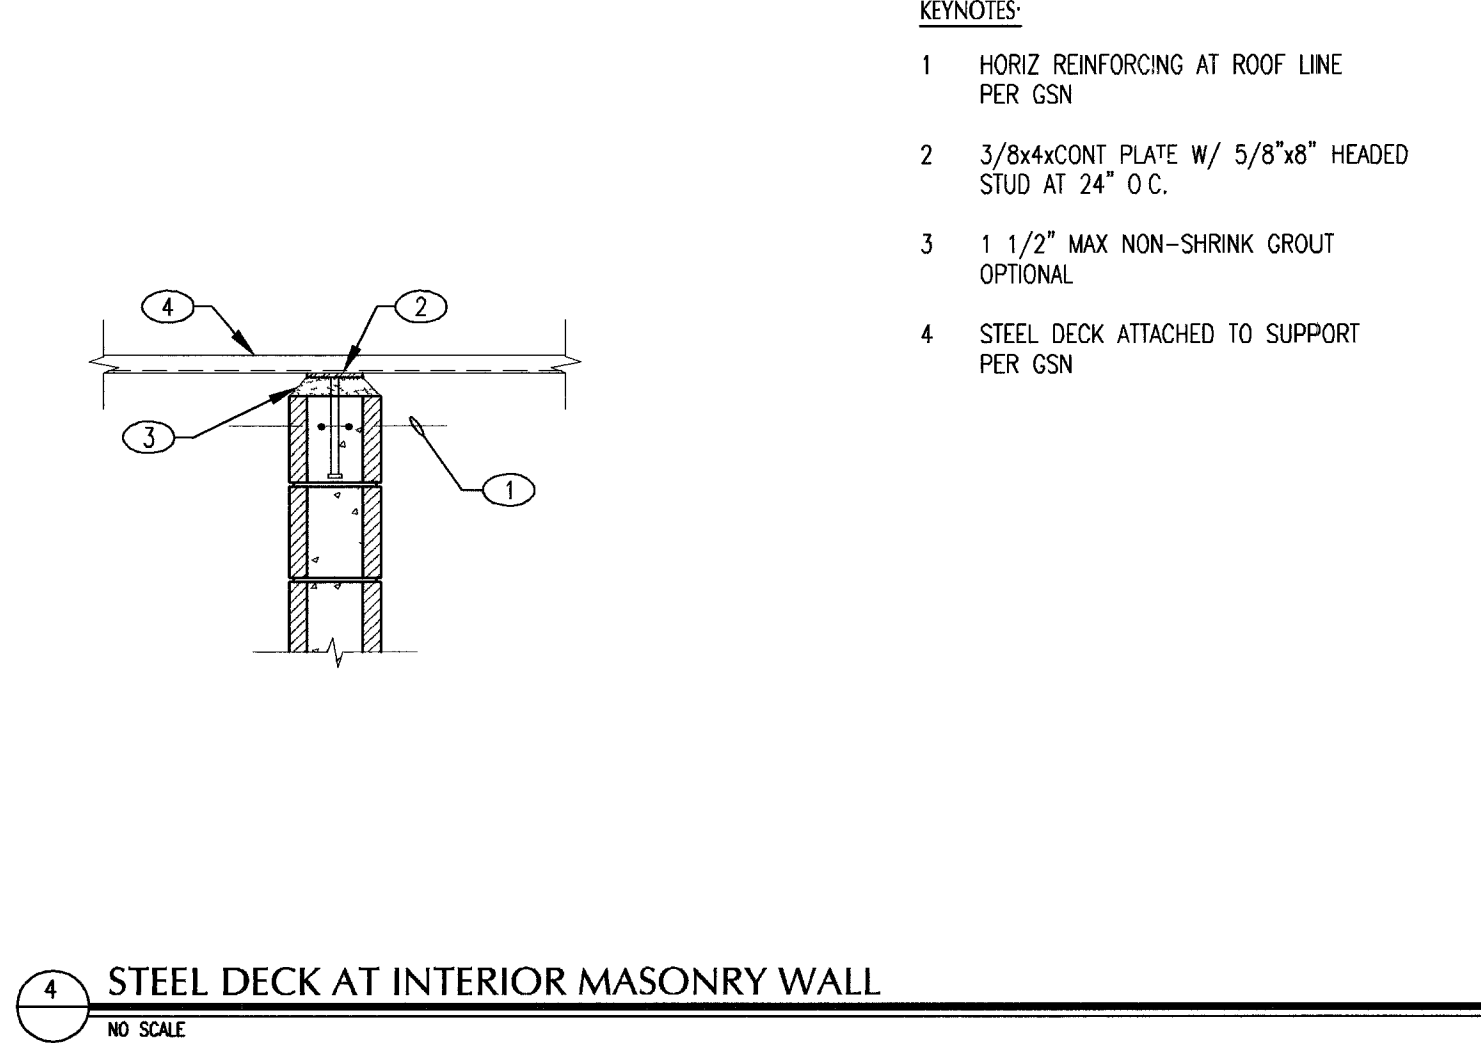
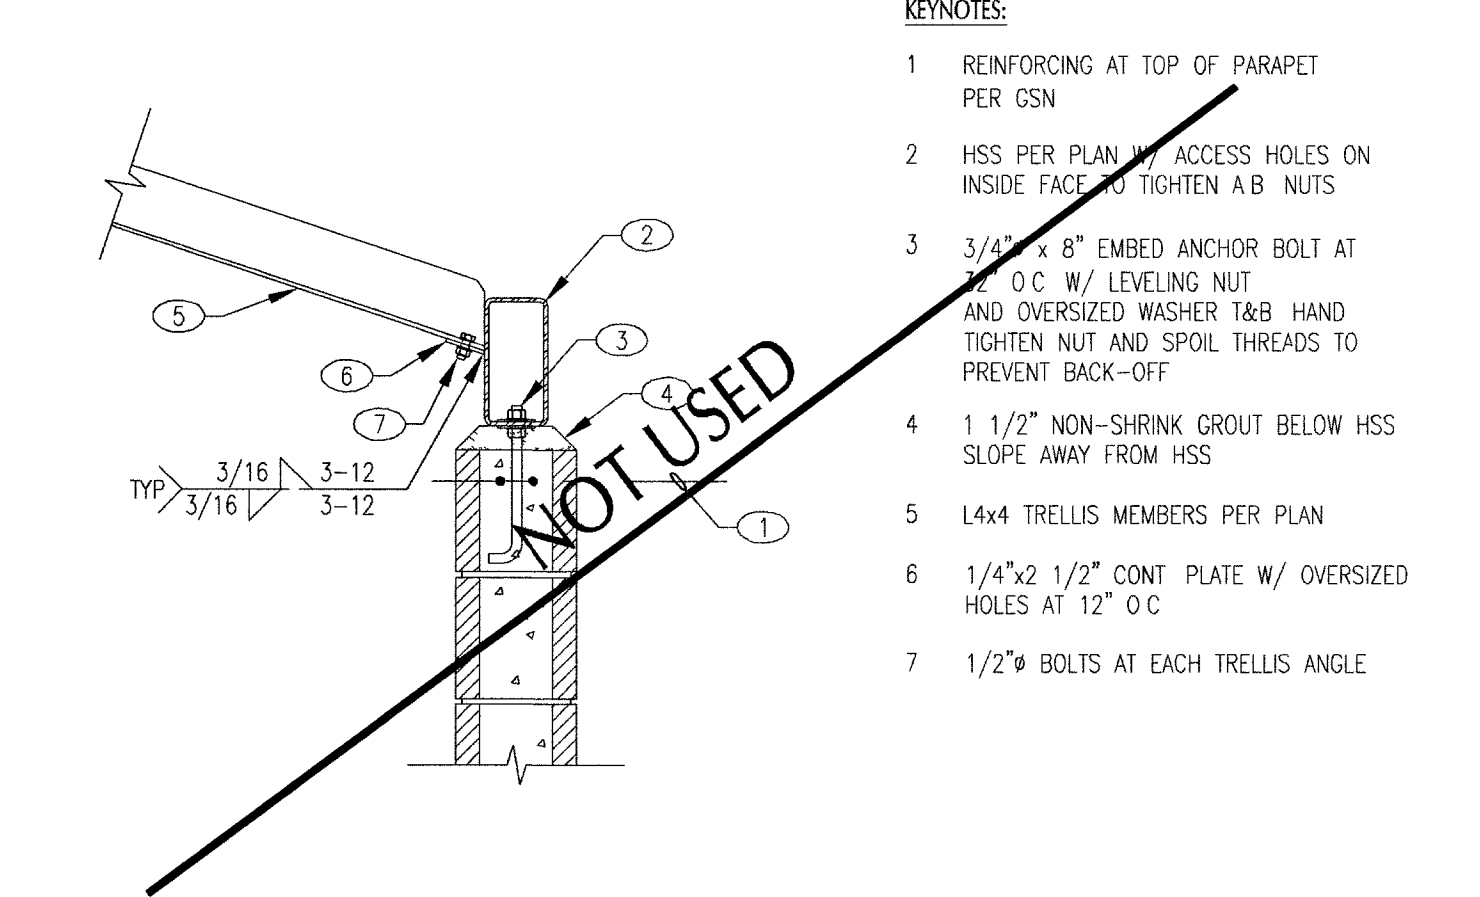


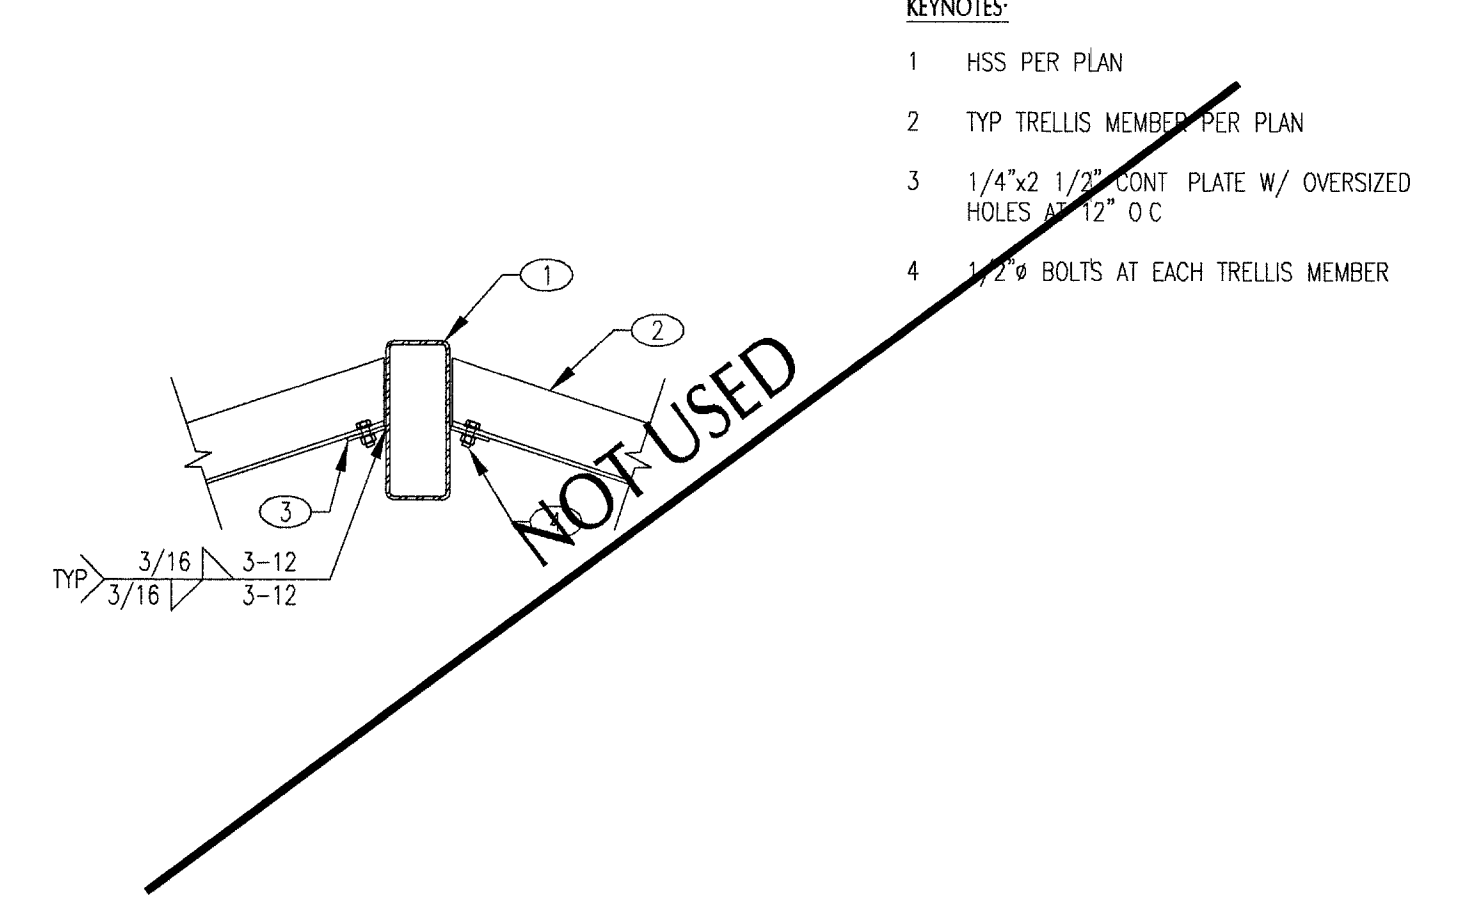

REVISIONS

STRUCT-ARCH COORDINATION 12/21/04

CONSULTANT

6380 S. VALLEY VIEW, STE. 406
LAS VEGAS, NEVADA 89118
Phone: (702) 616-5107
Fax: (702) 616-5125

STRUCTURAL SOLUTIONS

THESE PLANS, DRAWINGS AND DESIGNS ARE THE EXCLUSIVE PROPERTY OF ENGINEERING STRUCTURAL SOLUTIONS, ALL SHALL BE THE PROPERTY OF ENGINEERING STRUCTURAL SOLUTIONS. NO PART OF THESE PLANS, DRAWINGS AND DESIGNS SHALL BE REPRODUCED OR TRANSMITTED IN ANY FORM OR BY ANY MEANS, ELECTRONIC OR MECHANICAL, INCLUDING PHOTOCOPYING, RECORDING, OR BY ANY INFORMATION STORAGE AND RETRIEVAL SYSTEM, WITHOUT THE WRITTEN PERMISSION OF ENGINEERING STRUCTURAL SOLUTIONS.

JOB NUMBER: LV03191

CITY OF LAS VEGAS, NV
FIRE STATION #8
805 N. MOJAVE RD. LAS VEGAS, NV 89101

ROOF FRAMING DETAILS

STAMP

REGISTERED PROFESSIONAL ENGINEER-STATE OF NEVADA
Exp. 12/31/11
JDB

OWNER: CITY OF LAS VEGAS
DEPARTMENT OF PUBLIC WORKS
ARCHITECTURAL SERVICES

400 EAST STEWART AVENUE
LAS VEGAS, NEVADA 89103
PHONE: (702) 229-6535
FAX: (702) 386-2232
TDD: (702) 386-9106

DRAWN: JDB
FILE: LV03191
DATE: 4/3/04
SCALE: 3/4"=1'-0"
BID NO: .
CLV DWG NO: .
SHT NO: 077
S4.1