




- ① 12"x8"x16" SOLID GROUTED CMU WALL, PRIMED & PAINTED AT ALL EXPOSED SURFACES, PAINTED BF-4.
- ② DASHED LINE INDICATES LOCATION OF FRAMED ENTRY WALL ALONG GRIDLINE 10. NOC. 1 - 9/29/04
- ③ PROFILE OF MASONRY WALL ALONG GRIDLINE 3.3. 12" WIDE CONCRETE BOND BEAM CONNECTS TO THIS MASONRY WALL, SEE STRUCTURAL DWGS.
- ④ LINE OF CONCRETE WALKWAY, SEE CIVIL DRAWINGS.
- ⑤ BUTT JOINT AT GLASS, SEE DTL. 10/AT.
- ⑥ INSULATED GLASS, PER SPEC'S.

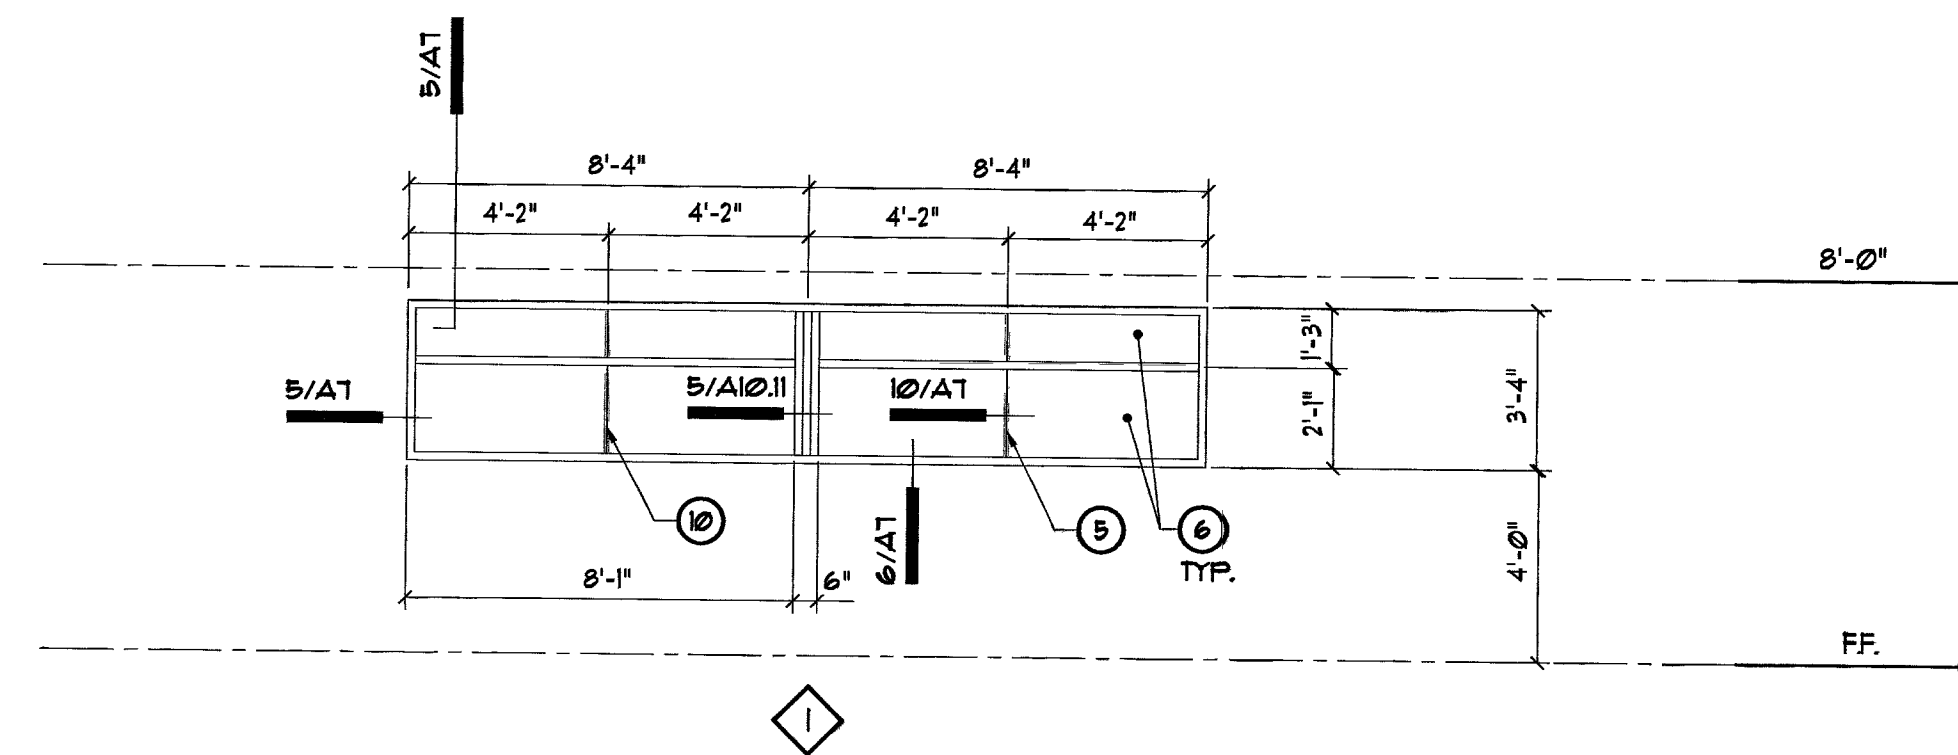

1/2" = 1'-0"

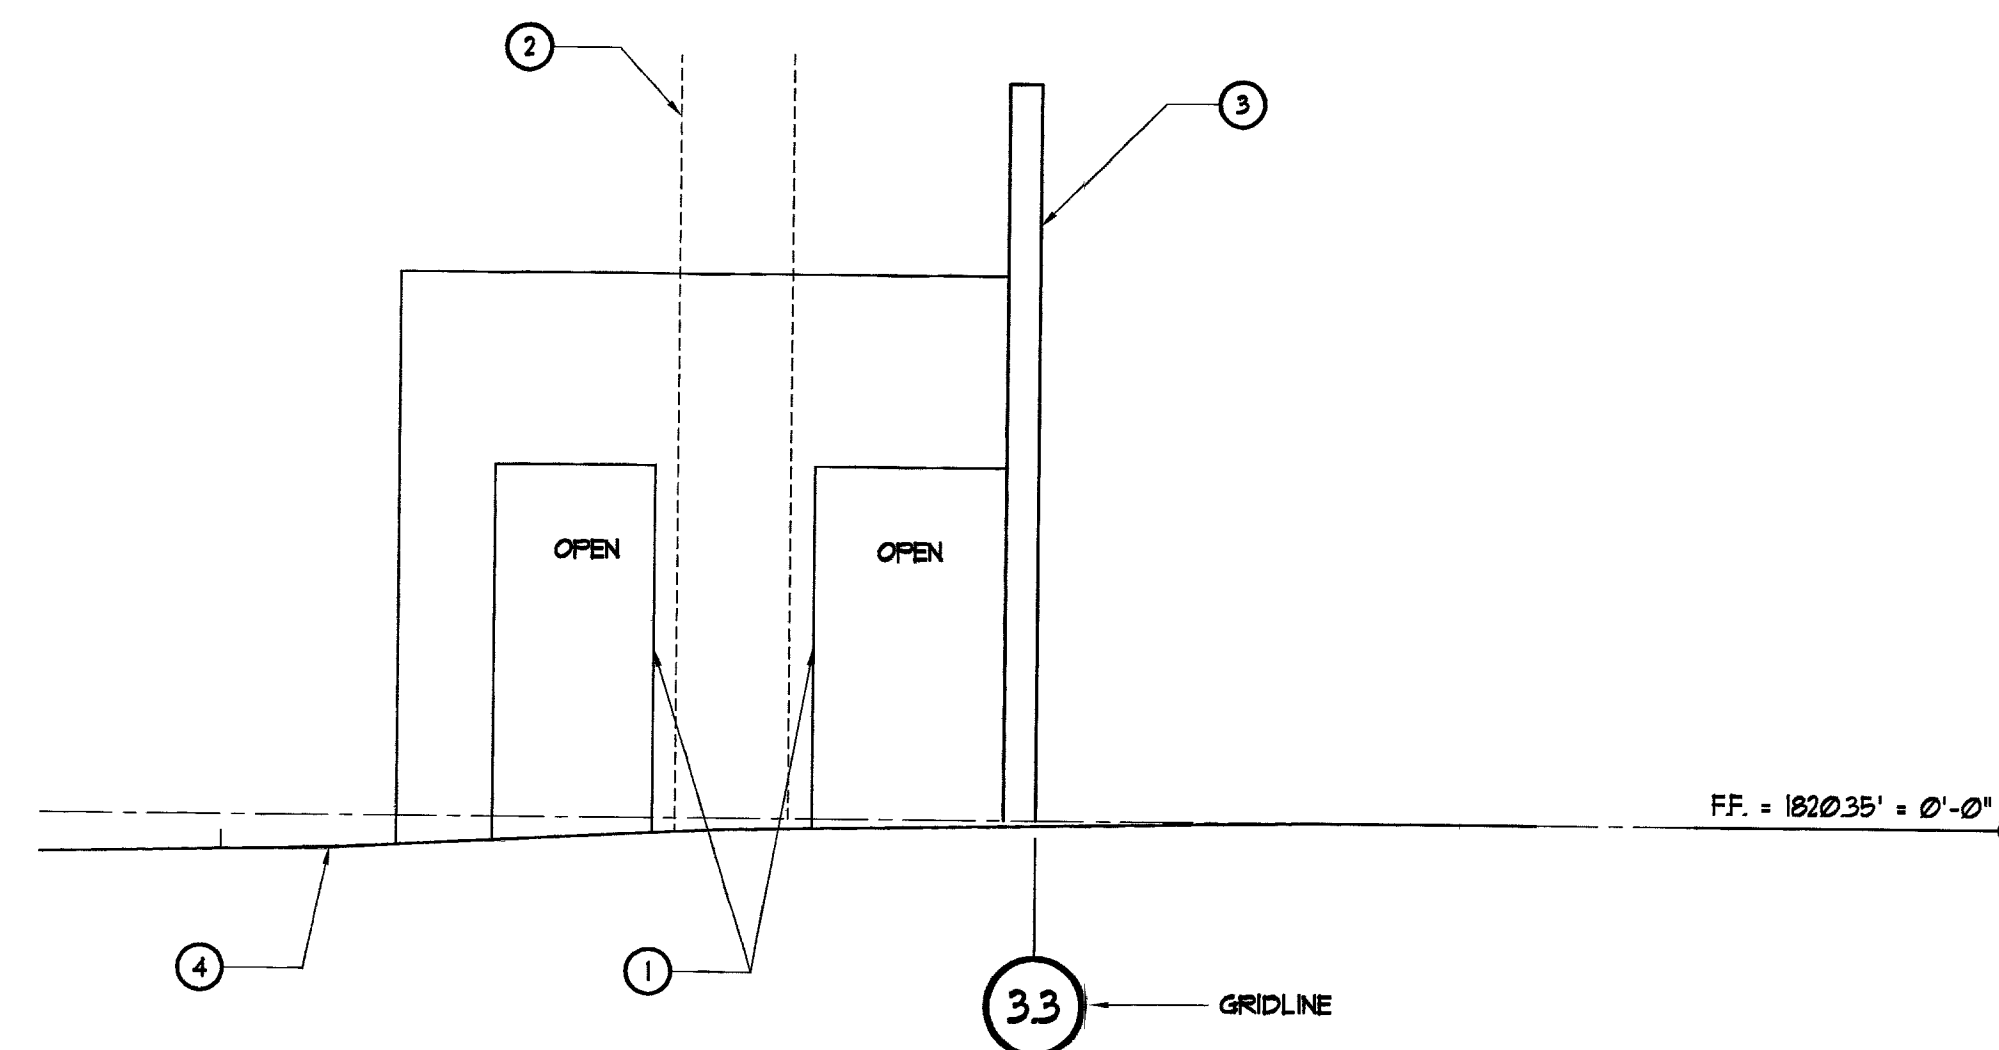

1/2" x 1'-0"

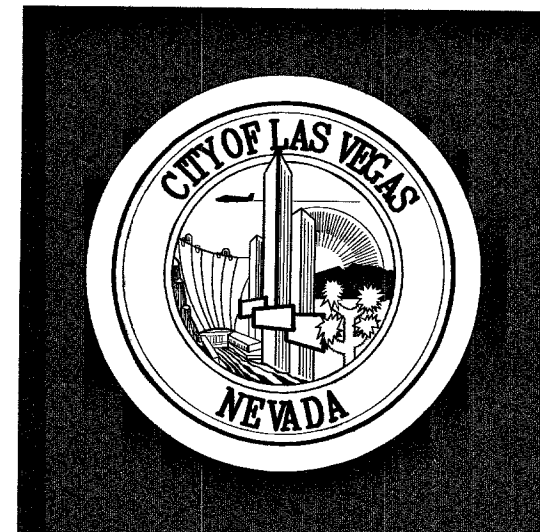[illegible]

CONSULTANT			
------------	--	--	--

CITY OF LAS VEGAS, NEVADA
FIRE STATION #8

Window Schedule & Wall Elevation

STAN-

OWNER: CITY OF LAS VEGAS
DEPARTMENT OF PUBLIC WORKS
ARCHITECTURAL SERVICES

ARCHITECT OF RECORD
SAMUEL D. TOLMAN, AIA, NCARB
400 EAST STEWART AVENUE
LAS VEGAS, NEVADA 89101
PHONE: (702) 229-6535
FAX: (702) 382-3232
TDD: (702) 386-9108

DRAWN	EPG		
FILE	Pa8-A61		
DATE	4/1/04		
SCALE	As Noted		
BID NO	041534104		
CLV DWG NO	630-101		
	047		
SHT NO			

A6.1

DRAWINGS AS INSTRUMENTS OF SERVICE ARE THE PROPERTY OF THE DESIGN PROFESSIONAL WHOSE STAMP OF CERTIFICATION APPEARS ON THE DRAWINGS AND SPECIFICATIONS. NO USE OR REPRODUCTION IN WHOLE OR IN PART WITHOUT WRITTEN CONSENT IS STRICTLY PROHIBITED. COPIES OF THE DRAWINGS AND SPECIFICATIONS RETAINED BY THE CLIENT MAY BE UTILIZED ONLY FOR OCCUPANCY OF THE PROJECT FOR WHICH THEY WERE PREPARED AND NOT FOR THE CONSTRUCTION OF ANY OTHER PROJECT. IN A ALL RIGHTS RESERVED.