



REVISIONS  
BLDG DEPT - 5/21/04


CONSULTANT

CITY OF LAS VEGAS, NEVADA

FIRE STATION #8

Enlarged Wall  
Sections

11 JUN 04

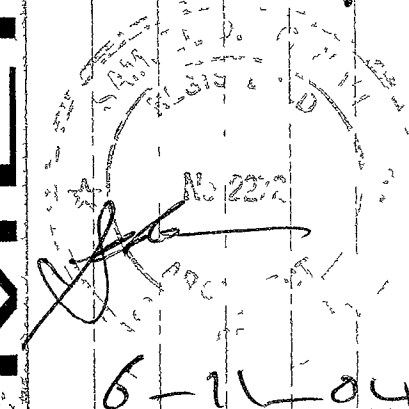


OWNER: CITY OF LAS VEGAS  
DEPARTMENT OF PUBLIC WORKS  
ARCHITECTURAL SERVICES


400 EAST STEWART AVENUE  
LAS VEGAS, NEVADA 89103  
PHONE: (702) 229-6535  
FAX: (702) 382-3232  
TDD: (702) 386-9108

DRAWN: EPS  
FILE: 748-AS-2  
DATE: 6/8/04  
SCALE: 1/2" = 1'-0"  
BID NO: 041534104  
CLV DWG NO: 630-101  
SHT NO:


A9.2

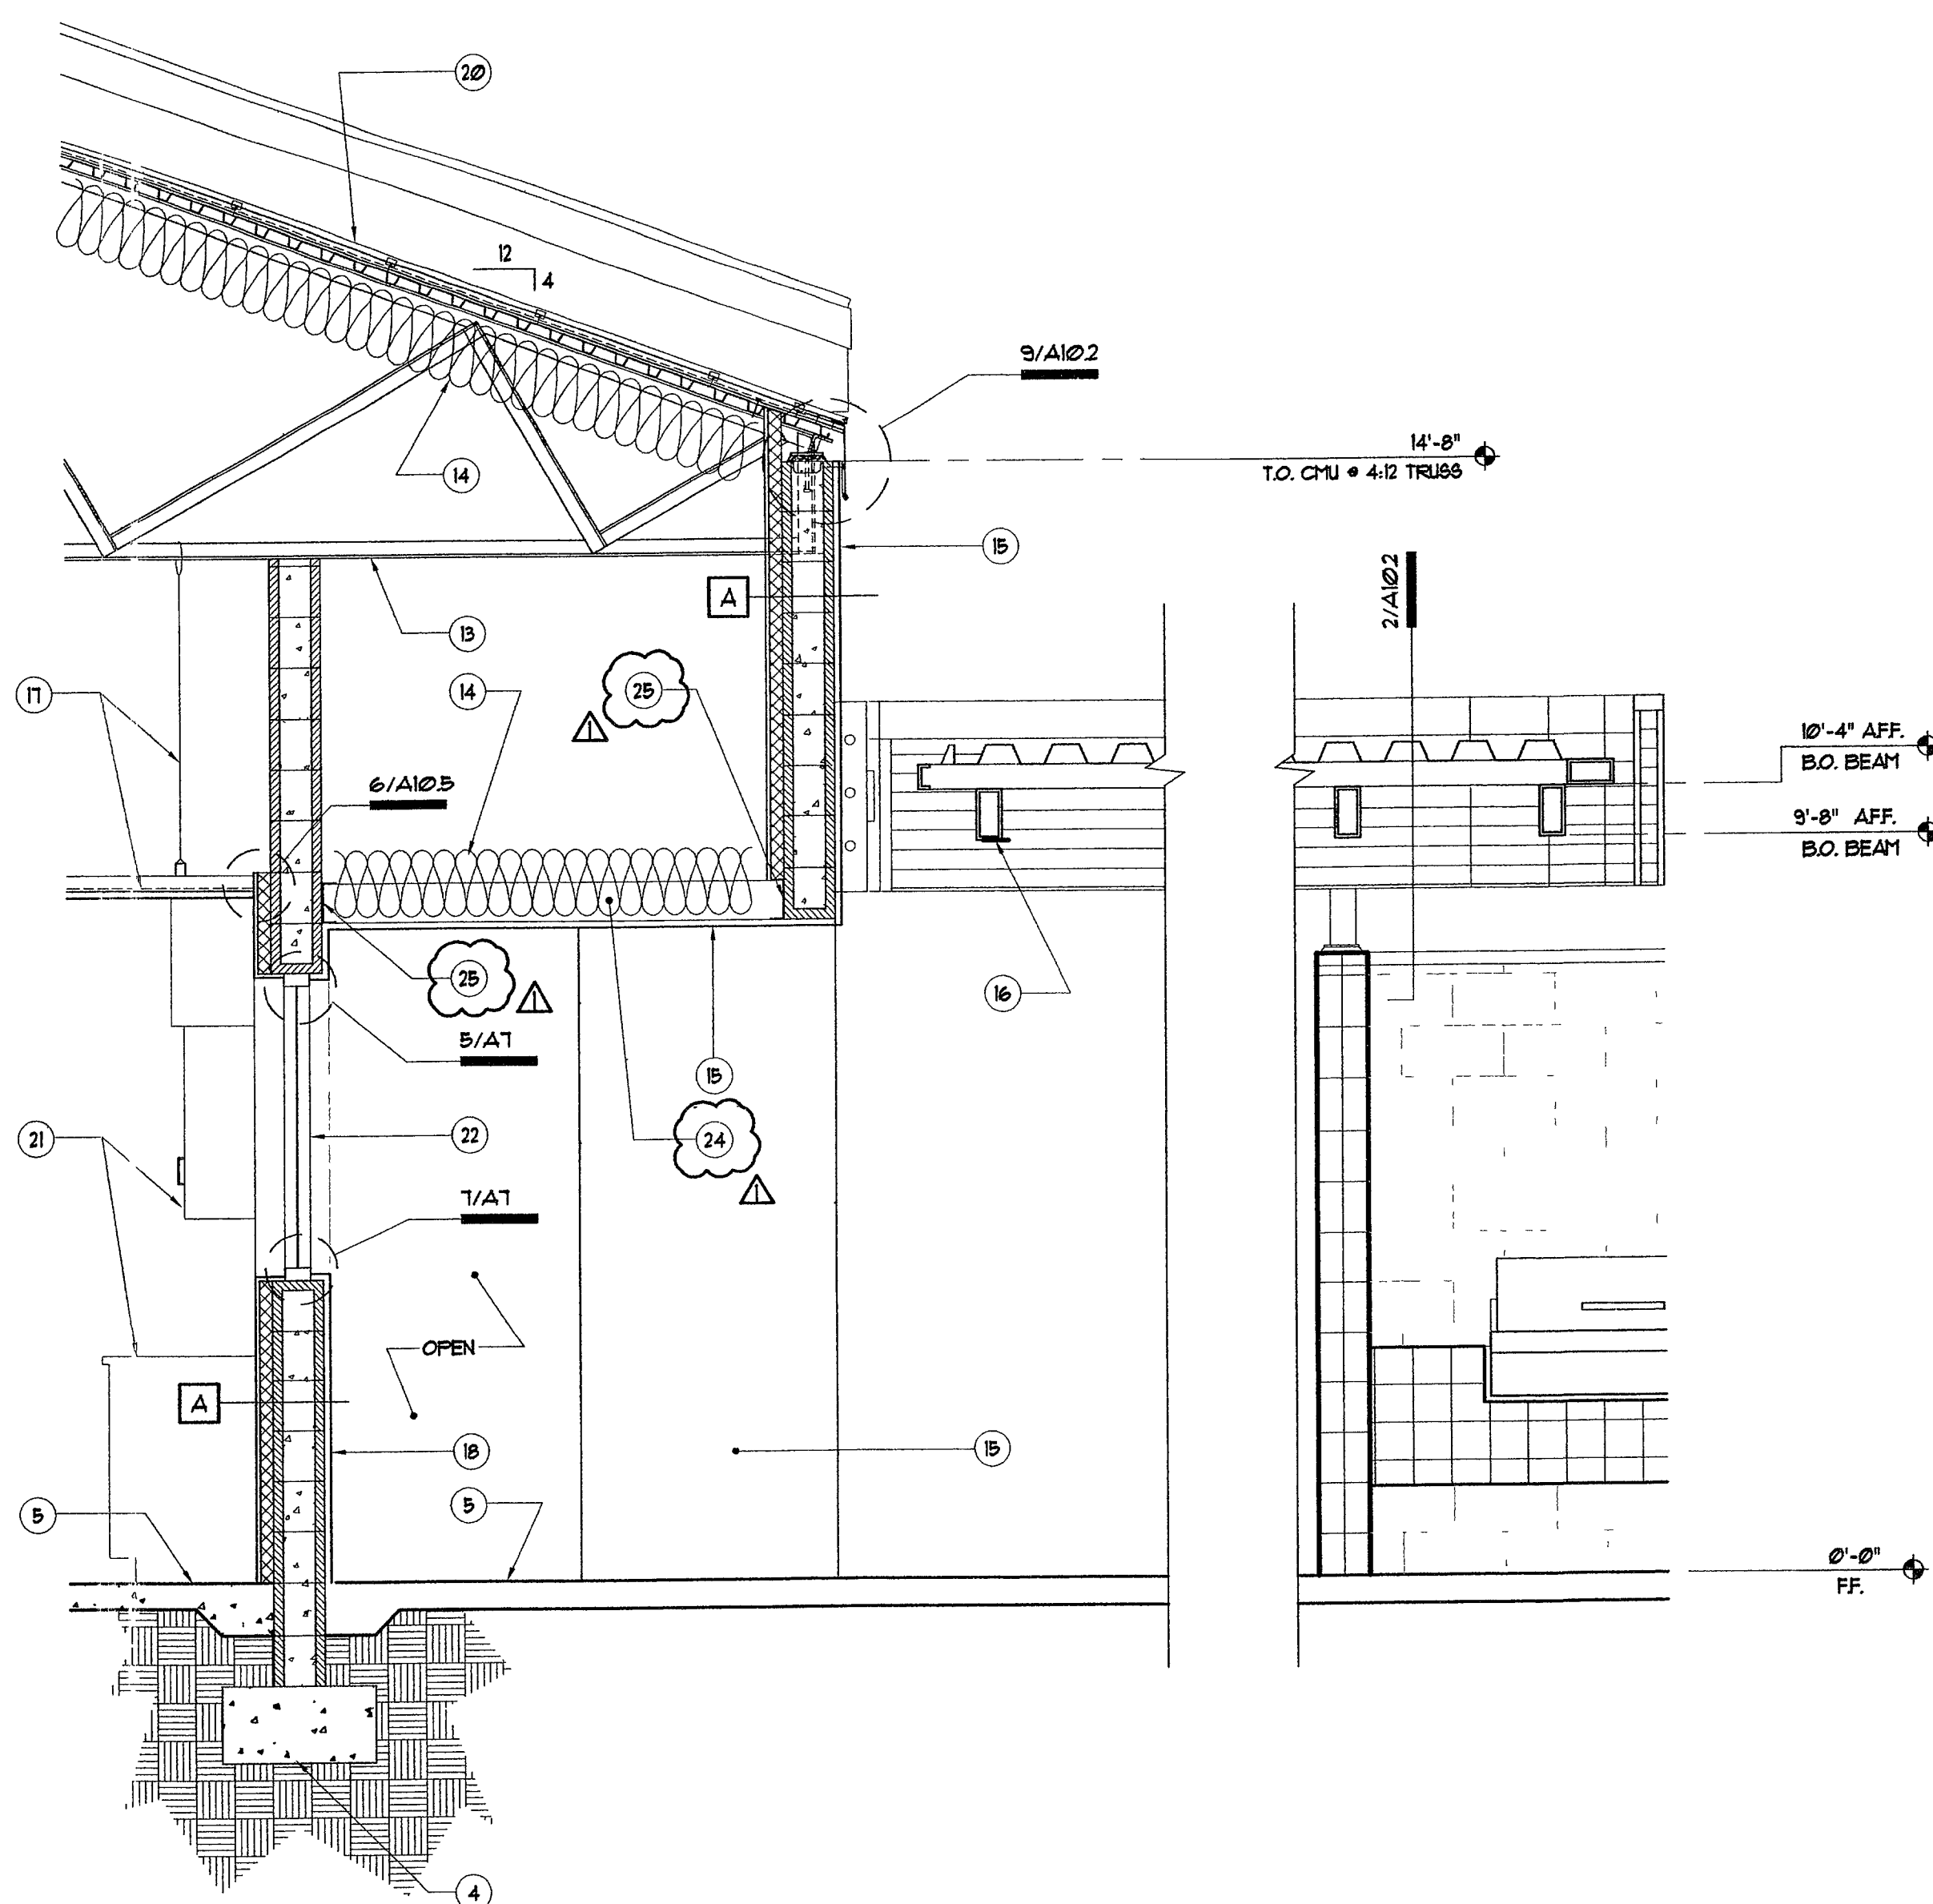

1 Wall Section  
Scale: 1/2"=1'-0"

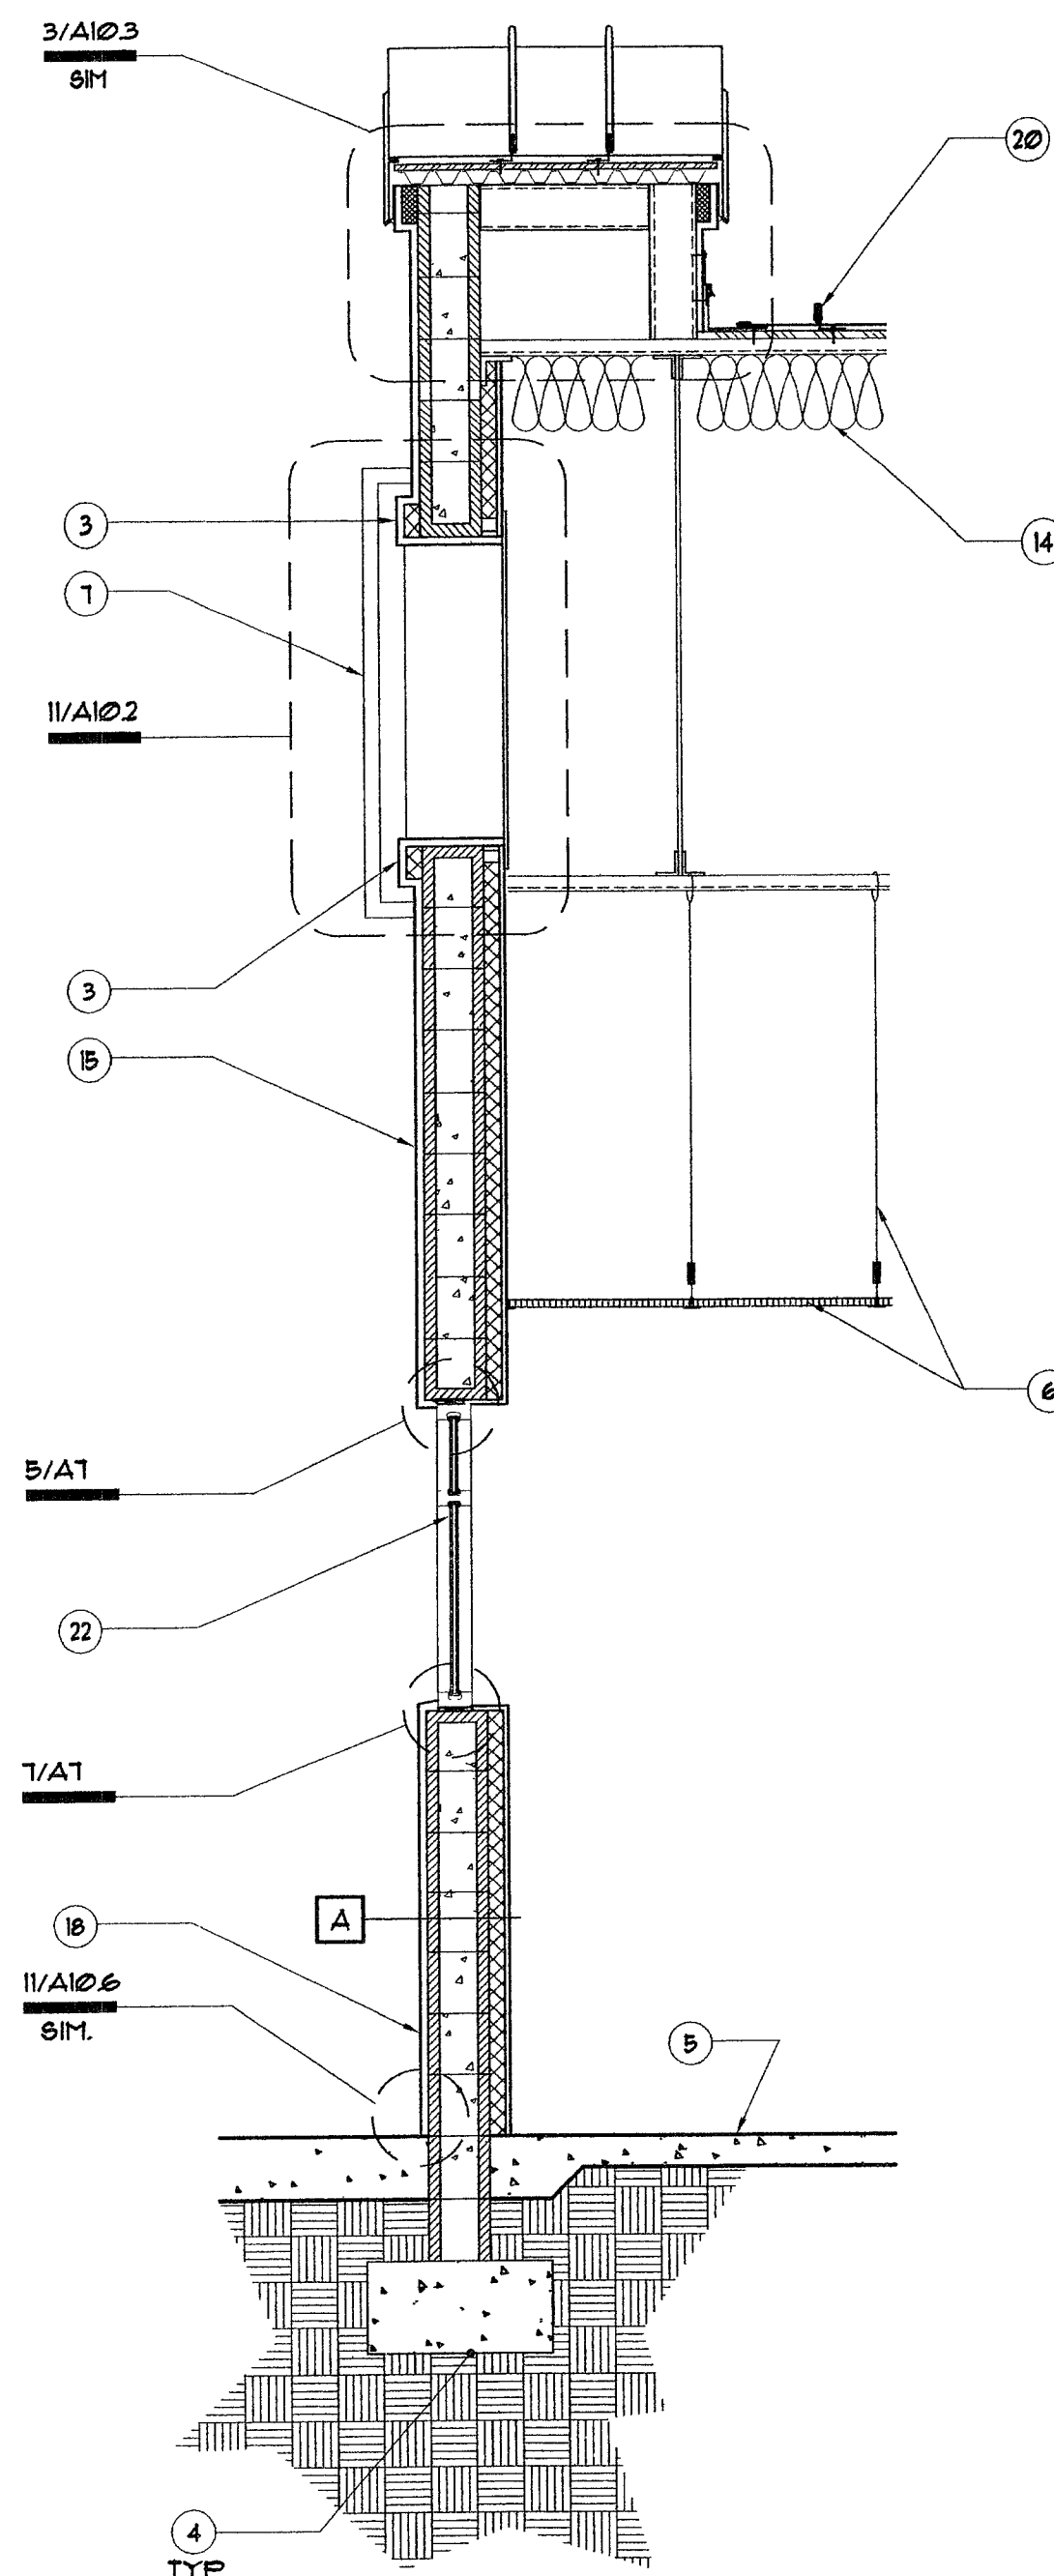

2 Wall Section  
Scale: 1/2"=1'-0"

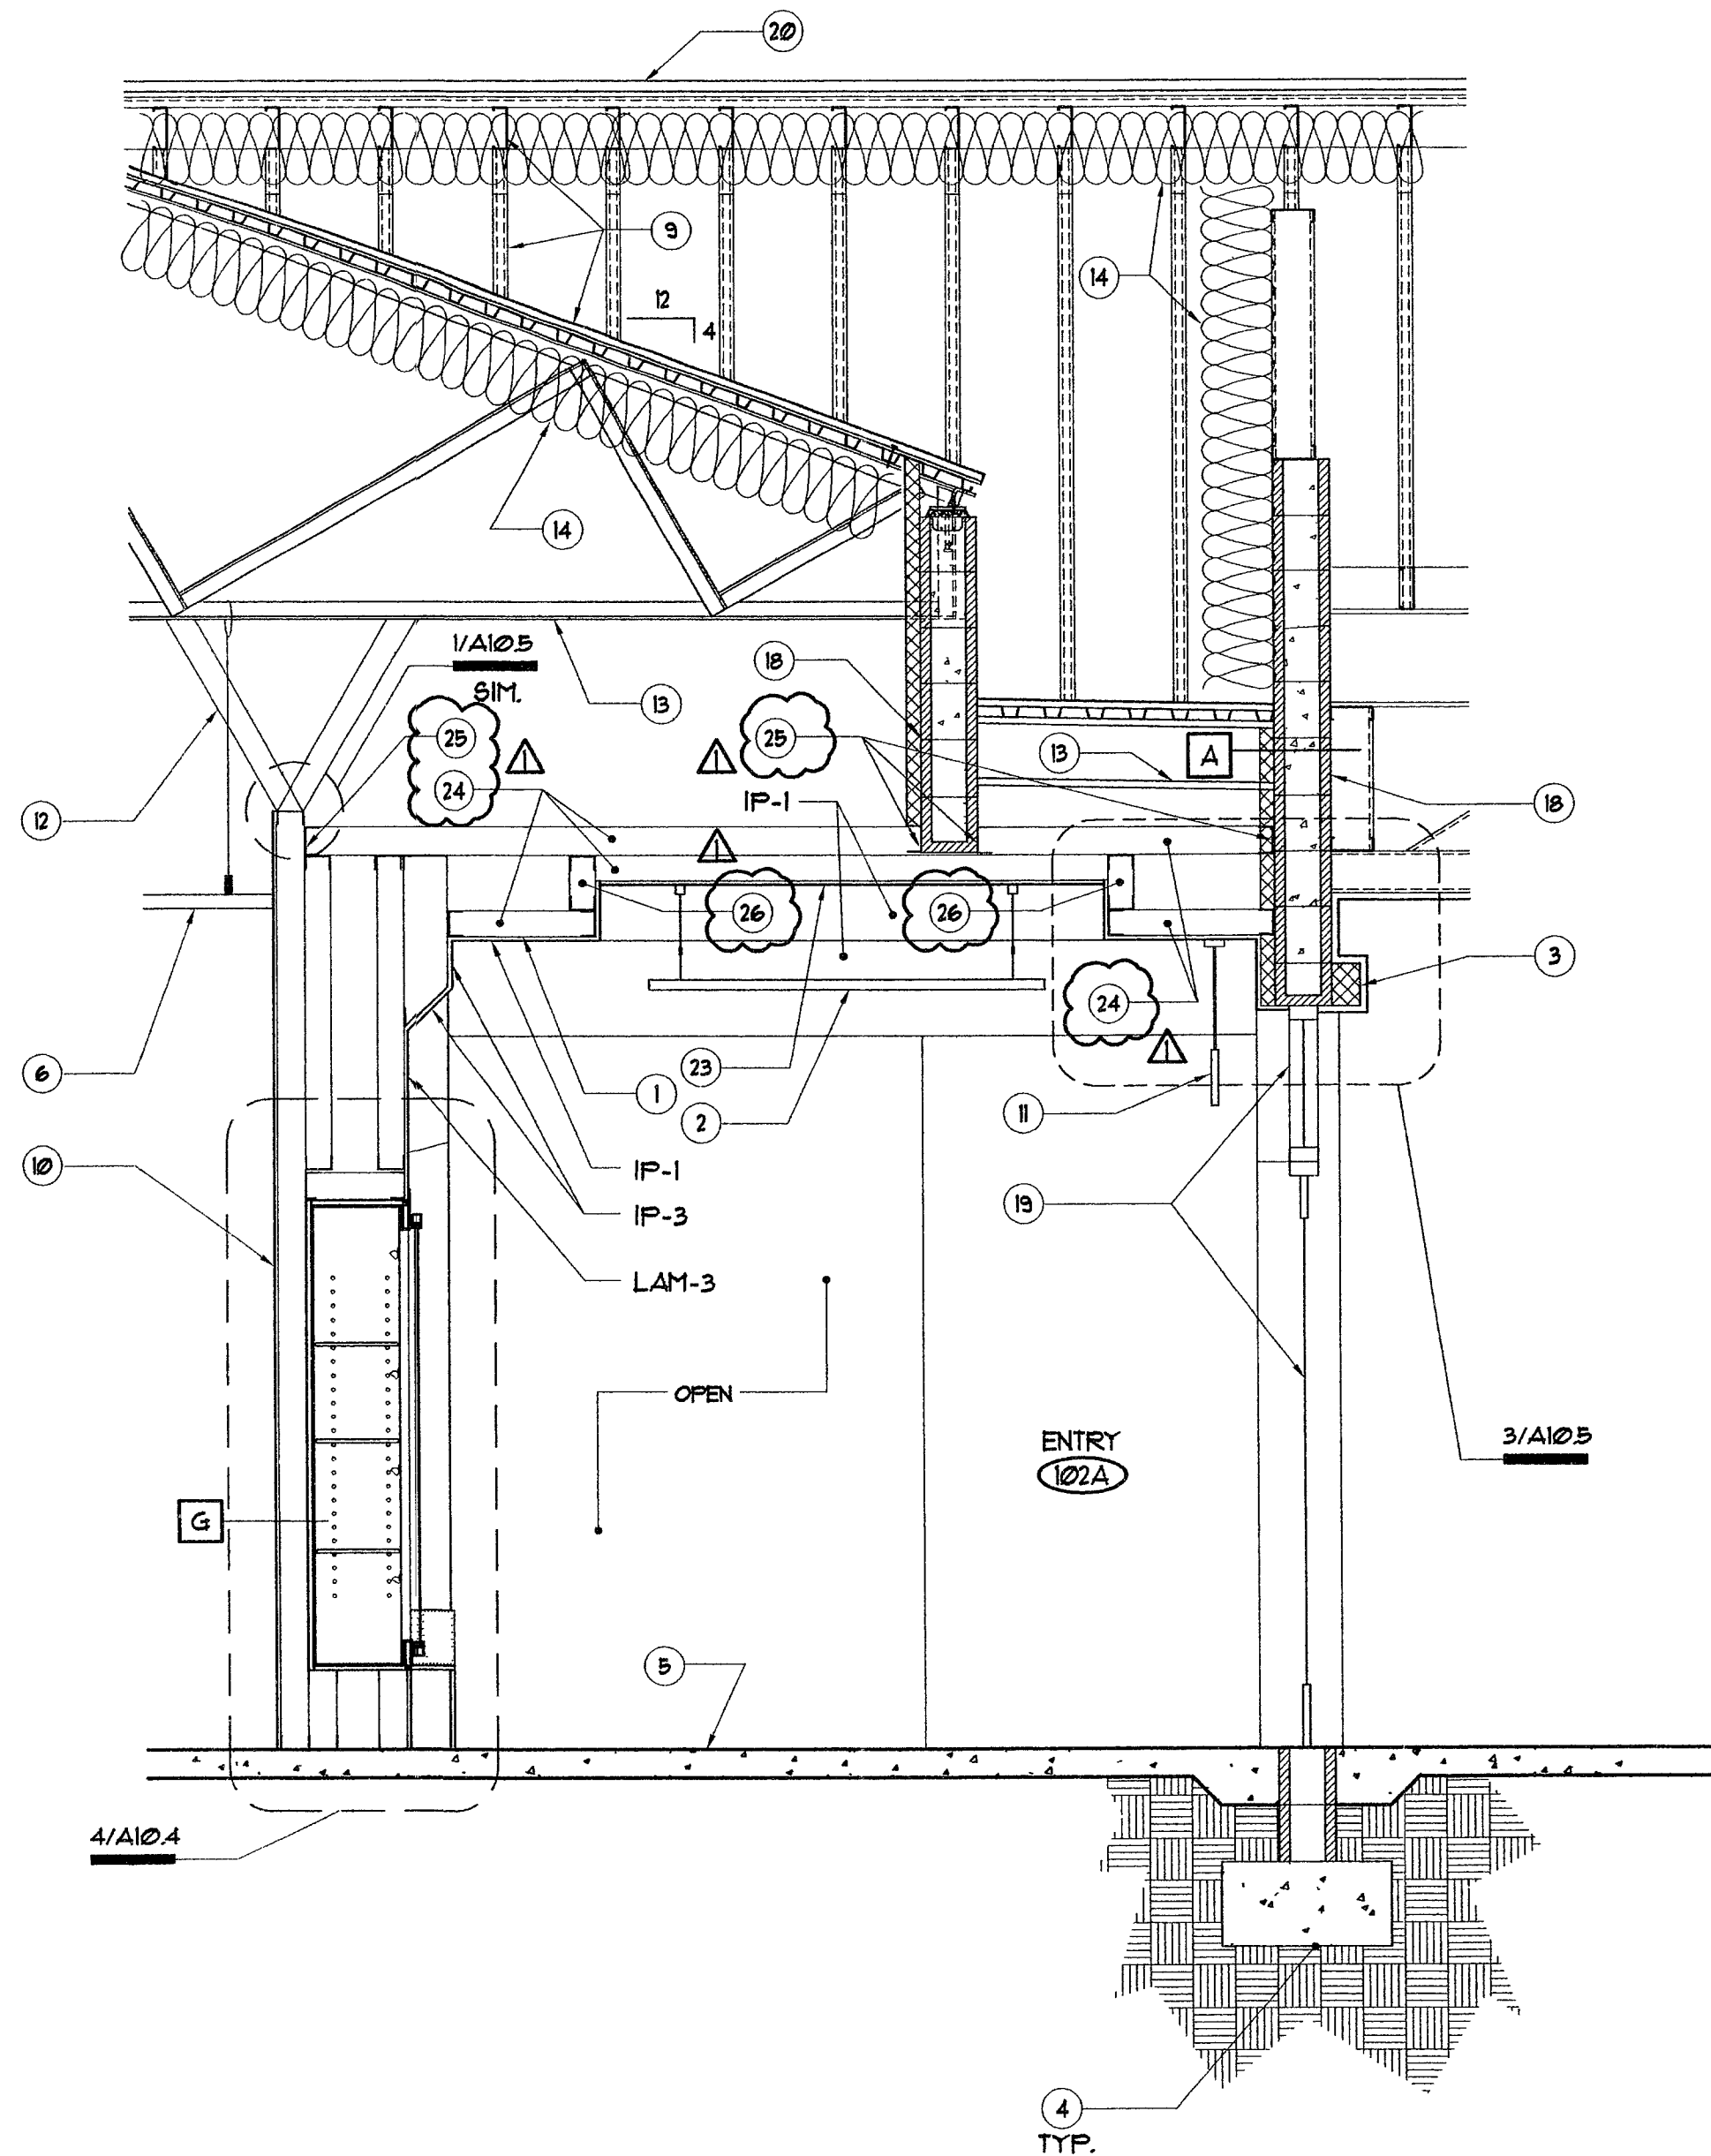

3 Wall Section  
Scale: 1/2"=1'-0"

## Keynotes

- 1 METAL FRAMED SOFFIT W/ PAINTED GYP BOARD FINISH - SEE DETAILS
- 2 INTERIOR LIGHT FIXTURE - SEE ELECTRICAL DWGS
- 3 EPS FOAM POPOUT WITH STUCCO FINISH
- 4 WALL FOOTING, SEE STRUCTURAL DRAWINGS
- 5 REINFORCED CONCRETE SLAB, SEE STRUCTURAL DRAWINGS
- 6 ACOUSTICAL TILE CEILING & SUSPENSION WIRES, SEE REF. CLG. PLAN & SPEC'S
- 7 GABLE VENT & TUBE STELL DECORATIVE BAR, SEE DETAIL 1/A102
- 8 18 GA. GALVANIZED METAL STUDS @ 24" O.C. (SOFFIT FRAMING)
- 9 METAL FRAMING OVERBUILD PER STRUCTURAL
- 10 INTERIOR WALL ASSEMBLY - SEE SHEETS A11 & G2

## Keynotes

- 11 EXIT SIGN - SEE ELECTRICAL DRAWINGS
- 12 DIAGONAL BRACING AS REQUIRED
- 13 PREFABRICATED ROOF TRUSS OR JOIST, SEE SEE STRUCTURAL DWGS
- 14 R-30 BATT. ROOF INSULATION
- 15 LIGHT SAND STUCCO FINISH - SEE EXTERIOR FINISH LEGEND & SPECIFICATIONS
- 16 METAL CANOPY, PAINTED, SEE FINISH LEGEND & DETAIL 2/A102
- 17 5/8" TYPE "X" GYP. BD. SUSPENDED CEILING, PAINTED, SEE DTL. 6/A103
- 18 EXTERIOR WALL ASSEMBLY, SEE SHEET G2, A11 & A12
- 19 EXTERIOR ENTRANCE DOOR W/ TRANSOM WINDOW, SEE DOOR SCHEDULE
- 20 STANDING BEAM METAL ROOFING O/ 30" FELT O/ WOOD SHEATHING, SEE ROOF PLAN

## Keynotes

- 21 CASEWORK, SEE INTERIOR ELEVATIONS
- 22 EXTERIOR WINDOW, SEE WINDOW SCHEDULE
- 23 LAM-3 FINISH O/ 1/2" PLYWOOD O/ METAL STUD FRAMING, SEE REFLECTED CEILING PLAN
- 24 3508025-43 JOISTS AT 24" O.C. W/ (2) #8 SCREWS EA. END FROM LEDGE TRACK TO JOIST. BLOCK AT MIDSPAN
- 25 3508025-43 TRACK LEDGER W/ 1-1/2" DIA. X 6" EMBED ANCHOR BOLT AT 24" O.C.
- 26 3508025-43 STUDS AT 24" O.C. W/ 43 MIL TOP AND BOTTOM TRACK W/ (2) #8 SCREWS AT MEMBER ENDS

## General Notes:

1. ALL EXTERIOR METAL TO BE POWDER COATED PER FINISH SCHEDULE.
2. SEE FINISH SCHEDULE FOR COLORS OF ALL FINISHES KEYNOTED ON ELEVATIONS.

PLANS APPROVED  
ARCHITECTURAL  
Building & Safety Dept.  
City of Las Vegas, Nevada

MUN JUN 17 2004

Does Not Include Structural, Electrical,  
Plumbing/Mechanical or Off-Site  
Improvements Unless No Change  
Without Approval Plan Is  
Not a Permit to Violate Any Ordinance

RECEIVED

JUN 11 2004

CITY OF LAS VEGAS  
BUILDING DEPT.