


30 0 30 60
SCALE FEET

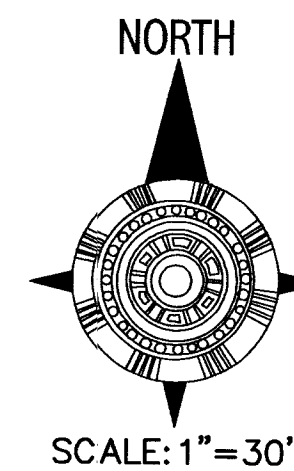

CONSTRUCTION NOTES

- 1 RELOCATE STREETLIGHT PER USD NO. 314 WITH 8' MAST ARM AND 250W HPS LUMINAIRE. (SEE SHEET C-17)
- 2 INSTALL 1 1/4" STREETLIGHT CONDUIT WITH 2-#4, 1-#8 GRND THW.
- 3 INSTALL "STOP HERE ON RED" SIGN (R10-6 24"x36").
- 4 INSTALL 24" STOP BAR.
- 5 SIGN POST INSTALLATION PER USD NO. 249. (SEE SHEET C-17)
- 6 INSTALL NO. 3-1/2 PULLBOX PER USD NO. 326 (SEE SHEET C-18). COVER TO BE NON-METALIC, TRAFFIC BEARING RATE. MAINTAIN 6" MINIMUM CONCRETE AROUND PULLBOX.
- 7 INTERCEPT AND CONNECT TO EXISTING STREETLIGHT CONDUIT. REPULL CONDUCTORS FROM STREETLIGHT TO STREETLIGHT.
- 8 INSTALL 4" WHITE STRIPES @ 45 DEG. ANGLE 3' ON CENTER.
- 9 INSTALL BLUE HANDICAP PARKING SYMBOL.
- 10 INSTALL 4" WHITE PARKING STRIPE.
- 11 REMOVE AND RETURN STREET LIGHT POLE TO CITY OF LAS VEGAS YARDS AT 3104 E. BONANZA ROAD. CALL 24 HOURS BEFORE RETURNING AT 229-6331.
- 12 INSTALL EMERGENCY FLASHER AS INDICATED ON SHEET C-10.
- 13 RELOCATE "NO LOITERING" SIGN.
- 14 REMOVE "NO LOITERING" SIGN.
- 15 REMOVE AND RELOCATE "NO LOITERING" SIGN 1' NORTH FROM BACK OF SIDEWALK.
- 16 RELOCATE SIGN (W11-2).
- 17 EXISTING CONDUIT TO PROTECT IN PLACE.
- 18 REMOVE EXISTING FOUNDATION 18" BELOW FG.
- 19 REMOVE AND REPLACE CONCRETE SIDEWALK PANEL PER USD NO. 234, AS REQUIRED, FOR REMOVAL AND INSTALLATION OF STREETLIGHTS AND PULLBOXES.

PROJ NO: A203157
DESIGN: LG/RAS
DATE: 05/28/04
SCALE: AS SHOWN
CADFILE: FS08_09

STAMP DATE: 7/9/04
EXP. DATE: 06/30/06

3320 N. Buffalo Drive
Suite 106
Las Vegas, NV 89129-7410
Tel: 702-396-3426
Fax: 702-396-3708
Web: aztec.us

Call before you Dig.
1-800-227-2600
UNDERGROUND SERVICE (USA)


Call before you Dig.
1-702-593-6111

BENCHMARK

CITY OF LAS VEGAS VERTICAL CONTROL #2LV01
2554 RIVET AND PLATE IN THE TOP OF CURB AT
THE NORTHEAST CORNER OF BONANZA ROAD AND
MOJAVE ROAD.
ELEVATION 1812.97 FEET NAVD88
552.594 METERS NAVD88


BASIS OF BEARING

THE NORTH LINE OF THE SOUTHWEST QUARTER
(SE1/4) OF THE SOUTHWEST QUARTER (SW1/4)
OF SECTION 25, TOWNSHIP 20 SOUTH, RANGE 61
EAST, M.D.M., CLARK COUNTY, NEVADA, BEARS
SOUTH 88°52'45" EAST AS SHOWN ON THE
RECORD OF SURVEY, RECORDED IN THE FILE 82,
PAGE 99 OF SURVEYS, CLARK COUNTY RECORDS.

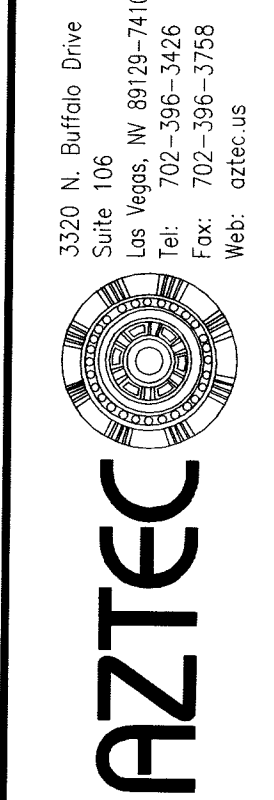

CITY OF LAS VEGAS
FIRE STATION NO. 8
TRAFFIC SIGNAGE, STRIPING & STREETLIGHTING
MOJAVE ROAD

SHEET
C-9
9 OF 24 SHEETS
CLV PRJ. #
630-101

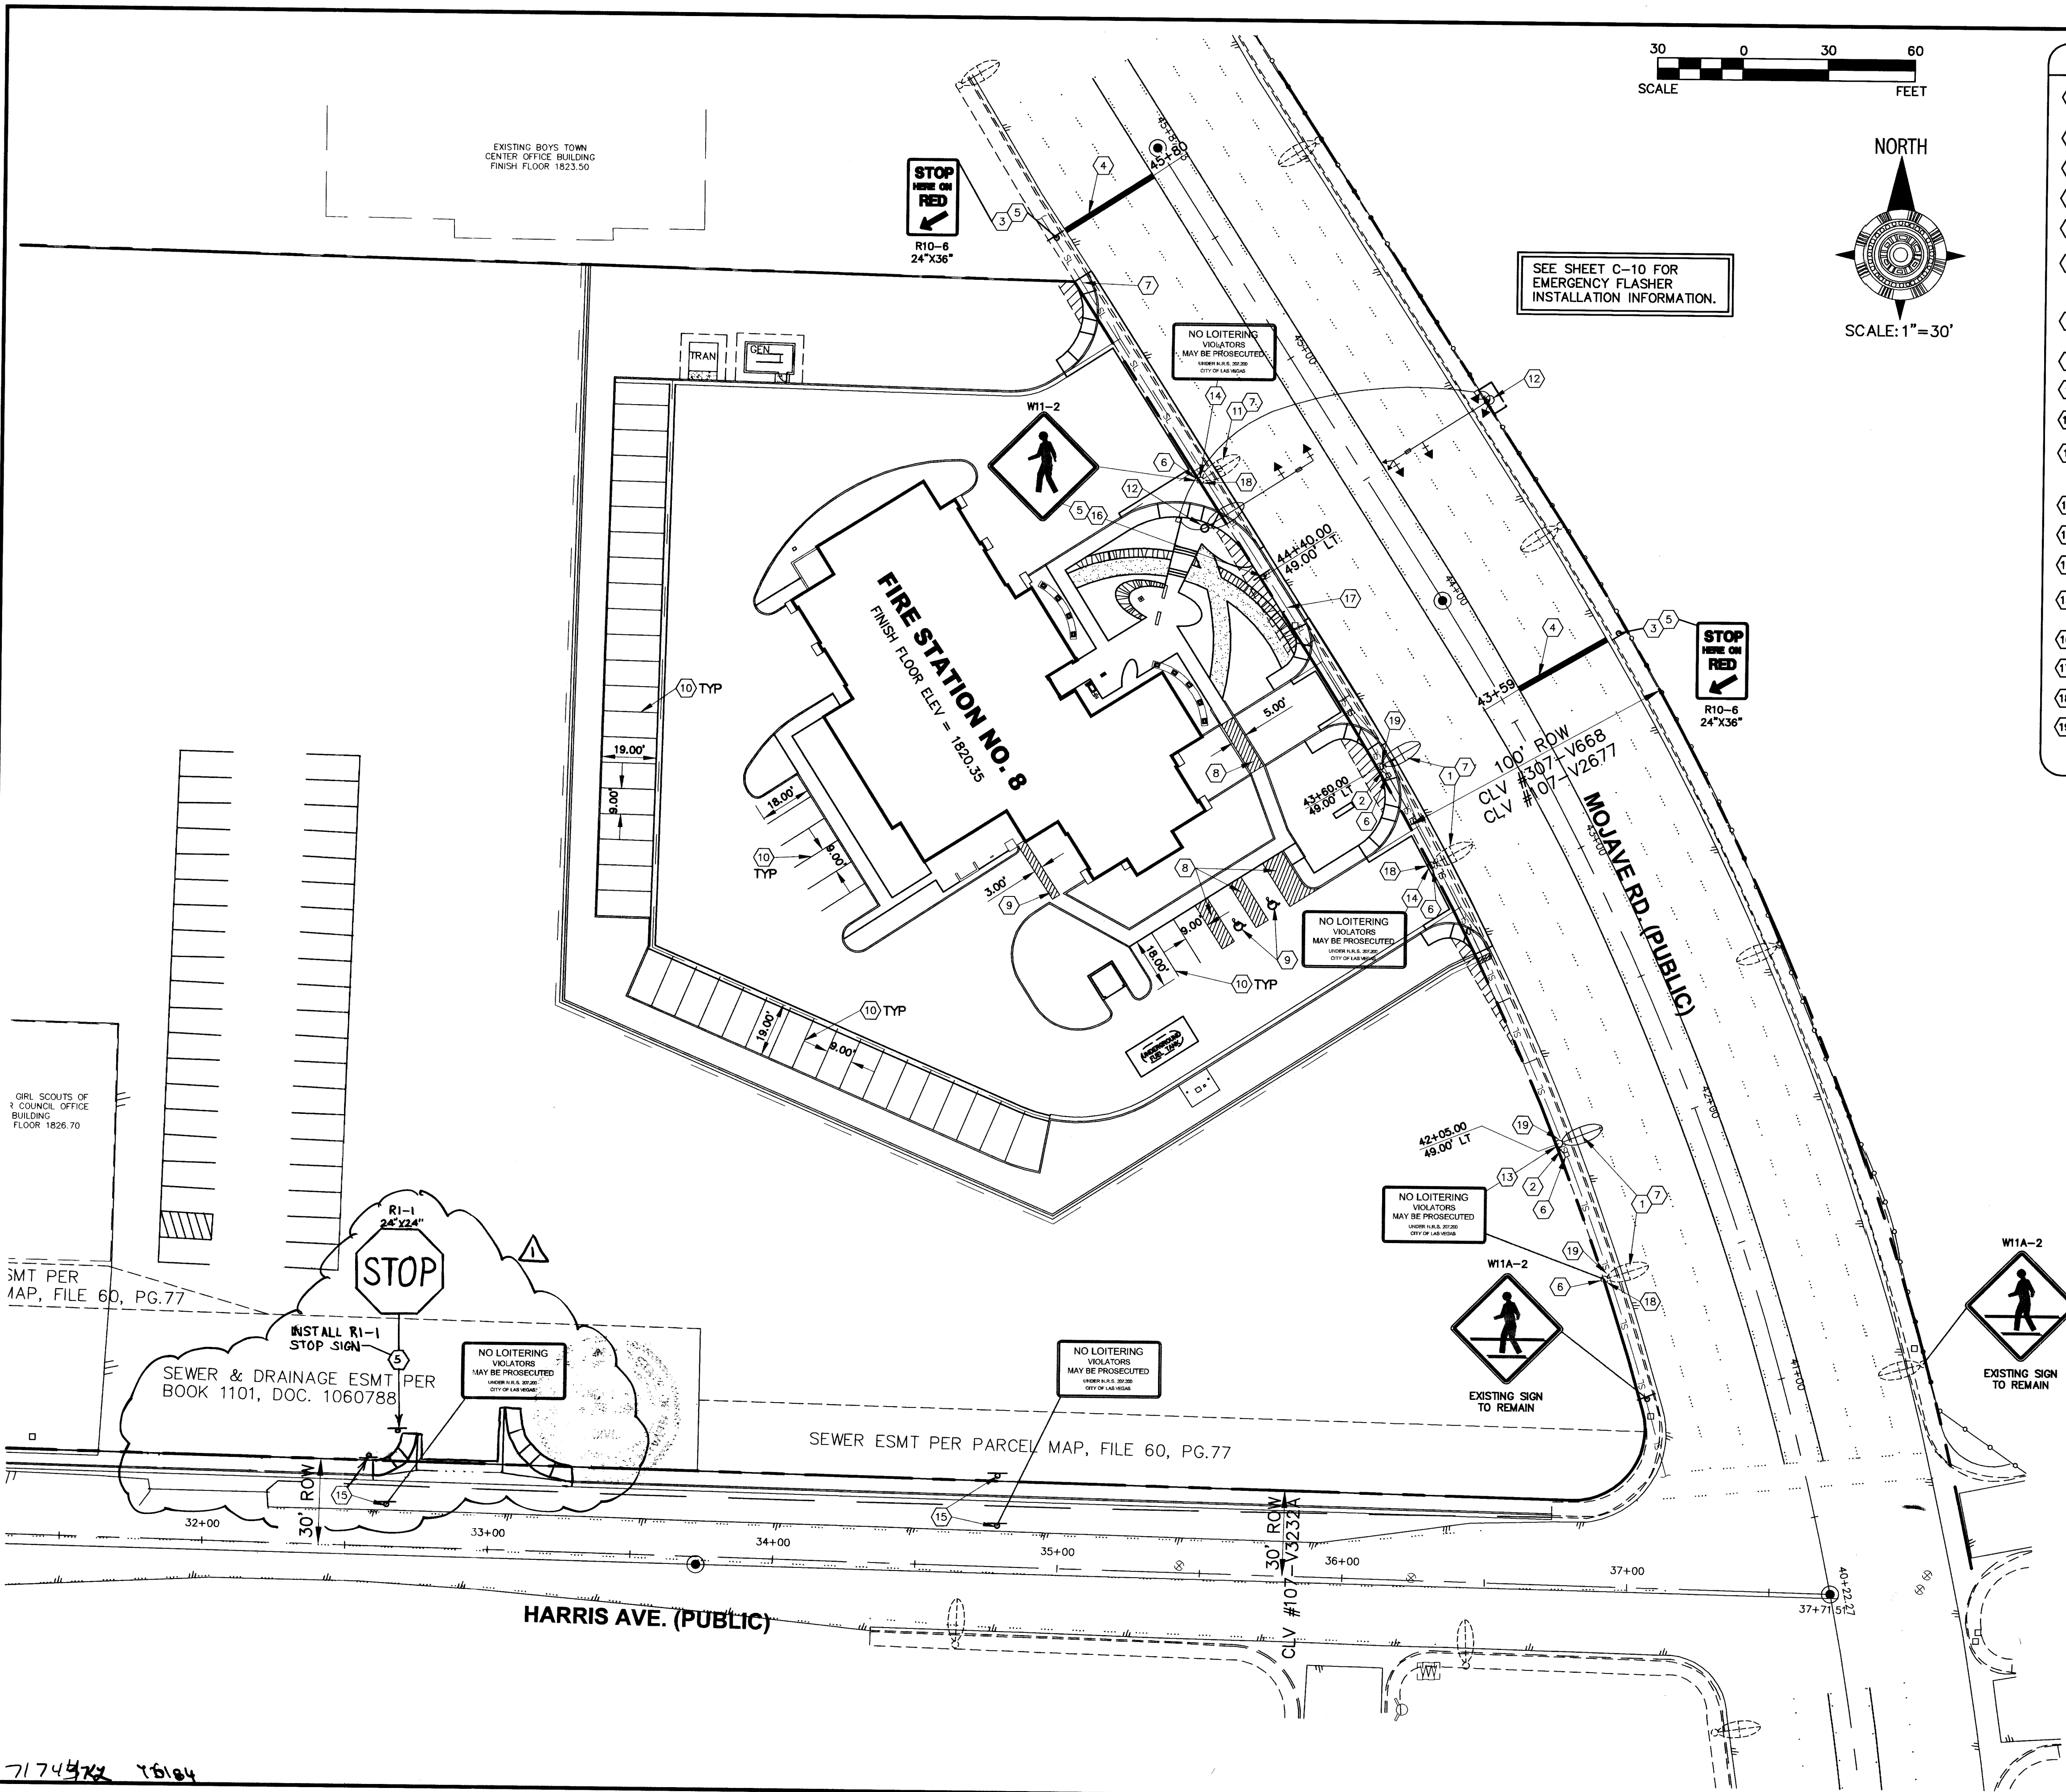

7174572 76184

630-101